

REQUEST FOR
QUALIFICATIONS /
PROPOSALS (RFQ / RFP)
FOR
ENGINEERING SERVICES

ADDENDUM #1

The Town is providing the following information in reference to the questions/comments received by design companies.

1. The submittals should include the Company's qualification materials (i.e., Firm Introduction, Project Team Resumes, & Relevant Experience).
2. The town will provide the MEMA/FEMA PDM Grant application to the company that is awarded the project. The grant award documents are attached (see Exhibit A).
3. The Secretary's Certificate on the ENF is attached. Some of the proposed cross sections with the proposed pre-cast concrete structure is also attached (see Exhibit B).
4. The hydraulic analysis will be provided to the company that is awarded the project. There is a hydraulic analysis that exists utilizing HEC-RAS. The RFQ/RFP scope of services includes the services for a Hydraulic analysis to be performed. Some of the design plans for the portions of Godfrey Brook that have already been constructed are attached (see Exhibit C).

Exhibit A



THE COMMONWEALTH OF MASSACHUSETTS
EXECUTIVE OFFICE OF PUBLIC SAFETY AND SECURITY



MASSACHUSETTS EMERGENCY MANAGEMENT AGENCY

400 Worcester Road Framingham, MA 01702-5399

Tel: 508-820-2000 Fax: 508-820-2030

Website: www.mass.gov/mema

Charles D. Baker
Governor

Samantha C. Phillips
Director

Karyn E. Polito
Lieutenant Governor

Terrence M. Reidy
Acting Secretary

August 12, 2021

Richard A. Villani, Esq.,
Town Administrator
Town of Milford
52 Main Street
Milford, MA 01757

Re: Pre-Disaster Mitigation Competitive Grant Program
PDMC 19-04 Godfrey Brook Capacity Improvements

Dear Mr. Villani,

The Federal Emergency Management Agency (FEMA) has approved Pre-Disaster Mitigation funding for the Town of Milford **Godfrey Brook Capacity Improvements** project.

The Town of Milford has received a FEMA award of \$733,425.00 and will be reimbursed up to 75% of approved, allowable, and eligible costs, up to the Federal Award, as stipulated by the grant agreement and 2 CFR Part 200. This is a reimbursable grant program and expenses must be incurred and paid, prior to being reimbursed. Please note that any project revisions, changes or deviations from the FEMA-approved grant application must be approved in writing by both MEMA and FEMA in order to be eligible for grant reimbursement.

Please Note: work cannot begin on this project until the contract is executed by all parties and a Notice to Proceed is issued.

In order to execute this agreement, the following forms relative to the attached grant agreement must be reviewed, completed and signed.

- 1) **Contractor Authorized Signatory Listing:** The Authorized Signatory must complete and sign the CASL according to instructions provided.
- 2) **Standard Contract Form and Commonwealth Terms and Conditions:** The Authorized Signatory identified on the CASL must complete, sign and hand date the form as the Contractor, on page 1 of the document.

Region I
P.O. Box 116
365 East Street
Tewksbury, MA 01876
Tel: 978-328-1500 Fax: 978-851-8218

Region II
20 Forge Parkway
Franklin, MA 02038
Tel: 774-762-4877

Region III / IV
1002 Suffield Street
Agawam, MA 01001
Tel: 413-750-1400 Fax: 413-821-1599

- 3) **Record of Environmental Considerations:** The FEMA Record of Environmental Considerations (REC), which includes the approved Scope of Work, is included for review and reference.
- 4) **Budget Information:** The budget has been completed according to the approved budget included in your application, with the funds allocated through the appropriate fiscal years.
- 5) **Work Schedule:** The work schedule has been prepared to coincide with the contract start and end dates.
- 6) **Designation of Project Manager Form:** The Authorized Signatory must appoint a local Project Manager for this Agreement; please complete and sign the form provided.
- 7) **Federal Funding Accountability and Transparency Act (FFATA):** This form must be completed and signed in blue ink.
- 8) **MEMA Sub-recipient Pre-Award Risk Assessment Questionnaire:** This form must be completed and signed by either the Authorized Signatory or CFO.
- 9) **MEMA Terms and Conditions:** These are conditions set forth by MEMA. Please review and sign this document. These conditions/requirements must be satisfied to be eligible for reimbursement.
- 10) **FEMA Assurances and Certifications:** This form must be completed and signed on page 1 of the form. Please review the instructions provided with the form.
- 11) **2020 DHS Standard Terms and Conditions:** Please review this document; these conditions/requirements must be satisfied to be eligible for funding.
- 12) **FEMA Award Letter:** A copy of the FEMA Award Letter is enclosed for your reference.

Documents requiring signature must be returned as single-sided, hard copy forms with original signatures. Scanned and emailed documents are not acceptable for contracts.


Please return this fully executed contract package within 30 days to:

**Massachusetts Emergency Management Agency
Attn: Beth Dubrawski
Mitigation and Recovery Grants Support Coordinator
400 Worcester Road
Framingham, MA 01702**

Once the Authorized Signatory has signed all required forms, MEMA will approve the contract and return an executed copy to you with a Notice to Proceed. Please carefully review all provisions of the attached grant agreement prior to execution.

Please do not hesitate to contact Beth Dubrawski at (508) 820-1425, or by email at beth.dubrawski@mass.gov, with any questions or concerns regarding these documents.

Sincerely,

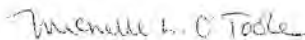

Michelle O'Toole
Acting State Hazard Mitigation Officer

Enclosures
Cc: File

Region I
P.O. Box 116
365 East Street
Tewksbury, MA 01876
Tel: 978-328-1500 Fax: 978-851-8218

Region II
20 Forge Parkway
Franklin, MA 02038
Tel: 774-762-4877

Region III / IV
1002 Suffield Street
Agawam, MA 01001
Tel: 413-750-1400 Fax: 413-821-1599



**THE COMMONWEALTH OF MASSACHUSETTS
EXECUTIVE OFFICE OF PUBLIC SAFETY AND SECURITY**



MASSACHUSETTS EMERGENCY MANAGEMENT AGENCY

400 Worcester Road Framingham, MA 01702-5399

Tel: 508-820-2000 Fax: 508-820-2030

Website: www.mass.gov/mema

Charles D. Baker
Governor

Samantha C. Phillips
Director

Karyn E. Polito
Lieutenant Governor

Terrence M. Reidy
Acting Secretary

September 27, 2021

Richard A. Villani, Esq.,
Town Administrator
Town of Milford
52 Main Street
Milford, MA 01757

Re: Pre-Disaster Mitigation Competitive Grant Program
PDMC 19-04 Godfrey Brook Capacity Improvements

Dear Mr. Villani,

Thank you for returning the executed contract, PDMC1904MILFORD00000, for the project listed above. The performance period shall start on the latest date that this contract has been executed by an authorized signatory of the Contractor, or the Department; that date is September 21, 2021. All work must be completed by the contract end date of May 29, 2024, to be eligible for FEMA reimbursement. Enclosed is a copy of the contract for your files.

The Massachusetts Emergency Management Agency (MEMA) and Federal Emergency Management Agency (FEMA) are very interested in completing this project as expeditiously as possible. We look forward to working with you on this important mitigation initiative.

Please do not hesitate to contact Beth Dubrawski at (508) 820-1425 or by e-mail at beth.dubrawski@mass.gov with any questions or concerns regarding this mitigation grant agreement.

Sincerely,

Michelle O'Toole
Acting State Hazard Mitigation Officer

Enclosures

Region I
P.O. Box 116
365 East Street
Tewksbury, MA 01876
Tel: 978-328-1500 Fax: 978-851-8218

Region II
20 Forge Parkway
Franklin, MA 02038
Tel: 774-762-4877

Region III / IV
1002 Suffield Street
Agawam, MA 01001
Tel: 413-750-1400 Fax: 413-821-1599

Exhibit B



The Commonwealth of Massachusetts
Executive Office of Energy and Environmental Affairs
100 Cambridge Street, Suite 900
Boston, MA 02114

Deval L. Patrick
GOVERNOR

Timothy P. Murray
LIEUTENANT GOVERNOR

Ian A. Bowles
SECRETARY

Tel: (617) 626-1000
Fax: (617) 626-1181
<http://www.mass.gov/envir>

September 11, 2009

CERTIFICATE OF THE SECRETARY OF ENERGY AND ENVIRONMENTAL AFFAIRS
ON THE
ENVIRONMENTAL NOTIFICATION FORM

PROJECT NAME : Godfrey Brook System Renovation
PROJECT MUNICIPALITY : Milford
PROJECT WATERSHED : Charles River
EEA NUMBER : 14465
PROJECT PROPONENT : Town of Milford
DATE NOTICED IN MONITOR : August 12, 2009

Pursuant to the Massachusetts Environmental Policy Act (M.G. L. c. 30, ss. 61-62I) and Section 11.06 of the MEPA regulations (301 CMR 11.00), I hereby determine that this project **does not require** the preparation of an Environmental Impact Report (EIR).

As described in the Environmental Notification Form (ENF), the project involves the replacement of the deteriorating masonry channel walls and bottoms of Godfrey Brook, O'Brien Brook and Hospital Brook. Godfrey Brook is an intermittent stream that is a tributary to the Charles River. O'Brien and Hospital brooks are intermittent streams that are tributaries to Godfrey Brook. Except for the upper reaches of the watershed, the Godfrey Brook system is constructed of stone masonry channels that have exceeded their expected lifespan. Godfrey Brook and its tributaries are part of the Town of Milford's stormwater management system.

Jurisdiction

The project is undergoing MEPA review pursuant to Section 11.03(3)(b)(1)(f) of the MEPA regulations because it requires a State agency action and will result in alteration of ½ or more acres of any other wetlands. The project will require a Section 401 Water Quality

Certificate (401 WQC) from the Massachusetts Department of Environmental Protection (MassDEP) and a Section 404 Permit from the U.S. Army Corps of Engineers (U.S. ACOE). The project will also require an Order of Conditions from the Milford Conservation Commission, and if appealed, a Superceding Order of Conditions from MassDEP.

The project will be undertaken by an agency of the Commonwealth. Therefore, MEPA jurisdiction for this project is broad and extends to all aspects of the project that are likely, directly or indirectly, to cause Damage to the Environment as defined in the MEPA regulations.

Review of the ENF

Site Location

Godfrey, O'Brien and Hospital Brooks are intermittent in flow due to the dense residential development that has occurred in their vicinity over the last 75 years and the significant portions of the drainage areas that have been rendered impervious. All three brooks are located entirely within the Town of Milford, almost exclusively on privately-owned property. Except in their extreme upper reaches, where the brooks remain in somewhat of a natural state, the channels of Godfrey, O'Brien, and Hospital Brooks typically are lined with stone masonry walls constructed in the 1930s by the Works Projects Administration. At that time, the channels were configured to accommodate the then existing brook flows and were not designed to provide additional capacity for future development in the watershed.

The condition of the stone walls is highly variable, ranging from fair to extremely poor and failing. The walls were observed in many areas to be leaning or threatening to collapse. In at least one area, the walls were observed to have completely fallen into the brook. Some portions of the stone walls have been replaced with walls of mass concrete as emergency repairs where extreme failures have occurred due to heavy storms. Godfrey and O'Brien Brooks run through culverts under street crossings in many locations, or are bridged with simple slab spans and stone abutments. Residential and commercial development encroaches upon the channels, with buildings very near the channel walls in many locations. The majority of the channels have a stone masonry bottom in addition to the walls, over which a gravel and debris substrate has developed, providing minimal wildlife habitat value. The channels provide a travel corridor and intermittent water source function, with the substrate providing limited habitat for aquatic invertebrates. Parts of the channels have no natural substrate and provide little to no habitat function, while the upstream natural areas provide greater habitat function.

Alternatives Analysis

The ENF indicates that the Town considered a number of potential alternatives resulting in the selection of the Preferred Alternative. The ENF included a feasibility study that was prepared to evaluate alternatives for restoration of the stream channels. The alternatives included:

1. *Emergency Repair of Channels Upon Failure* – No major repair or reconstruction of the channels is conducted and the stone masonry walls are repaired piecemeal upon failure of wall segments, as has been done in the past;
2. *Underground Culvert* – Open stream channels are converted to underground culverts;

3. *Restore Natural Stream Channel* – The stone masonry walls are removed and the channel is restored to a more natural condition, with reconstructed natural banks; and
4. *Stabilize Existing Channel in Place* – The existing channel is reconstructed in place with more stable materials and modern practices.

After a comparison of alternatives, the Town of Milford chose Alternative #4 as the Preferred Alternative. This alternative entails stabilizing the existing channel in place and provides for the replacement or reconstruction of the brook channels in their existing locations by increasing stability and longevity of the structures.

The ENF concludes that the Preferred Alternative provides a structural solution that does not impair wildlife habitat functions within the brooks. A precast concrete channel section is proposed with a natural substrate stream bottom that provides for wildlife habitat values equivalent to or better than existing conditions. The design would ensure that the channels would have the structural integrity to withstand existing flows with a long design life. Conveyance capacity could be increased in areas where site conditions allow improvements to the cross-sectional area of the stream. The ENF indicates that this alternative may be implemented in segments, determined either by priority for repair or by working in one direction along the channel. Typical methods would be required to construct this alternative, diverting flows around the active work areas. Replacement of the existing channel with a structurally stable cross-section will benefit water quality by eliminating erosion and sedimentation associated with collapse of the channel walls. The system could be designed to incorporate characteristics that would provide habitat enhancement, such as a natural bottom substrate and permeability to allow for groundwater exchange.

Wetland Impacts

The Preferred Alternative will require an Order of Conditions from the Milford Conservation Commission and a 401 Water Quality Certification from MassDEP. MassDEP has indicated in its comments that the Wetlands Protection Act regulations at 310 CMR 10:54 (1) states that where stream banks are composed of concrete, asphalt, or other artificial material, said banks are only significant to flood control and storm damage prevention. Therefore, Alternative 3 should be the Preferred Alternative because this alternative is the only alternative in which the stone masonry walls would be removed and the channel restored to a more natural condition with reconstructed natural banks. However, MassDEP acknowledges that this may not be practicable in many of the stream locations due to the constraints of the watershed area and velocity erosion. MassDEP has indicated that the Proponent should examine the possibility of combining Alternatives 3 and 4. I advise the Town of Milford to consult with MassDEP regarding the final designs of the Preferred Alternative.

Floodplain


The project involves activities with the 100-year floodplain and floodway. I refer the proponent to the comment letter from the Department of Conservation and Recreation's (DCR) Flood Hazard Management Program (FHMP) for guidance on applicable federal, state and local regulations and other requirements pertaining to development within the 100-year floodplain. As

noted by FHMP, if the project involves any federal action, it must comply with the federal Executive Order 11988, Floodplain Management.

Conclusion

Based on the information in the ENF and after consultation with relevant public agencies, I find that no further MEPA review is required. The project may proceed to State permitting.

September 11, 2009
Date

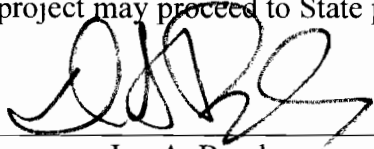

Ian A. Bowles

Comments received:

- 08/25/09 Board of Underwater Archaeological Resources
- 08/25/09 Massachusetts Department of Environmental Protection – CERO
- 09/01/09 Charles River Watershed Association
- 09/02/09 Department of Conservation and Recreation’s Flood Hazard Management Program

IAB/ACC/acc

Exhibit C

CONTRACT PLANS

for the

- GODFREY BROOK IMPROVEMENT PROJECT - CHURCH STREET CULVERT REPLACEMENT

TOWN of MILFORD, MASSACHUSETTS

MILFORD HIGHWAY DEPARTMENT

and the

OFFICE of PLANNING and ENGINEERING

SCOTT J. CRISAFULLI
HIGHWAY SURVEYOR



MICHAEL SANTORA, P.E.
TOWN ENGINEER

December, 2011

Issued for Bidding, March 28, 2012

PROJECT FUNDING ASSISTANCE PROVIDED BY:

HAZARD MITIGATION GRANT PROGRAM (HMGP)

"A Federal, State, and Local Partnership through the Federal Emergency Management Agency (FEMA)"

HMGP GRANT NUMBER 1813-22

Commonwealth of Massachusetts
DEVAL L. PATRICK, GOVERNOR

Massachusetts Emergency Management Agency
KURT N. SCHWARTZ, DIRECTOR

Department of Conservation and Recreation
EDWARD M. LAMBERT, JR., COMMISSIONER

INDEX TO PLAN SHEETS

SHEET NUMBER	TITLE
	Cover Sheet
1. - - -	Existing Conditions Church Street
2. - - -	Proposed Conditions Church Street
3. - - -	Church Street Profile
4. - - -	Church Street Details
5. - - -	Godfrey Brook & Culvert Details
6. - - -	Culvert Details & Sections
7. - - -	Channel Details

APPROVED

PREPARED BY

GZA GeoEnvironmental, Inc.
Engineers and Scientists



ONE FINANCIAL PLAZA
1350 Main Street, Suite 1400
Springfield, MA 01103
413-726-2100


ALL MATERIALS AND CONSTRUCTION METHODS AND DETAILS FOR THIS PROJECT SHALL CONFORM TO THE LATEST EDITION OF THE "STANDARD SPECIFICATIONS FOR HIGHWAYS AND BRIDGES", MASSACHUSETTS HIGHWAY DEPARTMENT (MHD), AS AMENDED, REFERRED TO HEREIN AS THE "STANDARD SPECIFICATIONS".

CHURCH STREET CULVERT

GENERAL NOTES


1. BASE SURVEY FOR THIS PROJECT WAS PROVIDED BY GUERRIERE AND HALNON, INC., MILFORD, MASSACHUSETTS. COMPLETE TOPOGRAPHICAL PLANS FROM THIS SURVEY WORK CAN BE OBTAINED FROM THE TOWN OF MILFORD.
2. THE ACCURACY AND COMPLETENESS OF UNDERGROUND AND OVERHEAD UTILITIES AS SHOWN ON THE PLANS ARE NOT GUARANTEED. IT SHALL BE THE CONTRACTOR'S RESPONSIBILITY TO DETERMINE THE EXACT LOCATION, SIZE, TYPE, ETC. OF ALL UTILITIES THAT MAY BE AFFECTED BY THE WORK OF THIS PROJECT. ALL DRAIN AND SANITARY SEWER STRUCTURES OWNED BY THE TOWN OF MILFORD SHALL BE ADJUSTED TO NEW LINE AND GRADE BY THE CONTRACTOR, AS DIRECTED BY THE PLANS OR BY THE ENGINEER. ANY UTILITY POLES OR GUY POLES WITHIN AREAS AFFECTED BY THE WORK OF THIS PROJECT SHALL BE REMOVED AND RESET BY THE APPLICABLE UTILITY COMPANY. ALTERATIONS TO UTILITIES NOT OWNED BY THE TOWN OF MILFORD SHALL BE MADE BY THE APPLICABLE UTILITY OWNERS, AS COORDINATED BY THE CONTRACTOR, AS DESCRIBED IN "UTILITY COORDINATION NOTES".
3. ALL MATERIALS AND CONSTRUCTION METHODS AND DETAILS FOR THIS PROJECT SHALL CONFORM TO THE LATEST EDITION OF THE "STANDARD SPECIFICATIONS FOR HIGHWAYS AND BRIDGES", MASSACHUSETTS HIGHWAY DEPARTMENT (MHD), AS AMENDED, REFERRED TO HEREIN AS THE "STANDARD SPECIFICATIONS".
4. THE CONTRACTOR MAY USE A CERTAIN PORTION OF THE VERIZON (BELL ATLANTIC) PROPERTY AT 9 WATER STREET AS A STAGING AREA. THE CONTRACTOR SHALL REMOVE A PORTION OF THE FENCE FOR ACCESS FROM CHURCH STREET. AT THE END OF THIS PROJECT, THE CONTRACTOR SHALL REPLACE THE FENCE, REMOVE AND DISPOSE OF ALL INTERIOR FENCING AND OTHER INTERIOR IMPROVEMENTS AND SHALL SWEEP THE AREA CLEAN OF DUST AND DEBRIS. ALL OTHER STAGING AREAS SHALL BE PROCURED BY THE CONTRACTOR. ANY DAMAGE TO PRIVATE PROPERTY IS THE SOLE RESPONSIBILITY OF THE CONTRACTOR.
5. ALL PROPOSED CATCH BASIN AND DROP INLET FRAMES AND COVERS SHALL BE AS LEBRON FOUNDRY, INC. MODEL NO. LF-248-2, OR EQUIVALENT. ALL PROP. CATCH BASINS SHALL BE AS SHOWN IN MHD (SD) 201.4.0 EXCEPT THAT THE SUMP SHALL BE 4'-0" DEEP. ALL CATCH BASINS SHALL BE EQUIPPED WITH HOODS AS PER MHD (SD) 201.12.0.
6. ALL PROP. DRAINAGE AND SAN. SEWER STRUCTURES SHALL BE SUPPORTED WITH A 12" CRUSHED STONE (M2.01.1) FOUNDATION.
7. ALL REINFORCED CONCRETE PIPE USED ON THIS PROJECT SHALL BE CLASS IV, UNLESS OTHERWISE DESIGNATED ON THE PLANS.
8. ALL EXISTING DRAIN AND SAN. SEWER LINES TO BE REPLACED SHALL BE ABANDONED IN PLACE. IF THEY CONFLICT WITH ANY PROP. WORK THEY SHALL BE REMOVED.
9. WHERE LINES OR STRUCTURES ARE ABANDONED IN PLACE, THE CONTRACTOR SHALL ENSURE THAT ALL CONNECTING PIPES, INLETS, AND OUTLETS ARE PLUGGED. ALL LIVE CONNECTIONS SHALL BE CONNECTED TO NEW WORK TO THE SATISFACTION OF THE ENGINEER.
10. CATCH BASIN, DROP INLET, AND MANHOLE FRAMES AND GRATES/COVERS SHALL CLEARLY ALIGN WITH THE OPENINGS IN THE PRECAST STRUCTURES.
11. ALL EXISTING PAVEMENT MARKINGS SHALL BE REPLACED IN KIND AFTER FINAL PAVING OF ROAD RECONSTRUCTION AREAS UNDER THIS CONTRACT.
12. ALL STRUCTURE STATIONS AND OFFSETS ARE TO THE CENTER POINT OF THE PROP. GRATE OR COVER.
13. ALL PROPOSED GRANITE CURBING SHALL BE MHD TYPE VB AND SHALL INCLUDE REMOVAL OF EXISTING GRANITE CURBING, WHERE APPLICABLE. REMOVE AND DISPOSE OF EXISTING GRANITE CURBING WITHIN THE LIMIT OF WORK.
14. NEW SIDEWALKS, WHEELCHAIR RAMPS, PRIVATE WALKS AND DRIVEWAYS SHALL BE CONSTRUCTED TO THE NEAREST SCORE LINE OR EXPANSION JOINT IN THE EXISTING ADJACENT SURFACES OR AS DIRECTED BY THE ENGINEER. PROP. CEMENT CONCRETE SIDEWALKS SHALL INCLUDE REMOVAL OF EXISTING SIDEWALK SURFACES.
15. ALL WHEELCHAIR RAMPS SHALL MEET THE LATEST REQUIREMENTS OF THE MASSACHUSETTS ARCHITECTURAL ACCESS BOARD AND THE LATEST STANDARDS OF THE MASSACHUSETTS HIGHWAY DEPARTMENT.
16. ALL DRIVEWAY REPAIRS SHALL BE "TYPICAL DRIVEWAYS" AS SHOWN IN THE DETAILS.
17. ALL PROPOSED RETAINING WALLS AND END WALLS SHALL BE CEMENTED FIELD STONE MASONRY (MHD SD 302.2.0) OR CEMENT CONCRETE MASONRY (MHD SD 302.1.0) OR AS OTHERWISE SHOWN ON THE PLANS. EXACT HEIGHTS OF THESE WALLS SHALL BE AS SHOWN ON THE CROSS SECTIONS OR DETAILS OR AS DIRECTED IN THE FIELD BY THE ENGINEER.
18. IN EXCAVATION AREAS, ALL TOPSOIL SHALL BE REMOVED TO A DEPTH OF 12" (MINIMUM) OR AS DIRECTED BY THE ENGINEER AND SHALL BE STOCKPILED FOR RESPREADING AFTER BACKFILLING IS COMPLETED.
19. MAILBOXES, FENCES, STREET SIGNS, ETC. THAT NEED TO BE REMOVED AND RESET OR RELOCATED SHALL BE DONE SO TO THE SATISFACTION OF THE ENGINEER. ALL ITEMS SHALL BE SET TO MHD STANDARDS.
20. CONTRACTOR SHALL COMPLY IN ALL RESPECTS WITH ALL ENVIRONMENTAL PERMITS ISSUED FOR THIS PROJECT.
21. SOME GODFREY BROOK FIELDSTONE WALLS HAVE BEEN REPLACED WITH CONCRETE WALLS.
22. IF ANY ARTIFACTS OR HUMAN REMAINS ARE FOUND DURING GROUND DISTURBING ACTIVITIES, THE CONTRACTOR SHALL CEASE WORK AND IMMEDIATELY NOTIFY THE ENGINEER.
23. ALL DISTURBED AREAS NOT OTHERWISE SURFACED SHALL RECEIVE 6" LOAM AND SEED AND BE ESTABLISHED AS LAWNS.

- LEGEND**
- EXISTING EDGE OF WATER
 - EXISTING EDGE OF PAVEMENT
 - VC EXISTING CURB
 - EXISTING PROPERTY LINE
 - EXISTING STREET RIGHT OF WAY
 - 310 EXISTING 10 FT. CONTOUR
 - 307 EXISTING 1 FT. CONTOUR
 - 311.0 EXISTING SPOT GRADE
 - x-x EXISTING CHAIN LINK FENCE
 - o-o EXISTING STOCKADE FENCE
 - SD EXISTING STORM DRAIN LINE
 - SS EXISTING SANITARY SEWER LINE
 - G EXISTING GAS LINE
 - W EXISTING WATER LINE
 - EXISTING OVERHEAD WIRES
 - EXISTING CATCH BASIN
 - EXISTING DRAIN MANHOLE
 - EXISTING SANITARY MANHOLE
 - EXISTING UTILITY POLE
 - EXISTING HYDRANT
 - EXISTING WATER VALVE
 - EXISTING GAS VALVE
 - EXISTING TREES
 - GB-20 BORING LOCATION

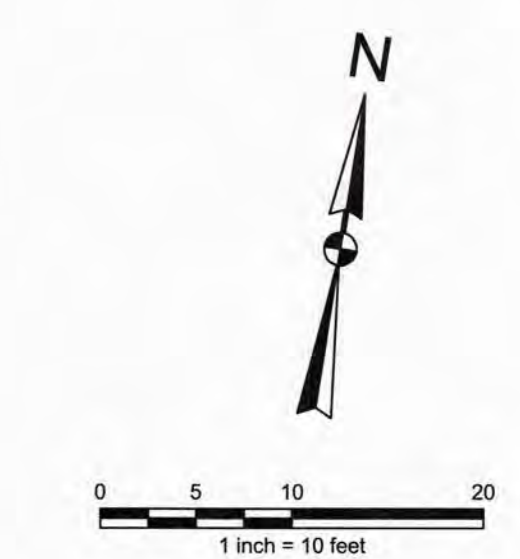

NO.	ISSUE/DESCRIPTION	BY	DATE
2	ISSUED FOR CONSTRUCTION	EDM	3/28/12
1	ISSUED FOR PERMITTING	EDM	1/19/12

PREPARED BY: GZA GeoEnvironmental, Inc. Engineers and Scientists www.gza.com		PREPARED FOR: TOWN OF MILFORD	
PROJ MGR: TEJ DESIGNED BY: RS DATE: DECEMBER, 2011	REVIEWED BY: RS DRAWN BY: EDM PROJECT NO: 15.0166148.10	CHECKED BY: TEJ SCALE: 1"=10' REVISION NO:	1

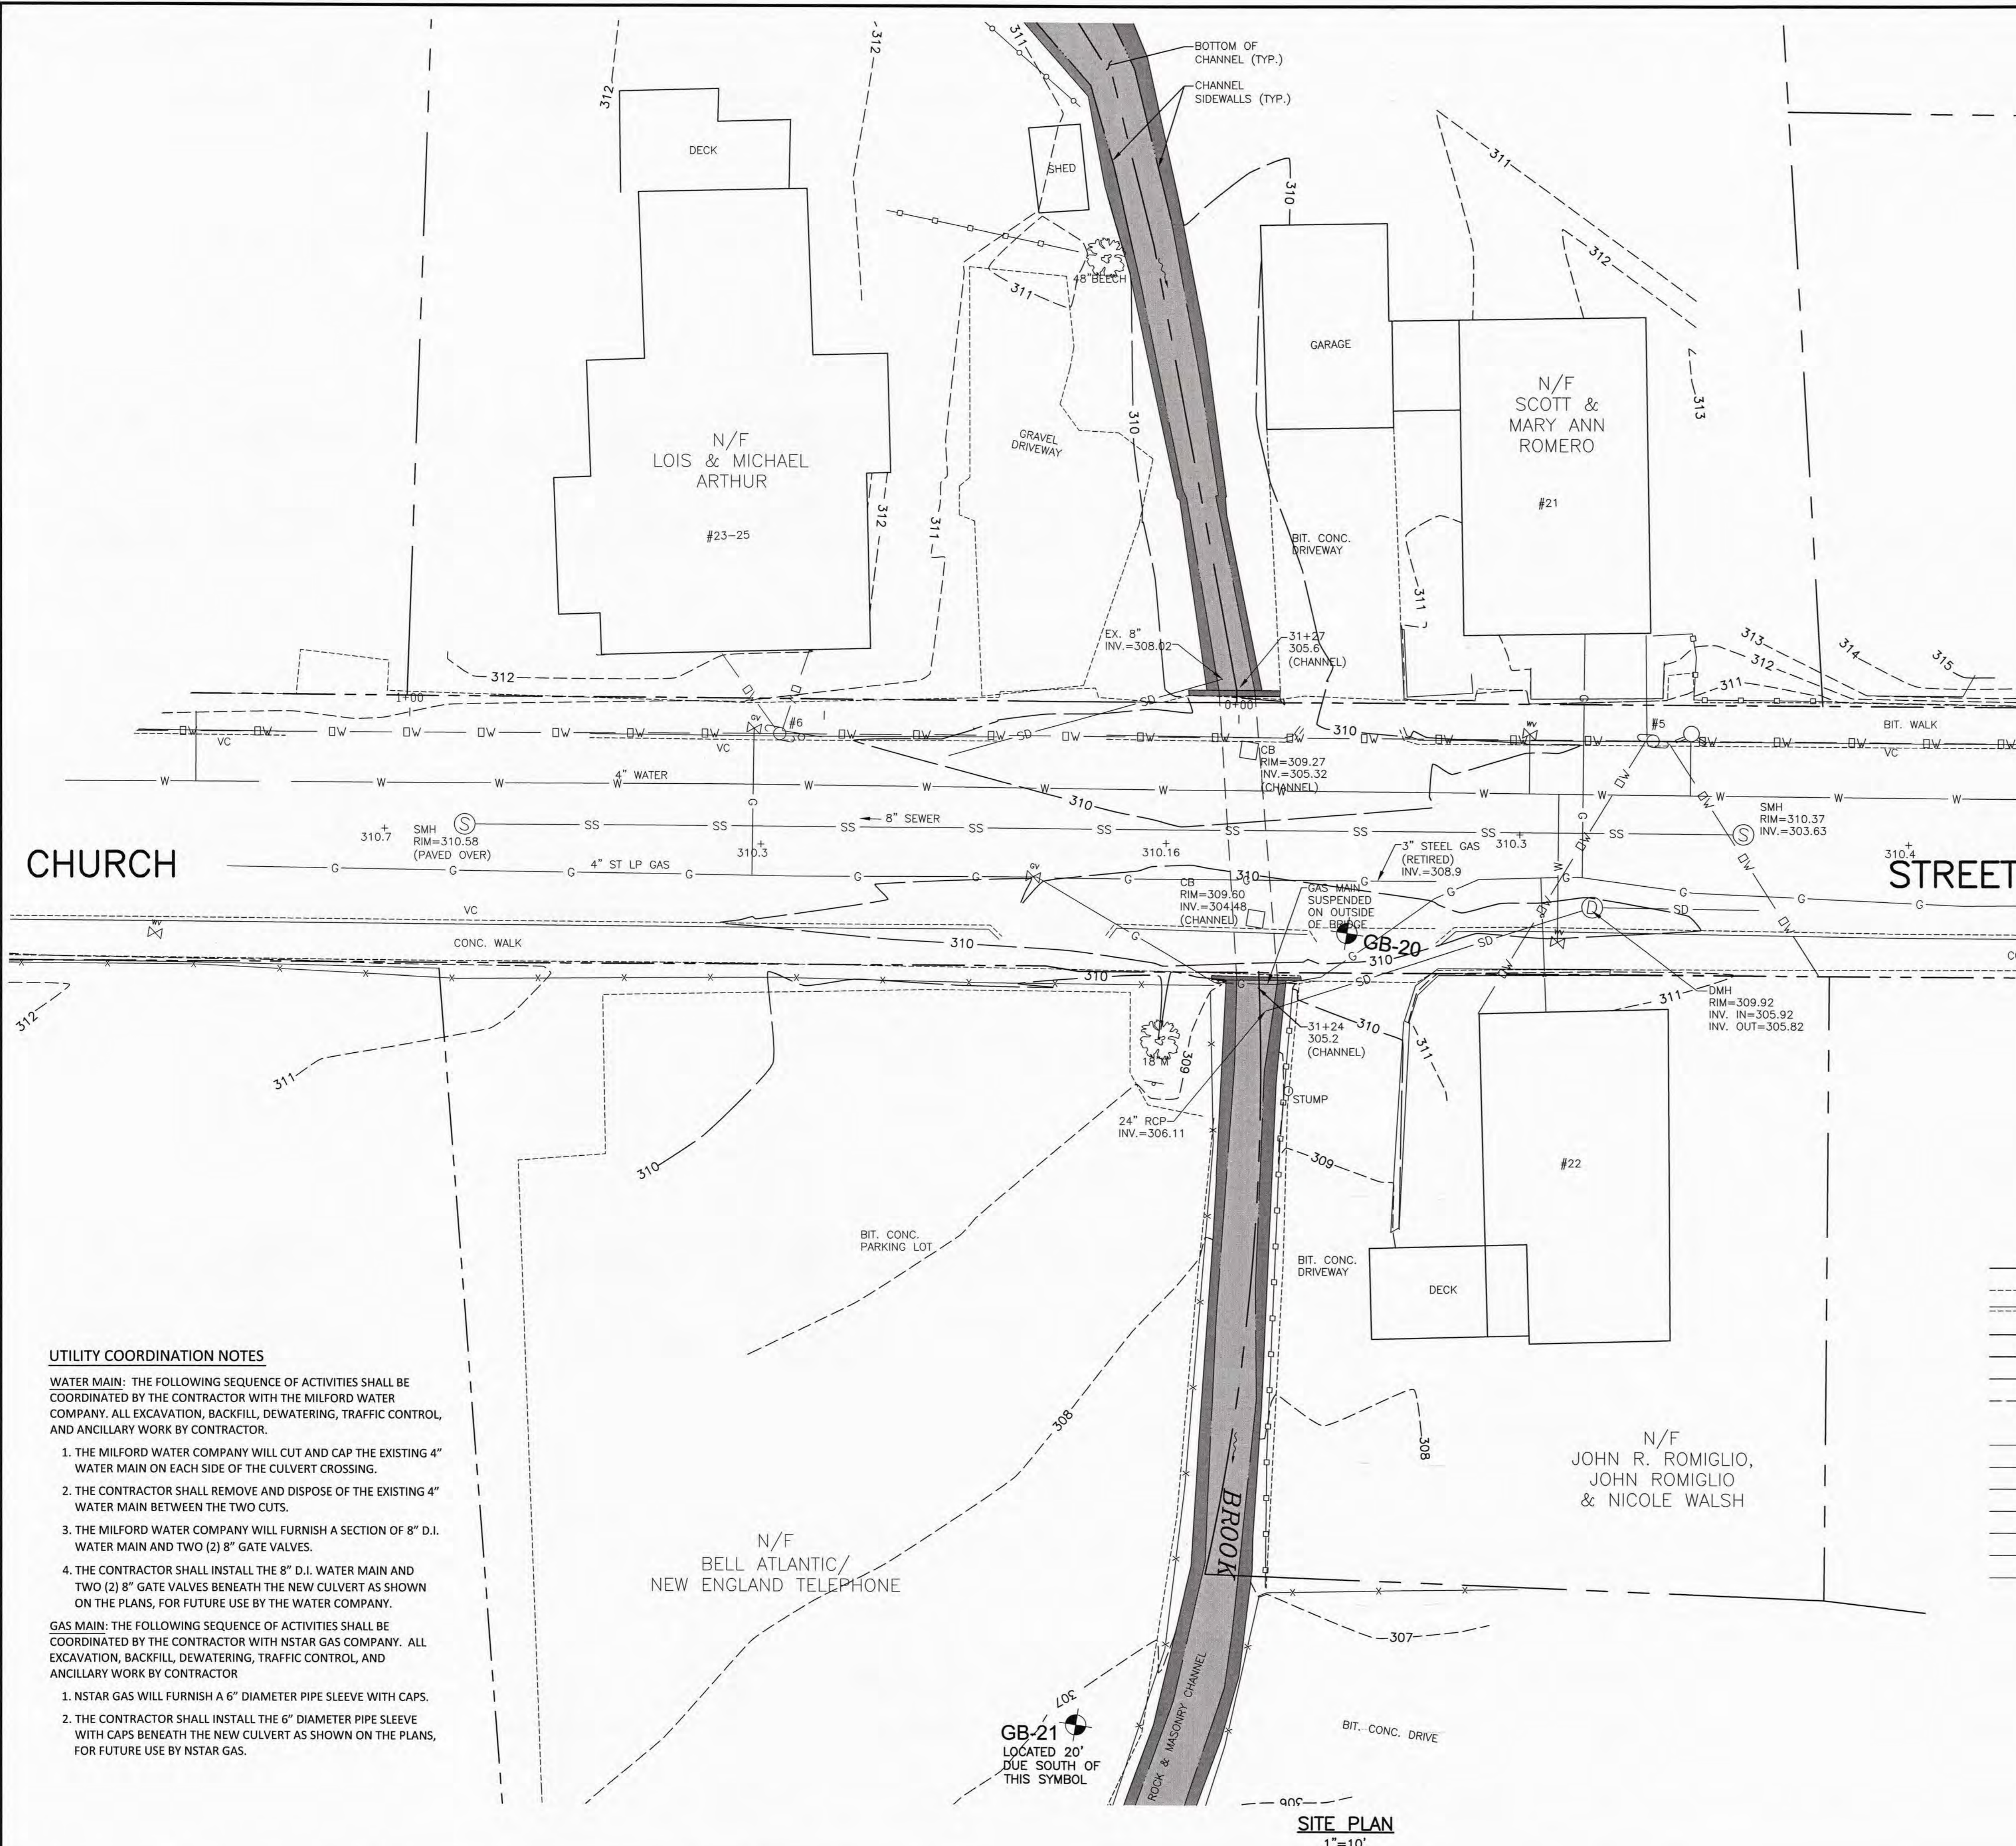

- UTILITY COORDINATION NOTES**
- WATER MAIN:** THE FOLLOWING SEQUENCE OF ACTIVITIES SHALL BE COORDINATED BY THE CONTRACTOR WITH THE MILFORD WATER COMPANY. ALL EXCAVATION, BACKFILL, DEWATERING, TRAFFIC CONTROL, AND ANCILLARY WORK BY CONTRACTOR.
1. THE MILFORD WATER COMPANY WILL CUT AND CAP THE EXISTING 4" WATER MAIN ON EACH SIDE OF THE CULVERT CROSSING.
 2. THE CONTRACTOR SHALL REMOVE AND DISPOSE OF THE EXISTING 4" WATER MAIN BETWEEN THE TWO CUTS.
 3. THE MILFORD WATER COMPANY WILL FURNISH A SECTION OF 8" D.I. WATER MAIN AND TWO (2) 8" GATE VALVES.
 4. THE CONTRACTOR SHALL INSTALL THE 8" D.I. WATER MAIN AND TWO (2) 8" GATE VALVES BENEATH THE NEW CULVERT AS SHOWN ON THE PLANS, FOR FUTURE USE BY THE WATER COMPANY.
- GAS MAIN:** THE FOLLOWING SEQUENCE OF ACTIVITIES SHALL BE COORDINATED BY THE CONTRACTOR WITH NSTAR GAS COMPANY. ALL EXCAVATION, BACKFILL, DEWATERING, TRAFFIC CONTROL, AND ANCILLARY WORK BY CONTRACTOR
1. NSTAR GAS WILL FURNISH A 6" DIAMETER PIPE SLEEVE WITH CAPS.
 2. THE CONTRACTOR SHALL INSTALL THE 6" DIAMETER PIPE SLEEVE WITH CAPS BENEATH THE NEW CULVERT AS SHOWN ON THE PLANS, FOR FUTURE USE BY NSTAR GAS.


SITE PLAN
1"=10'

TEMPORARY TRAFFIC CONTROL NOTES

- PRIOR TO COMMENCEMENT OF ANY CONSTRUCTION, THE CONTRACTOR SHALL SUBMIT A TEMPORARY TRAFFIC CONTROL PLAN FOR APPROVAL BY THE ENGINEER IN WRITING.
- ANY REQUIRED TEMPORARY CHANNELIZATION OF TRAFFIC SHALL BE ACCOMPLISHED THROUGH THE USE OF REFLECTORIZED PLASTIC DRUMS WITH STEADY BURN LIGHTS TYPE C7, EXCEPT THAT THE FIRST THREE DRUMS USED AT EACH END OF A STRING OF DRUMS SHALL HAVE ATTACHED FLASHER TYPE 9? DRUMS AND LIGHTS SHALL BE IN ACCORDANCE WITH THE MANUAL ON UNIFORM TRAFFIC CONTROL DEVICES FOR STREETS AND HIGHWAYS, 2009 EDITION (MUTCD) AND MASSDOT STANDARDS.
- MAXIMUM SPACING OF DRUMS SHALL BE 20 FEET ON TAPER, 40 FEET ON TANGENT.
- ALL SIGNS SHALL BE BLACK LEGEND ON A REFLECTIVE ORANGE BACKGROUND AND IN ACCORDANCE WITH THE MUTCD AND MASSDOT STANDARDS. ALL CONSTRUCTION SIGNS SHALL BE ATTACHED TO THEIR OWN INDEPENDENT SUPPORTS. SIGN SUPPORTS SHALL BE CRASHWORTHY.
- ALL CONSTRUCTION TEMPORARY TRAFFIC CONTROL DEVICES SHALL BE IMMEDIATELY REMOVED WHEN NO LONGER NEEDED. WHEN WORK IS SUSPENDED FOR SHORT PERIODS OF TIME, TEMPORARY TRAFFIC CONTROL DEVICES THAT ARE NO LONGER APPLICABLE SHALL BE EITHER COVERED OR REMOVED.
- THE CONTRACTOR SHALL MAINTAIN ACCESS AND EGRESS AT ALL TIMES TO ALL PROPERTIES ABUTTING THE WORK AREA.
- DURING NON-WORKING HOURS, NO LATERAL DROP-OFF WILL BE PERMITTED WITHIN THE AREA OF EXCAVATION ADJACENT TO ANY TRAVELLED WAY.
- IT IS ANTICIPATED THAT ONE, CONTINUOUS SHORT-TERM STREET CLOSURE WITH DETOUR (2 WEEKS OR LESS) MAY BE ALLOWABLE FOR CHURCH STREET. LOCAL TRAFFIC MAY BE ALLOWED TO DRIVE 2 WAYS ON CHURCH STREET. ANY PROPOSED DETOUR MUST BE REVIEWED IN DETAIL WITH THE ENGINEER AND WRITTEN APPROVAL OF THE DETOUR PLAN MUST BE OBTAINED PRIOR TO IMPLEMENTATION.


SEDIMENT AND EROSION CONTROL NOTES:

- SEDIMENT BASINS AND TRAPS (IF NECESSARY), PERIMETER BERMS, SEDIMENT BARRIERS, CATCH BASIN PROTECTION AND OTHER MEASURES INTENDED TO TRAP SEDIMENT SHALL BE CONSTRUCTED AS A FIRST STEP IN ANY LAND DISTURBING ACTIVITY AND SHALL BE MADE FUNCTIONAL BEFORE UPGRADING LAND DISTURBANCE TAKES PLACE.
- THE CONTRACTOR SHALL CONSTRUCT ALL EROSION AND SEDIMENT CONTROL MEASURES PER THE PROJECT PLANS AND OTHERS AS MAY BE NECESSARY PRIOR TO BEGINNING ANY LAND DISTURBING ACTIVITIES. SHALL ENSURE THAT ALL RUNOFF FROM DISTURBED AREAS IS DIRECTED TO THE SEDIMENT CONTROL DEVICES, AND SHALL NOT REMOVE ANY EROSION OR SEDIMENT CONTROL MEASURES UNTIL THE AREAS DRAINING TO THEM ARE FINAL STABILIZED. THE CONTRACTOR SHALL INSPECT DAILY AND MAINTAIN CONTINUOUSLY IN EFFECTIVE OPERATING CONDITION ALL EROSION AND SEDIMENT CONTROL MEASURES UNTIL SUCH TIME AS THEY ARE REMOVED. CONDUCT INSPECTIONS AND REPORTING IN ACCORDANCE WITH ALL PERMITS.
- THE CONTRACTOR SHALL IMPLEMENT MEASURES TO DIVERT THE RUN-ON OF STORMWATER FLOWS INTO THE SITE AT UPGRADING LOCATIONS, WHERE POSSIBLE, AND WITHOUT CAUSING OR CONTRIBUTING TO FLOODING OF NEIGHBORING PROPERTIES.
- IMMEDIATELY UPON DISCOVERING UNFORESSEEN CIRCUMSTANCES POSING THE POTENTIAL FOR ACCELERATED EROSION AND/OR SEDIMENT POLLUTION, THE CONTRACTOR SHALL IMPLEMENT APPROPRIATE BEST MANAGEMENT PRACTICES (BMPs) TO ELIMINATE THE POTENTIAL FOR ACCELERATED EROSION AND/OR SEDIMENT POLLUTION. THE CONTRACTOR SHALL INSTALL AND MAINTAIN ANY ADDITIONAL EROSION CONTROL MEASURES NECESSARY FOR PERMIT COMPLIANCE.
- ALL EROSION CONTROL MEASURES SHALL BE CONSTRUCTED AND MAINTAINED IN ACCORDANCE WITH APPLICABLE PUBLISHED STANDARDS AND SPECIFICATIONS AND THE "MASSACHUSETTS EROSION AND SEDIMENT CONTROL GUIDELINES FOR URBAN AND SUBURBAN AREAS", MA DEP, MAY 2003 (THE GUIDELINES).
- ALL DISTURBED AREAS SHALL HAVE SOD, SEED, MULCH, OR OTHER APPROVED STABILIZATION MEASURES APPLIED TO DISTURBED AREAS WITHIN SEVEN (7) CALENDAR DAYS AFTER ACTIVITIES ON THAT AREA HAVE CEASED. MAINTENANCE SHALL BE PERFORMED AS NECESSARY TO ENSURE CONTINUED STABILIZATION. ACTIVE CONSTRUCTION AREAS MAY BE EXEMPTED, PROVIDED THAT PROPER CONTROLS ARE IN PLACE AND MAINTAINED.
- STOCKPILES WHICH HAVE NOT BEEN USED FOR SEVEN (7) CALENDAR DAYS SHALL BE STABILIZED THROUGH COVERING OR THE APPLICATION OF SOD, SEED, AND ANCHORED STRAW MULCH, OR OTHER APPROVED STABILIZATION MEASURES.
- ALL CATCH BASINS OR OTHER DRAIN INLETS WHICH MAY RECEIVE STORMWATER FROM DISTURBED AREAS AS SHOWN ON THE PLANS AND ADDITIONALLY AS LOCATED IN THE FIELD SHALL BE PROVIDED WITH SILT SACKS OR EQUIVALENT INLET PROTECTION TO FILTER SEDIMENT-LADEN STORMWATER.
- THE CONTRACTOR SHALL BE RESPONSIBLE FOR THE CONTROL OF DUST AND DIRT SCATTERING AND RISING IN THE AIR DURING CONSTRUCTION AND SHALL PROVIDE APPROPRIATE CONTROLS IN ACCORDANCE WITH THE PLANS AND SPECIFICATIONS.
- ALL WASTE MATERIALS GENERATED AT THE SITE SHALL BE IMMEDIATELY REMOVED AND DISPOSED OF PROPERLY OR STORED IN A SECURELY COVERED CONTAINER IN ACCORDANCE WITH LOCAL AND STATE REGULATIONS. CONTAINER SHALL BE EMPTIED ON A REGULAR BASIS AND AS NECESSARY. NO CONSTRUCTION WASTE OR DEBRIS SHALL BE BURIED ONSITE.
- PRIOR TO REMOVAL OF SEDIMENT CONTROL MEASURES THE CONTRACTOR SHALL STABILIZE ALL CONTRIBUTORY AREAS USING PAVEMENT, SOD, OR AN APPROVED PERMANENT SEED MIXTURE WITH REQUIRED SOIL AMENDMENTS AND AN APPROVED MULCH.
- THIS PROJECT MAY BE REGULATED UNDER THE U.S. EPA NATIONAL POLLUTANT DISCHARGE ELIMINATION SYSTEM (NPDES) MASSACHUSETTS GENERAL PERMIT FOR DEWATERING ACTIVITY DISCHARGE. OPERATORS OF SUCH CONSTRUCTION SITES MUST MEET THE REQUIREMENTS OF EPA'S DEWATERING GENERAL PERMIT (DGP). TO OBTAIN COVERAGE UNDER THE DGP, THE CONTRACTOR MUST PREPARE AND FILE A COMPLETE AND ACCURATE NOTICE OF INTENT (NOI) WITH EPA AND MASSACHUSETTS DEP. THE CONTRACTOR IS RESPONSIBLE FOR COMPLYING WITH THE DGP, INCLUDING ALL MONITORING AND REPORTING REQUIREMENTS.
- THE CONTRACTOR SHALL PREVENT SEDIMENTATION OF THE STREAM CHANNEL DOWNSTREAM OF THE WORK BY INSTALLING A SANDBAG DIKE OR OTHER APPROVED MEASURES IN THE CHANNEL DOWNSTREAM OF THE LIMIT OF WORK.

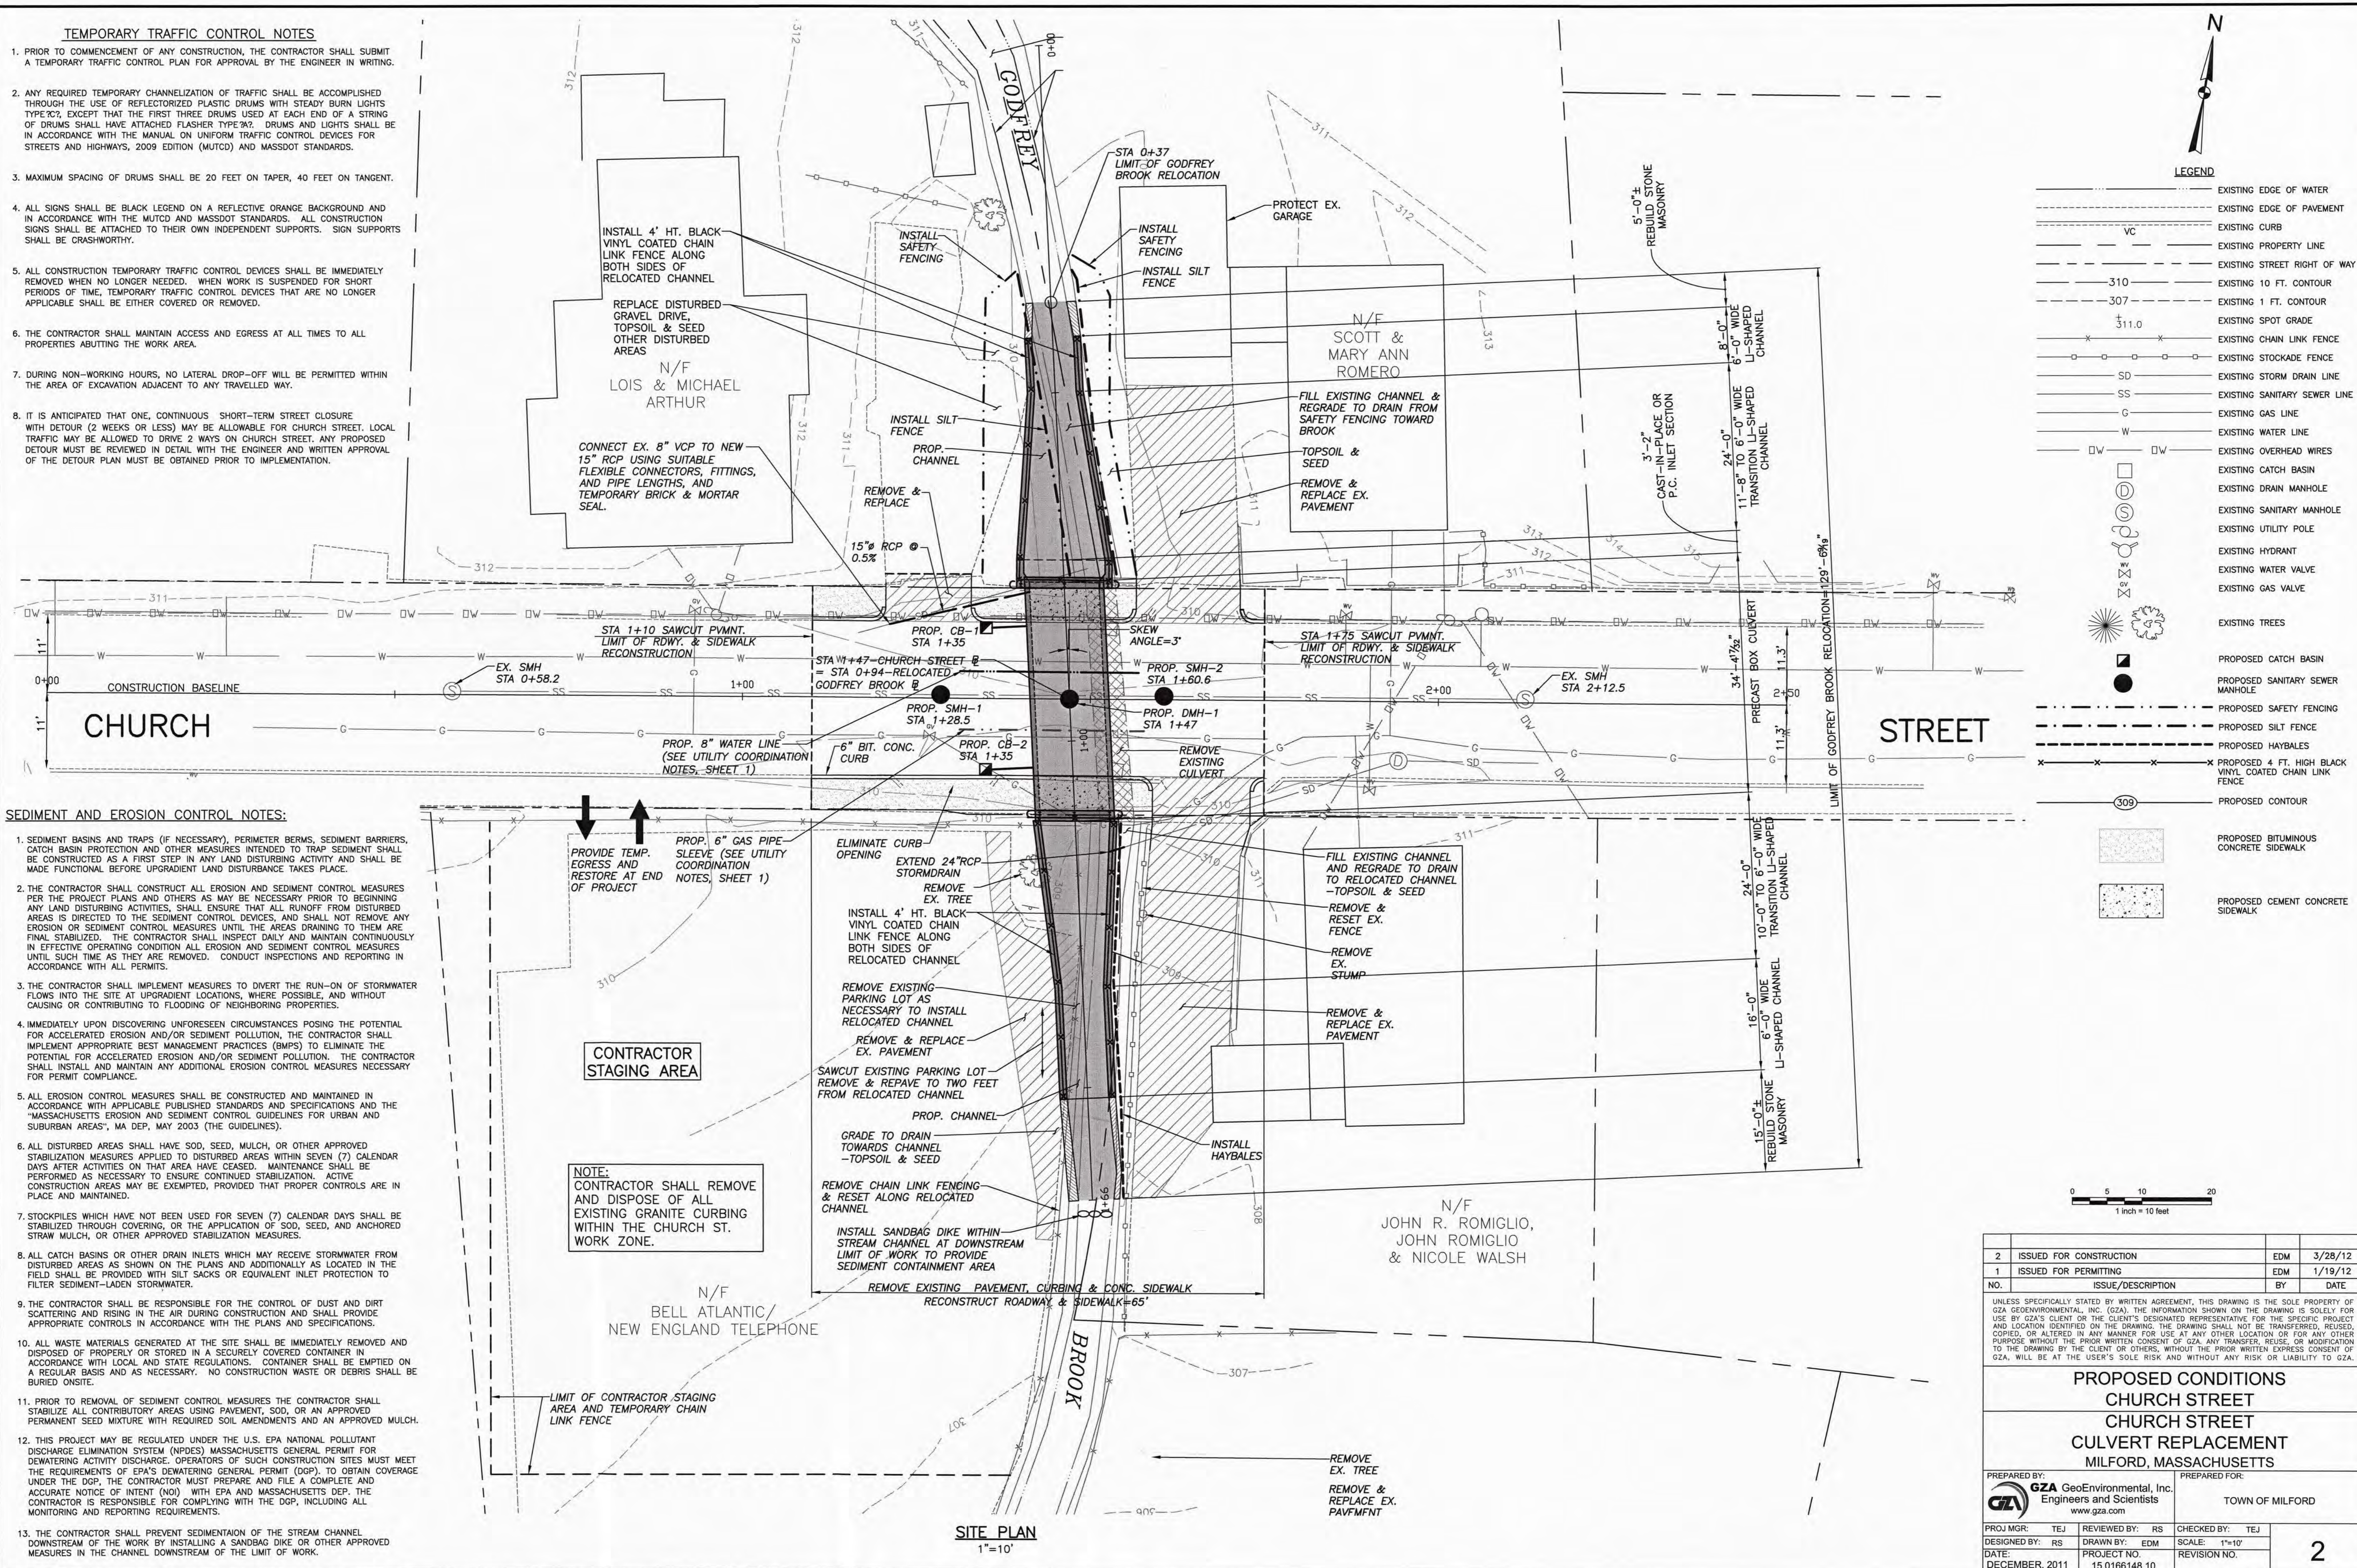

LEGEND

---	EXISTING EDGE OF WATER
---	EXISTING EDGE OF PAVEMENT
---	EXISTING CURB
---	EXISTING PROPERTY LINE
---	EXISTING STREET RIGHT OF WAY
---	EXISTING 10 FT. CONTOUR
---	EXISTING 1 FT. CONTOUR
---	EXISTING SPOT GRADE
---	EXISTING CHAIN LINK FENCE
---	EXISTING STOCKADE FENCE
---	EXISTING STORM DRAIN LINE
---	EXISTING SANITARY SEWER LINE
---	EXISTING GAS LINE
---	EXISTING WATER LINE
---	EXISTING OVERHEAD WIRES
---	EXISTING CATCH BASIN
---	EXISTING DRAIN MANHOLE
---	EXISTING SANITARY MANHOLE
---	EXISTING UTILITY POLE
---	EXISTING HYDRANT
---	EXISTING WATER VALVE
---	EXISTING GAS VALVE
---	EXISTING TREES
---	PROPOSED CATCH BASIN
---	PROPOSED SANITARY SEWER MANHOLE
---	PROPOSED SAFETY FENCING
---	PROPOSED SILT FENCE
---	PROPOSED HAYBALES
---	PROPOSED 4 FT. HIGH BLACK VINYL COATED CHAIN LINK FENCE
---	PROPOSED CONTOUR
---	PROPOSED BITUMINOUS CONCRETE SIDEWALK
---	PROPOSED CEMENT CONCRETE SIDEWALK

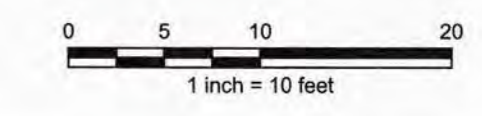


2	ISSUED FOR CONSTRUCTION	EDM	3/28/12
1	ISSUED FOR PERMITTING	EDM	1/19/12
NO.	ISSUE/DESCRIPTION	BY	DATE

UNLESS SPECIFICALLY STATED BY WRITTEN AGREEMENT, THIS DRAWING IS THE SOLE PROPERTY OF GZA GEOENVIRONMENTAL, INC. (GZA). THE INFORMATION SHOWN ON THE DRAWING IS SOLELY FOR USE BY GZA'S CLIENT OR THE CLIENT'S DESIGNATED REPRESENTATIVE FOR THE SPECIFIC PROJECT AND LOCATION IDENTIFIED ON THE DRAWING. THE DRAWING SHALL NOT BE TRANSFERRED, REUSED, COPIED, OR ALTERED IN ANY MANNER FOR USE AT ANY OTHER LOCATION OR FOR ANY OTHER PURPOSE WITHOUT THE PRIOR WRITTEN CONSENT OF GZA. ANY TRANSFER, REUSE, OR MODIFICATION TO THE DRAWING BY THE CLIENT OR OTHERS, WITHOUT THE PRIOR WRITTEN EXPRESS CONSENT OF GZA, WILL BE AT THE USER'S SOLE RISK AND WITHOUT ANY RISK OR LIABILITY TO GZA.


PROPOSED CONDITIONS
CHURCH STREET
CHURCH STREET
CULVERT REPLACEMENT
MILFORD, MASSACHUSETTS

PREPARED BY:	GZA GeoEnvironmental, Inc. Engineers and Scientists www.gza.com	PREPARED FOR:	TOWN OF MILFORD
PROJ. MGR:	TEJ	REVIEWED BY:	RS
DESIGNED BY:	RS	DRAWN BY:	EDM
DATE:	DECEMBER, 2011	PROJECT NO.:	15.0166148.10
		CHECKED BY:	TEJ
		SCALE:	1"=10'
		REVISION NO.:	

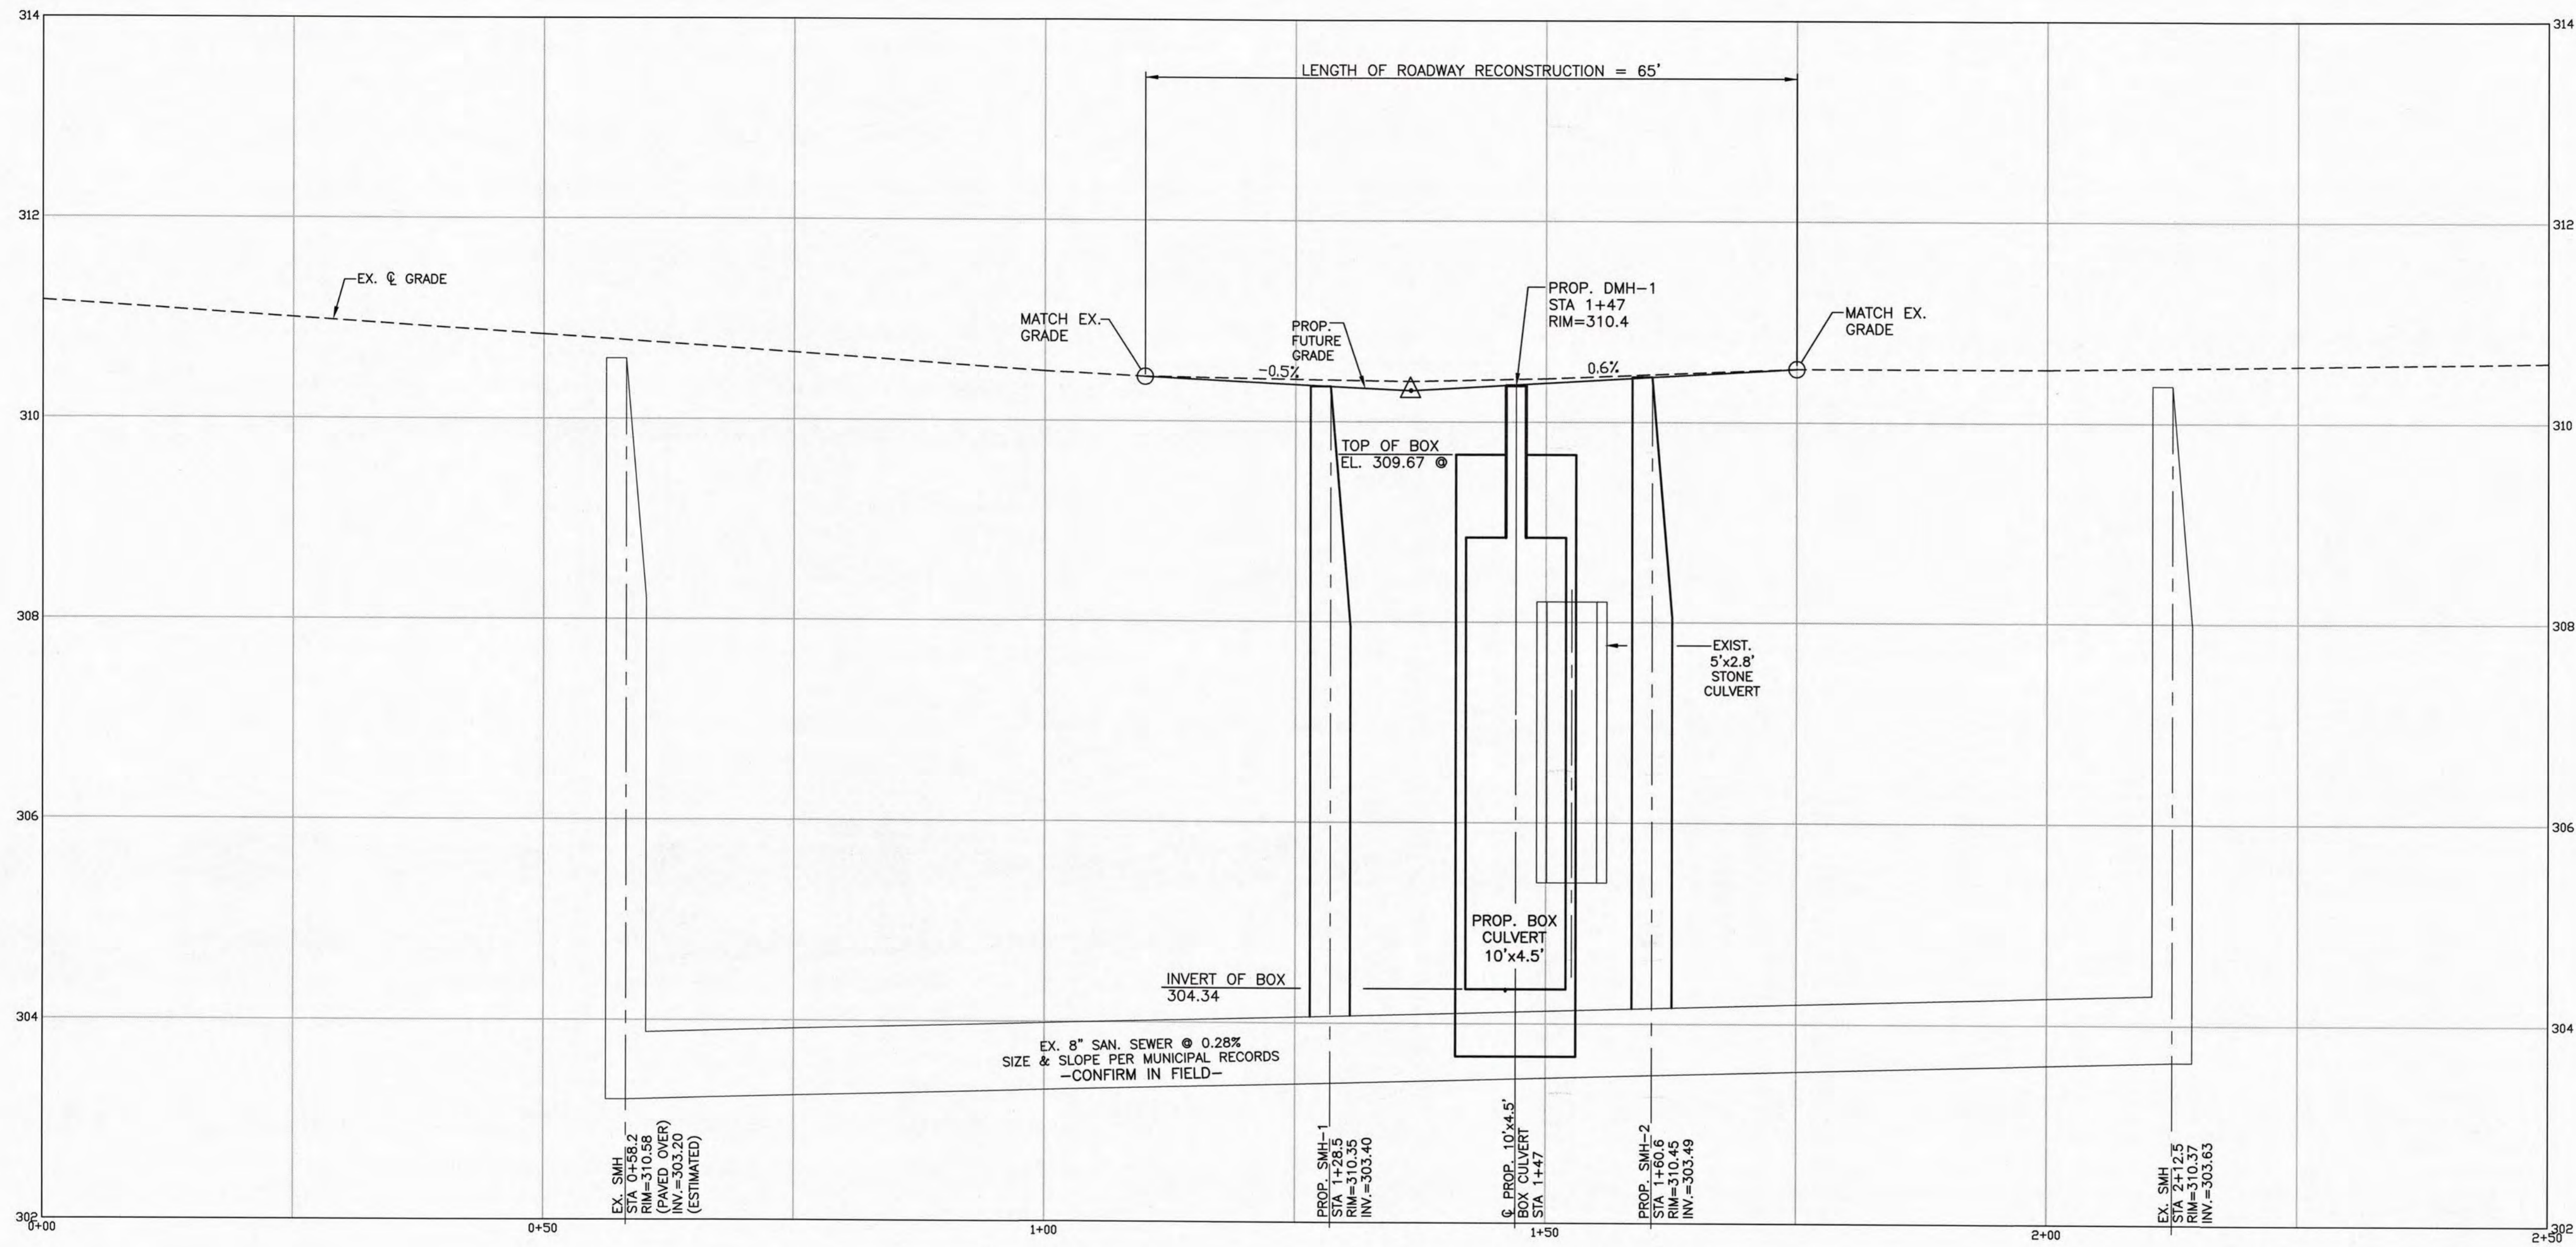

PROFILE-CHURCH STREET

VERT. 1"=1'
HOR. 1"=10'

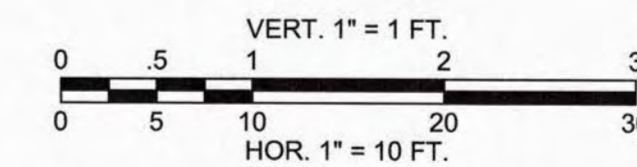

NOTES:

1. PROPOSED FUTURE GRADE BASED ON DRAFT TOWN OF MILFORD ROADWAY IMPROVEMENT PROJECT PLANS, BY GCG ASSOCIATES, INC., DECEMBER 10, 2011.
2. CONTRACTOR TO REVIEW PROFILE WITH THE ENGINEER IN THE FIELD PRIOR TO PAVING.
3. THE CONTRACTOR SHALL PAVE WITHIN THE LIMITS OF ROADWAY RECONSTRUCTION TO FORM A SMOOTH TRANSITION BETWEEN THE STRUCTURES AND EXISTING PAVEMENT.

2	ISSUED FOR CONSTRUCTION	EDM	3/28/12
1	ISSUED FOR PERMITTING	EDM	1/19/12
NO.	ISSUE/DESCRIPTION	BY	DATE

UNLESS SPECIFICALLY STATED BY WRITTEN AGREEMENT, THIS DRAWING IS THE SOLE PROPERTY OF GZA GEOENVIRONMENTAL, INC. (GZA). THE INFORMATION SHOWN ON THE DRAWING IS SOLELY FOR USE BY GZA'S CLIENT OR THE CLIENT'S DESIGNATED REPRESENTATIVE FOR THE SPECIFIC PROJECT AND LOCATION IDENTIFIED ON THE DRAWING. THE DRAWING SHALL NOT BE TRANSFERRED, REUSED, COPIED, OR ALTERED IN ANY MANNER FOR USE AT ANY OTHER LOCATION OR FOR ANY OTHER PURPOSE WITHOUT THE PRIOR WRITTEN CONSENT OF GZA. ANY TRANSFER, REUSE, OR MODIFICATION TO THE DRAWING BY THE CLIENT OR OTHERS, WITHOUT THE PRIOR WRITTEN EXPRESS CONSENT OF GZA, WILL BE AT THE USER'S SOLE RISK AND WITHOUT ANY RISK OR LIABILITY TO GZA.

**CHURCH STREET
PROFILE
CHURCH STREET
CULVERT REPLACEMENT
MILFORD, MASSACHUSETTS**

PREPARED BY: GZA GeoEnvironmental, Inc. Engineers and Scientists www.gza.com		PREPARED FOR: TOWN OF MILFORD	
PROJ MGR: TEJ	REVIEWED BY: RS	CHECKED BY: TEJ	
DESIGNED BY: RS	DRAWN BY: EDM	SCALE: AS NOTED	
DATE: DECEMBER, 2011	PROJECT NO: 15.0166148.10	REVISION NO:	3

CHURCH STREET CULVERT REPLACEMENT

MILFORD, MASSACHUSETTS

HAZARD MITIGATION GRANT PROGRAM (HMGP)

"A Federal, State, and Local Partnership through the Federal Emergency Management Agency (FEMA)"



Commonwealth of Massachusetts
DEVAL L. PATRICK, GOVERNOR



Massachusetts Emergency Management Agency
KURT N. SCHWARTZ, DIRECTOR



Town of Milford, Massachusetts
LOUIS CELOZZI, TOWN ADMINISTRATOR




Department of Conservation and Recreation
EDWARD M. LAMBERT JR., COMMISSIONER

PROJECT SIGN DETAIL


PROJECT SIGN NOTES:

- BACKGROUND IS IVORY WITH DARK GREEN LETTERING.
- THE SIGN SHALL BE ERRECTED AT A SUITABLE LOCATION NEAR THE PROJECT SITE TO BE APPROVED BY THE ENGINEER.

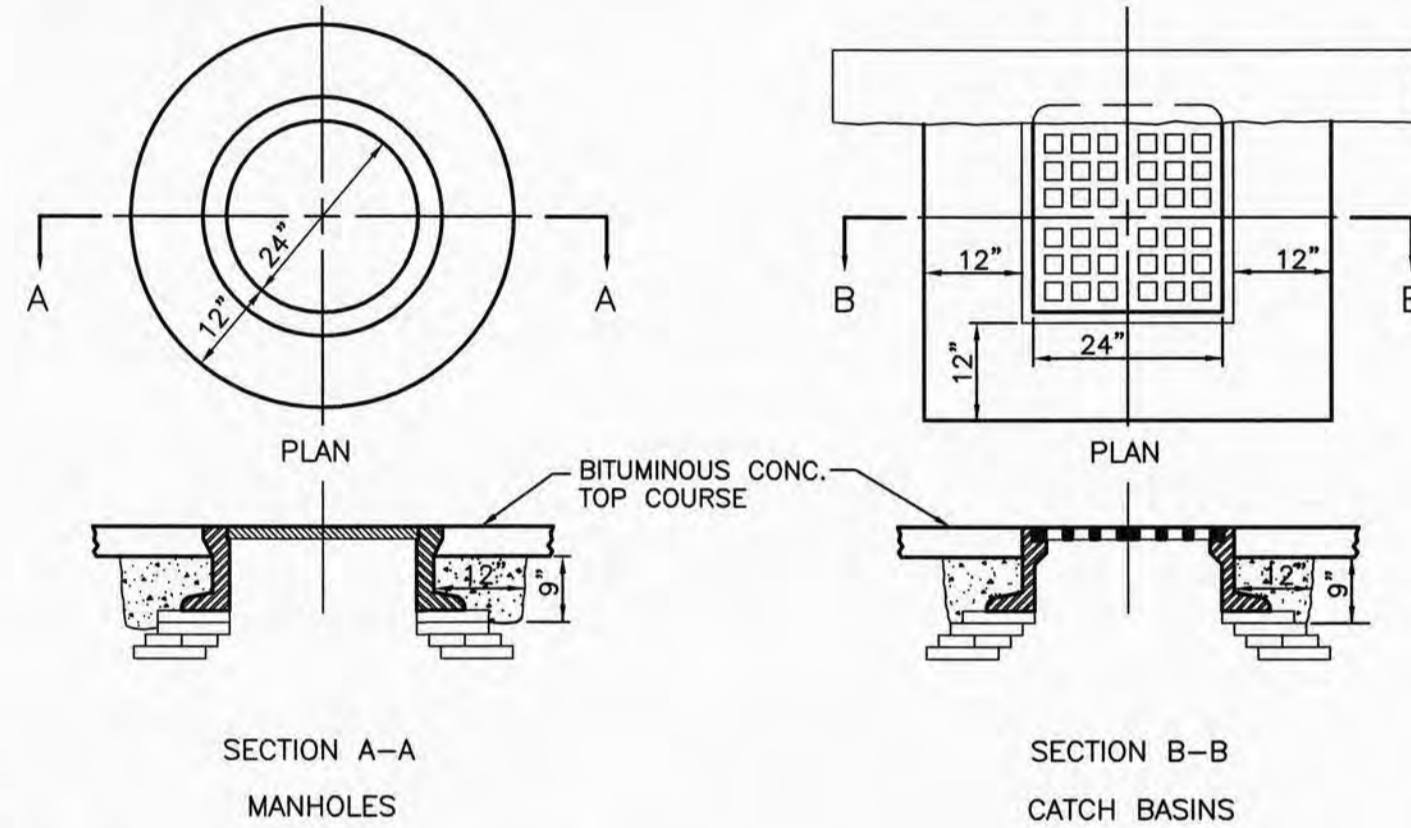


- NOTES:
- COLLARS TO BE CLASS A CEMENT CONCRETE MASONRY REGULAR OR HIGH EARLY STRENGTH AS DIRECTED.
 - NO CONCRETE COLLAR REQUIRED IN CONCRETE PAVEMENT.

CONCRETE COLLARS

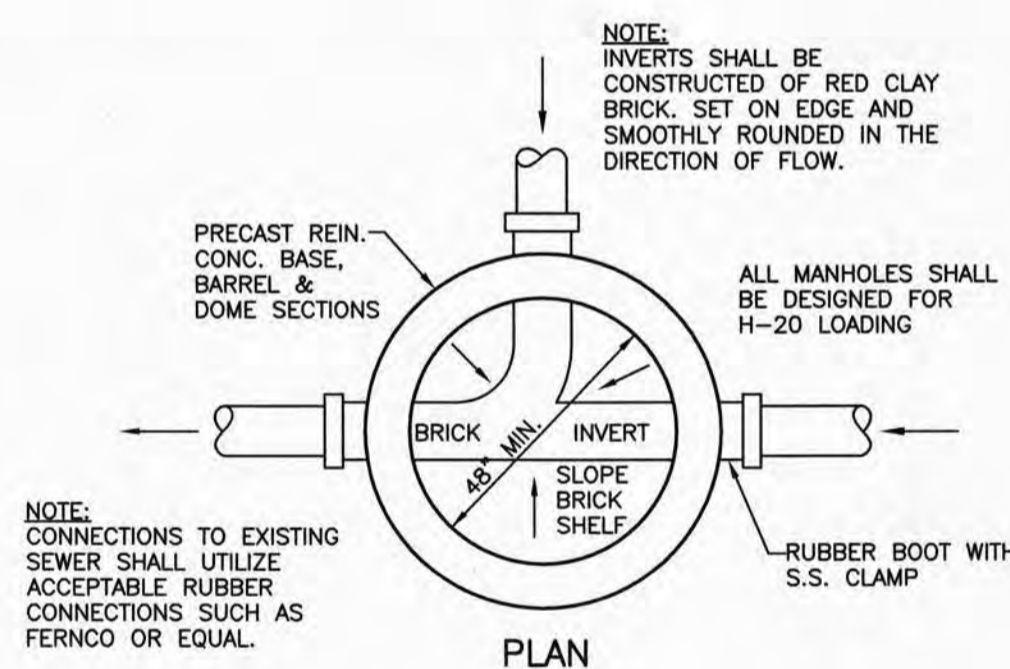



NOTE: ADJUSTMENT BRICK SHALL BE RED CLAY, HARD BURNED, SEWER BRICK.

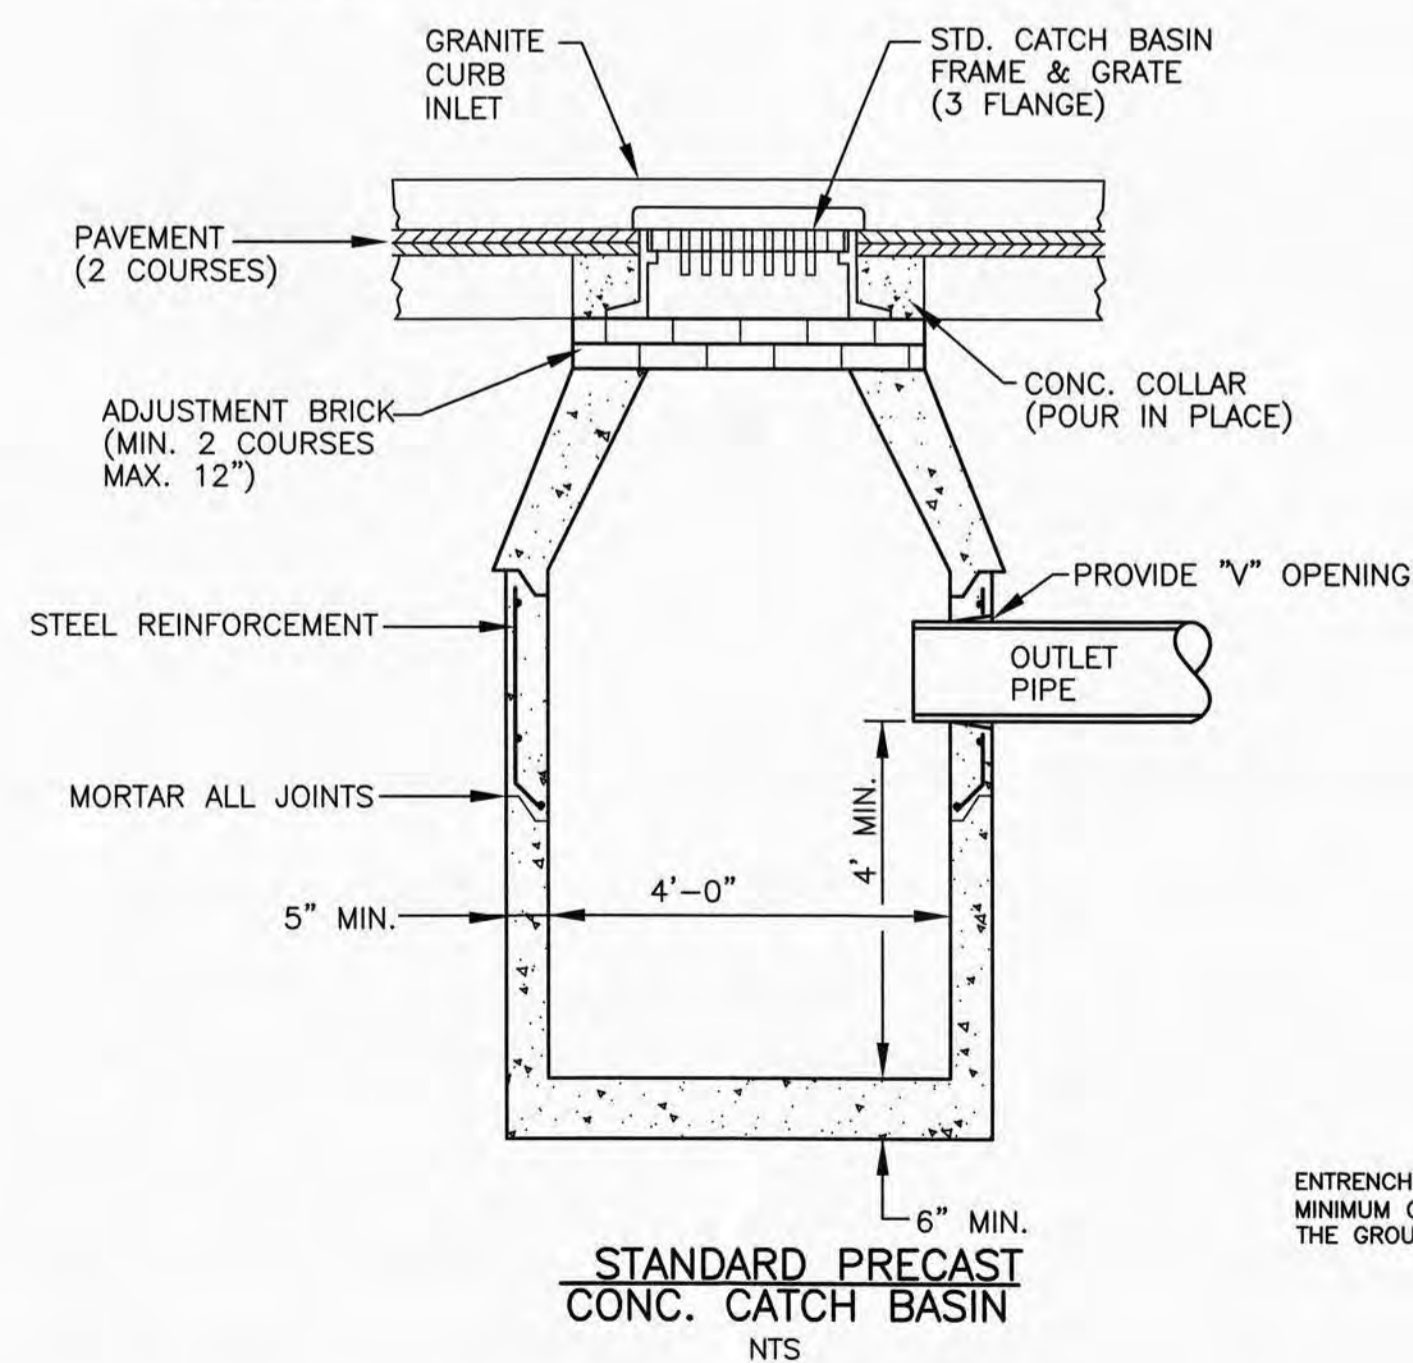



STANDARD PRECAST CONC. CATCH BASIN

TYPICAL PRECAST CONCRETE SANITARY MANHOLE


NOTE:
ALL STRUCTURES SHALL BE SUITABLE FOR H-20 LOADING AND SHALL MEET THE REQUIREMENTS OF ASTM C478.

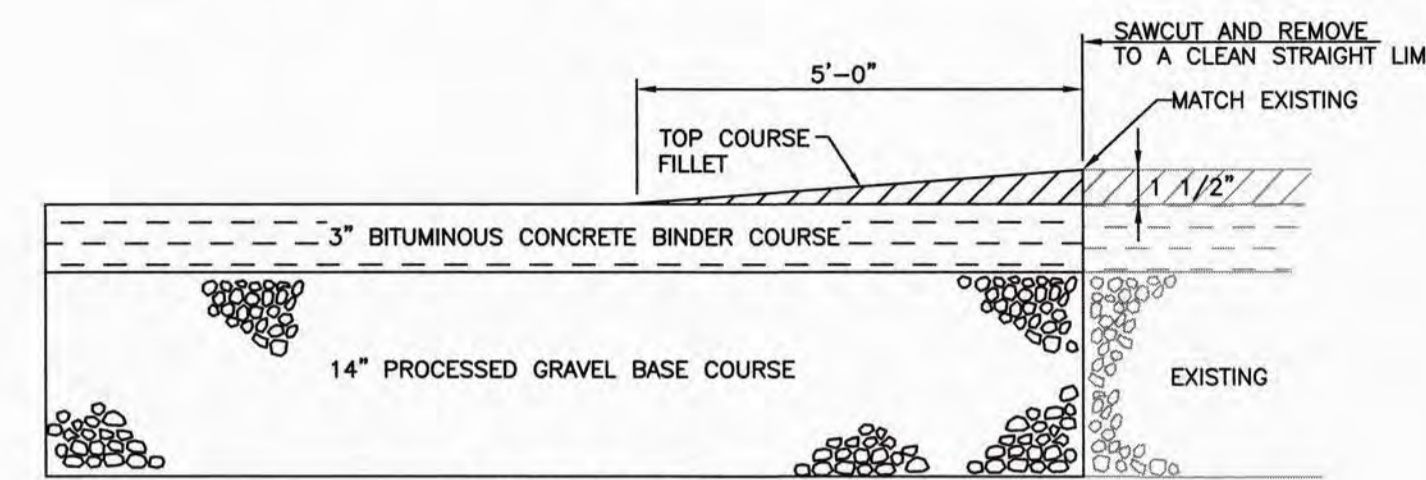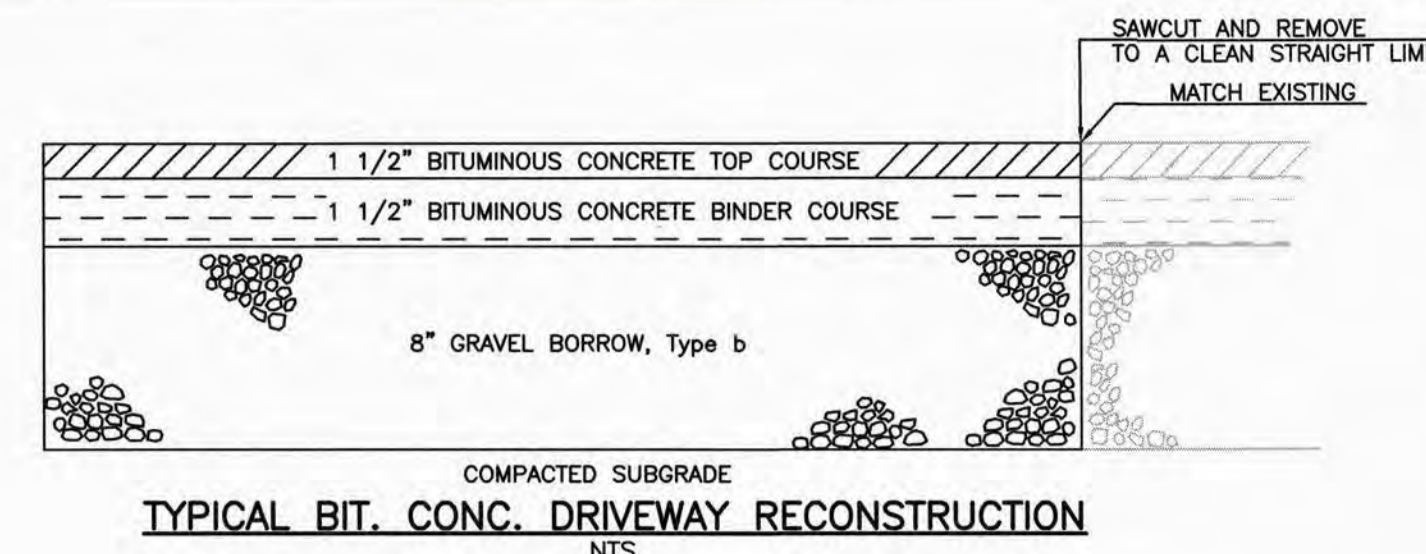




TYPICAL TRENCH DETAIL

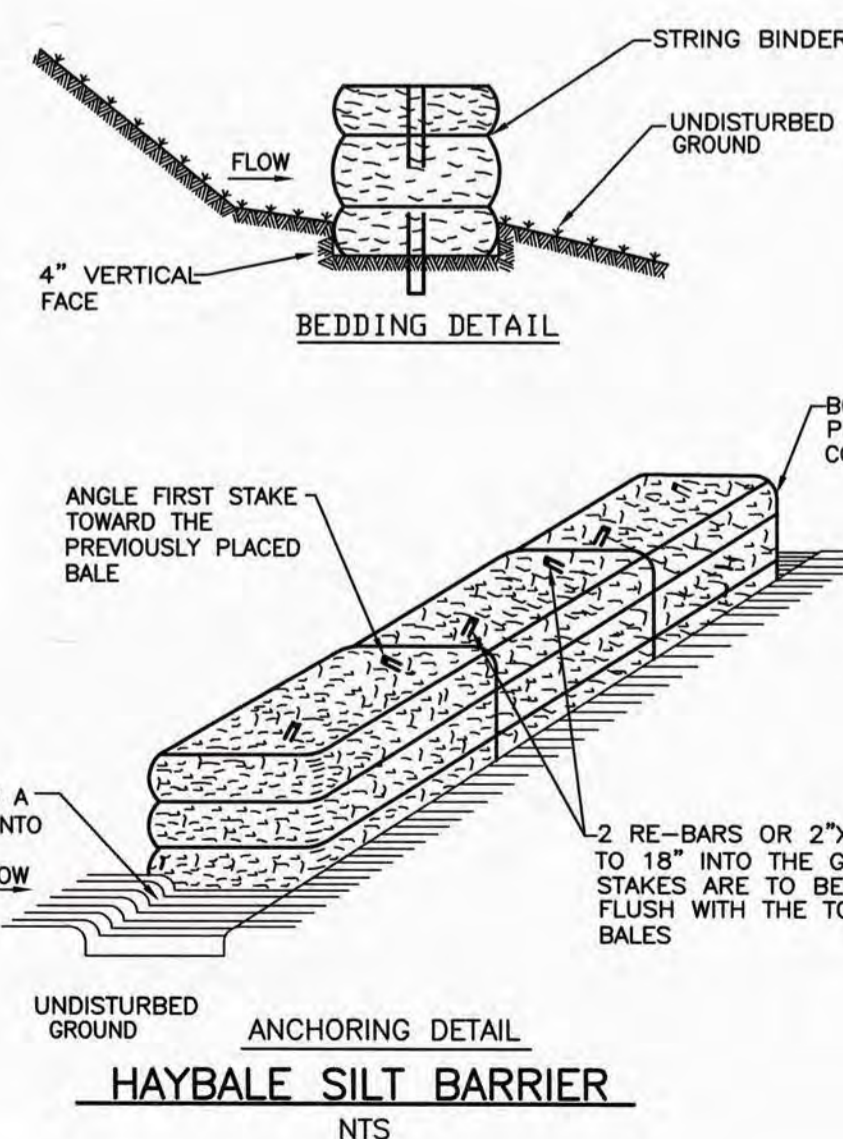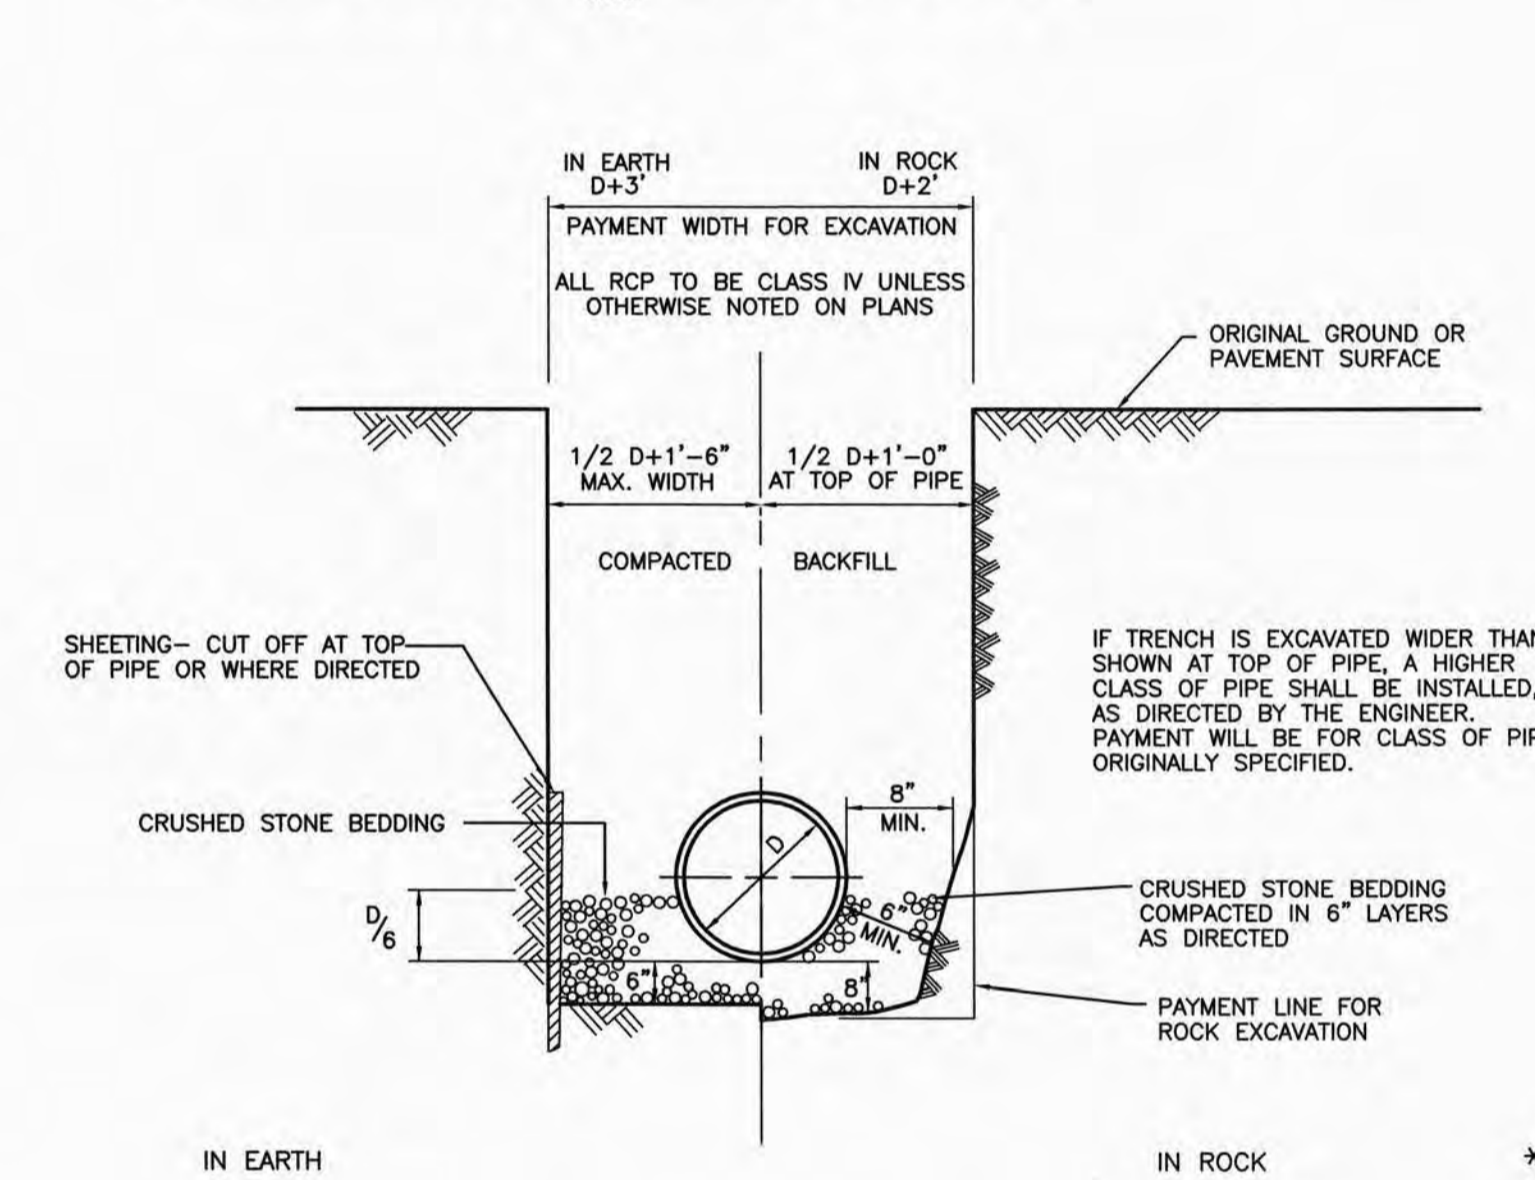

HAYBALE SILT BARRIER

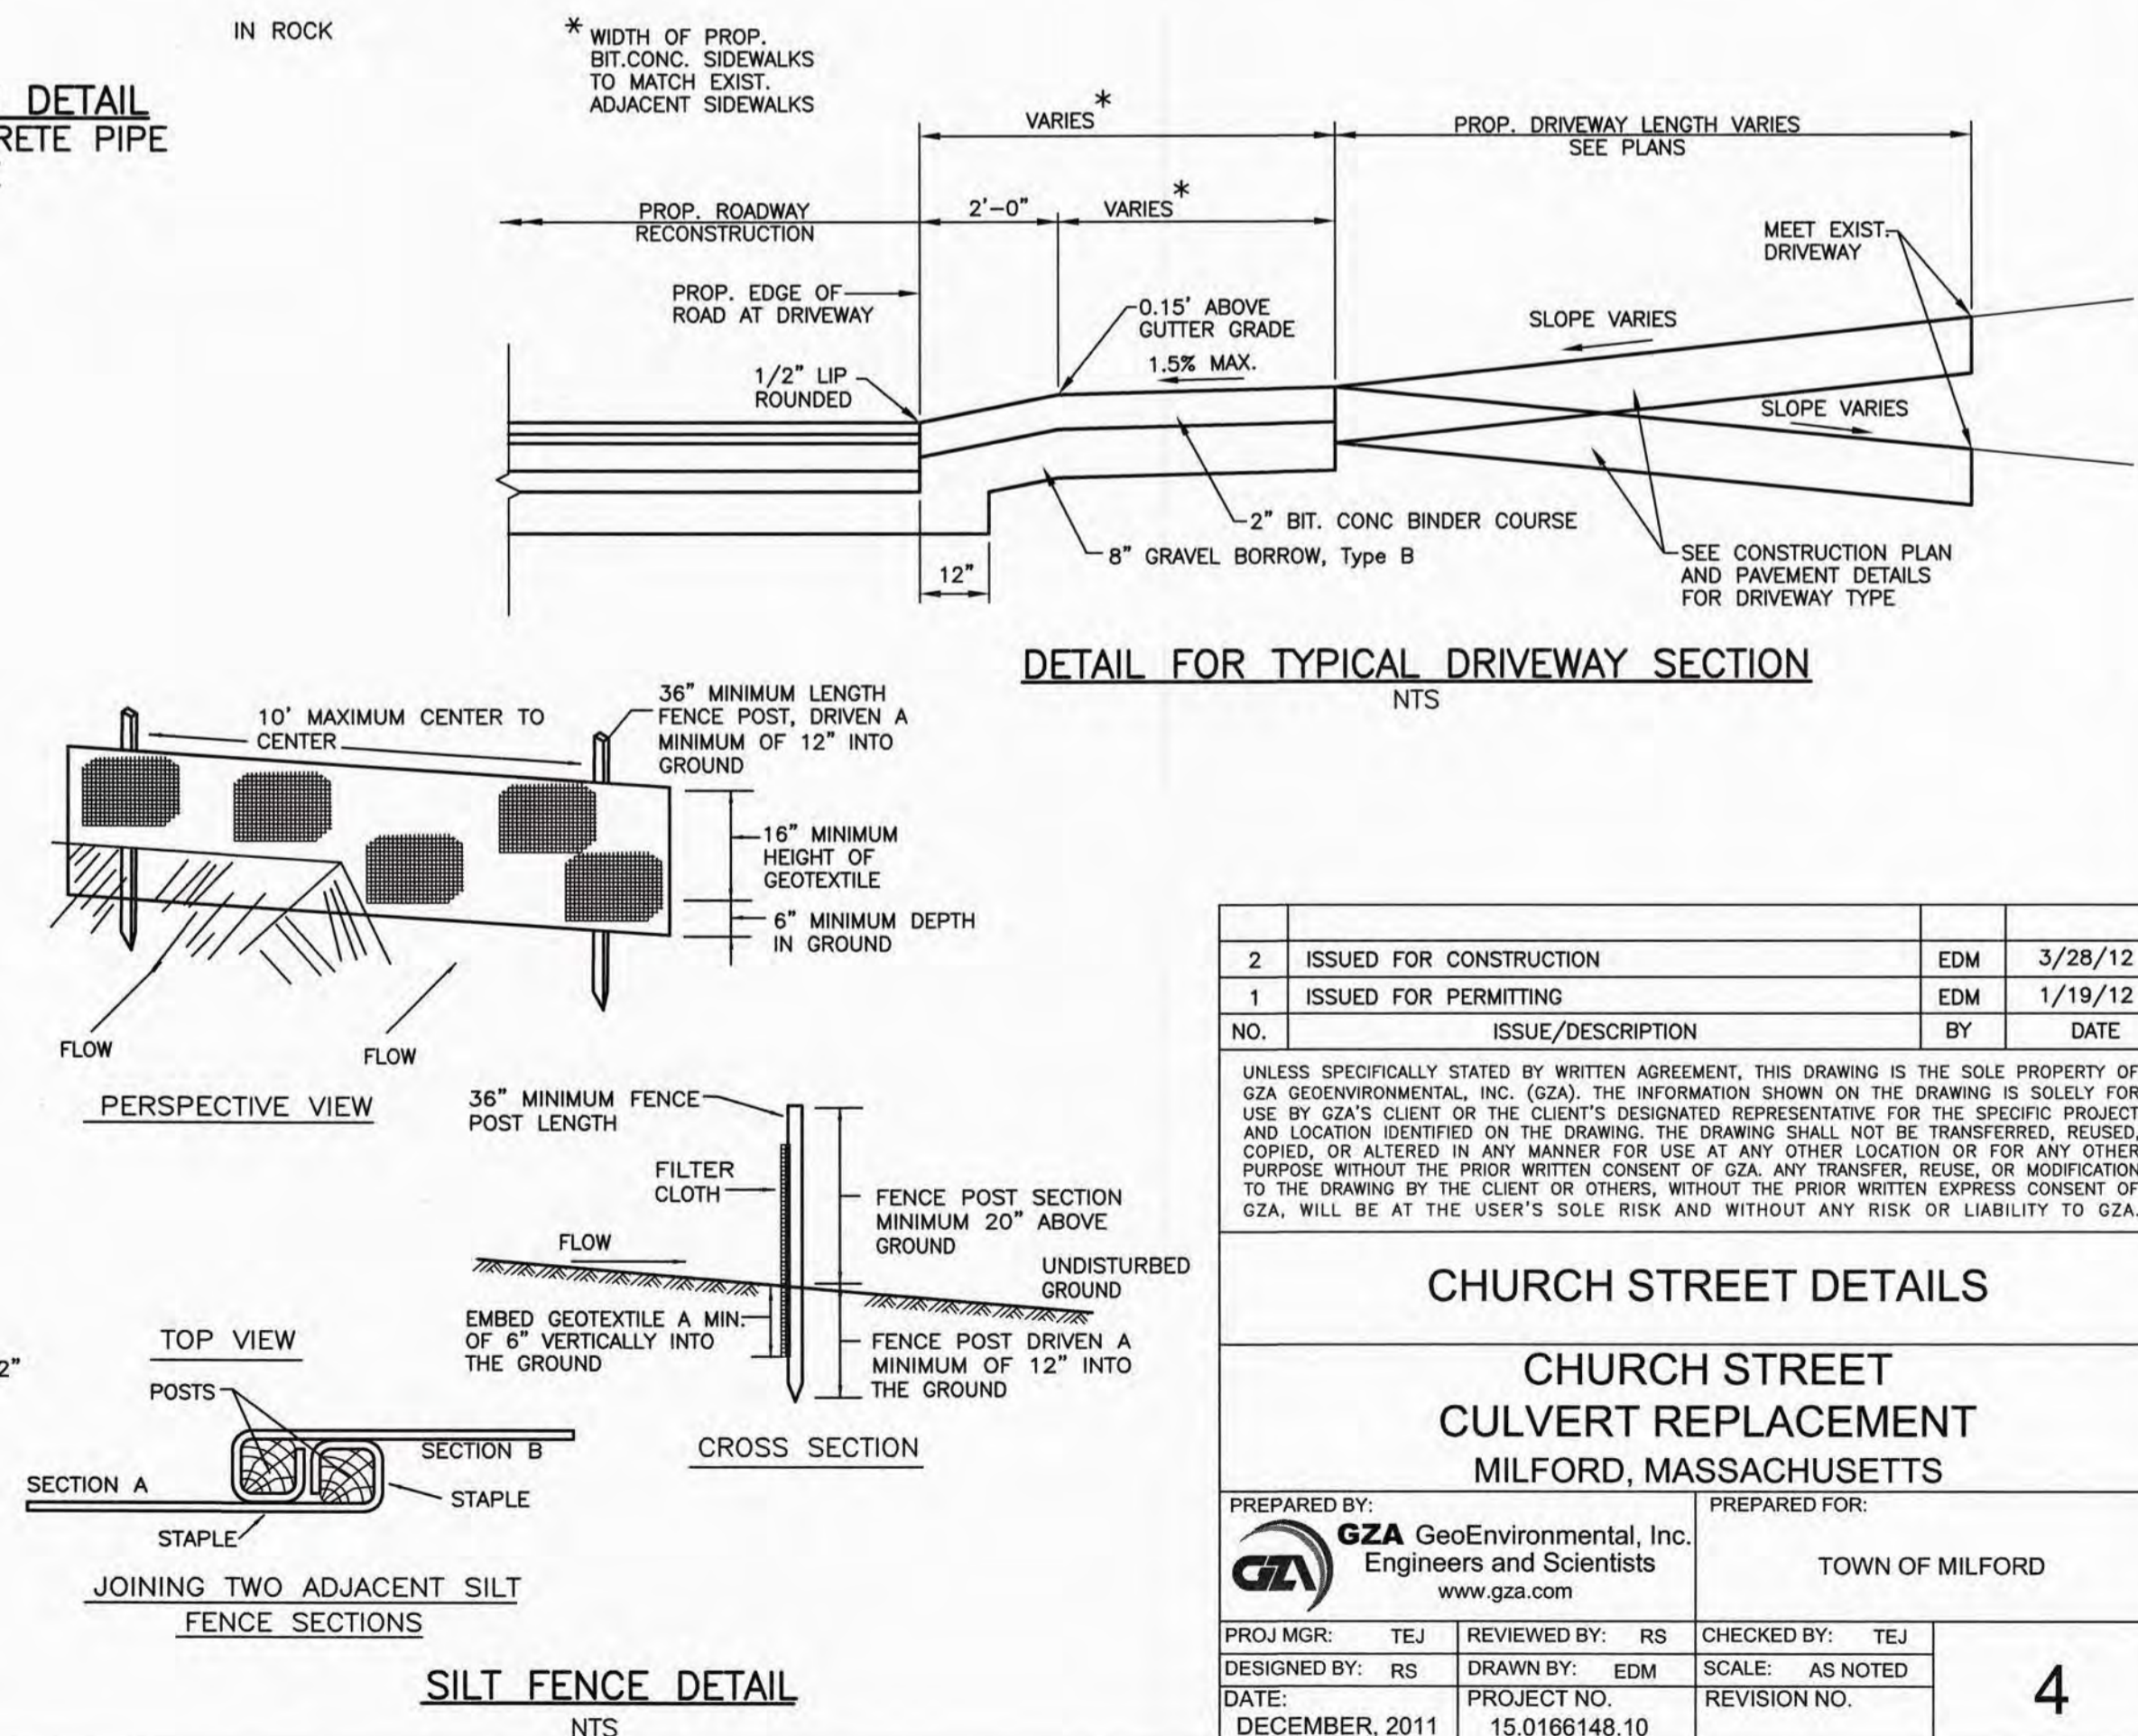

SILT FENCE DETAIL

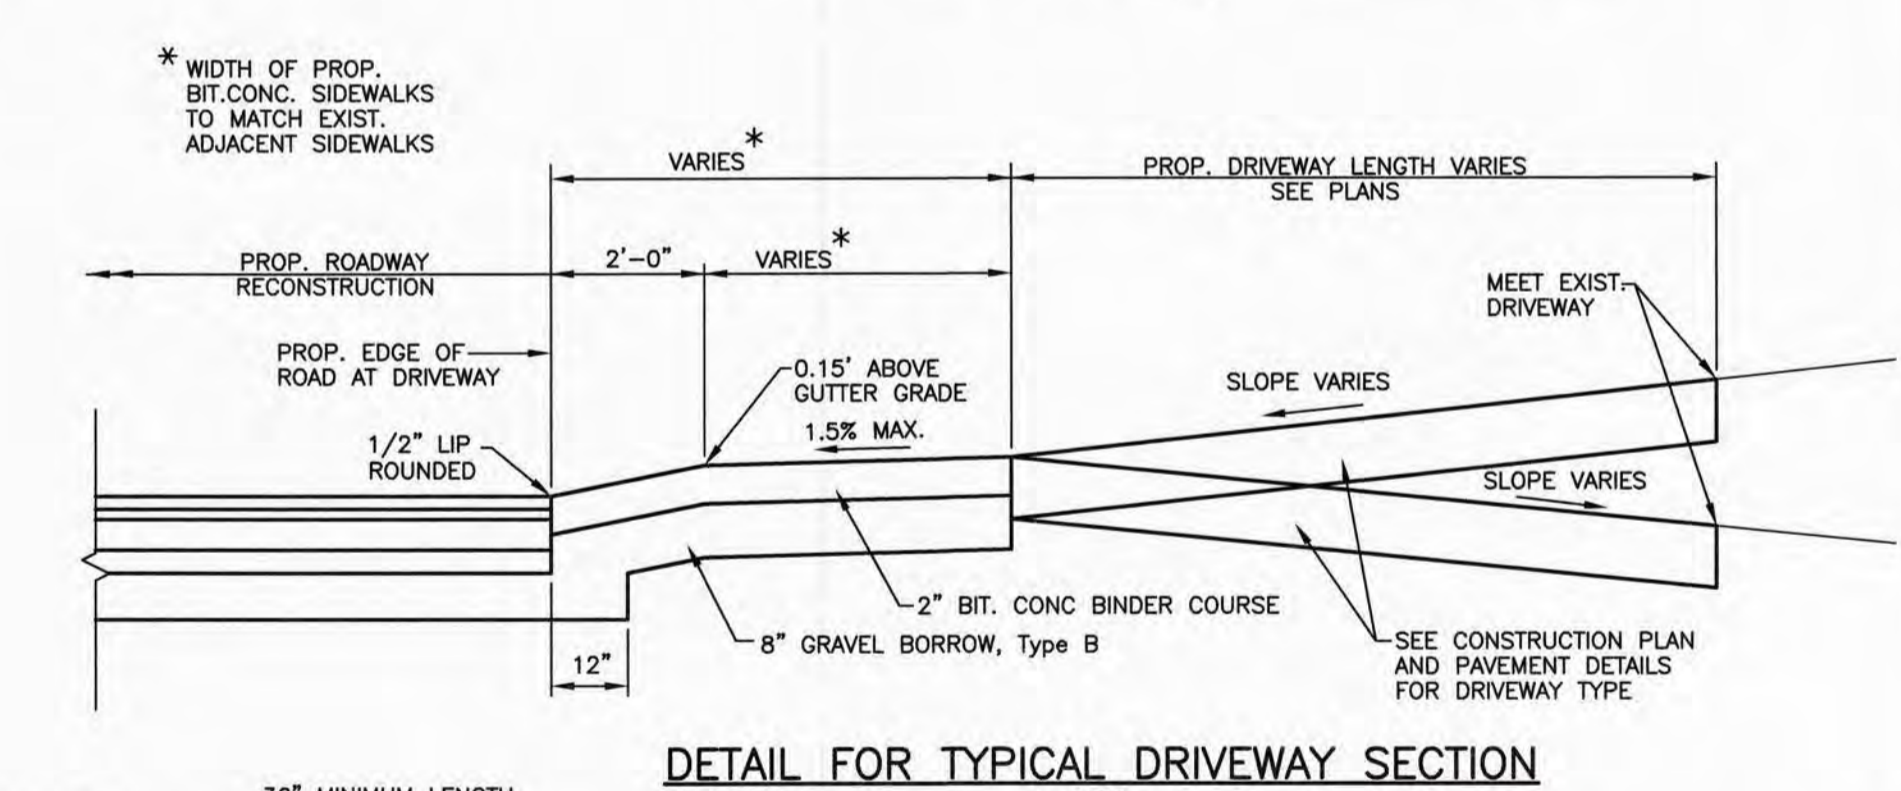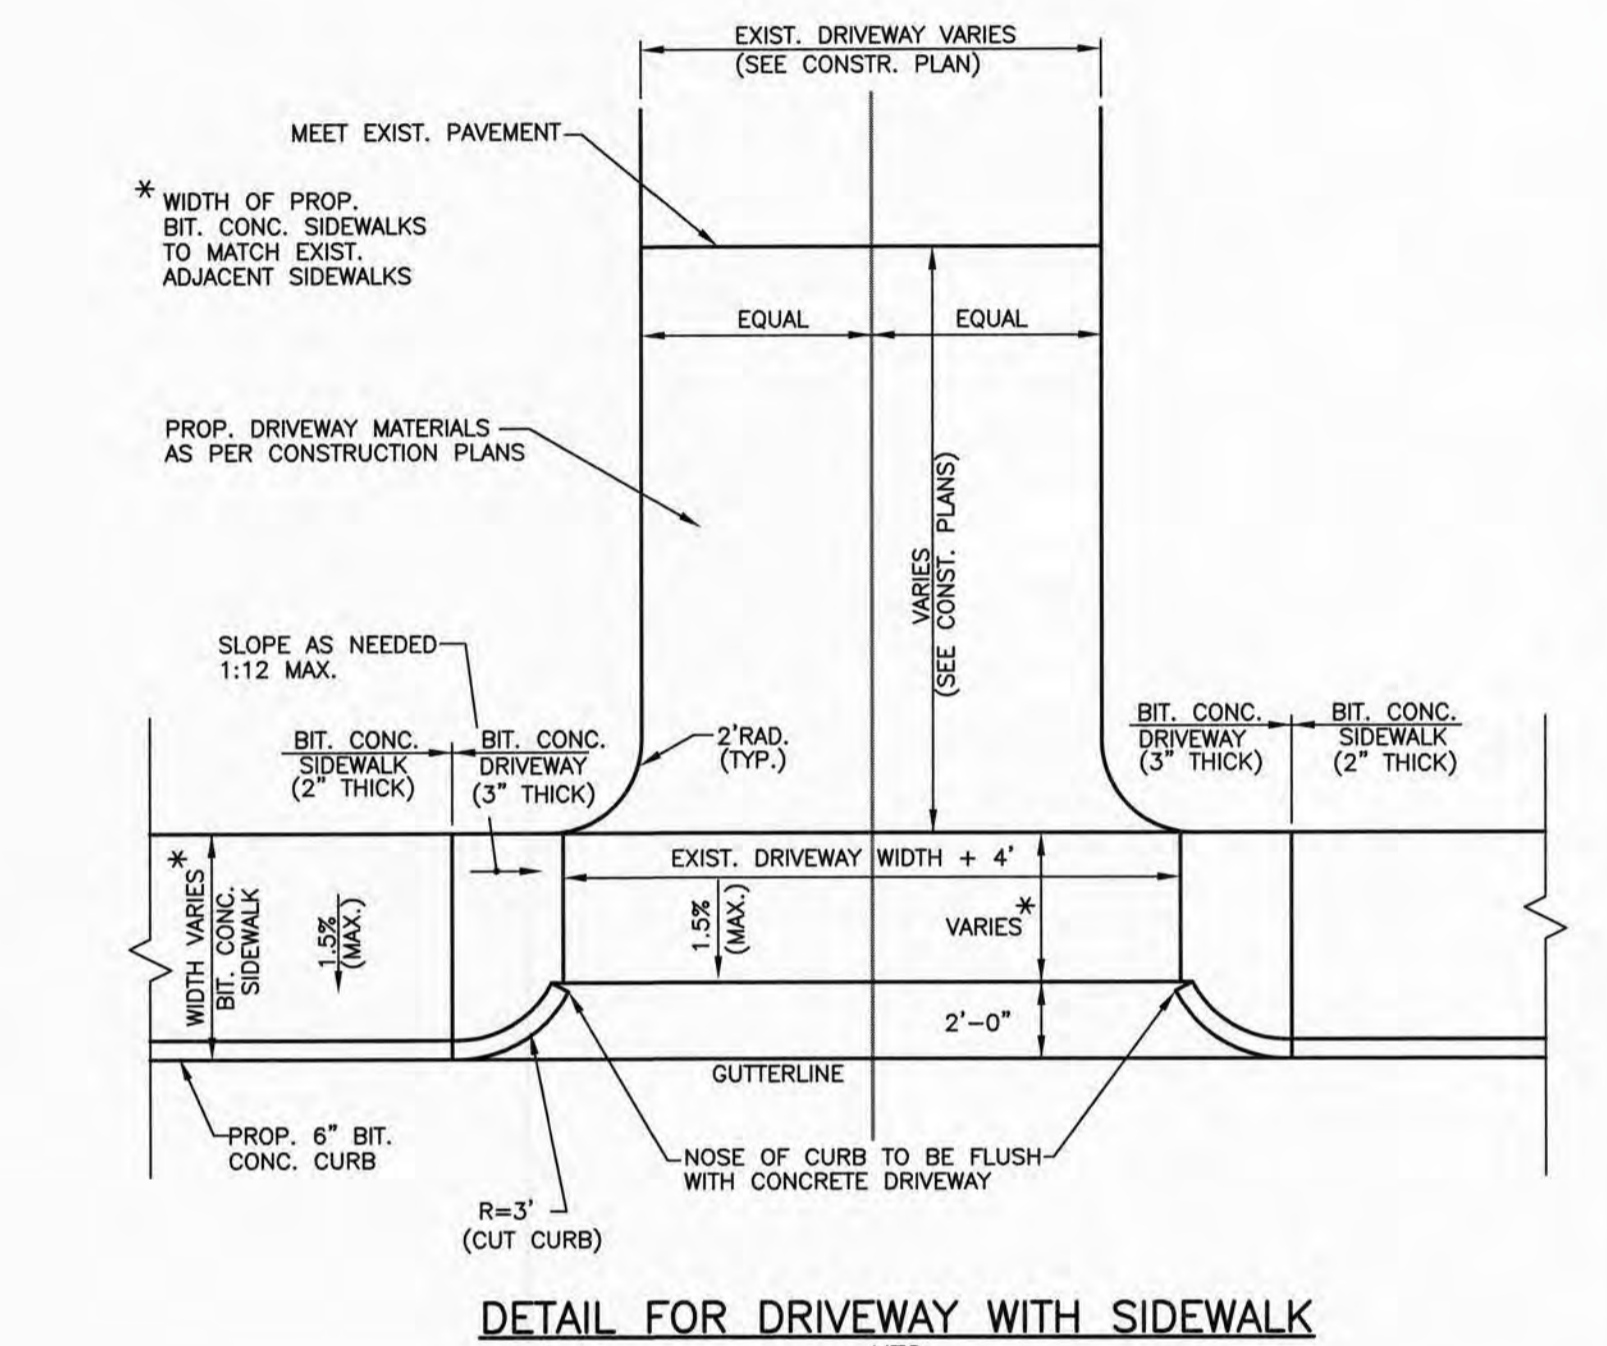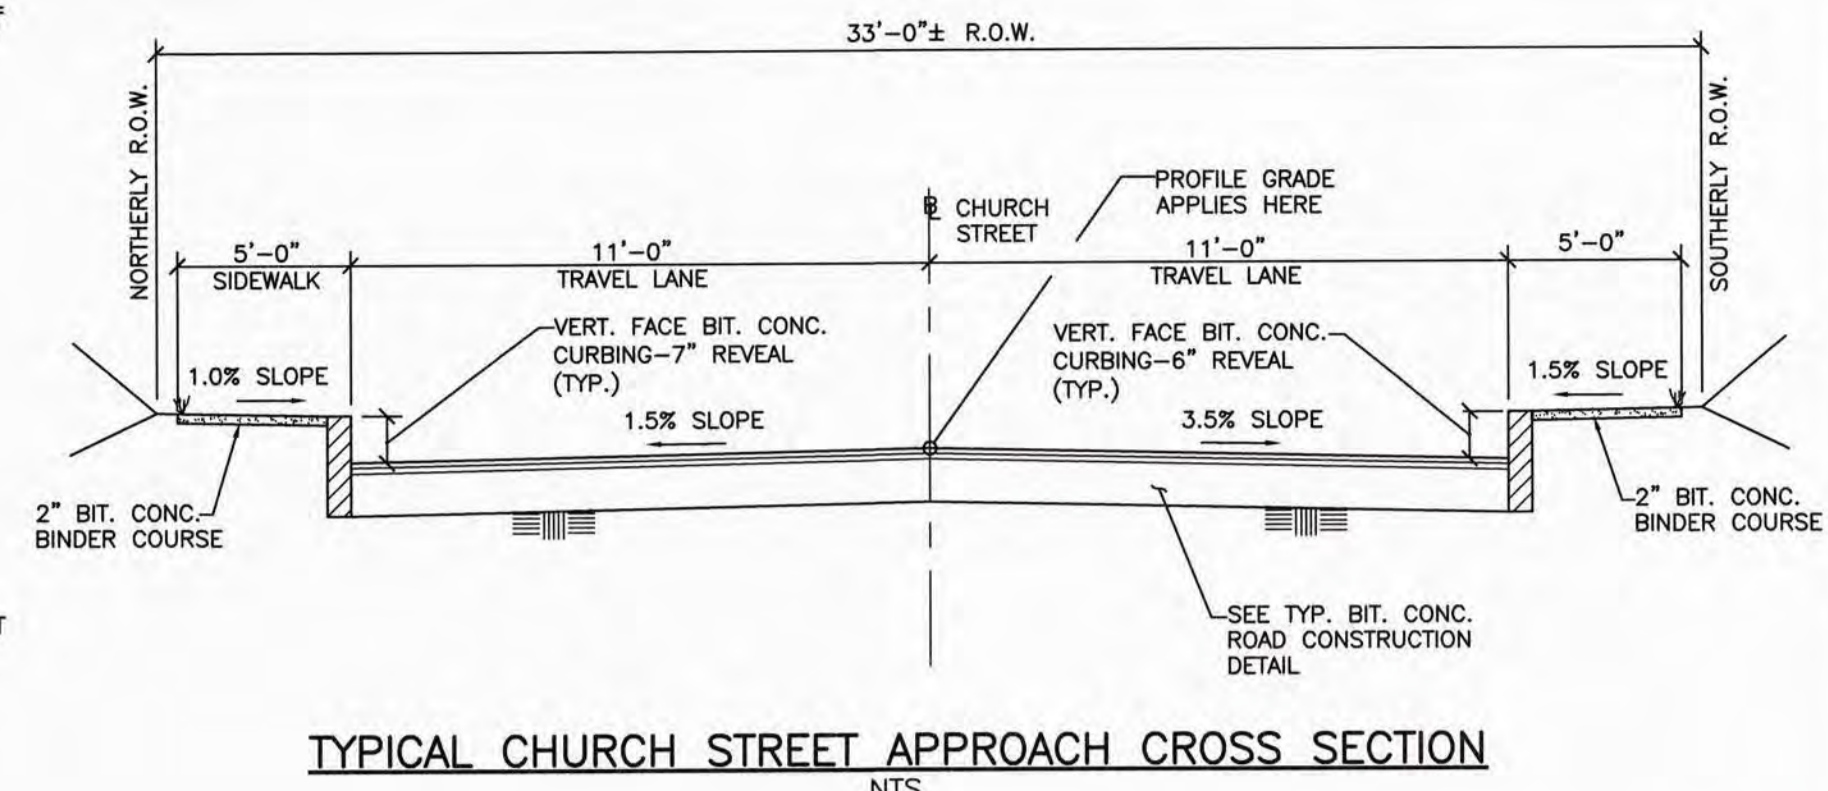

NO.	ISSUE/DESCRIPTION	BY	DATE
2	ISSUED FOR CONSTRUCTION	EDM	3/28/12
1	ISSUED FOR PERMITTING	EDM	1/19/12

UNLESS SPECIFICALLY STATED BY WRITTEN AGREEMENT, THIS DRAWING IS THE SOLE PROPERTY OF GZA GEOENVIRONMENTAL, INC. (GZA). THE INFORMATION SHOWN ON THE DRAWING IS SOLELY FOR USE BY GZA'S CLIENT OR THE CLIENT'S DESIGNATED REPRESENTATIVE FOR THE SPECIFIC PROJECT AND LOCATION IDENTIFIED ON THE DRAWING. THE DRAWING SHALL NOT BE TRANSFERRED, REUSED, COPIED, OR ALTERED IN ANY MANNER FOR USE AT ANY OTHER LOCATION OR FOR ANY OTHER PURPOSE WITHOUT THE PRIOR WRITTEN CONSENT OF GZA. ANY TRANSFER, REUSE, OR MODIFICATION TO THE DRAWING BY THE CLIENT OR OTHERS, WITHOUT THE PRIOR WRITTEN EXPRESS CONSENT OF GZA, WILL BE AT THE USER'S SOLE RISK AND WITHOUT ANY RISK OR LIABILITY TO GZA.

CHURCH STREET DETAILS


CHURCH STREET CULVERT REPLACEMENT

MILFORD, MASSACHUSETTS


PREPARED BY: GZA GeoEnvironmental, Inc. Engineers and Scientists
www.gza.com

PREPARED FOR: TOWN OF MILFORD

PROJ MGR: TEJ	DESIGNED BY: RS	DATE: DECEMBER, 2011	REVIEWED BY: RS	DRAWN BY: EDM	PROJECT NO: 15.0166148.10	CHECKED BY: TEJ	SCALE: AS NOTED	REVISION NO.
---------------	-----------------	----------------------	-----------------	---------------	---------------------------	-----------------	-----------------	--------------

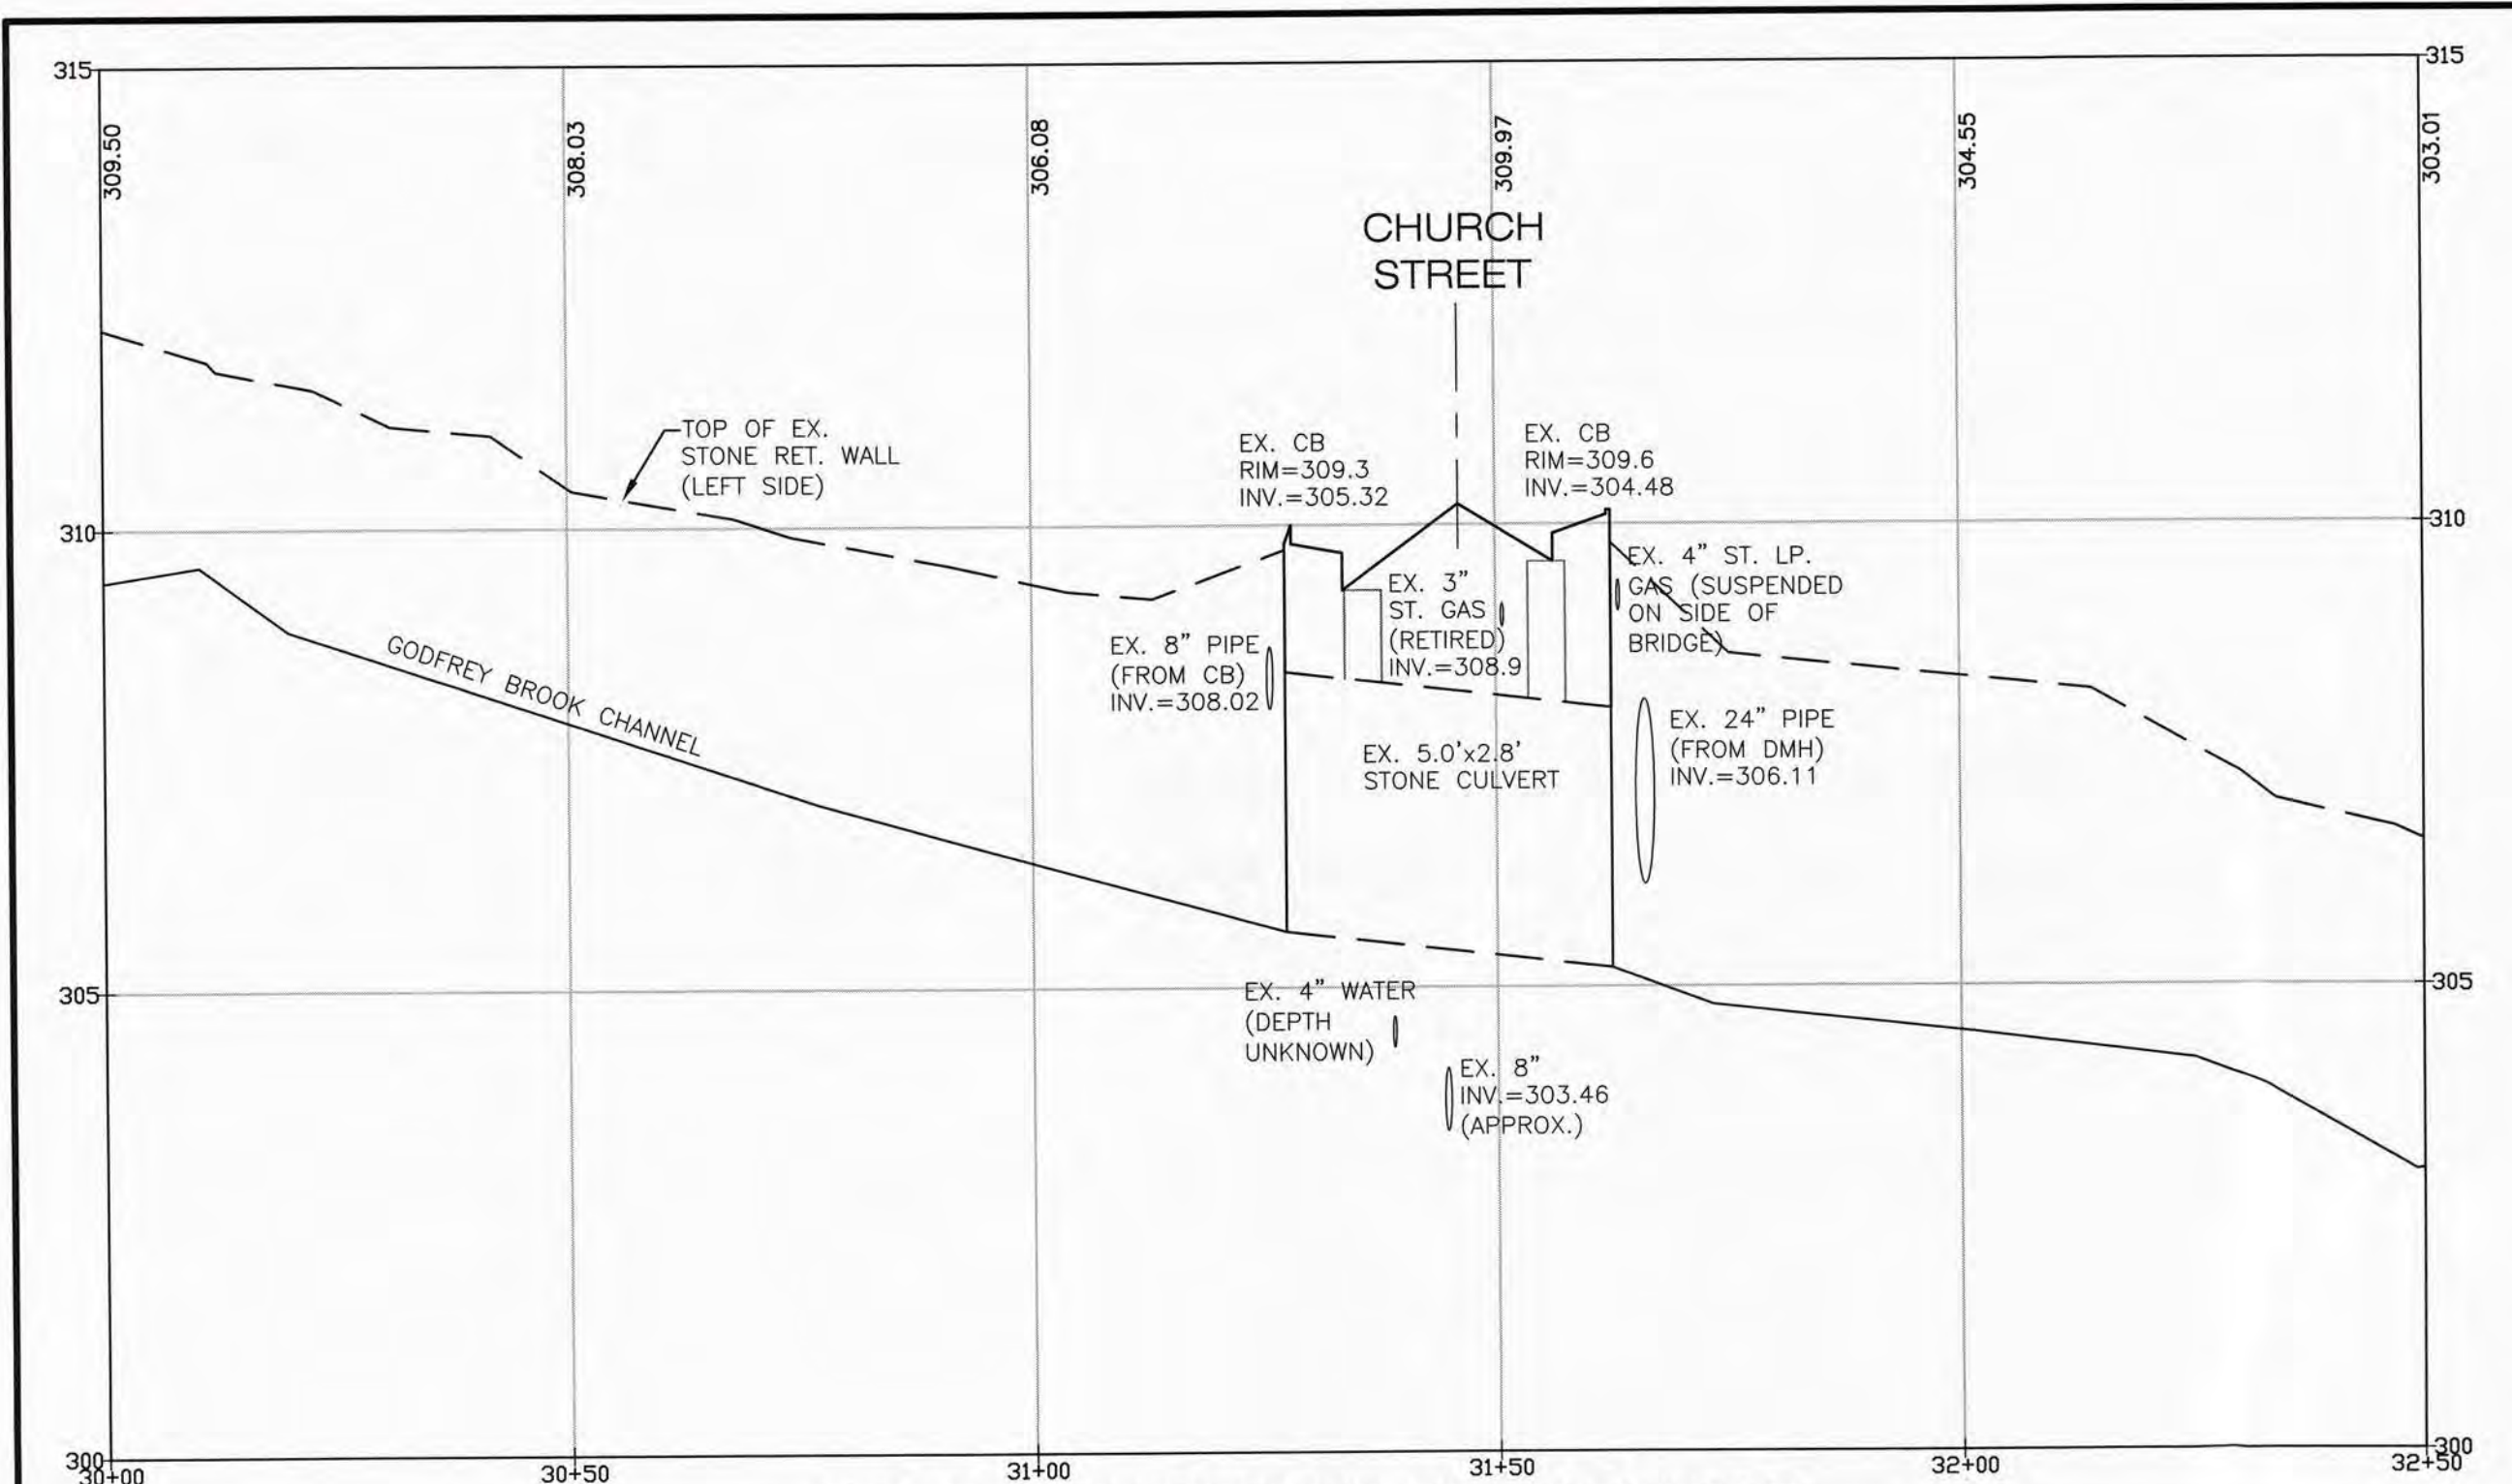

PROFILE-GODFREY BROOK EXISTING CULVERT
VERT. 1"=2'
HOR. 1"=20'

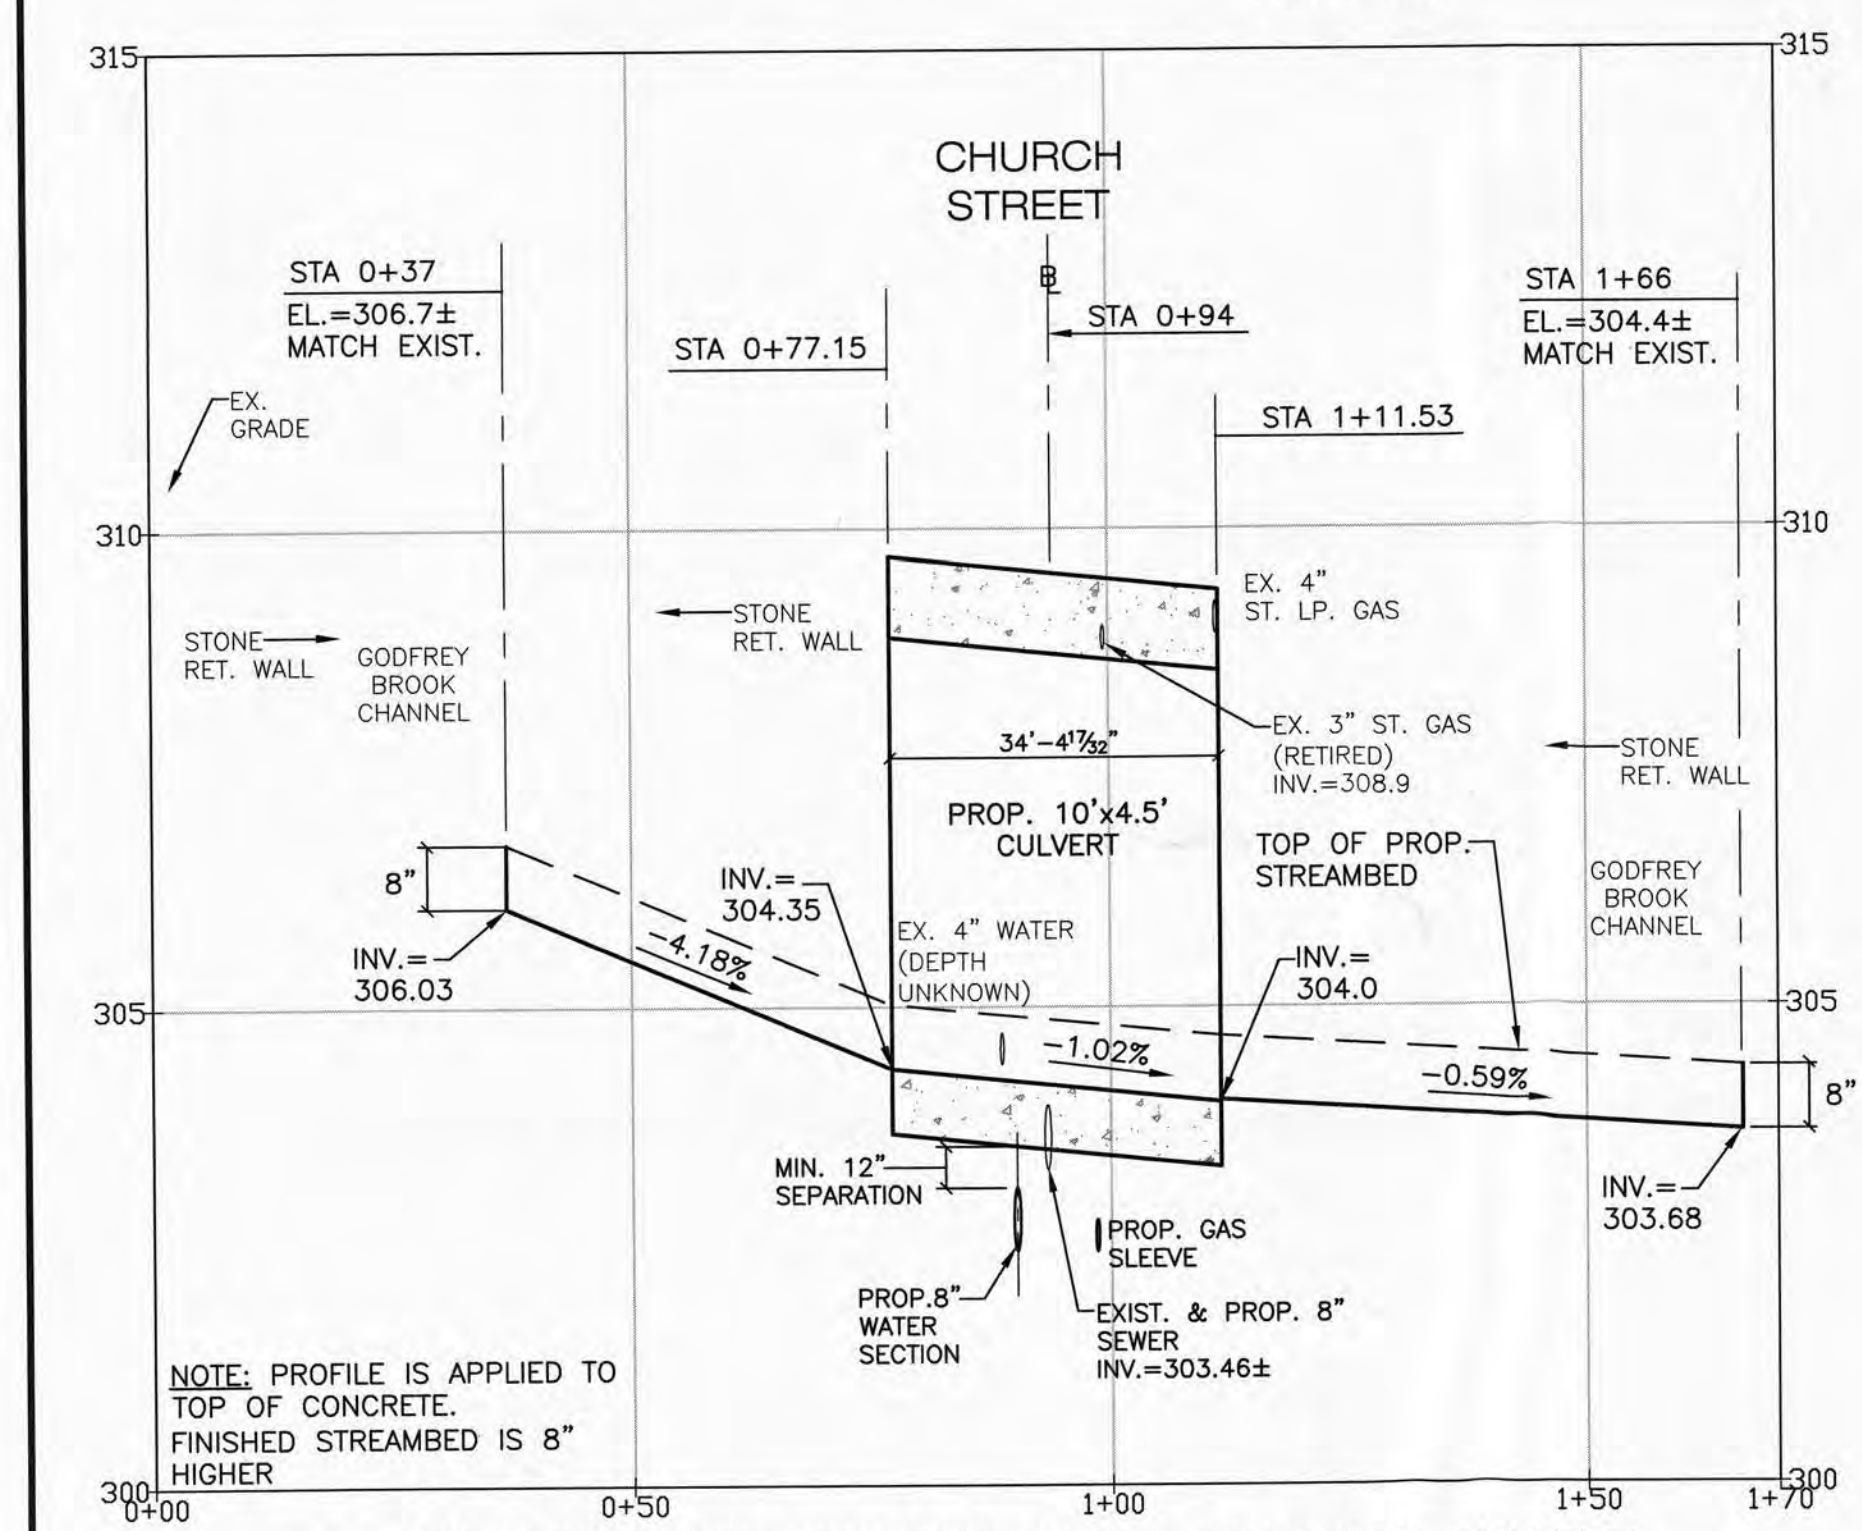


PROFILE-RELOCATED GODFREY BROOK PROPOSED CULVERT
VERT. 1"=2'
HOR. 1"=20'

PRECAST DESIGN NOTES:


CONCRETE MINIMUM STRENGTH = 5000 PSI @ 28 DAYS
 STEEL REINFORCEMENT - ASTM A615, GRADE 60
 WHEEL LOADING - AASHTO HS20-44 + IMPACT COVER TO STEEL - 1.5 INCHES
 EARTH COVER - 0'-0"
 UNIT WEIGHT OF EARTH - 125 POUNDS PER CUBIC FOOT
 ACTIVE PRESSURE COEFFICIENT - 0.25 MIN., 0.5 MAX.
 DESIGN SHALL BE IN ACCORDANCE WITH AASHTO SPECIFICATIONS FOR HIGHWAY BRIDGES, ACI 318-83, AND LOAD FACTOR DESIGN (AASHTO) U-SHAPED CHANNEL: DESIGN FOR 2' LIVELOAD SURCHARGE

CAST-IN-PLACE CONCRETE NOTES


CONCRETE MINIMUM STRENGTH = 4,000 PSI @ 28 DAYS
 STEEL REINFORCEMENT - ASTM A615, GRADE 60, EPOXY COATED

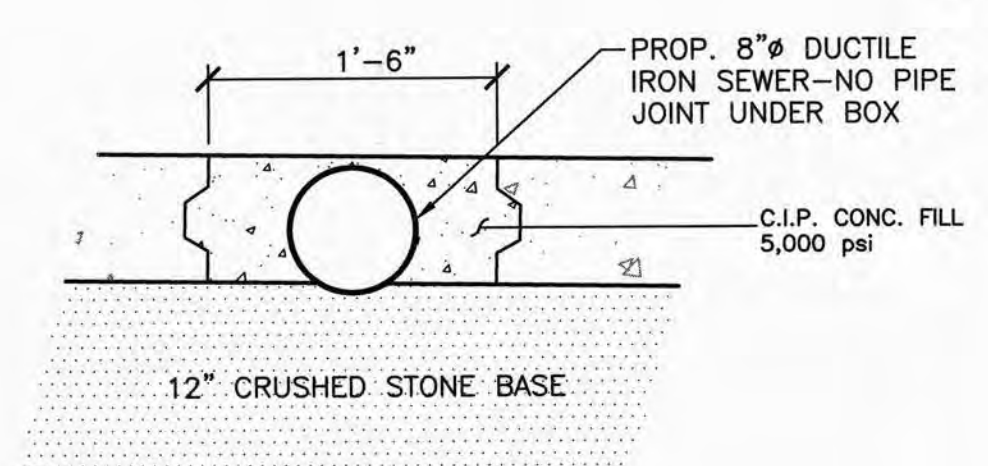


DETAIL AT SEWER
1"=1"

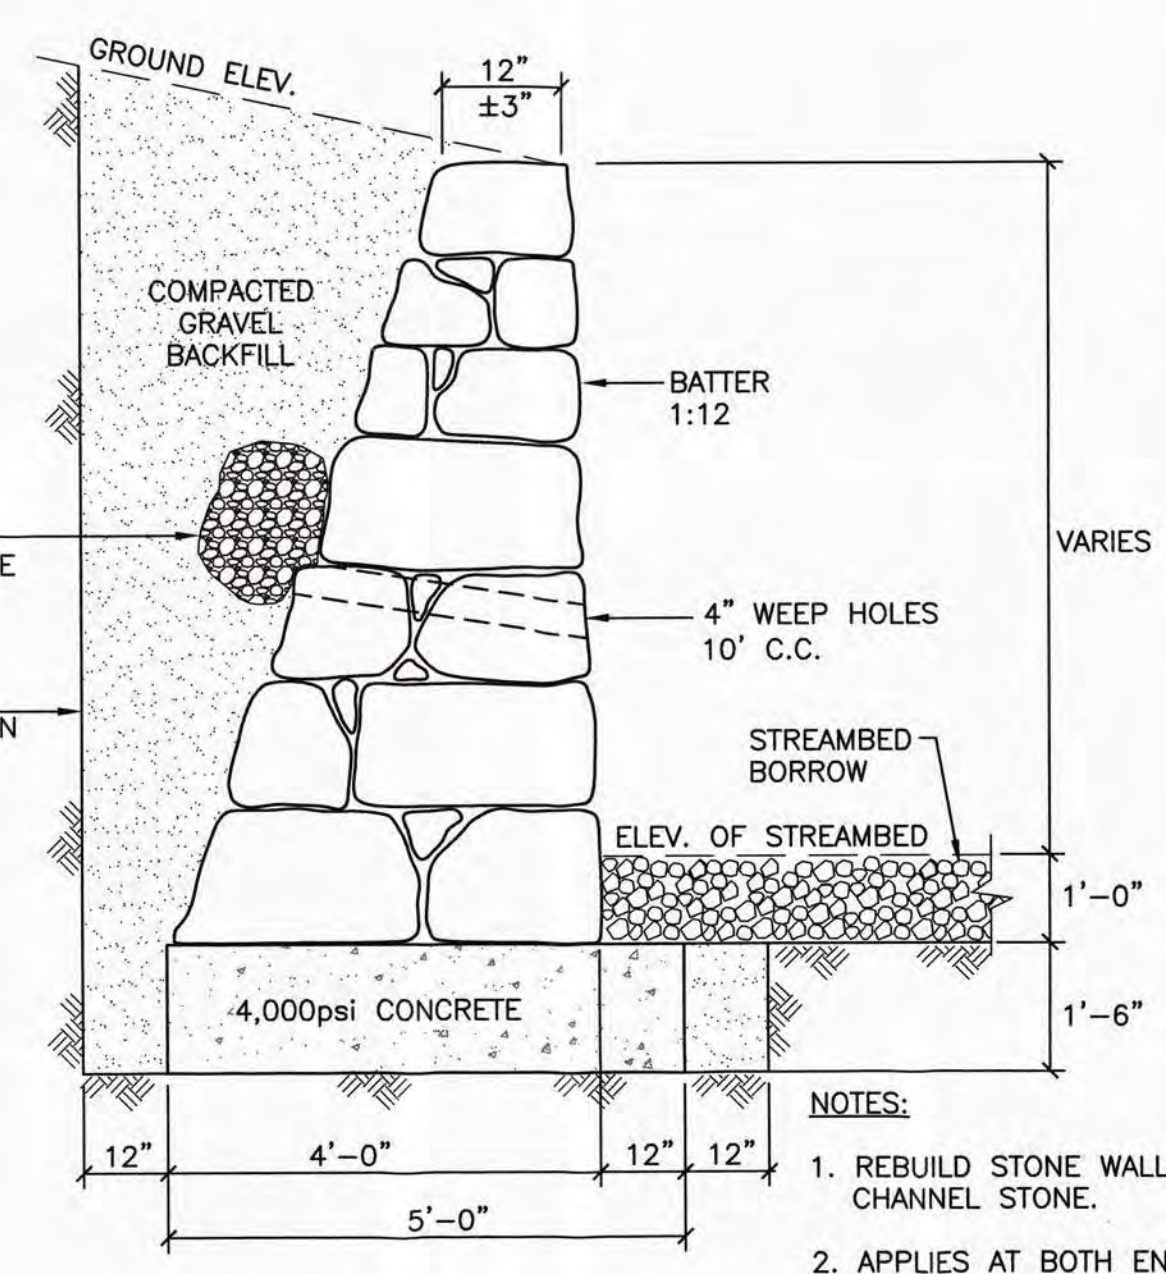


TYPICAL CEMENTED STONE MASONRY WALL
NTS

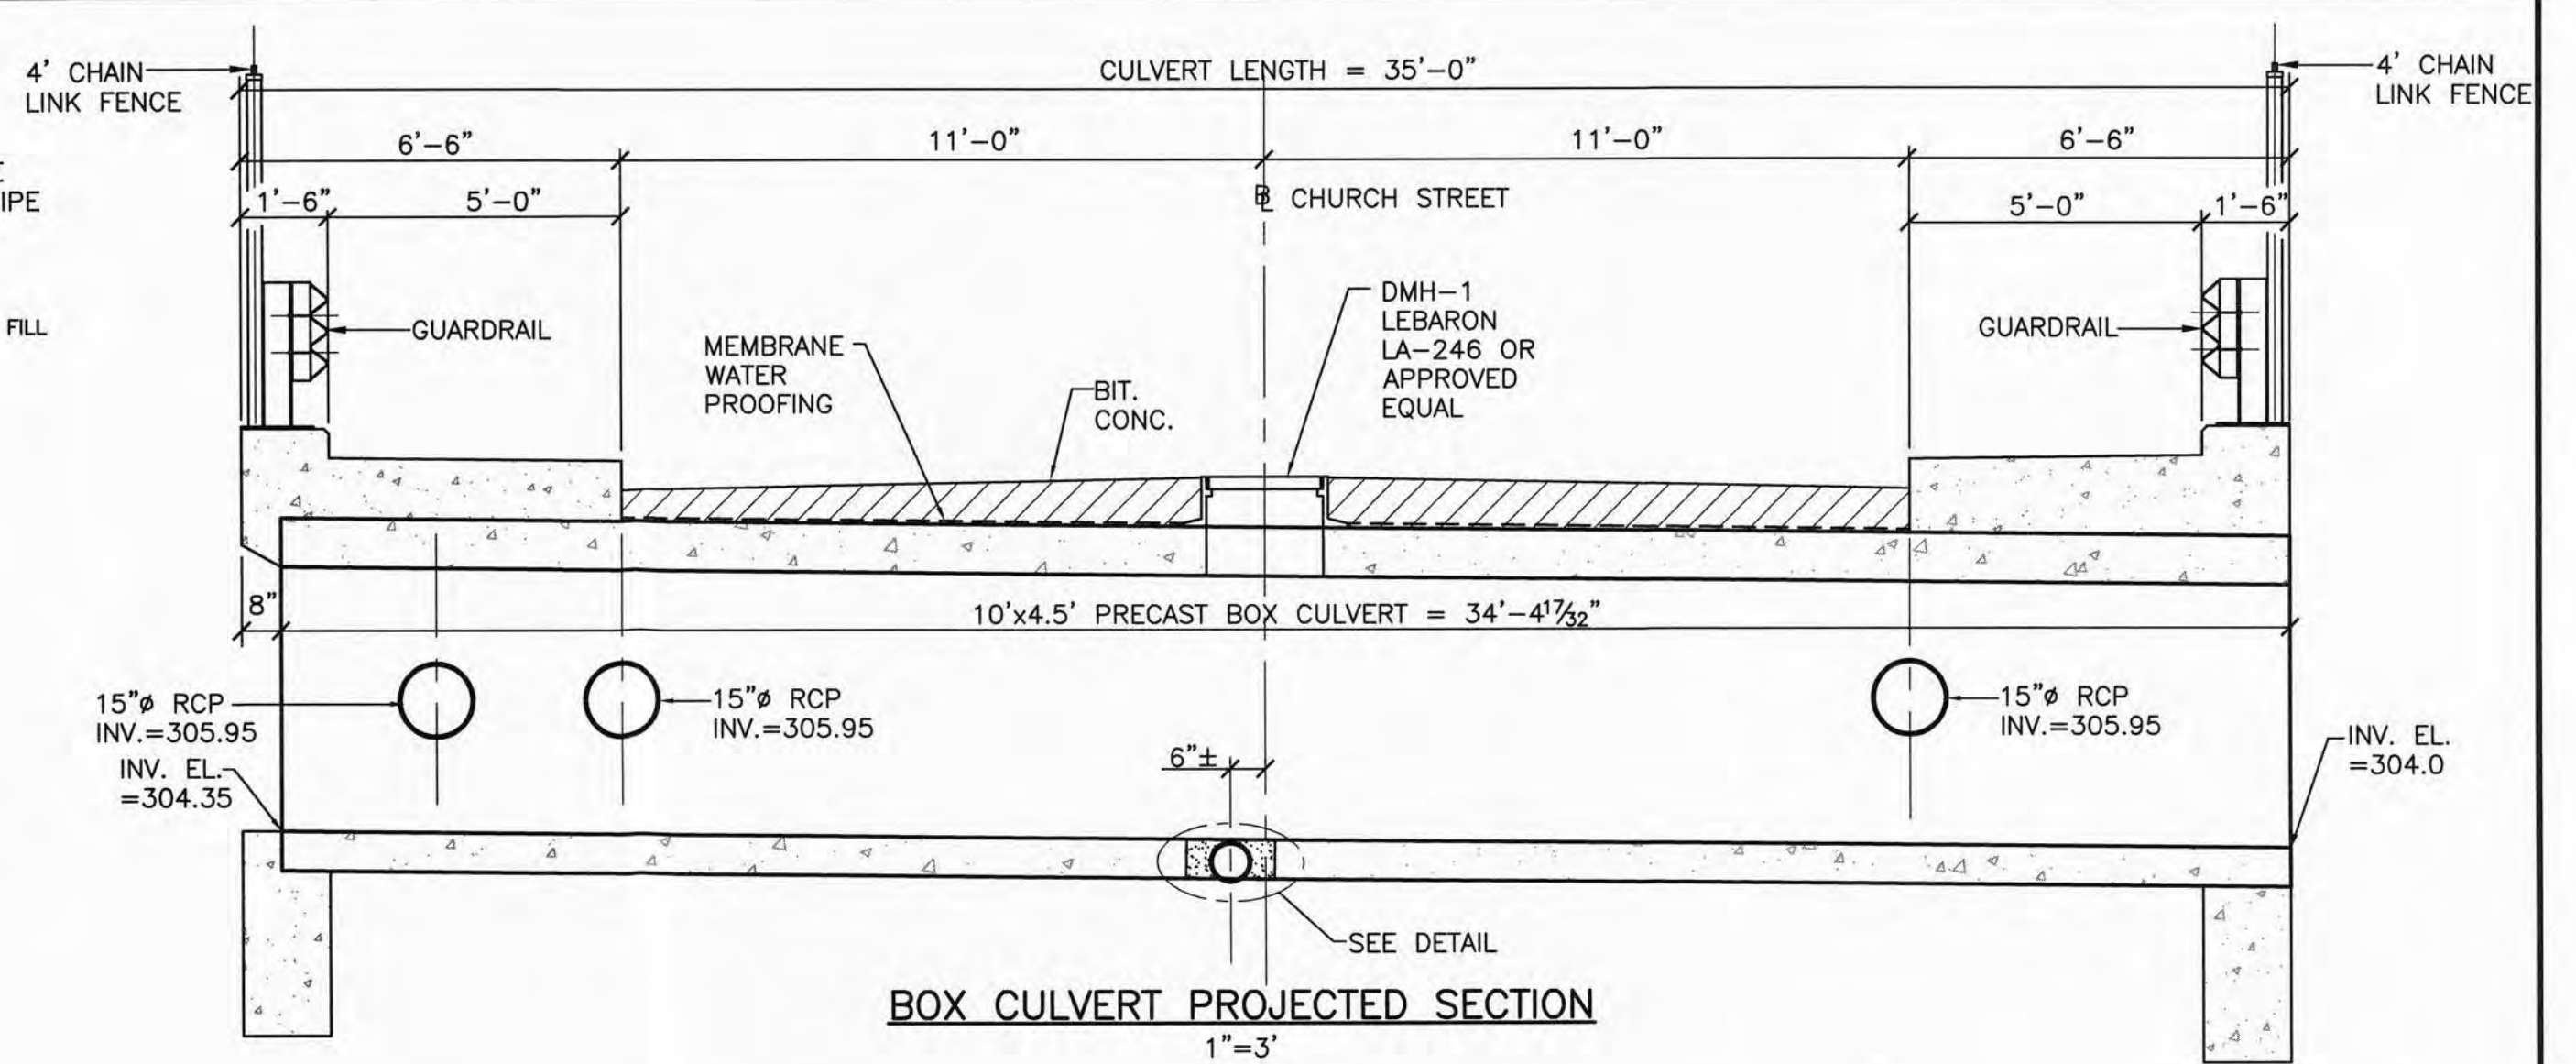


BOX CULVERT PROJECTED SECTION
1"=3"

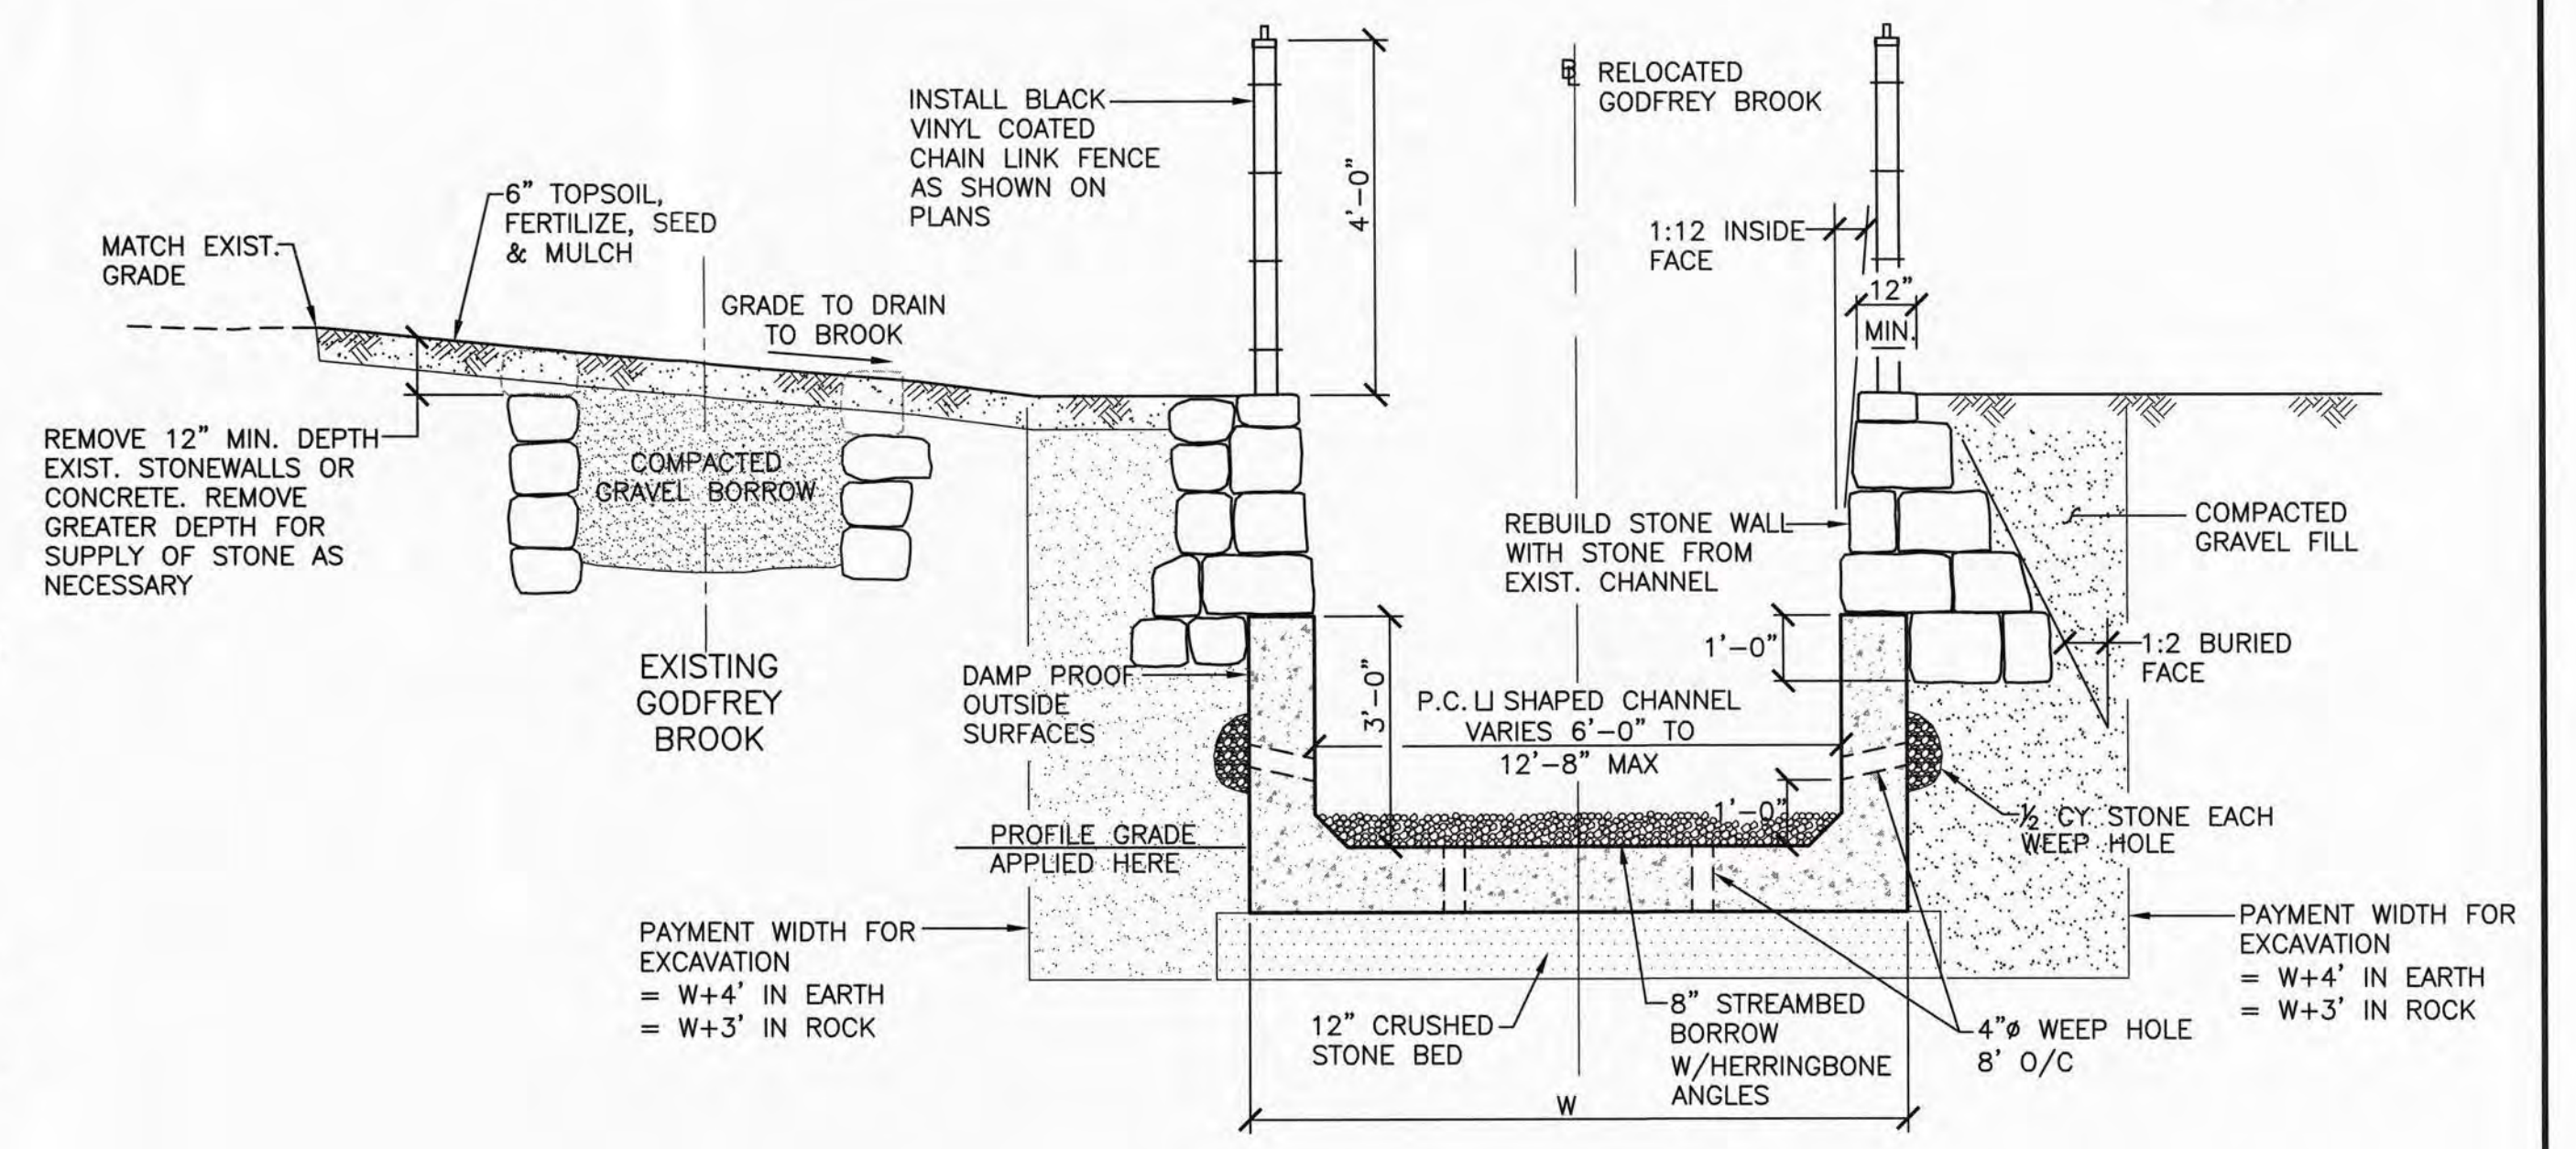

TYPICAL SECTION AT PRECAST U-SHAPED CHANNEL
NTS

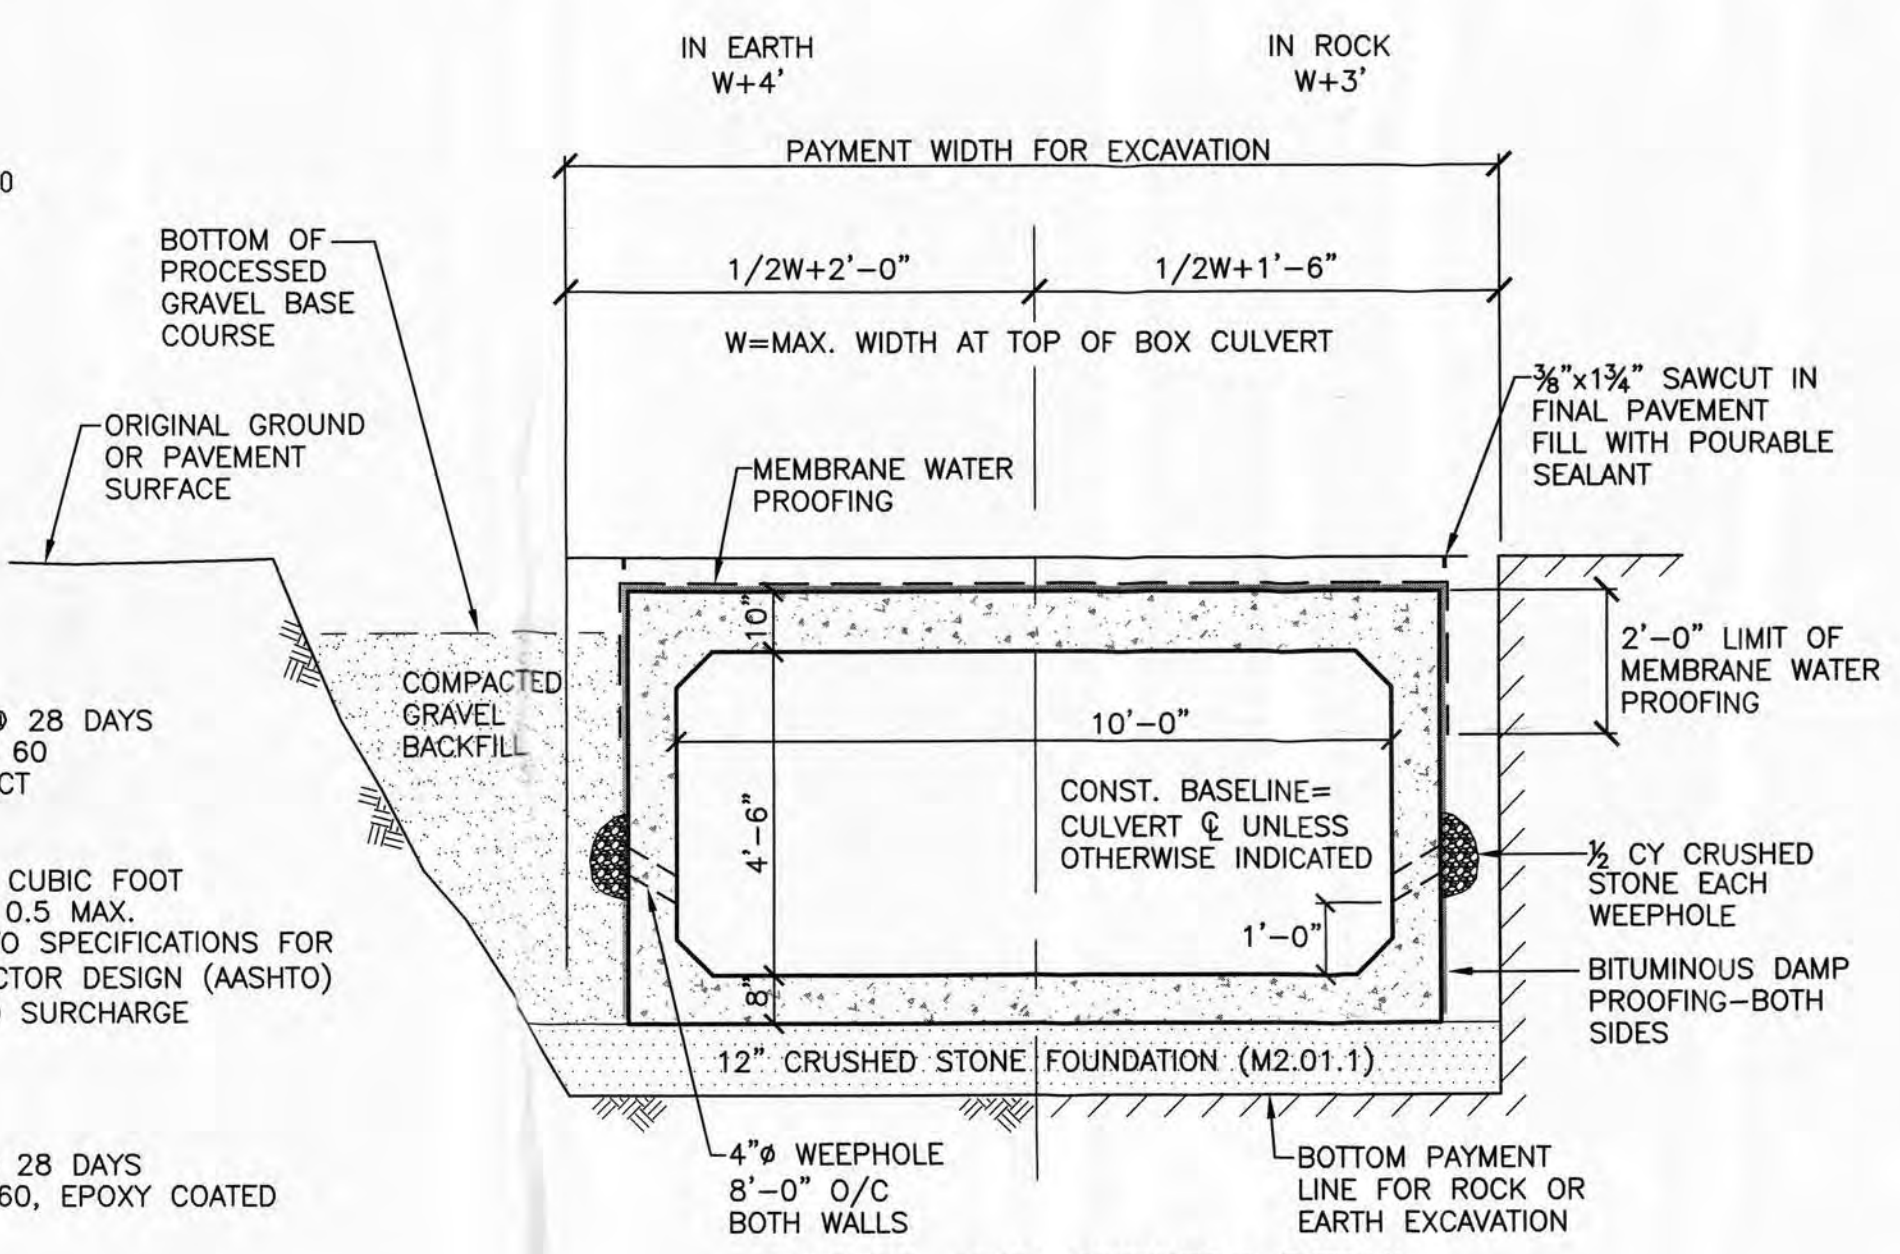

TYPICAL BOX CULVERT DETAIL
NTS

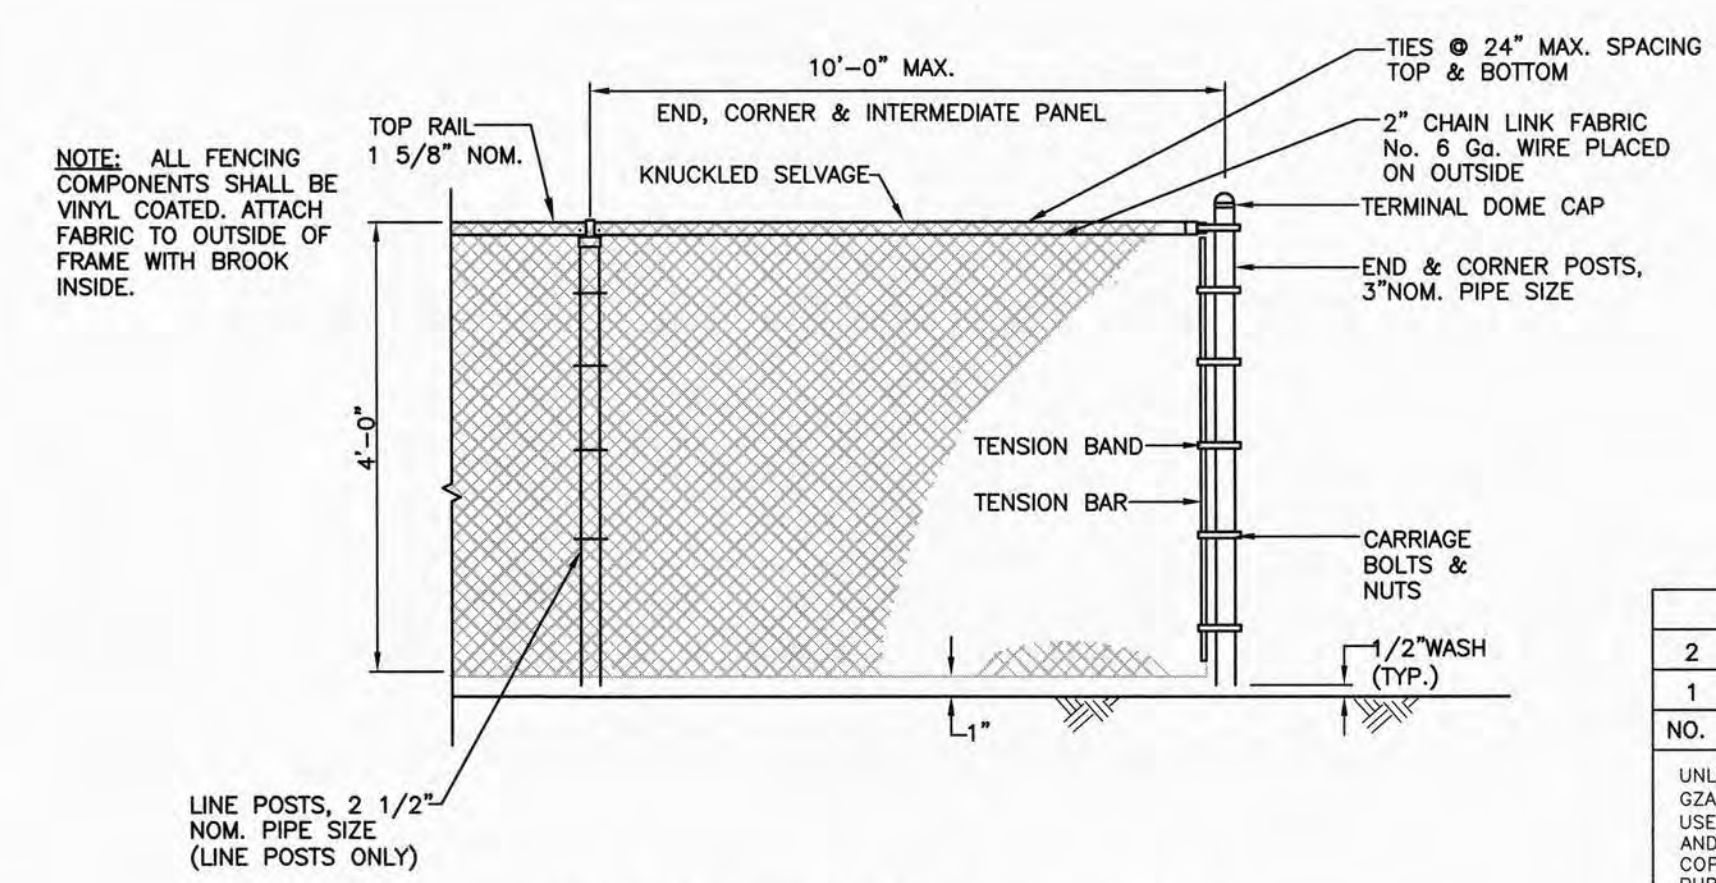

VINYL COATED CHAIN LINK FENCE
NTS


2	ISSUED FOR CONSTRUCTION	EDM	3/28/12
1	ISSUED FOR PERMITTING	EDM	1/19/12
NO.	ISSUE/DESCRIPTION	BY	DATE

UNLESS SPECIFICALLY STATED BY WRITTEN AGREEMENT, THIS DRAWING IS THE SOLE PROPERTY OF GZA GEOTECHNICAL, INC. (GZA). THE INFORMATION SHOWN ON THE DRAWING IS SOLELY FOR USE BY GZA'S CLIENT OR THE CLIENT'S DESIGNATED REPRESENTATIVE FOR THE SPECIFIC PROJECT AND LOCATION IDENTIFIED ON THE DRAWING. THE DRAWING SHALL NOT BE TRANSFERRED, REUSED, COPIED, OR ALTERED IN ANY MANNER FOR USE AT ANY OTHER LOCATION OR FOR ANY OTHER PURPOSE WITHOUT THE PRIOR WRITTEN CONSENT OF GZA. ANY TRANSFER, REUSE, OR MODIFICATION TO THE DRAWING BY THE CLIENT OR OTHERS, WITHOUT THE PRIOR WRITTEN EXPRESS CONSENT OF GZA, WILL BE AT THE USER'S SOLE RISK AND WITHOUT ANY RISK OR LIABILITY TO GZA.

GODFREY BROOK & CULVERT DETAILS
CHURCH STREET
CULVERT REPLACEMENT
MILFORD, MASSACHUSETTS











PREPARED BY: **GZA GeoEnvironmental, Inc.**
 ENGINEERS AND SCIENTISTS
 TOWN OF MILFORD

PROJ MGR: TEJ	DESIGNED BY: RS	REVIEWED BY: RS	CHECKED BY: TEJ
DATE: DECEMBER, 2011	PROJECT NO: 15.0166148.10	SCALE: AS NOTED	REVISION NO:

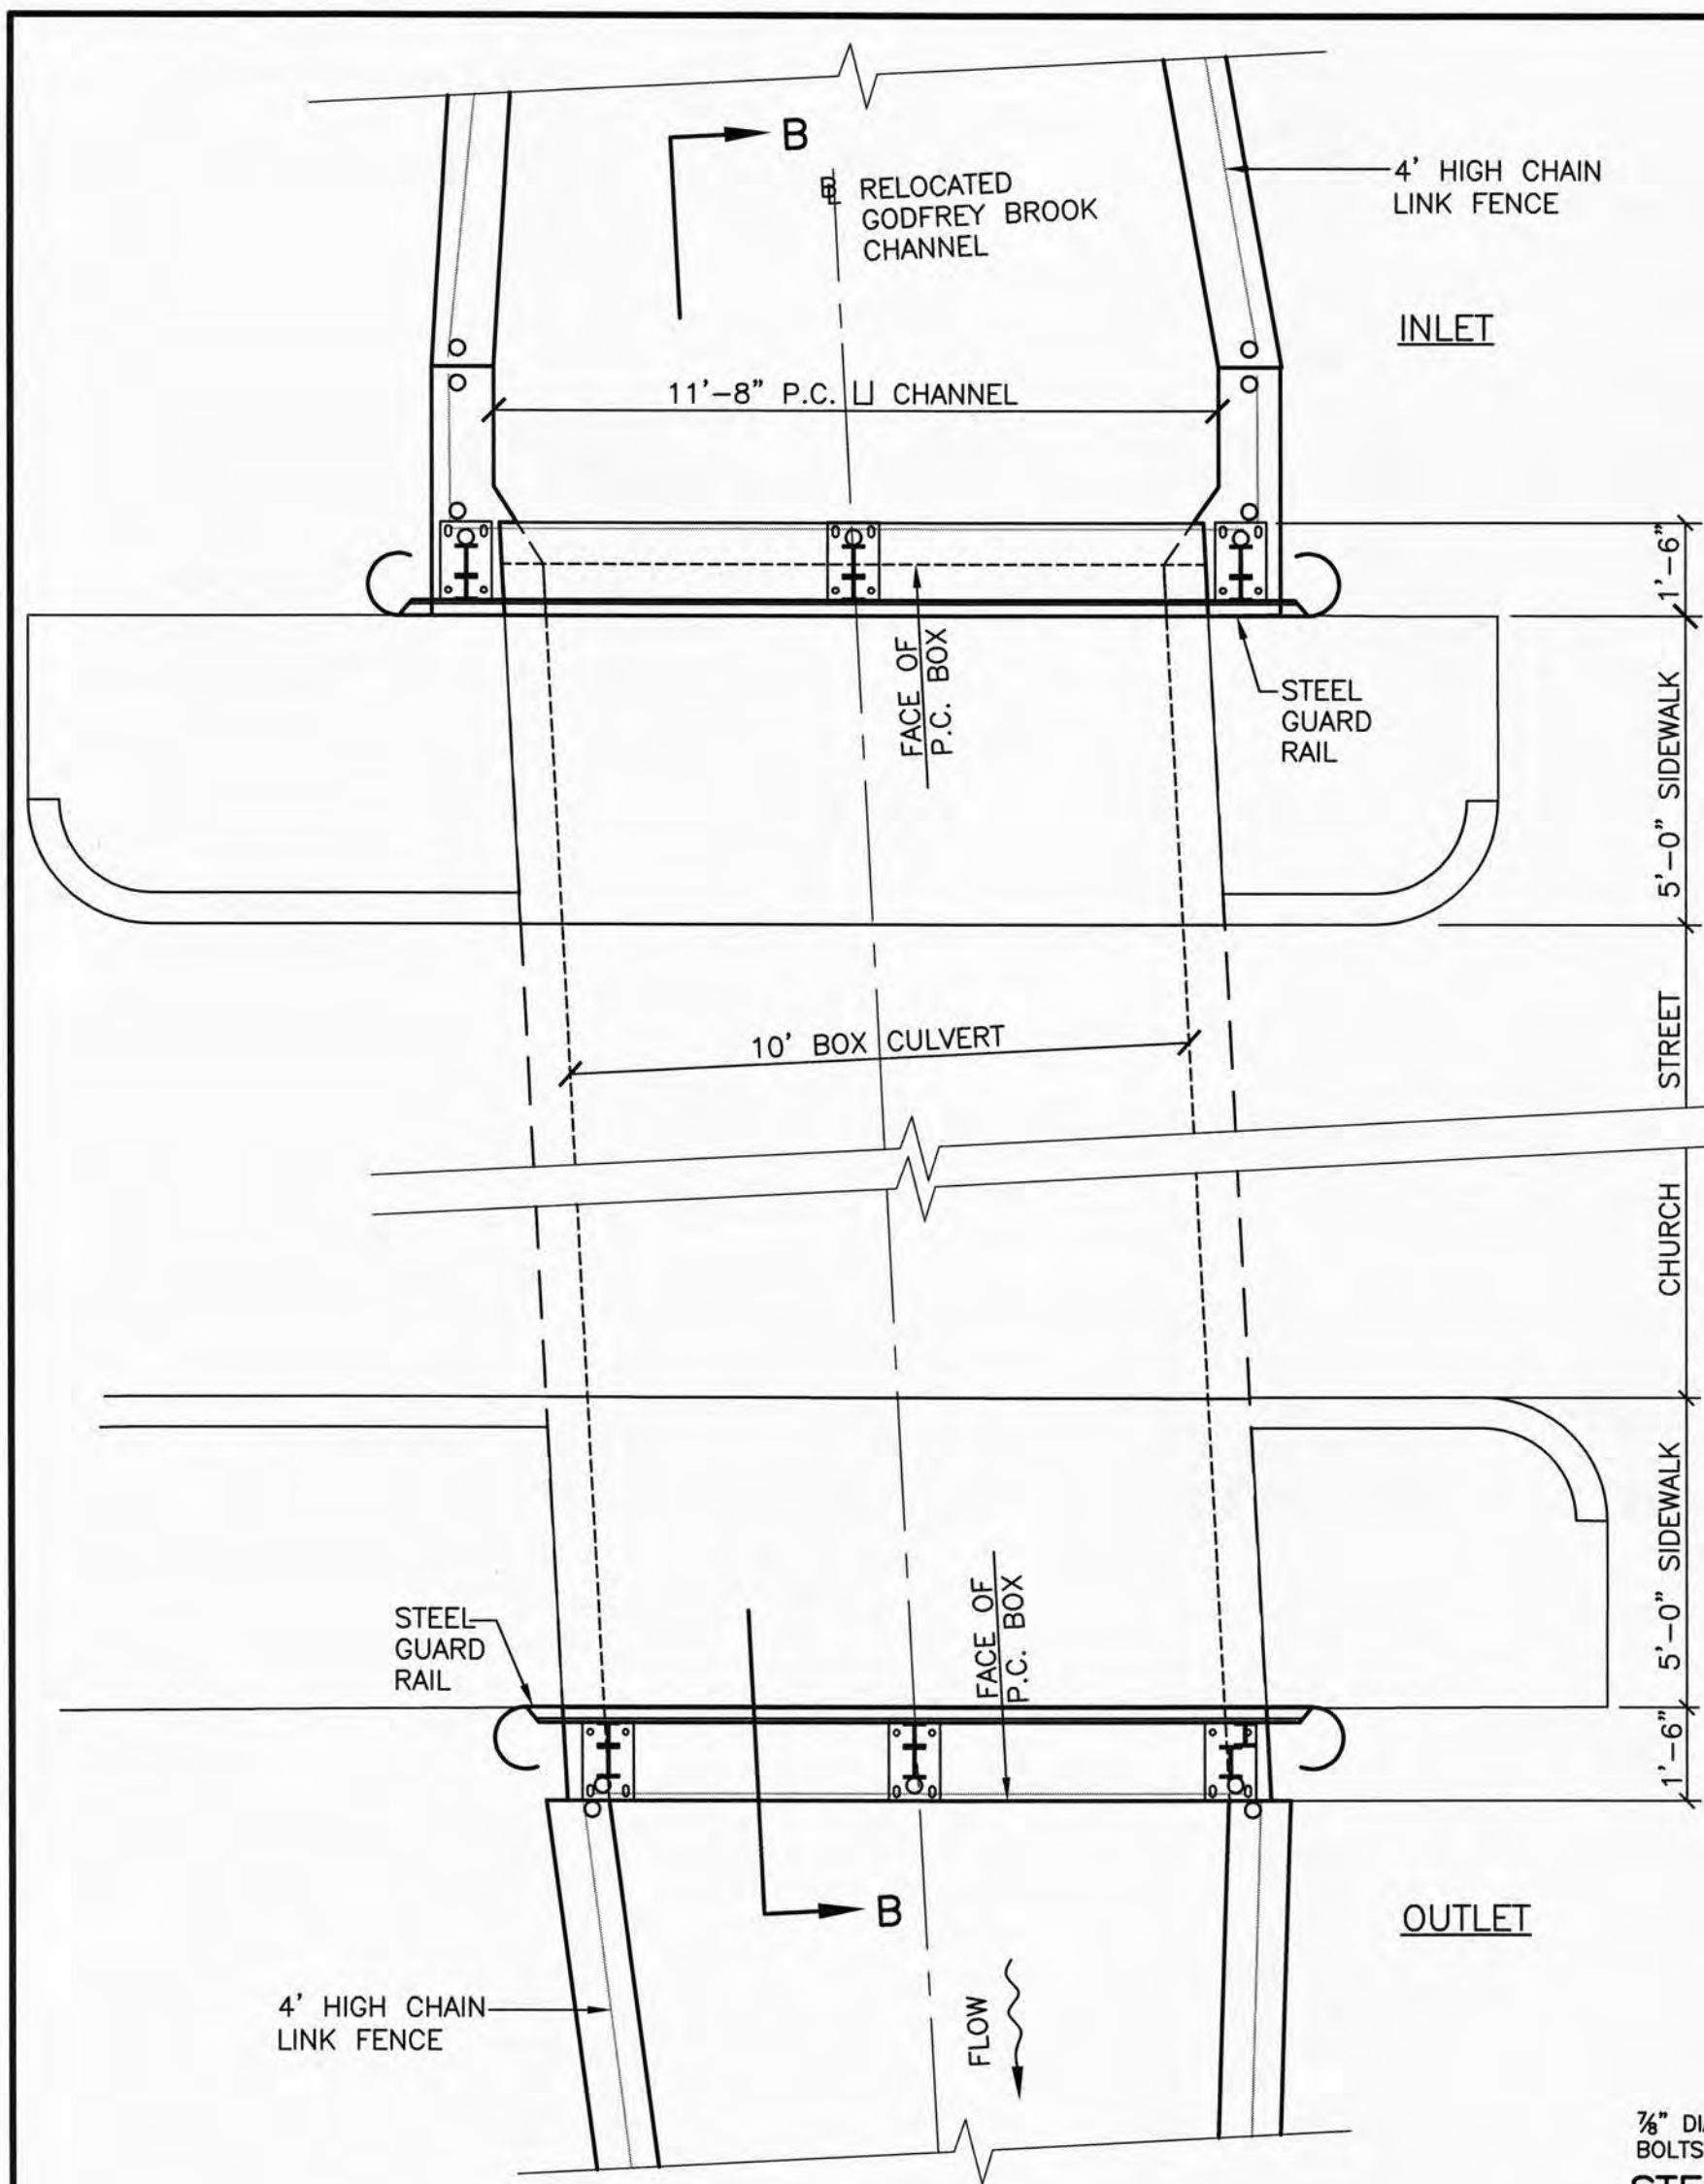

BOX CULVERT INLET/OUTLET PLAN
1"=3'

- NOTES:**
- SWEDGE BOLTS, U-BOLTS, NUTS & WASHERS TO BE HOT-DIPPED GALVANIZED.
 - Holes for swedge bolts shall be 10" deep. Swedge bolts to be set in epoxy resin, as approved by the engineer.
 - BASE PLATE IS TO BE SET ON 3/8" NEOPRENE.
 - THE BASE PLATE AND CONSTRUCTION METHOD SHOWN ARE ALSO USED WHEN THERE ARE NO EXPANSION JOINTS IN THE CEMENT CONCRETE.
 - CONTRACTOR SHALL BE RESPONSIBLE FOR ALL FIELD MEASUREMENTS.

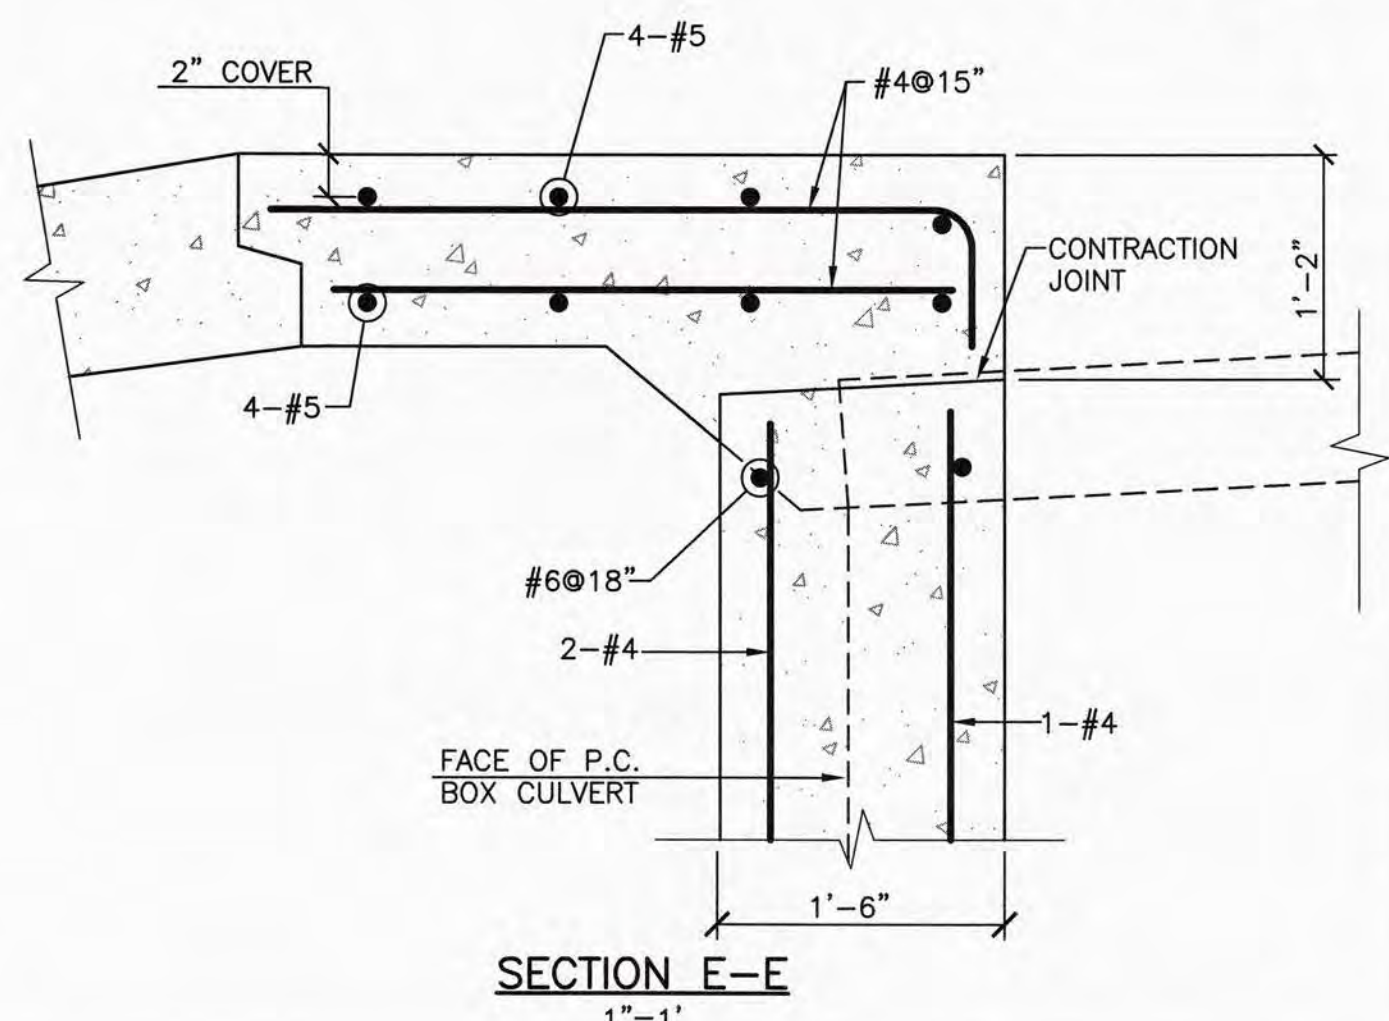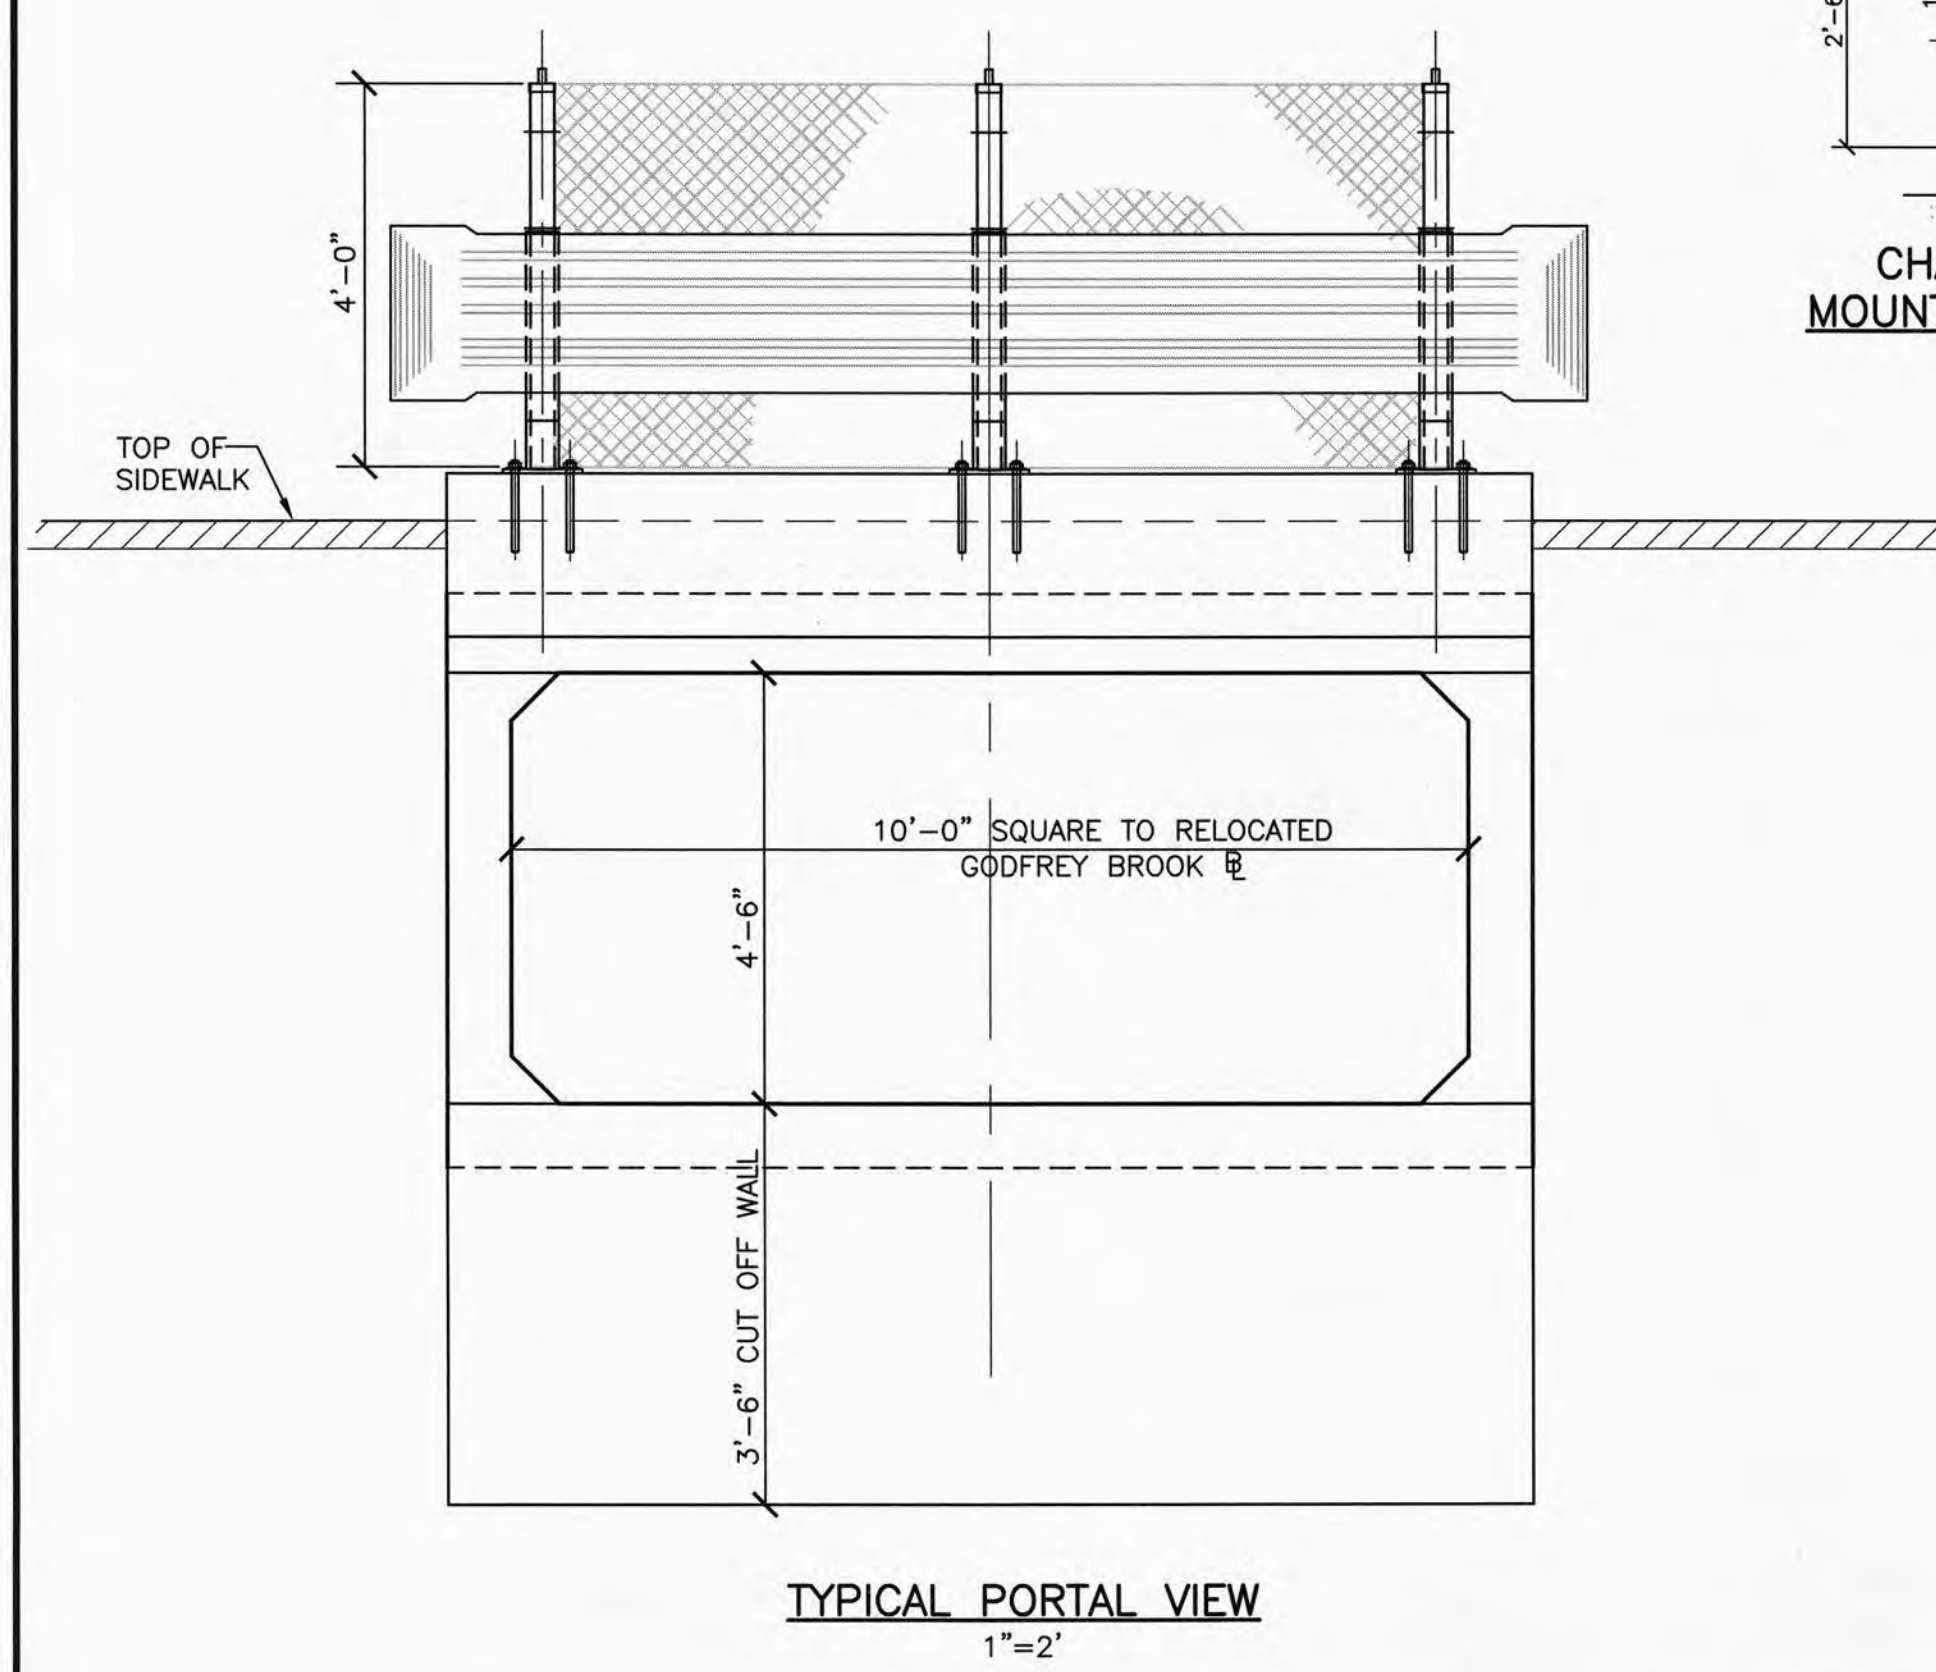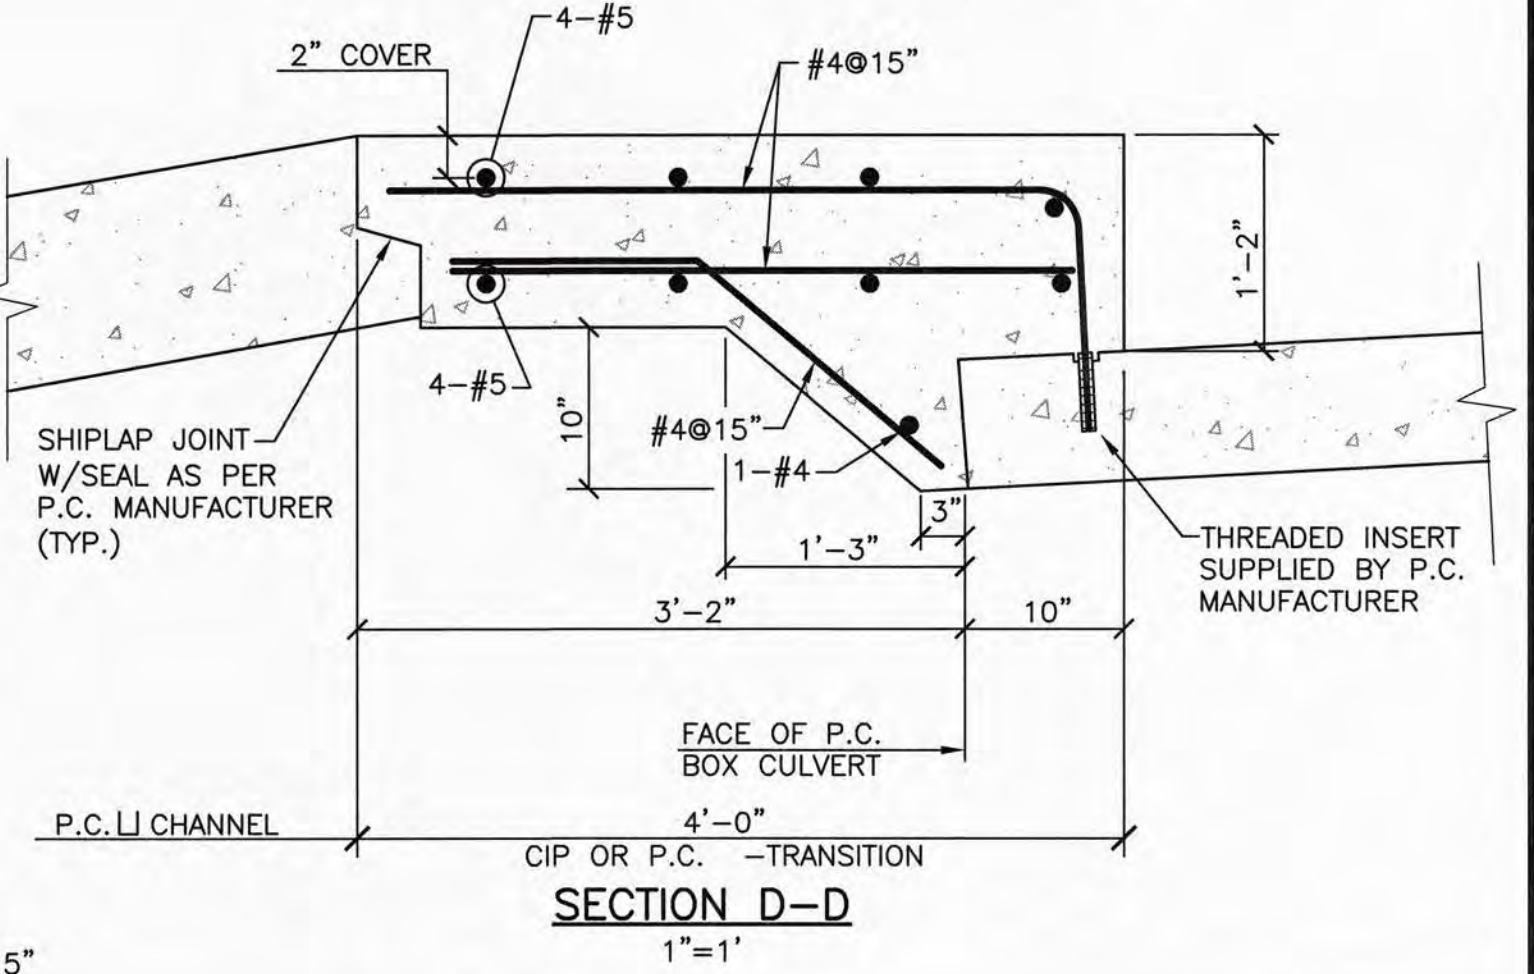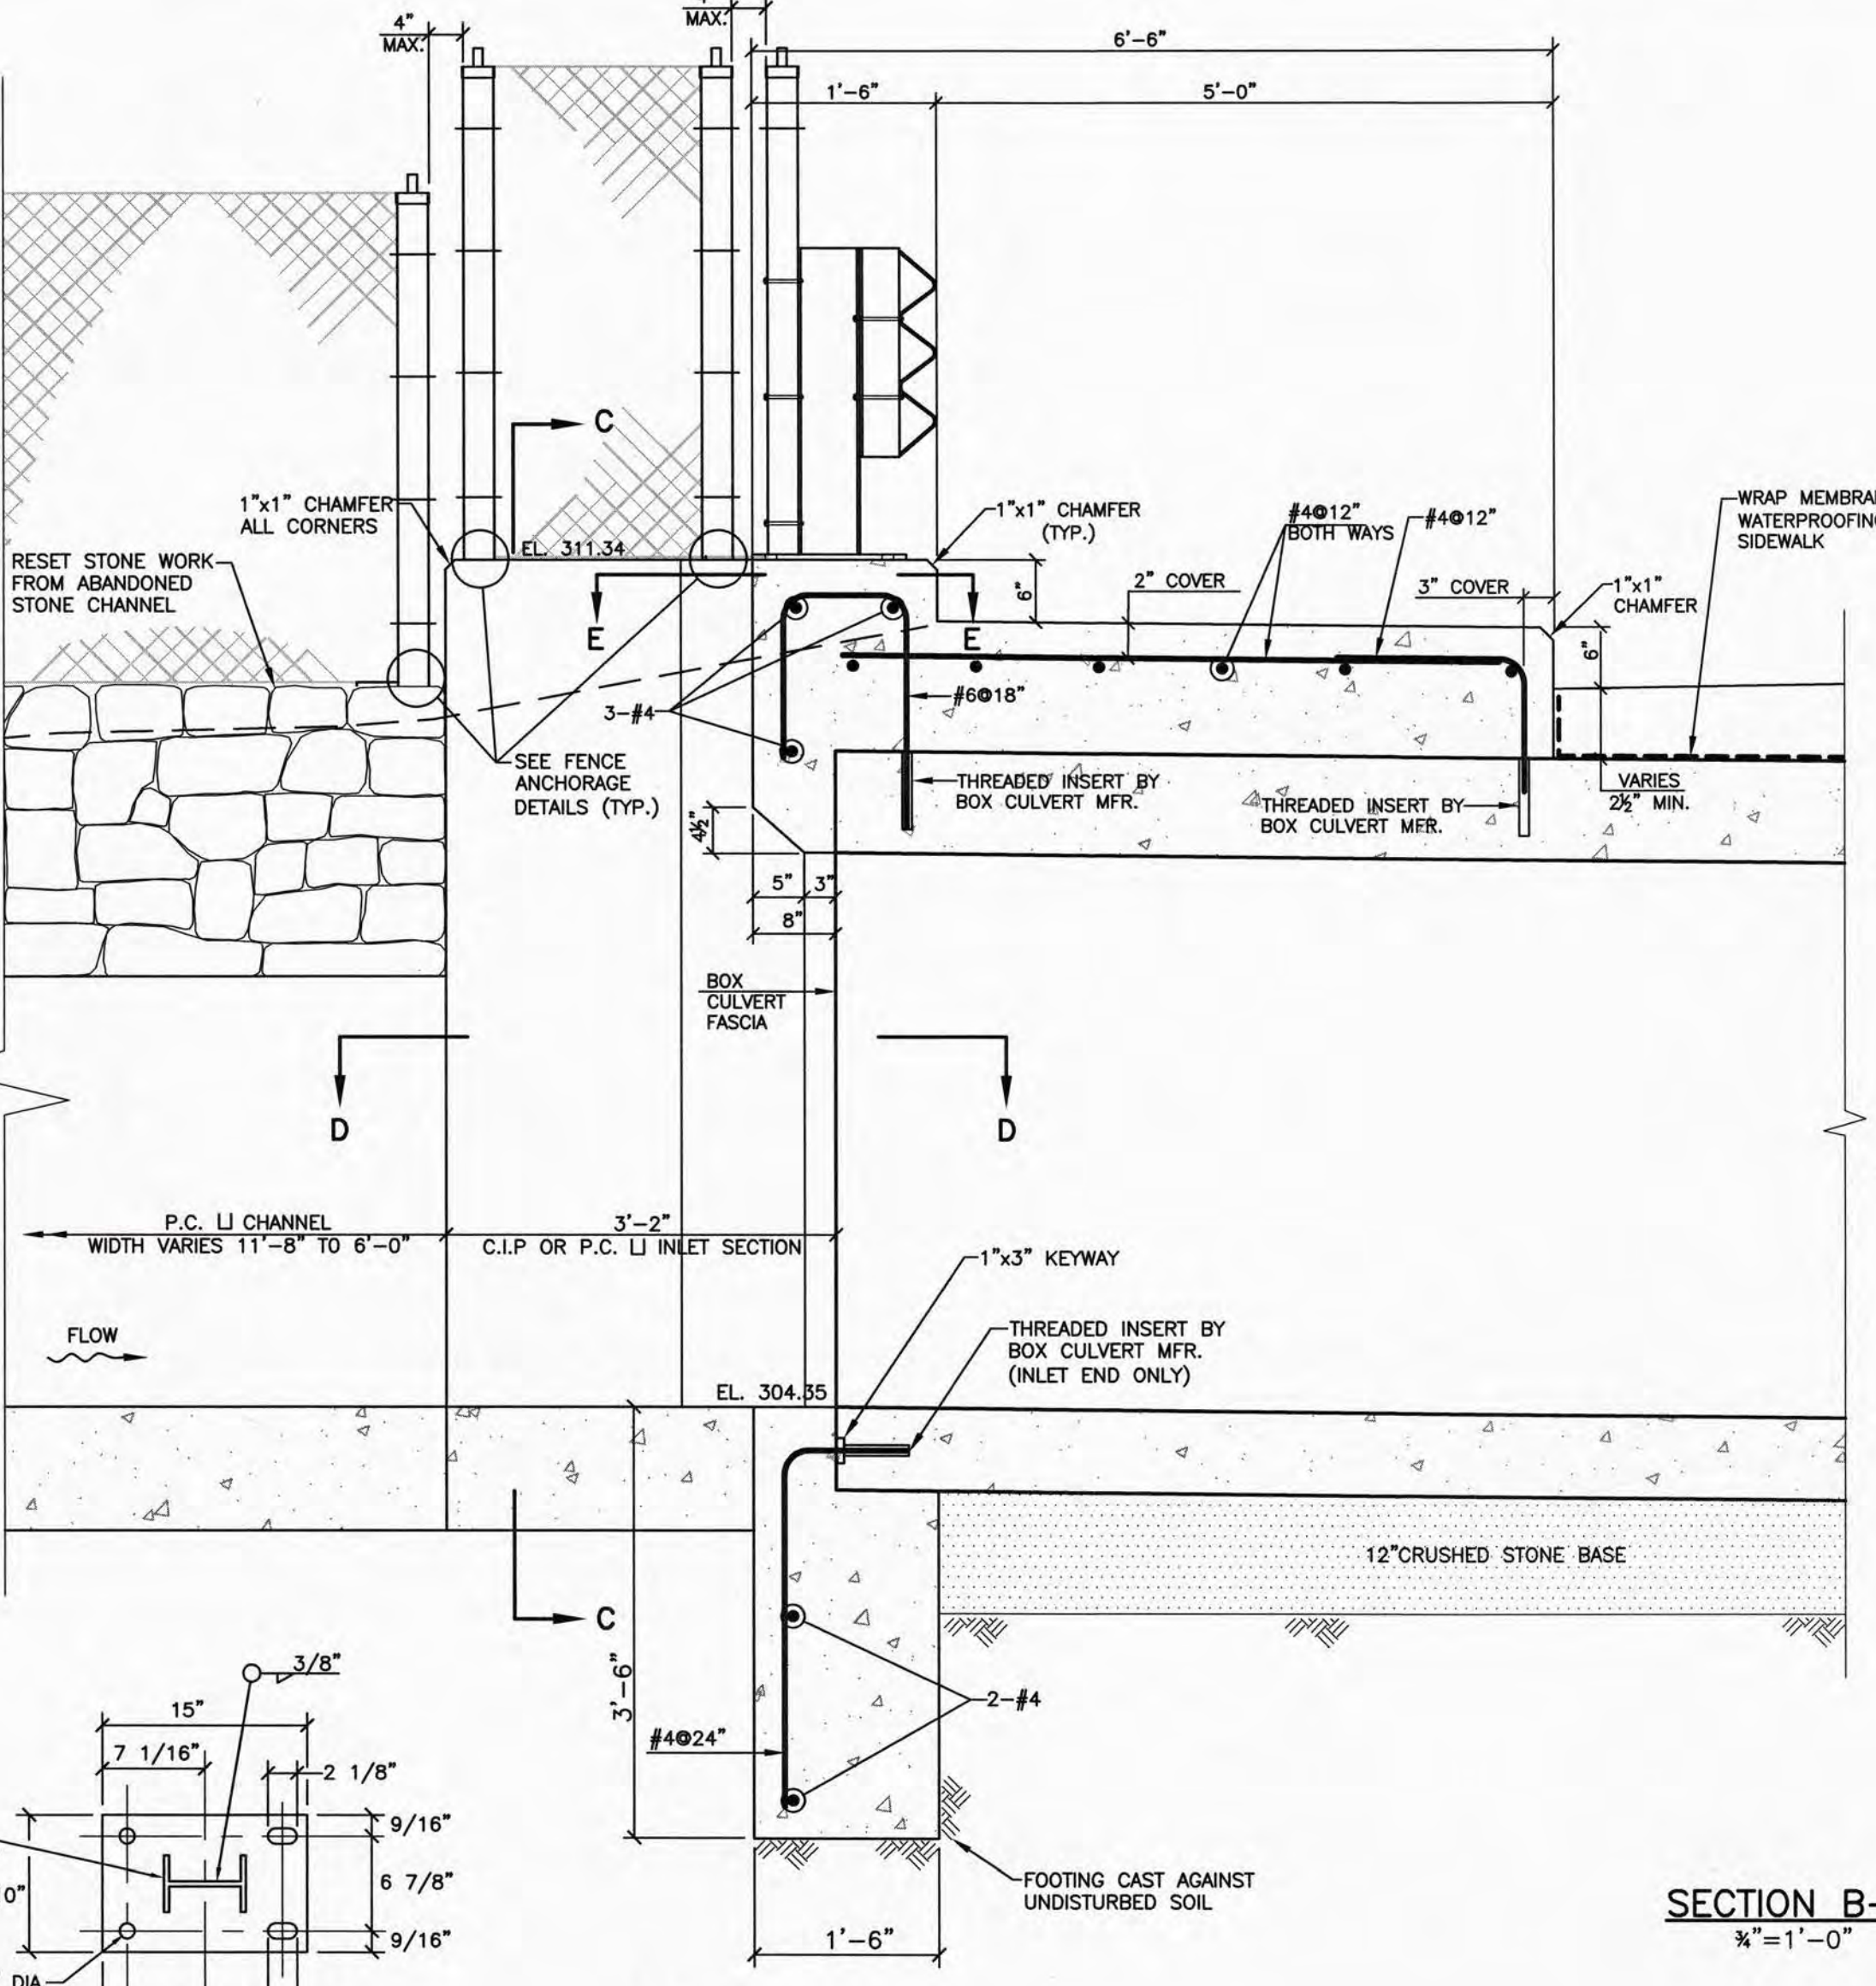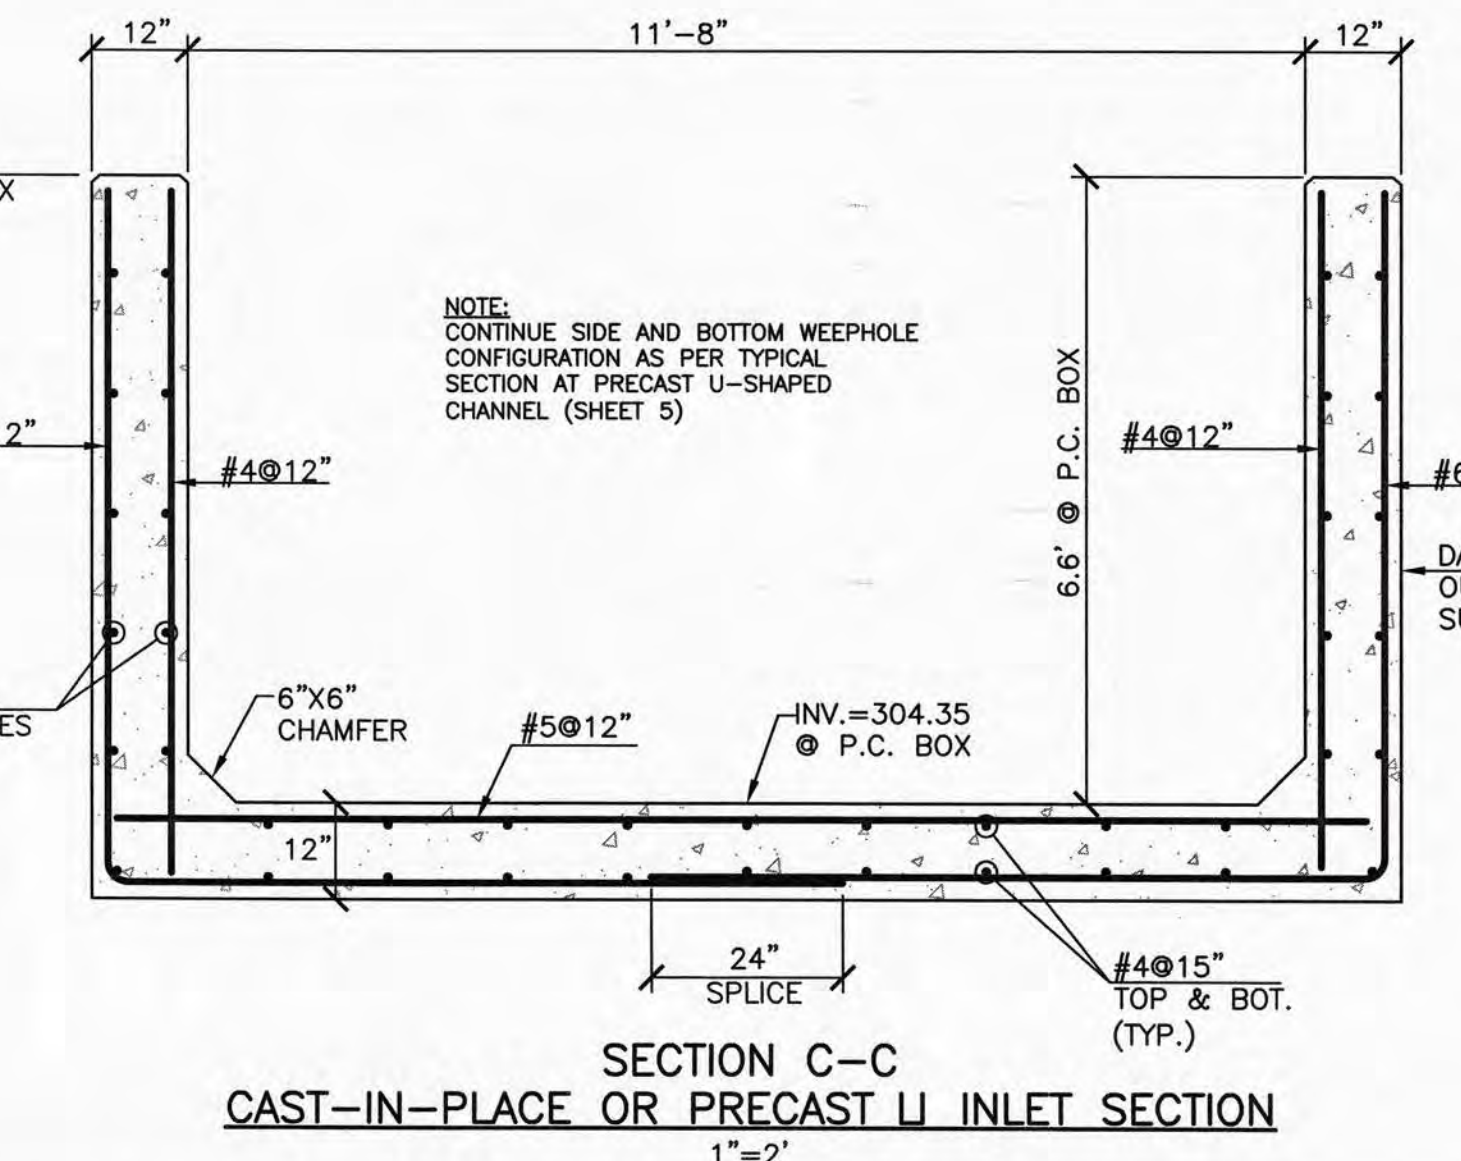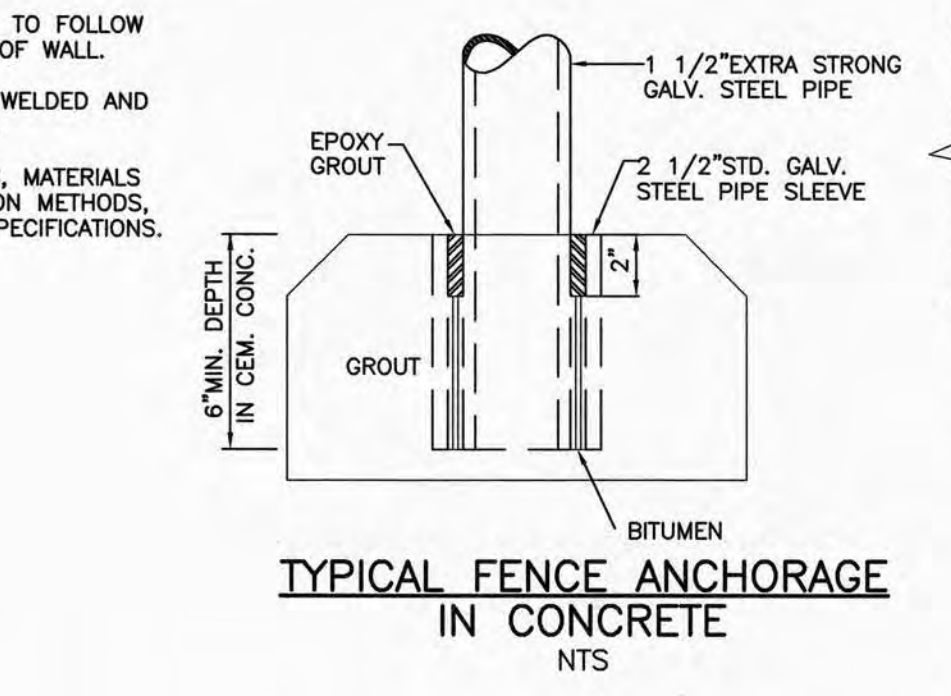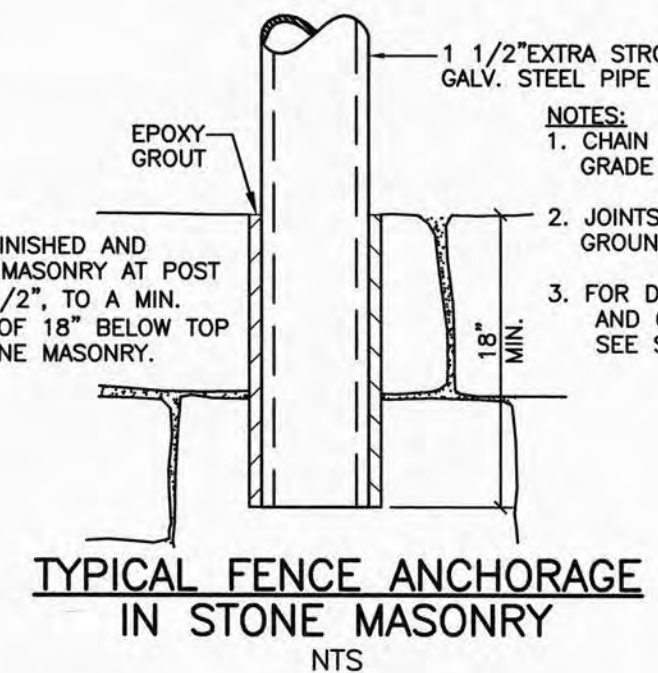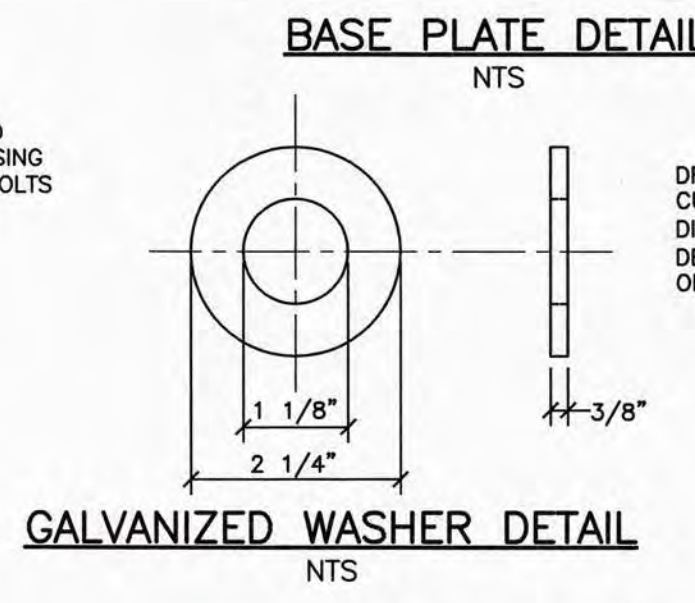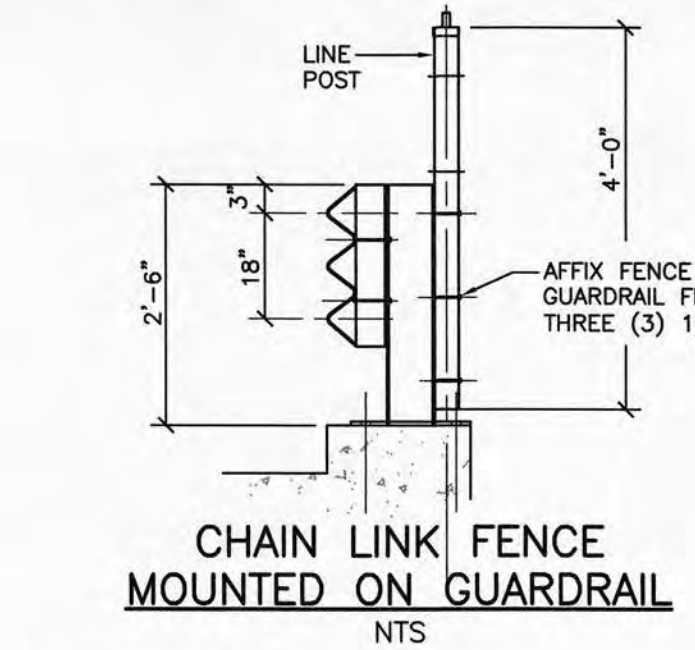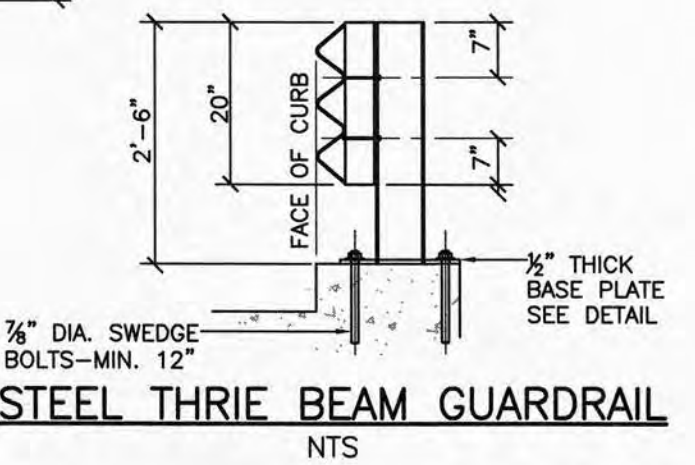

NO.	ISSUE/DESCRIPTION	BY	DATE
2	ISSUED FOR CONSTRUCTION	EDM	3/28/12
1	ISSUED FOR PERMITTING	EDM	1/19/12


UNLESS SPECIFICALLY STATED BY WRITTEN AGREEMENT, THIS DRAWING IS THE SOLE PROPERTY OF GZA GEOENVIRONMENTAL, INC. (GZA). THE INFORMATION SHOWN ON THE DRAWING IS SOLELY FOR USE BY GZA'S CLIENT OR THE CLIENT'S DESIGNATED REPRESENTATIVE FOR THE SPECIFIC PROJECT AND LOCATION IDENTIFIED ON THE DRAWING. THE DRAWING SHALL NOT BE TRANSFERRED, REUSED, COPIED, OR ALTERED IN ANY MANNER FOR USE AT ANY OTHER LOCATION OR FOR ANY OTHER PURPOSE WITHOUT THE PRIOR WRITTEN CONSENT OF GZA. ANY TRANSFER, REUSE, OR MODIFICATION TO THE DRAWING BY THE CLIENT OR OTHERS, WITHOUT THE PRIOR WRITTEN EXPRESS CONSENT OF GZA, WILL BE AT THE USER'S SOLE RISK AND WITHOUT ANY RISK OR LIABILITY TO GZA.

CULVERT DETAILS & SECTIONS
CHURCH STREET
CULVERT REPLACEMENT
MILFORD, MASSACHUSETTS


PREPARED BY: **GZA** GeoEnvironmental, Inc.
Engineers and Scientists
www.gza.com

PREPARED FOR: **TOWN OF MILFORD**


PROJ MGR: TEJ	DESIGNED BY: RS	DATE: DECEMBER, 2011	REVIEWED BY: RS	DRAWN BY: EDM	PROJECT NO: 15.0166148.10	CHECKED BY: TEJ	SCALE: AS NOTED	REVISION NO.
---------------	-----------------	----------------------	-----------------	---------------	---------------------------	-----------------	-----------------	--------------

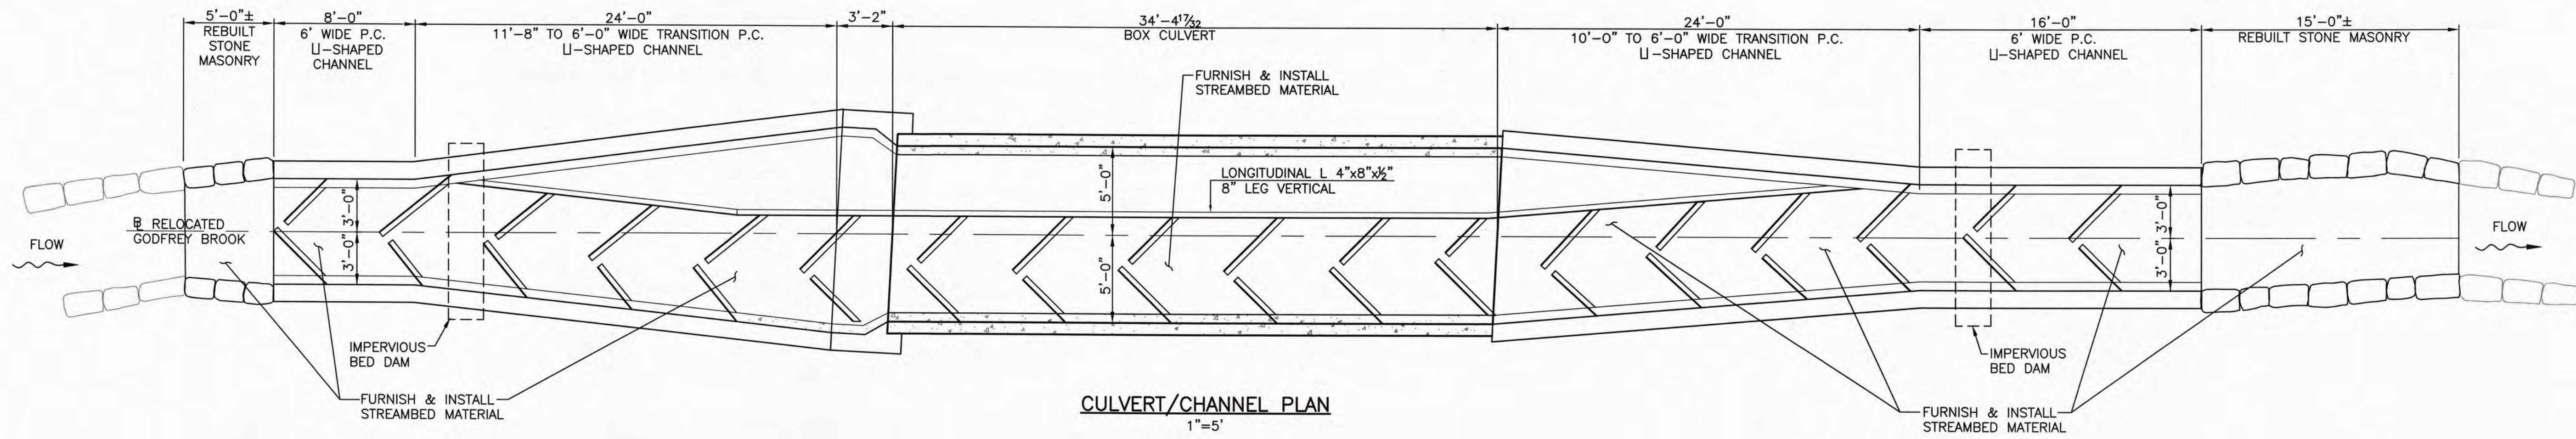


CULVERT/CHANNEL PLAN
1"=5'

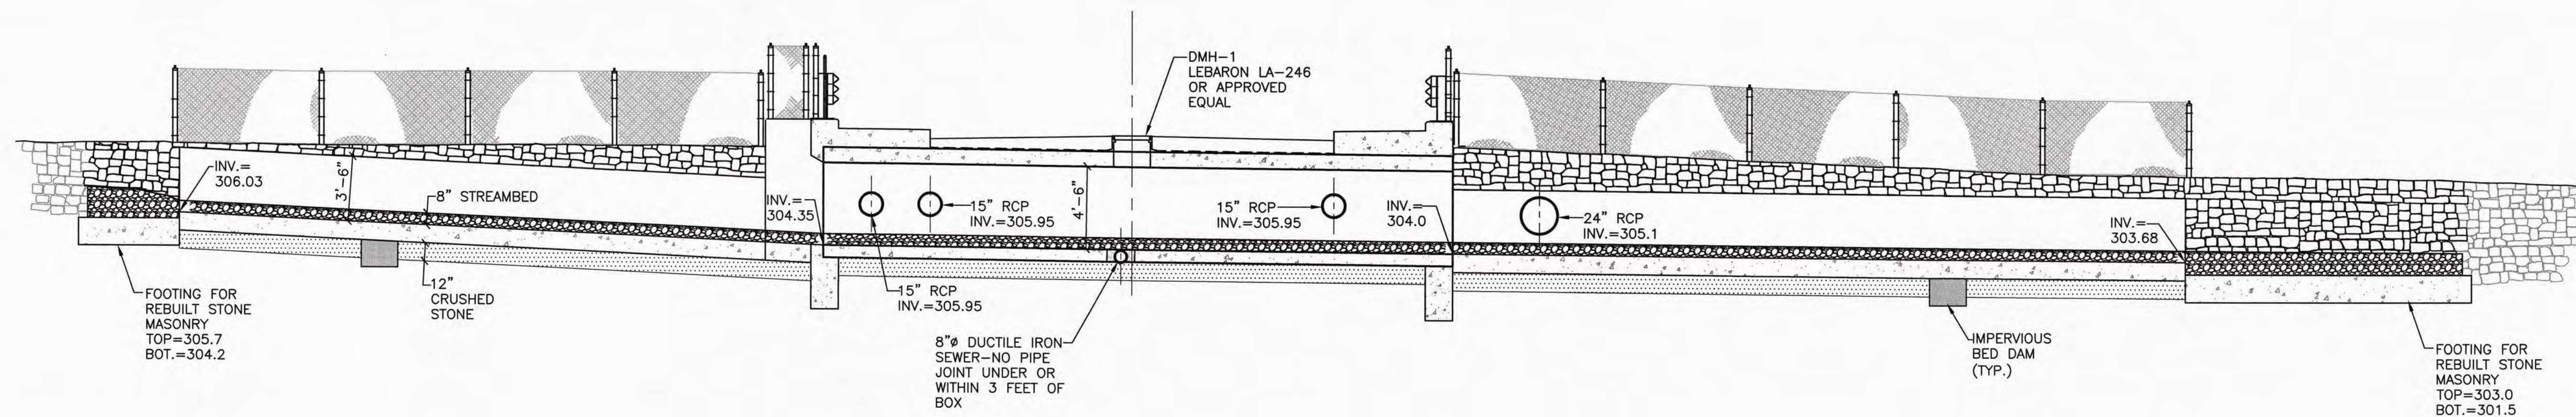


CULVERT/CHANNEL SECTION
1"=5'

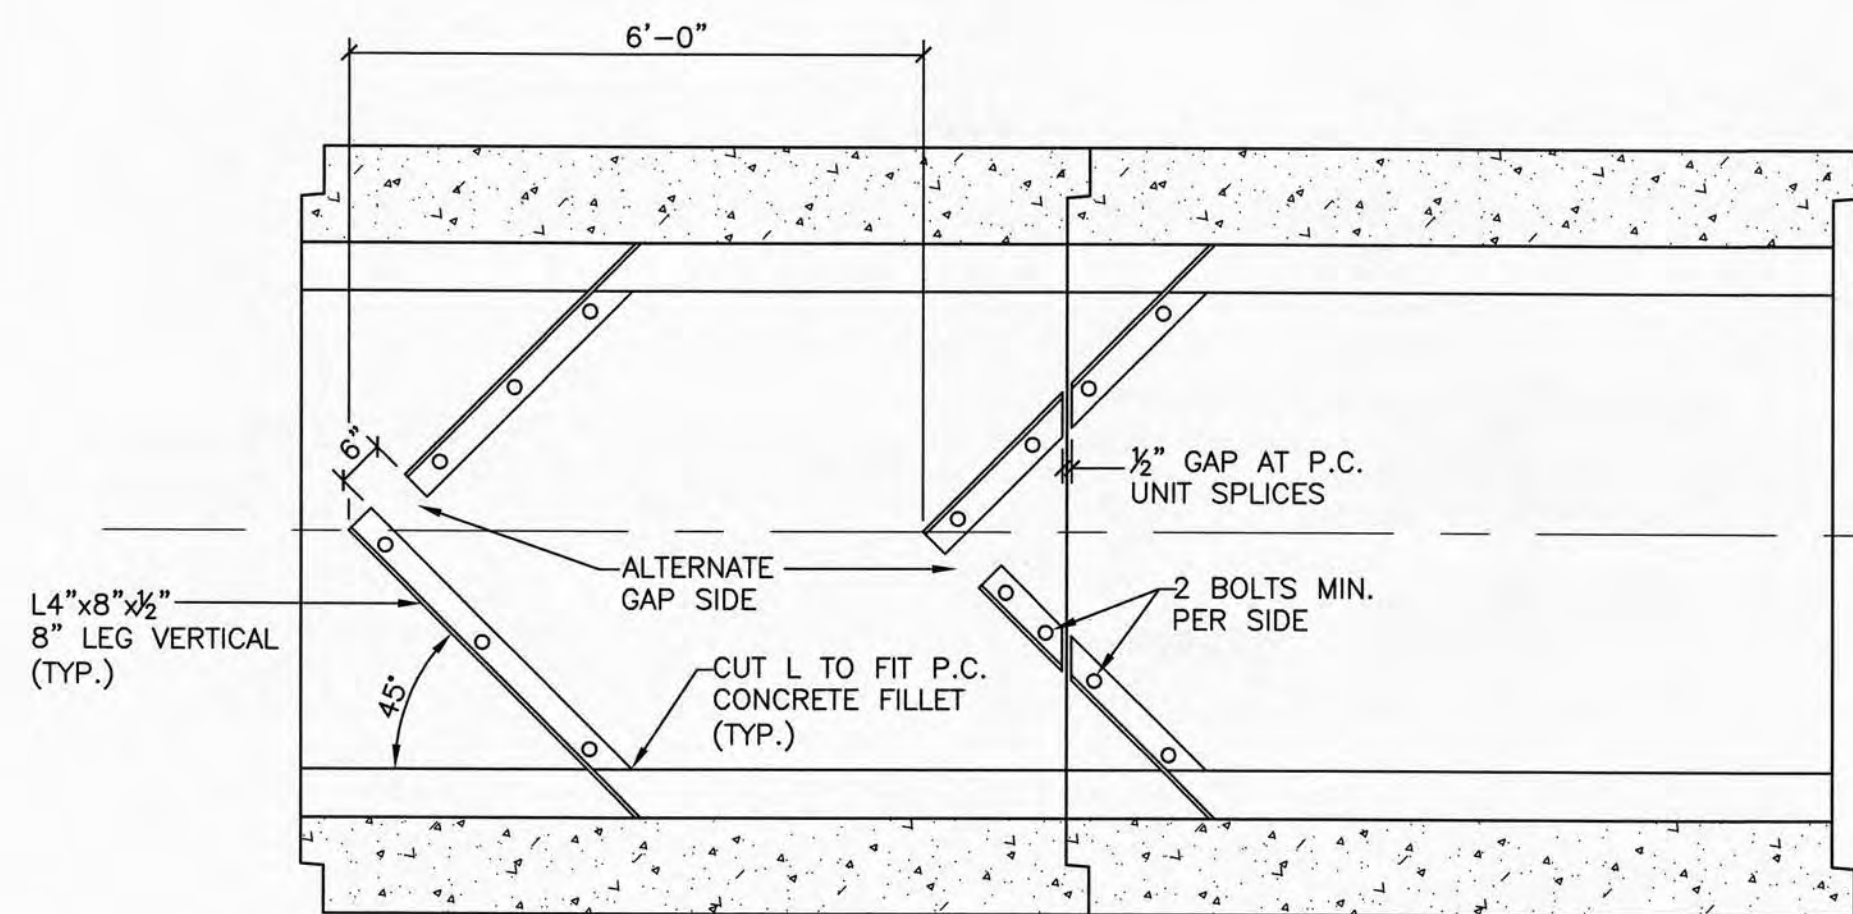

HERRINGBONE BAFFLE ANGLE LAYOUT
1"=2'

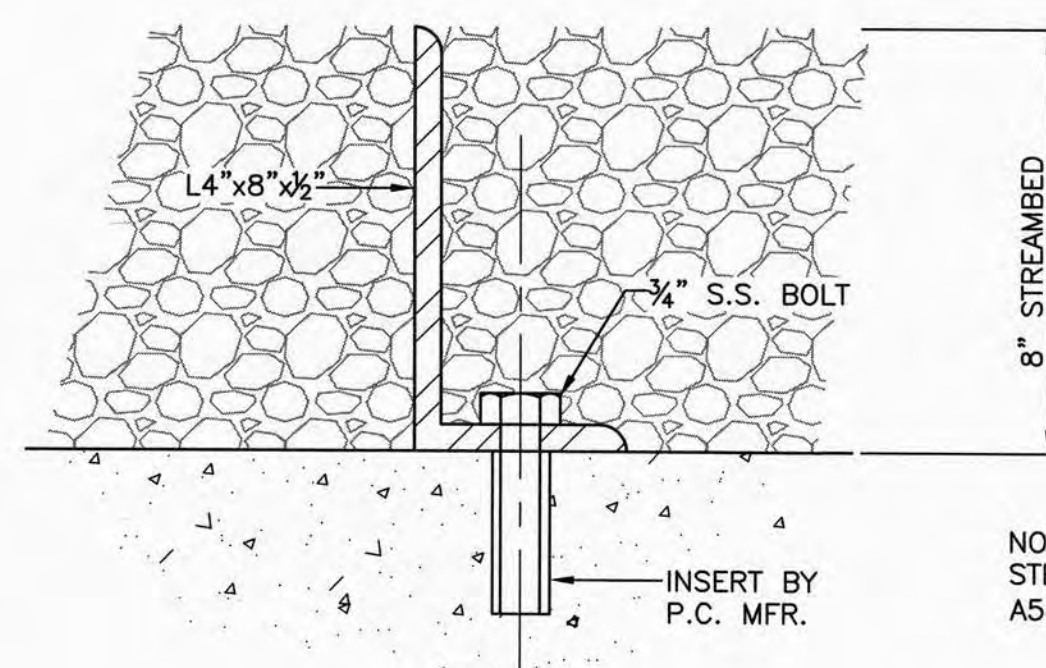

ANGLE DETAIL
NTS

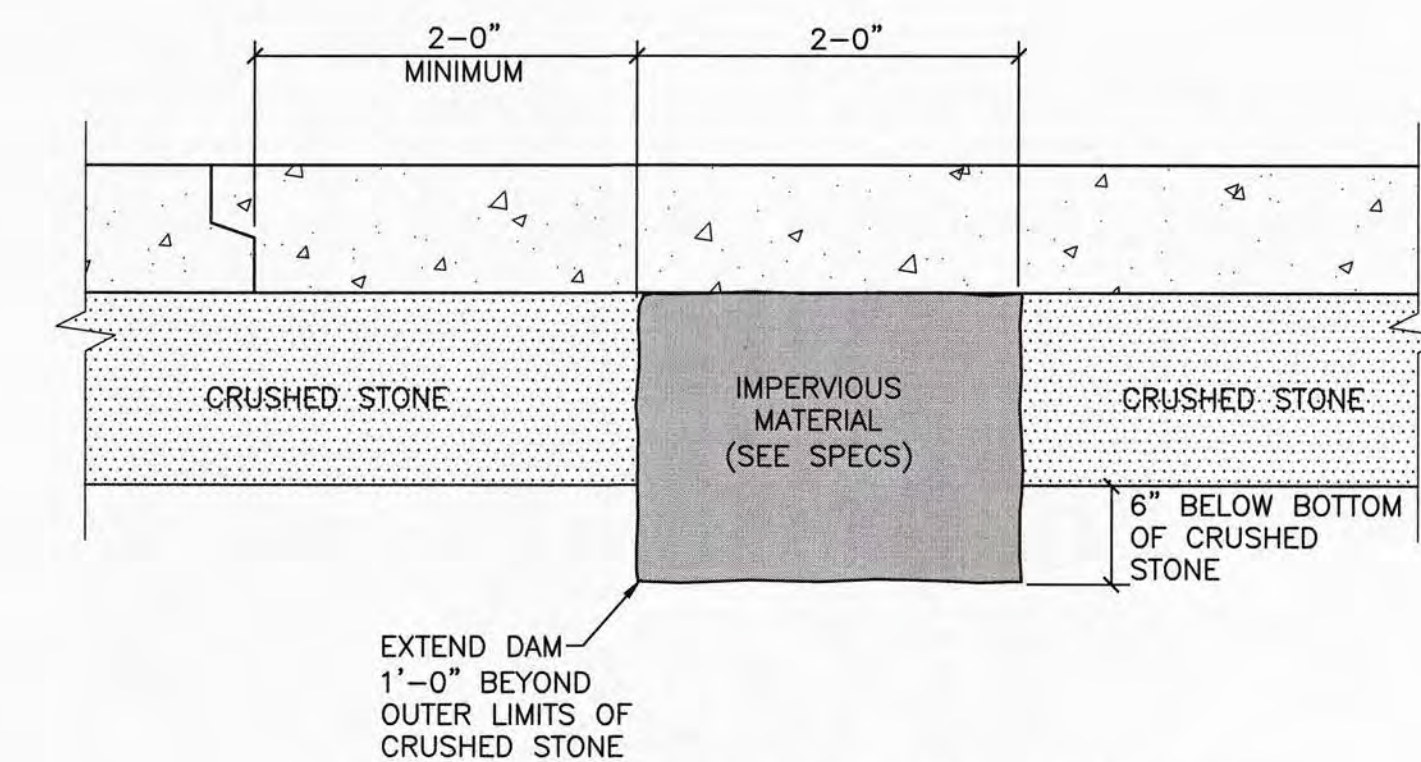

TYPICAL IMPERVIOUS BED DAM DETAIL
1"=1'

2	ISSUED FOR CONSTRUCTION	EDM	3/28/12
1	ISSUED FOR PERMITTING	EDM	1/19/12
NO.	ISSUE/DESCRIPTION	BY	DATE

UNLESS SPECIFICALLY STATED BY WRITTEN AGREEMENT, THIS DRAWING IS THE SOLE PROPERTY OF GZA GEOENVIRONMENTAL, INC. (GZA). THE INFORMATION SHOWN ON THE DRAWING IS SOLELY FOR USE BY GZA'S CLIENT OR THE CLIENT'S DESIGNATED REPRESENTATIVE FOR THE SPECIFIC PROJECT AND LOCATION IDENTIFIED ON THE DRAWING. THE DRAWING SHALL NOT BE TRANSFERRED, REUSED, COPIED, OR ALTERED IN ANY MANNER FOR USE AT ANY OTHER LOCATION OR FOR ANY OTHER PURPOSE WITHOUT THE PRIOR WRITTEN CONSENT OF GZA. ANY TRANSFER, REUSE, OR MODIFICATION TO THE DRAWING BY THE CLIENT OR OTHERS, WITHOUT THE PRIOR WRITTEN EXPRESS CONSENT OF GZA, WILL BE AT THE USER'S SOLE RISK AND WITHOUT ANY RISK OR LIABILITY TO GZA.

CHANNEL DETAILS

**CHURCH STREET
CULVERT REPLACEMENT
MILFORD, MASSACHUSETTS**

PREPARED BY:
GZA GeoEnvironmental, Inc.
Engineers and Scientists
www.gza.com

PREPARED FOR:
TOWN OF MILFORD

PROJ MGR:	TEJ	REVIEWED BY:	RS	CHECKED BY:	TEJ
DESIGNED BY:	RS	DRAWN BY:	EDM	SCALE:	AS NOTED
DATE:	DECEMBER, 2011	PROJECT NO:	15.0166148.10	REVISION NO.	

CONTRACT PLANS

For The

GODFREY BROOK FLOOD MITIGATION PROJECT

Prepared For The

TOWN OF MILFORD, MASSACHUSETTS

OFFICE OF PLANNING AND ENGINEERING

RENO DE LUZIO
TOWN PLANNER



MICHAEL SANTORA, P.E.
TOWN ENGINEER

April, 1999

Issued for Bidding, August 12, 1999

Issued as Record Print, October 1, 2001
As-Built Information Provided By
John Rocchio Corp., Sept. 19, 2001


PROJECT FUNDING ASSISTANCE PROVIDED BY:

COMMONWEALTH OF MASSACHUSETTS

THE DEPARTMENT OF HOUSING AND COMMUNITY DEVELOPMENT
MASSACHUSETTS COMMUNITY DEVELOPMENT BLOCK GRANT PROGRAM

THE DEPARTMENT OF ENVIRONMENTAL MANAGEMENT
OFFICE OF WATERWAYS

PREPARED BY

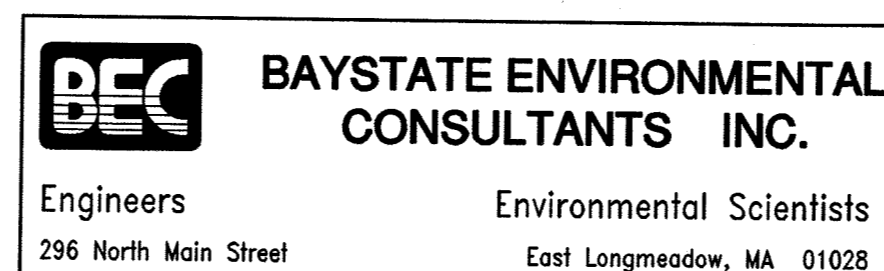

INDEX TO PLAN SHEETS

SHEET NUMBER	TITLE LINE 1	TITLE LINE 2
1	Cover Sheet	
2	Index Plan	
3	Layout Plan No. 1	
4	Layout Plan No. 2	
5	Layout Plan No. 3	
6	Layout Plan No. 4	
7	Construction Details No. 1	
8	Construction Details No. 2	
9	Construction Details No. 3	
10	Plan / Profile Sta. -0+20 to 5+50	Godfrey Brook Diversion Culvert
11	Plan / Profile Sta. 5+50 to 10+50	Godfrey Brook Diversion Culvert
12	Plan / Profile Sta. 10+50 to 16+50	Godfrey Brook Diversion Culvert
13	Plan / Profile Sta. 16+50 to 22+00	Godfrey Brook Diversion Culvert
14	Plan / Profile Sta. 22+00 to 28+00	Godfrey Brook Diversion Culvert
15	Plan / Profile Sta. 28+00 to 32+84.29	Godfrey Brook Diversion Culvert
16	Plan / Profile Sta. 0+00 to 5+44.5±	Open Channel Reconstruction Downstream of Vine Street
17	Plan / Profile Sta. -0+30 to 5+00	O'Brien Brook Diversion Culvert
18	Plan / Profile Sta. 5+00 to 6+81.51	O'Brien Brook Diversion Culvert
19	Plan / Profile Sta. 0+00 to 4+00	Hospital Brook Diversion Culvert (Bid Alternate No. 1)
20	Plan / Profile Sta. 4+00 to 6+71.38	Hospital Brook Diversion Culvert (Bid Alternate No. 1)
21	Plan and Details Sta 0+00 to 1+36.35	Open Channel Reconstruction Downstream of Vine Street
22	Plan and Details Sta. 1+36.35 to 5+44.5±	Open Channel Reconstruction Downstream of Vine Street
23	Plan / Profile Sta. 0+00 to 3+31.13	ReAlignment of Godfrey Brook at Vine Street
24	Box Culvert Ends	Details and Sections
25	Godfrey Brook Diversion Structure	
25A	Godfrey Brook Diversion Structure	
26	O'Brien Brook Diversion Structure	
27	Hospital Brook Diversion Structure	
28	Hospital Brook Diversion and	
29	Junction Chamber No. 1	Modifications to Existing Structures (Bid Alternate No. 1)
30	Junction Chamber No. 2	Plan and Sections (Bid Alternate No. 1)
31	Junction Chamber No. 2	Plan and Sections
32	Utility Profiles No. 1	Sections
33	Utility Profiles No. 2	Proposed Drains and Sanitary Sewers
34	Utility Profiles No. 3	Proposed Drains and Sanitary Sewers
35	Construction Sequencing Plan	Proposed Drains and Sanitary Sewers Vine Street Area

ALL MATERIALS AND CONSTRUCTION METHODS AND DETAILS FOR THIS PROJECT SHALL CONFORM TO THE LATEST EDITION OF THE "STANDARD SPECIFICATIONS FOR HIGHWAYS AND BRIDGES", MASSACHUSETTS HIGHWAY DEPARTMENT (MHD), AS AMENDED, REFERRED TO HEREIN AS THE "STANDARD SPECIFICATIONS".

GENERAL NOTES

- BASE SURVEY FOR THIS PROJECT WAS PROVIDED BY GUERRIERE AND HALNON, INC., MILFORD, MASSACHUSETTS. COMPLETE TOPOGRAPHICAL PLANS FROM THIS SURVEY WORK CAN BE OBTAINED FROM THE TOWN OF MILFORD.
- THE ACCURACY AND COMPLETENESS OF UNDERGROUND AND OVERHEAD UTILITIES AS SHOWN ON THE PLANS ARE NOT GUARANTEED. IT SHALL BE THE CONTRACTOR'S RESPONSIBILITY TO DETERMINE THE EXACT LOCATION, SIZE, TYPE, ETC. OF ALL UTILITIES THAT MAY BE AFFECTED BY THE WORK OF THIS PROJECT. ALL DRAIN AND SANITARY SEWER STRUCTURES OWNED BY THE TOWN OF MILFORD SHALL BE ADJUSTED TO NEW LINE AND GRADE BY THE CONTRACTOR, AS DIRECTED BY THE PLANS OR BY THE ENGINEER. ANY UTILITY POLES OR GUY POLES WITHIN AREAS AFFECTED BY THE WORK OF THIS PROJECT SHALL BE REMOVED AND RESET BY THE APPLICABLE UTILITY COMPANY. ALTERATIONS TO UTILITIES NOT OWNED BY THE TOWN OF MILFORD SHALL BE MADE BY THE APPLICABLE UTILITY OWNERS, AS COORDINATED BY THE CONTRACTOR.
- ALL MATERIALS AND CONSTRUCTION METHODS AND DETAILS FOR THIS PROJECT SHALL CONFORM TO THE LATEST EDITION OF THE "STANDARD SPECIFICATIONS FOR HIGHWAYS AND BRIDGES" MASSACHUSETTS HIGHWAY DEPARTMENT (MHD), AS AMENDED, REFERRED TO HEREIN AS THE "STANDARD SPECIFICATIONS".
- PRIOR TO ANY OTHER WORK TAKING PLACE, THE CONTRACTOR SHALL ERECT SILT FENCE EROSION CONTROL BARRIER ALONG THE TEMPORARY EASEMENT LINES AT ALL UNPAVED OR UNSURFACED AREAS THROUGHOUT THE PROJECT AREA. EROSION CONTROL BARRIER INSTALLATION MAY BE PHASED BUT NO GROUND DISTURBANCE SHALL BE ALLOWED WITHOUT AN ADEQUATE EROSION CONTROL BARRIER IN PLACE.
- THE CONTRACTOR MAY USE THE TOWN OF MILFORD PROPERTY AT THE CORNER OF MAIN ST. AND FRUIT ST. AS A STAGING AREA. AT THE END OF THIS PROJECT THE CONTRACTOR SHALL REMOVE AND DISPOSE OF ALL PAVING, INTERIOR FENCING, AND OTHER INTERIOR IMPROVEMENTS AND SHALL GRADE THE SITE LEVEL, ADDING GRAVEL BORROW AS NECESSARY TO FILL ANY LOW AREAS. ALL OTHER STAGING AREAS SHALL BE PROCURED BY THE CONTRACTOR.
- ALL PROPOSED CATCH BASIN AND DROP INLET FRAMES AND COVERS SHALL BE AS LEBARON FOUNDRY, INC. MODEL NO. LF-248-2, OR EQUIVALENT. ALL PROP. CATCH BASINS SHALL BE AS SHOWN IN MHD (SD) 201.4.0 EXCEPT THAT THE SUMP SHALL BE 4'-0" DEEP. ALL CATCH BASINS SHALL BE EQUIPPED WITH HOODS AS PER MHD (SD) 201.12.0.
- ALL PROP. DRAINAGE AND SAN. SEWER STRUCTURES SHALL BE SUPPORTED WITH A 12" CRUSHED STONE (M2.01.1) FOUNDATION PIPE.
- ALL REINFORCED CONCRETE PIPE USED ON THIS PROJECT SHALL BE CLASS III, UNLESS OTHERWISE DESIGNATED ON THE PLANS.
- ALL EXISTING DRAIN AND SAN. SEWER LINES TO BE REPLACED SHALL BE ABANDONED IN PLACE. IF THEY CONFLICT WITH ANY PROP. WORK THEY SHALL BE REMOVED.
- WHERE LINES OR STRUCTURES ARE ABANDONED IN PLACE, THE CONTRACTOR SHALL ENSURE THAT ALL CONNECTING PIPES, INLETS, AND OUTLETS ARE PLUGGED. ALL LIVE CONNECTIONS SHALL BE CONNECTED TO NEW WORK TO THE SATISFACTION OF THE ENGINEER.
- CATCH BASIN, DROP INLET, AND MANHOLE FRAMES AND GRATES/COVERS SHALL CLEARLY ALIGN WITH THE OPENINGS IN THE PRECAST STRUCTURES.
- ALL EXISTING PAVEMENT MARKINGS SHALL BE REPLACED IN KIND AFTER FINAL PAVING OF ROAD RECONSTRUCTION AREAS.
- ALL STRUCTURE STATIONS AND OFFSETS ARE TO THE CENTER POINT OF THE PROP. GRATE OR COVER.
- ALL PROPOSED GRANITE CURBING SHALL BE MHD TYPE VB AND SHALL INCLUDE REMOVAL OF EXISTING GRANITE CURBING, WHERE APPLICABLE. REMOVE AND RESET OF GRANITE CURBING SHALL BE LIMITED TO AREAS OUTSIDE OF THE PUBLIC RIGHT OF WAY.
- NEW SIDEWALKS, WHEELCHAIR RAMPS, PRIVATE WALKS AND DRIVEWAYS SHALL BE CONSTRUCTED TO THE NEAREST SCORE LINE OR EXPANSION JOINT IN THE EXISTING ADJACENT SURFACES OR AS DIRECTED BY THE ENGINEER. PROP. CEMENT CONCRETE SIDEWALKS SHALL INCLUDE REMOVAL OF EXISTING SIDEWALK SURFACES.
- ALL WHEELCHAIR RAMPS SHALL MEET THE LATEST REQUIREMENTS OF THE MASSACHUSETTS ARCHITECTURAL ACCESS BOARD AND THE LATEST STANDARDS OF THE MASSACHUSETTS HIGHWAY DEPARTMENT.
- ALL DRIVEWAY REPAIRS SHALL BE "TYPICAL DRIVEWAYS" AS SHOWN IN THE DETAILS.
- ALL UNSURFACED AREAS WITHIN THE PERMANENT EASEMENT SHALL BE CLEARED AND GRUBBED. ALL OTHER TREES, SHRUBS, AND OTHER VEGETATION OUTSIDE OF THE PERMANENT EASEMENTS BUT WITHIN THE TEMPORARY EASEMENT LINES SHALL BE REMOVED AS THE CONTRACTOR REQUIRES TO COMPLETE THE WORK OF THIS PROJECT, WITH THE EXCEPTION OF TREES DESIGNATED ON THE PLANS AS TO REMAIN. GRUBBING WITHIN THE TEMPORARY EASEMENTS SHALL NOT BE REQUIRED BUT WILL BE ALLOWED, EXCEPT FOR WITHIN WETLAND AREAS, IF THE CONTRACTOR DESIRES IN ORDER TO FACILITATE THE WORK.
- ALL PROPOSED RETAINING WALLS AND END WALLS SHALL BE CEMENTED FIELD STONE MASONRY (MHD SD 302.2.0) OR CEMENT CONCRETE MASONRY (MHD SD 302.1.0) OR AS OTHERWISE SHOWN ON THE PLANS. EXACT HEIGHTS OF THESE WALLS SHALL BE AS SHOWN ON THE CROSS SECTIONS OR DETAILS OR AS DIRECTED IN THE FIELD BY THE ENGINEER.
- IN EXCAVATION AREAS, ALL TOPSOIL SHALL BE REMOVED TO A DEPTH OF 12" (MINIMUM) OR AS DIRECTED BY THE ENGINEER AND SHALL BE STOCKPILED FOR RESPREADING AFTER BACKFILLING IS COMPLETED.
- MAILBOXES, FENCES, STREET SIGNS, ETC. THAT NEED TO BE REMOVED AND RESET OR RELOCATED SHALL BE DONE SO TO THE SATISFACTION OF THE OWNER. ALL ITEMS SHALL BE SET TO MHD STANDARDS.
- CONTRACTOR SHALL COMPLY IN ALL RESPECTS WITH ALL ENVIRONMENTAL PERMITS ISSUED FOR THIS PROJECT.

TRAFFIC MANAGEMENT NOTES


- PRIOR TO COMMENCEMENT OF ANY CONSTRUCTION, THE CONTRACTOR SHALL SUBMIT A TRAFFIC MANAGEMENT PLAN FOR APPROVAL BY THE ENGINEER IN WRITING.
- ANY REQUIRED TEMPORARY CHANNELIZATION OF TRAFFIC SHALL BE ACCOMPLISHED THROUGH THE USE OF REFLECTORIZED PLASTIC DRUMS WITH STEADY BURN LIGHTS TYPE "C", EXCEPT THAT THE FIRST THREE DRUMS USED AT EACH END OF A STRING OF DRUMS SHALL HAVE ATTACHED FLASHER TYPE "A".
- MAXIMUM SPACING OF DRUMS SHALL BE 20 FEET ON TAPER, 40 FEET ON TANGENT.
- ALL SIGNS SHALL BE BLACK LEGEND ON A REFLECTIVE ORANGE BACKGROUND AND IN ACCORDANCE WITH MHD STANDARDS. ALL CONSTRUCTION SIGNS SHALL BE ATTACHED TO THEIR OWN INDEPENDENT SUPPORTS.
- ALL CONSTRUCTION TRAFFIC CONTROL DEVICES SHALL BE IMMEDIATELY REMOVED WHEN NO LONGER NEEDED. ADVANCE WARNING SIGNS NO LONGER APPLICABLE SHALL BE EITHER COVERED OR REMOVED.
- THE CONTRACTOR SHALL MAINTAIN ACCESS AND EGRESS AT ALL TIMES TO ALL PROPERTIES ABUTTING THE WORK AREA.
- AT THE END OF EACH WORKDAY, ALL ROADWAYS SHALL BE OPEN FOR TWO-WAY TRAFFIC BY FILLING EXCAVATIONS TO GRADE OR BY THE USE OF STEEL PLATES.
- DURING NON-WORKING HOURS, NO LATERAL DROP-OFF WILL BE PERMITTED WITHIN THE AREA OF EXCAVATION ADJACENT TO ANY TRAVELLED WAY.
- IT IS ANTICIPATED THAT SHORT-TERM DETOURS (3 DAYS OR LESS) MAY BE ALLOWABLE FOR PORTIONS OF WATER STREET, THAYER STREET, TAYLOR STREET, FARESE ROAD AND FARESE ROAD EXTENSION, AND VINE STREET. ALL PROPOSED DETOURS MUST BE REVIEWED IN DETAIL WITH THE ENGINEER AND WRITTEN APPROVAL OF THE DETOUR PLAN MUST BE OBTAINED PRIOR TO IMPLEMENTATION.
- NO DETOUR OF MAIN STREET TRAFFIC WILL BE ALLOWED.

GENERAL CONSTRUCTION SEQUENCING

- THE CONTRACTOR SHALL SUBMIT A WRITTEN PROJECT SEQUENCE AND SCHEDULE FOR APPROVAL BY THE ENGINEER IN WRITING PRIOR TO ANY CONSTRUCTION ACTIVITIES TAKING PLACE.
- THE CONTRACTOR SHALL GENERALLY PROCEED IN A DOWNSTREAM TO UPSTREAM FASHION.
- SEQUENCING FOR WORK IN THE VINE STREET AREA HAS BEEN DESCRIBED IN DETAIL FOR PERMITTING PURPOSES AND IS INCLUDED IN THE CONSTRUCTION PLANS.
- UNDER NO CIRCUMSTANCES SHALL ANY DIVERSION STRUCTURE BE PLACED INTO OPERATION BEFORE ALL DOWNSTREAM WORK HAS BEEN ACCEPTED FOR USE.

LEGEND

EXISTING		PROPOSED	
	FIRE HYDRANT		APPROX. STREET LINES
	WATER GATE		APPROX. PROPERTY LINES
	SEWER MANHOLE		EDGE OF PAVEMENT
	CATCH BASIN		PAVED WALKS
	DRAIN MANHOLE		CURB LINES
	PIPE OUTLET		EDGE OF DRIVES
	GAS GATE		FENCE
	UTILITY POLE		STONE WALL
	GUY WIRE		CONCRETE WALL
	SPOT GRADES		OVERHEAD WIRES
	APPROX. BORING LOCATION WITH APPROX. GROUND SURFACE ELEVATION		GAS LINE
	SHRUB OR MISC. TREE		SEWER LINE
	HEDGE LINE		DRAIN LINE
	TREE LINE		WATER LINE
	WETLAND AREA		TELEPHONE LINE
			BUILDING
			WETLAND BOUNDARY
			STREAMS
			100' WETLAND BUFFER ZONE
			SUPPLEMENTARY EROSION CONTROL BARRIER
			REQUIRED PERMANENT EASEMENT
			REQUIRED TEMPORARY EASEMENT
			CONSTRUCTION BASELINES
			DIVERSION CULVERTS
			CATCH BASIN (OR DROP INLET)
			DRAINAGE MANHOLE
			SAN. SEWER MANHOLE
			DIRECTION OF FLOW
			CURB (OR BERM) - TYPE NOTED
			EDGE OF PAVING OR SIDEWALK
			DRAIN PIPE (DOUBLE LINE 24" AND OVER)
			SEWER MAN
			SPOT GRADE
			SLOPE
			DETAIL "A" AS SHOWN ON SHEET NO. 8 (TYP.)

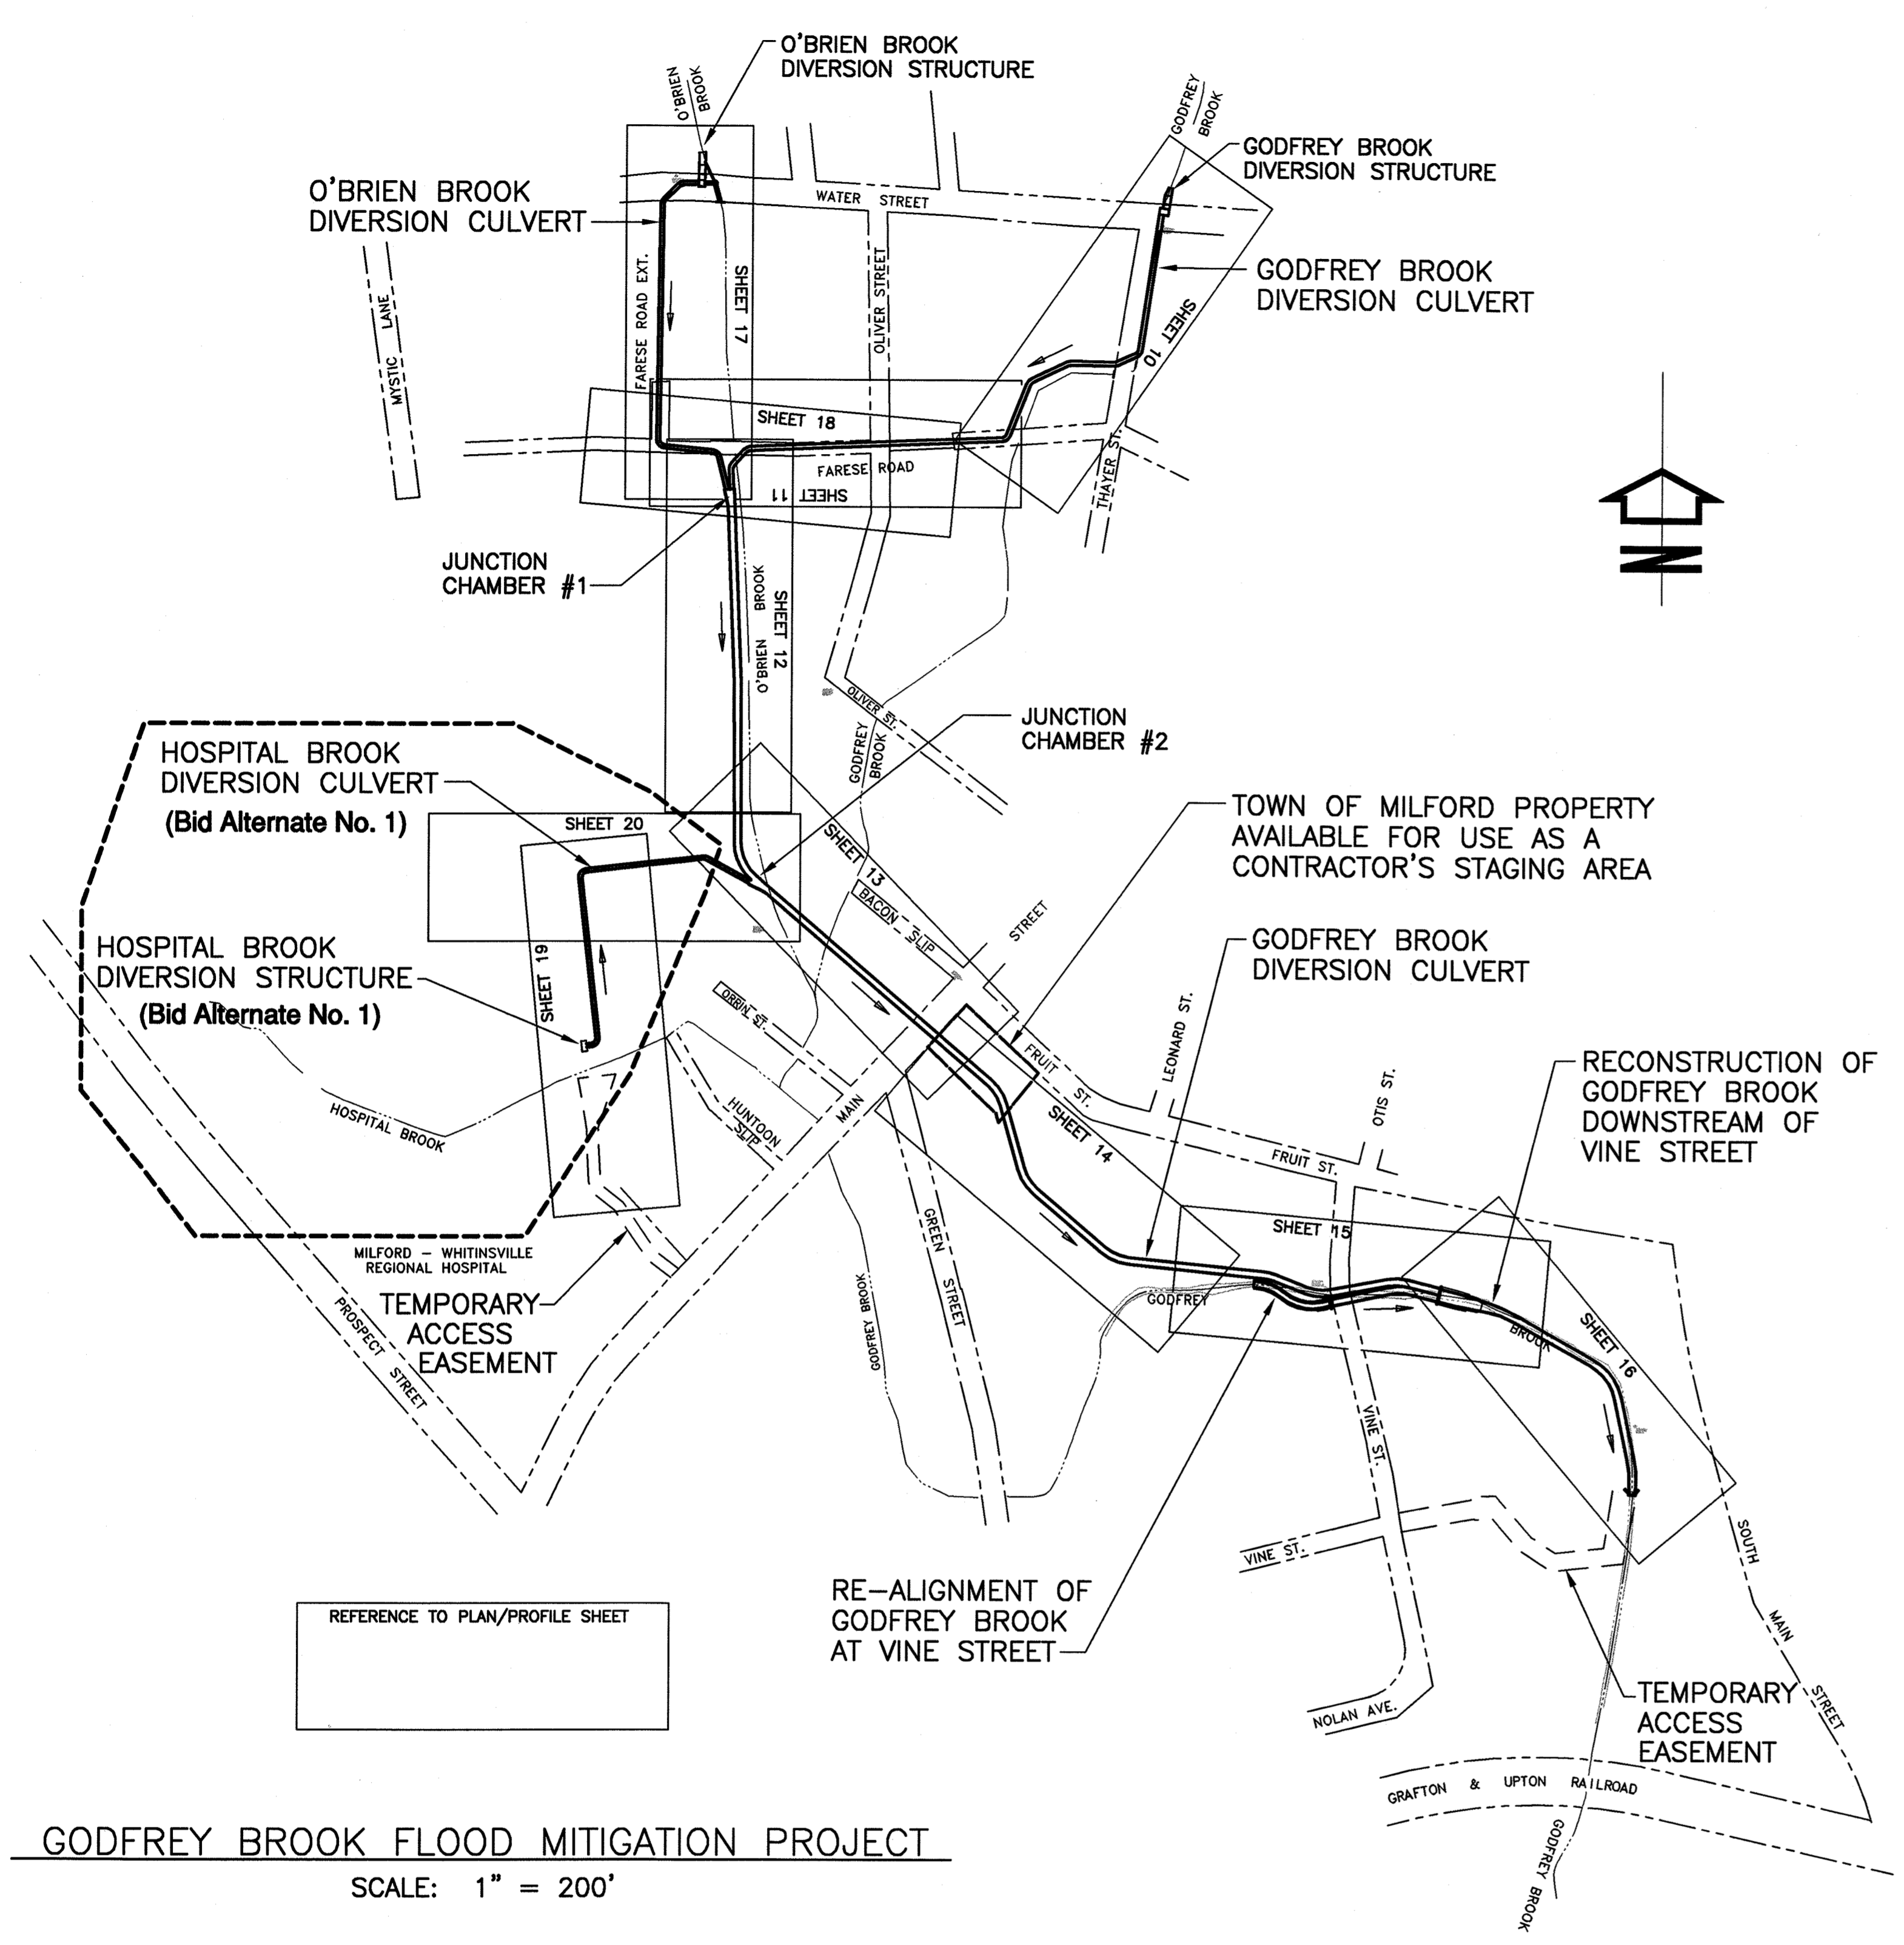

GODFREY BROOK FLOOD MITIGATION PROJECT
SCALE: 1" = 200'

ABBREVIATIONS

Aban.	Abandon	Hyd.	Hydrant	Rem.	Remove
Approx.	Approximately	Inv	Invert Elevation	Ret.	Retain
BB	Bituminous Berm	LP	Low Point	Ret. Wall	Retaining Wall
Bit. Conc.	Bituminous Concrete	Lt.	Left	R.O.W.	Right-of-Way
B	Baseline	M.H.	Manhole	R.R.	Railroad
Bldg.	Building	M.H.D.	Mass. Highway Department	Rt.	Right
B.M.	Bench Mark	Min.	Minimum	R/W	Right-of-Way
C.B.	Catch Basin	Max.	Maximum	San.	Sanitary
CEM.	Cement	NTS	Not to Scale	Sec.	Section
C.I.	Curb Inlet	O.C.	On Centers	Sects.	Sections (End sections for pipes)
C.I.P.	Cast Iron pipe	P.C.	Point of Curvature	Sh.	Sheet
CL	Center Line	P.C.C.	Point of Compound Curvature	S.M.H.	Sewer Manhole
Conc.	Concrete	P.I.	Point of Intersection	Sq. Yds.	Square Yards
Const.	Construct(ion)	P.L.	Property Line	St.	Station
Culv.	Culvert	P.R.C.	Point of Reverse Curvature	Surf.	Surfacing or Surface
Cu. Yds.	Cubic Yards	P.VCP	Poly-Vinyl-Chloride Pipe	S.W.	Sidewalk
D.I.	Drop Inlet	Proj.	Project	T. Tan.	Tangent
D.I.P.	Ductile Iron Pipe	Prop.	Proposed	Temp.	Temporary
Dr.	Drive	P.T.	Point of Tangency	Typ.	Typical
Elev. (or EL.)	Elevation	R	Radius of Curvature	Var.	Variable
Exc.	Excavation	R&R	Remove and Rebuild	V.C.	Vertical Curve
Exist. (or Ex.)	Existing	R&S	Remove and Stack	V.C.P.	Vitrified Clay Pipe
GC	Granite Curb	RCP	Reinforced Concrete Pipe	Vert.	Vertical
Gar.	Garage	Rd.	Road	Wd.	Wood
Gran.	Granite	Rdwy.	Roadway	X-Sect.	Cross Section

BAYSTATE ENVIRONMENTAL CONSULTANTS INC.
296 North Main Street
East Longmeadow, MA 01028
Surveyors
Scientists
Engineers


PROJECT NO. 94-1215
SCALE AS NOTED
DATE: APRIL 1999
DRAWN BY: EDM
CHECKED BY: TEJ

Index Plan
Godfrey Brook Flood Mitigation Project
Milford, Massachusetts

NO.	DATE	REVISION
1	10/1/01	ISSUED AS RECORD PRINT
2	8/12/99	ISSUED FOR BIDDING

AutoCAD File: P:\AUTOCAD\ADMIN\941215\RECORD DRAWINGS\Sheet 2.dwg Plotted at: Thu Oct 04 08:38:26 2001
BEC, Inc.

Autocad File: P:\AUTOCAD\ACAD\IN\944215\RECORD DRAWINGS\Sheet 3 4 5 6.dwg Plotted at: Thu Oct 04 08:50:46 2001
 BEC, Inc.

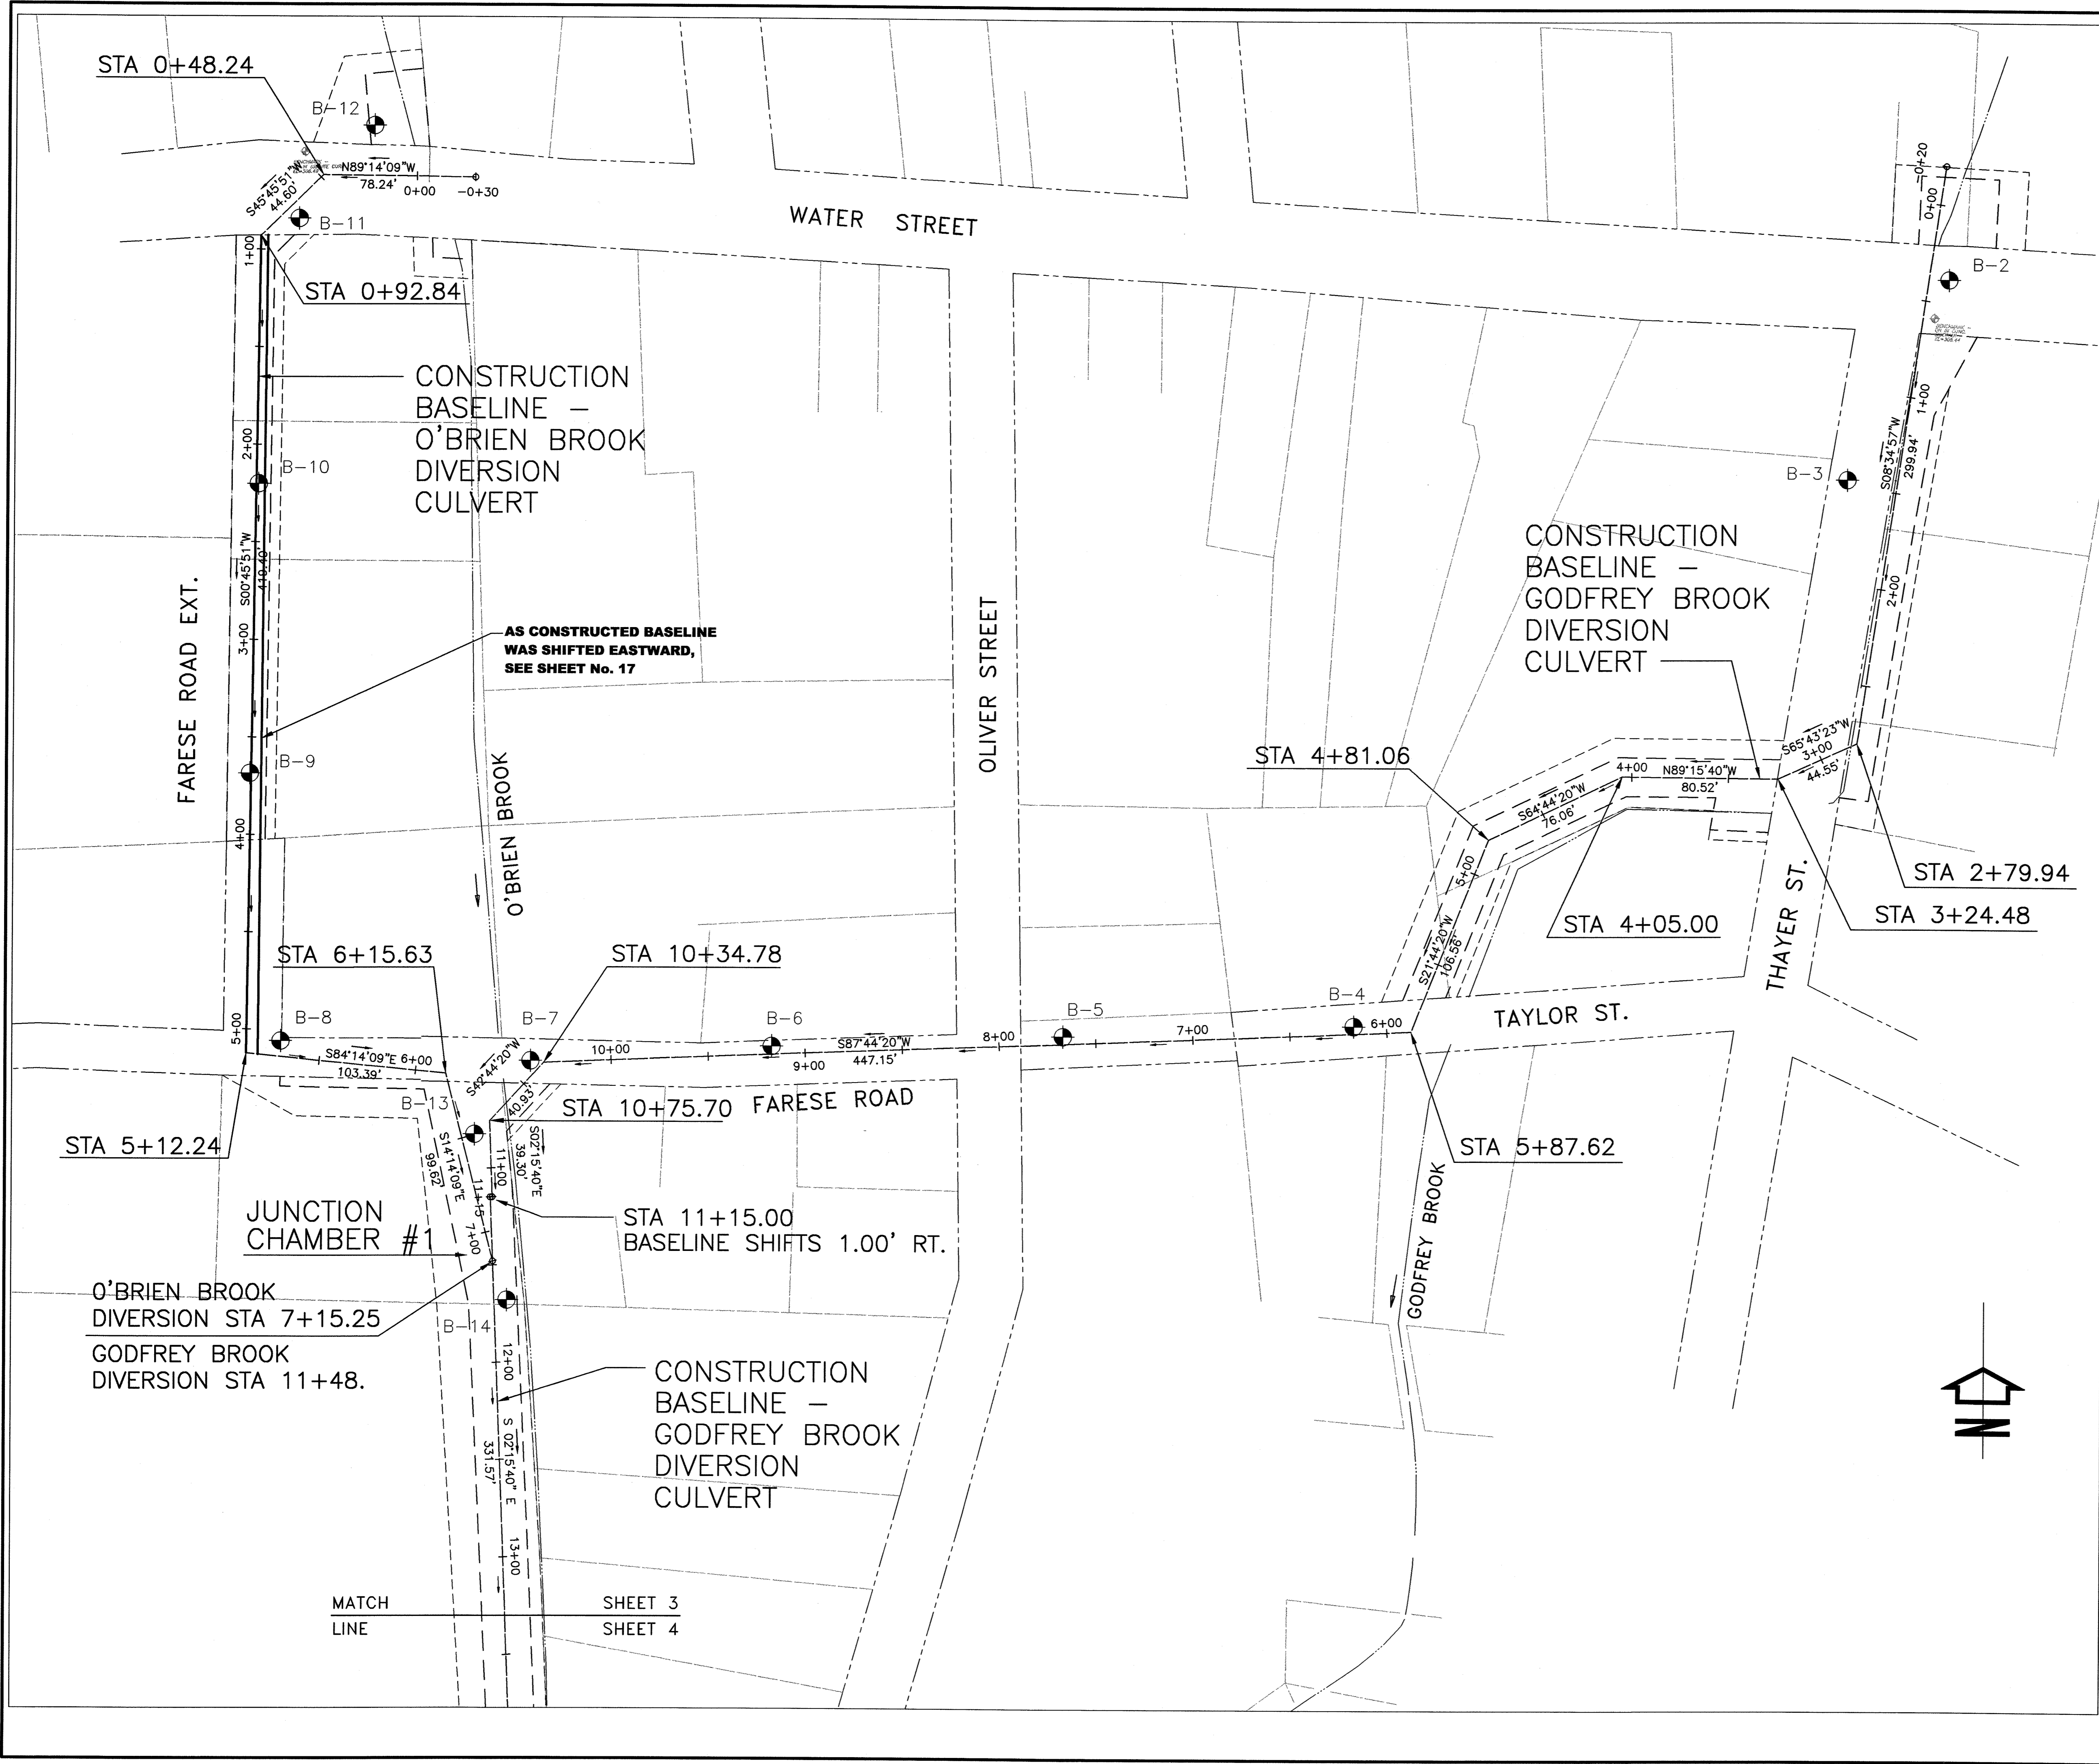

NOTE:
 LOCAL COORDINATED CONTROL POINTS
 WILL BE PROVIDED TO THE CONTRACTOR.


**CONSTRUCTION BASELINE
 COORDINATE LISTINGS**

GODFREY BROOK DIVERSION CULVERT:

STATION	COORDINATES
-0+20.00 (BEGIN)	N 414802.98 E 593331.85
11+15.00	N 414270.22 E 592584.68
BASELINE SHIFTS 1.00' RT. AT GODFREY BROOK STA 11+15.00	
11+15.00 1.00'R	N 414270.68 E 592583.68

O'BRIEN BROOK DIVERSION CULVERT:

STATION	COORDINATES
-0+30.00 (BEGIN)	N 414794.08 E 592573.40
7+15.25 (END)	N 414237.70 E 592584.99
INTERSECTION AT GODFREY BROOK STA 11+48.00	

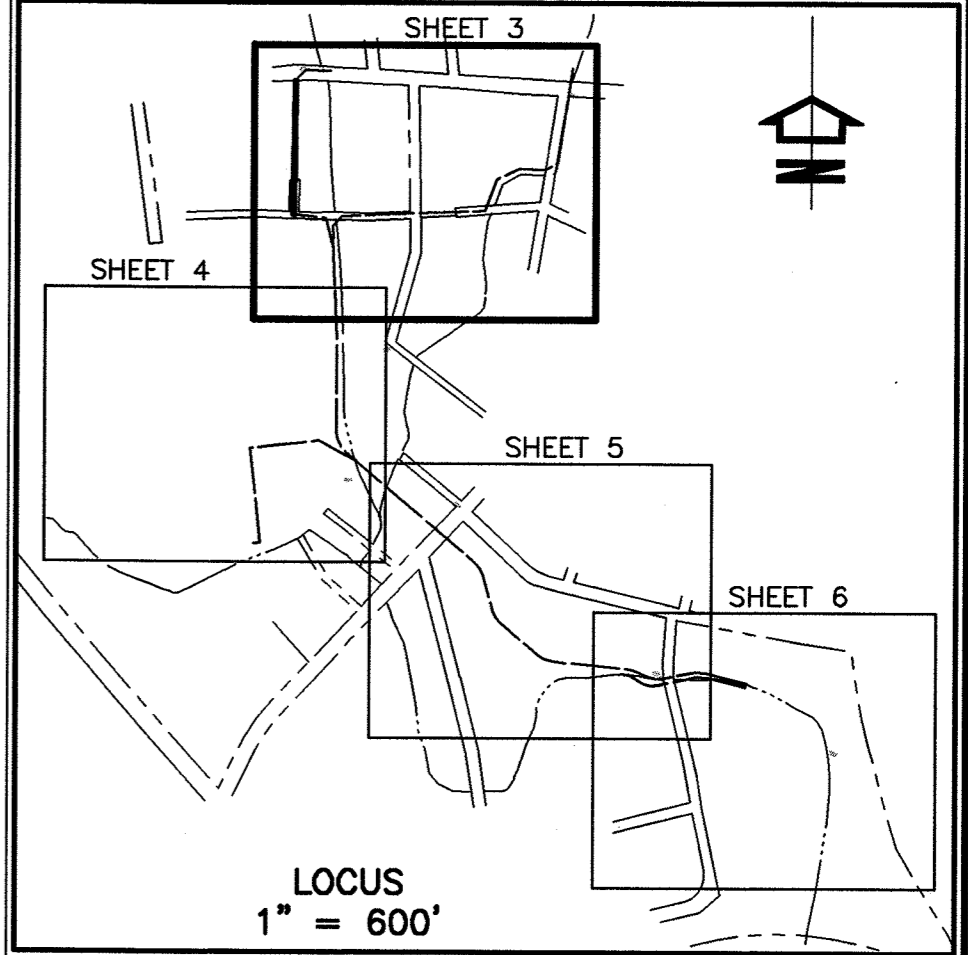

LEGEND

- EXISTING STREAM CHANNELS
- - - APPROXIMATE STREET LINES
- - - APPROXIMATE PROPERTY LINES
- CONSTRUCTION BASELINES, WITH FLOW DIRECTION
- - - REQ'D. TEMPORARY EASEMENTS
- - - REQ'D. PERMANENT EASEMENTS
- B-29 APPROXIMATE BORING LOCATION
BORING LOGS INCLUDED WITH SPECIFICATIONS

3 of 35 SHEETS

BAYSTATE ENVIRONMENTAL CONSULTANTS INC.
 Scientists
 298 North Main Street
 East Longmeadow, MA 01028

DEC
 Engineers
 298 North Main Street


PROJECT NO. 94-1215
 SCALE 1" = 40'
 DATE APRIL 1999
 DRAWN BY EDM
 CHECKED BY TEJ

Layout Plan No. 1

**Godfrey Brook Flood Mitigation Project
 Milford, Massachusetts**

NO.	DATE	REVISION	BY
1	8/12/99	ISSUED FOR BIDDING	TEJ
2	10/1/01	ISSUED AS RECORD PRINT	EDM

AUTOCAD FILE: P:\AUTOCAD\ACAD\DRAWING\941215\RECORD DRAWINGS\Sheet 3 4 5.dwg Plotted at: Tue Oct 02 08:04:14 2001
 REC, INC.

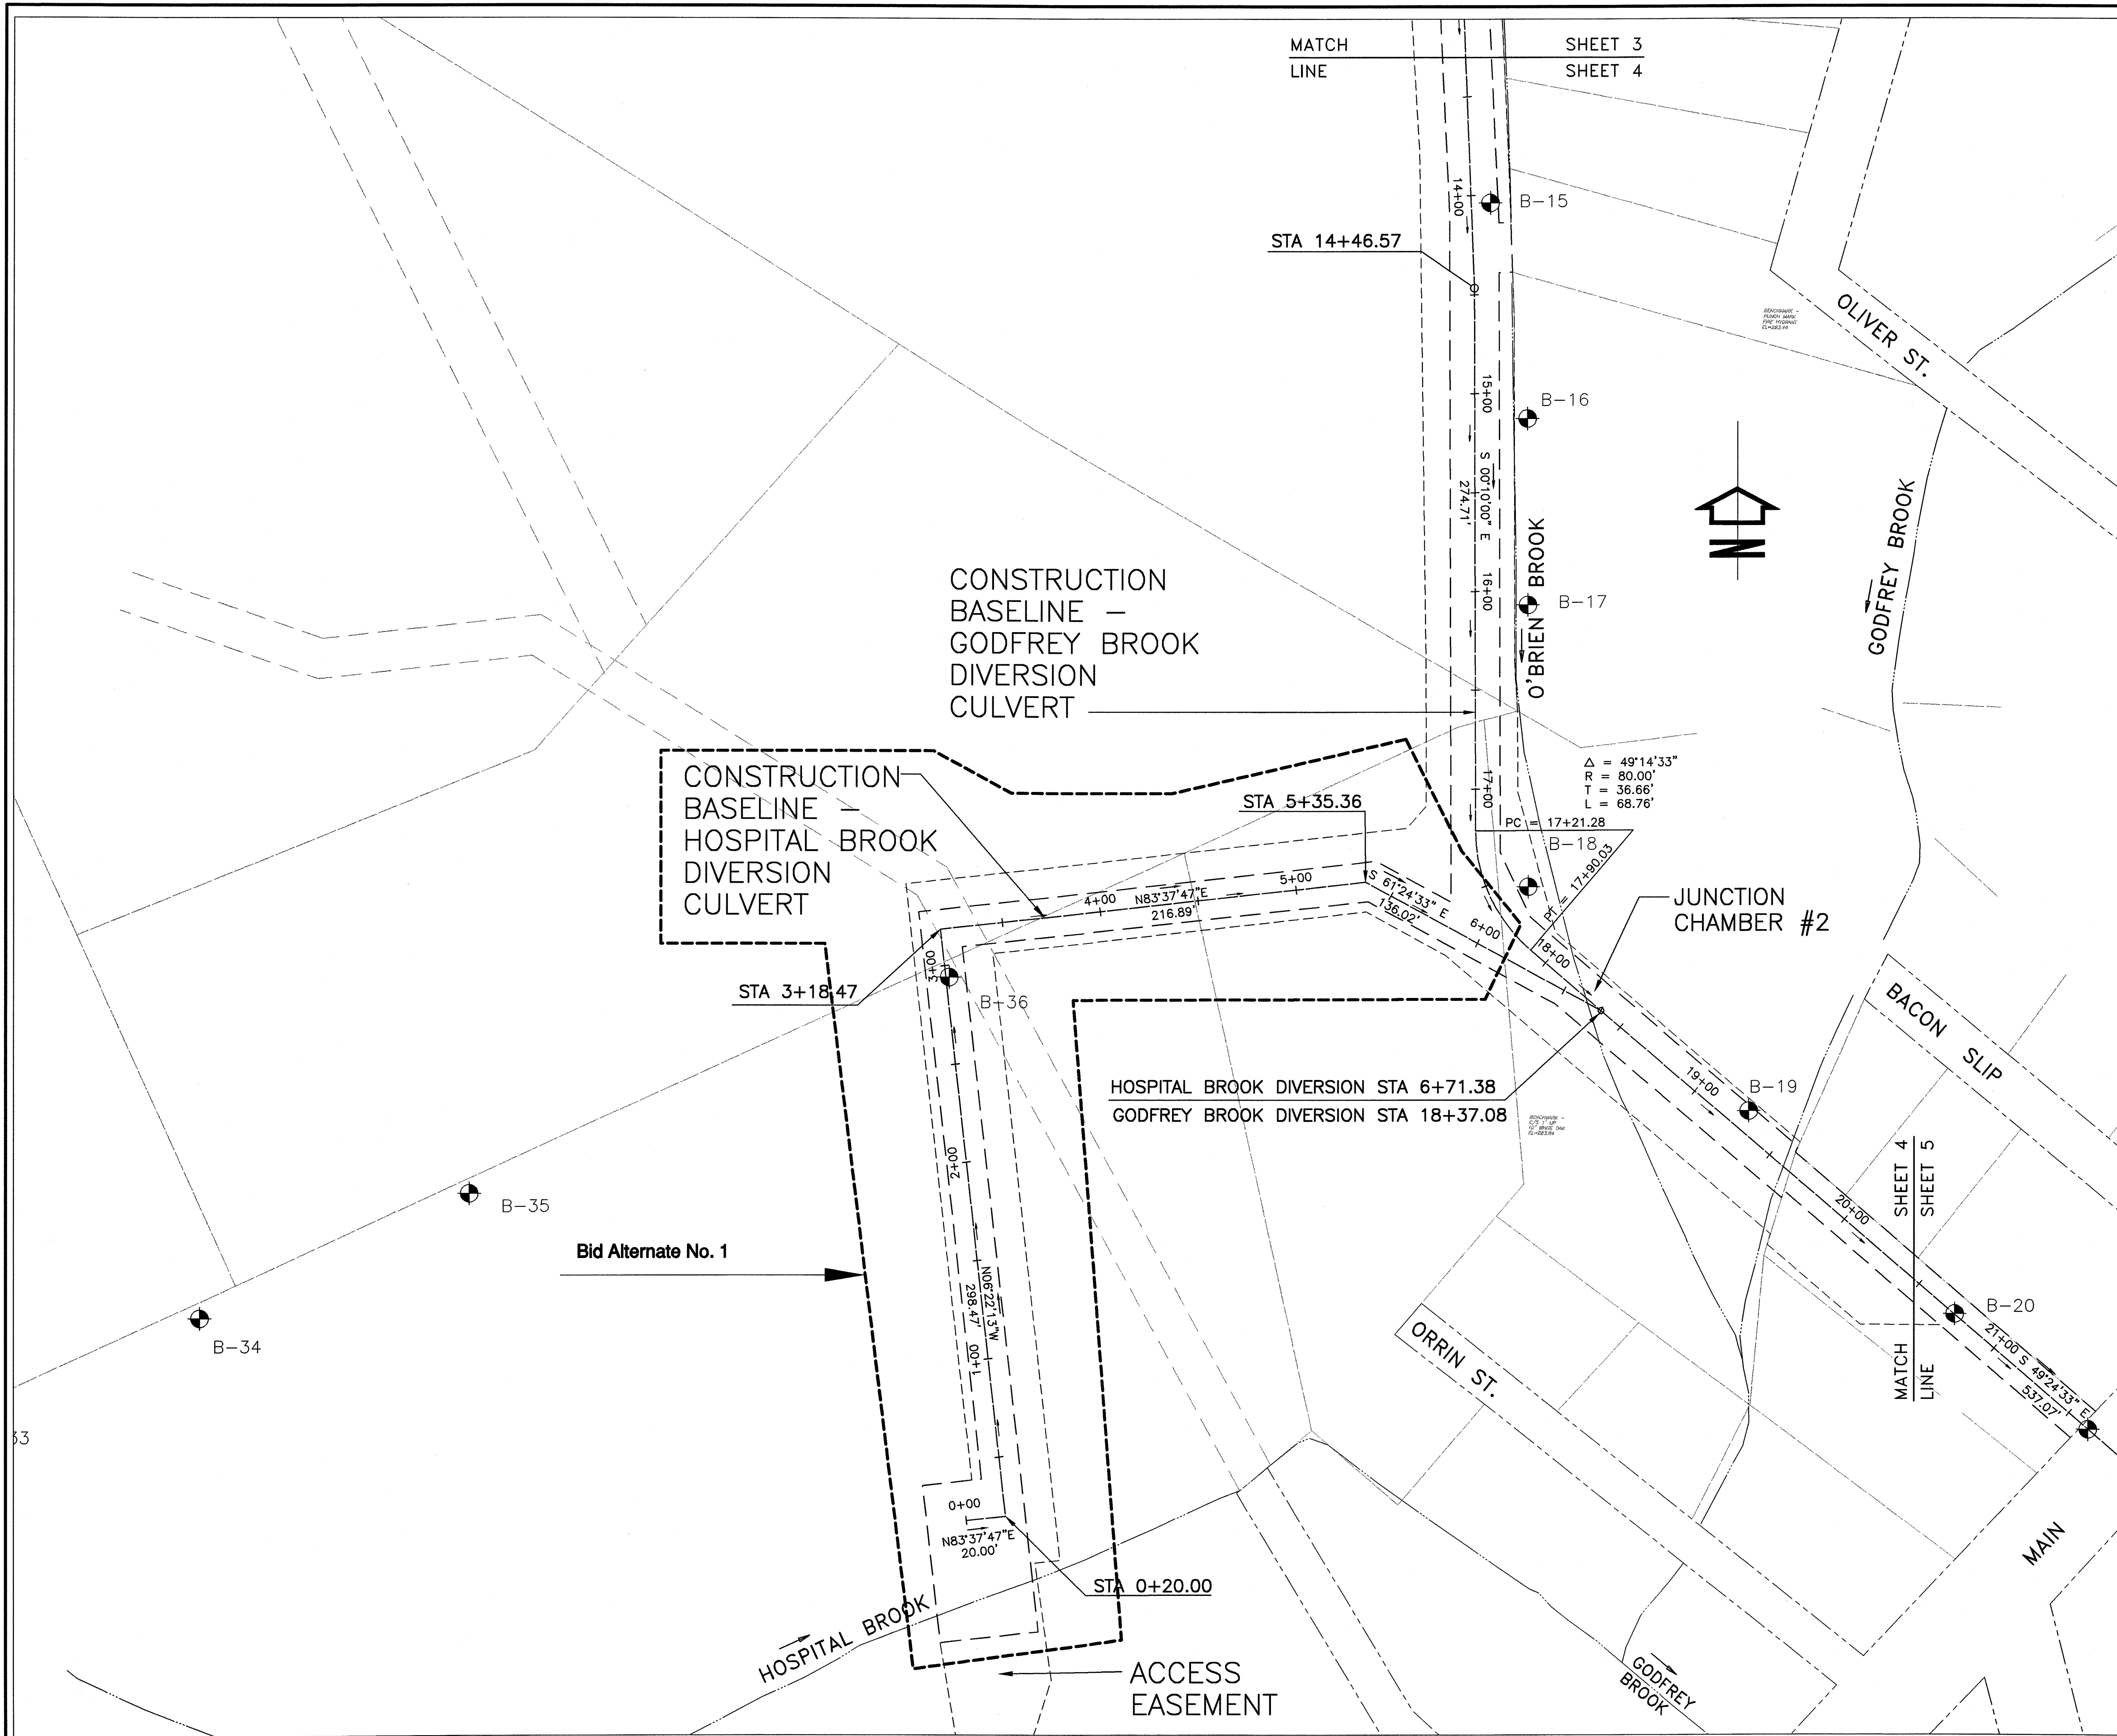


NOTE:
 LOCAL COORDINATED CONTROL POINTS
 WILL BE PROVIDED TO THE CONTRACTOR.

**CONSTRUCTION BASELINE
 COORDINATE LISTINGS**

HOSPITAL BROOK
 DIVERSION CULVERT:

STATION	COORDINATES
0+00.00 (BEGIN)	N 413315.71 E 592339.50
6+71.38 (END)	N 413573.53 E 592661.24

INTERSECTION AT
 GODFREY BROOK STA 18+37.08

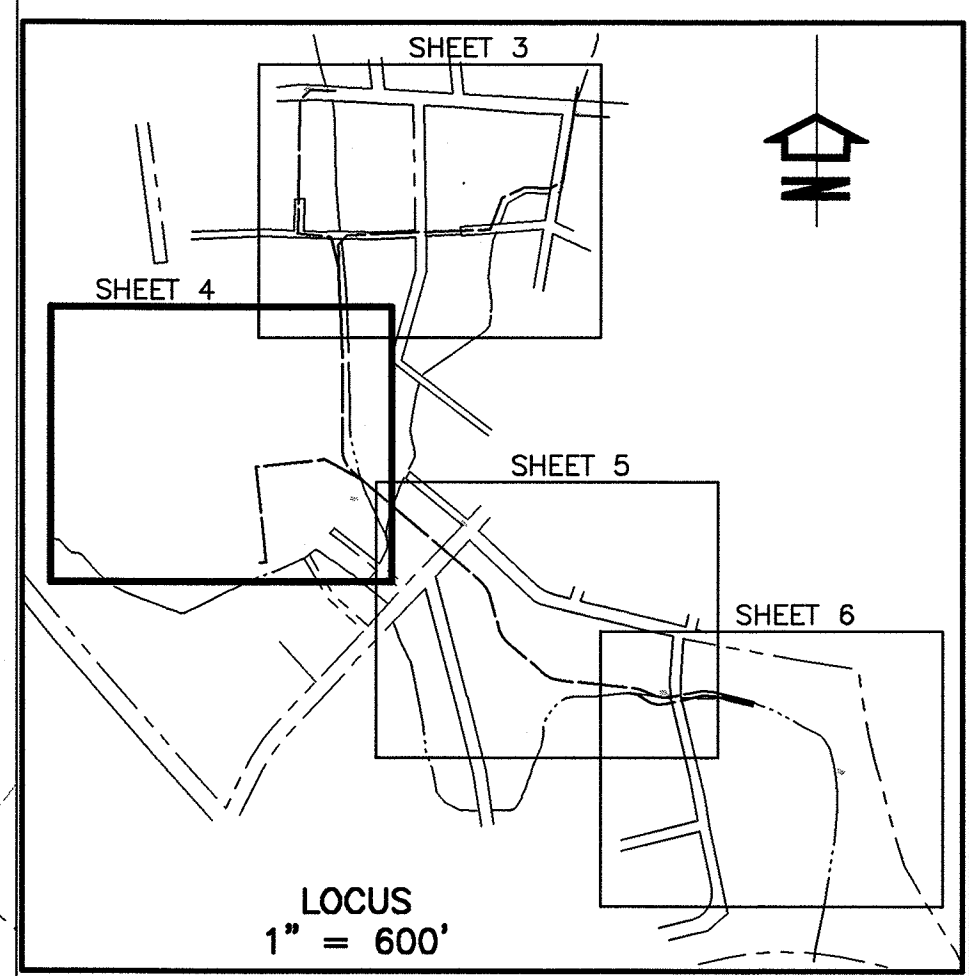


COORDINATES SHOWN ARE
 MASSACHUSETTS COORDINATE SYSTEM
 GRID NORTH - MAINLAND ZONE

LEGEND

	EXISTING STREAM CHANNELS
	APPROXIMATE STREET LINES
	APPROXIMATE PROPERTY LINES
	CONSTRUCTION BASELINES, WITH FLOW DIRECTION
	REQ'D. TEMPORARY EASEMENTS
	REQ'D. PERMANENT EASEMENTS
	APPROXIMATE BORING LOCATION BORING LOGS INCLUDED WITH SPECIFICATIONS

PROJECT NO.	94-1215	DATE	APRIL 1999	SCALE	1" = 40'	DRAWN BY	EDM	CHECKED BY	TEJ	SHEET NO.	4	TOTAL SHEETS	35
Layout Plan No. 2													
Godfrey Brook Flood Mitigation Project Milford, Massachusetts													
PROJECT	EDM	TEJ	BY										
ISSUED AS RECORD PRINT	10/1/01	8/12/99	DATE										
ISSUED FOR BIDDING	1		NO.										
REVISION													

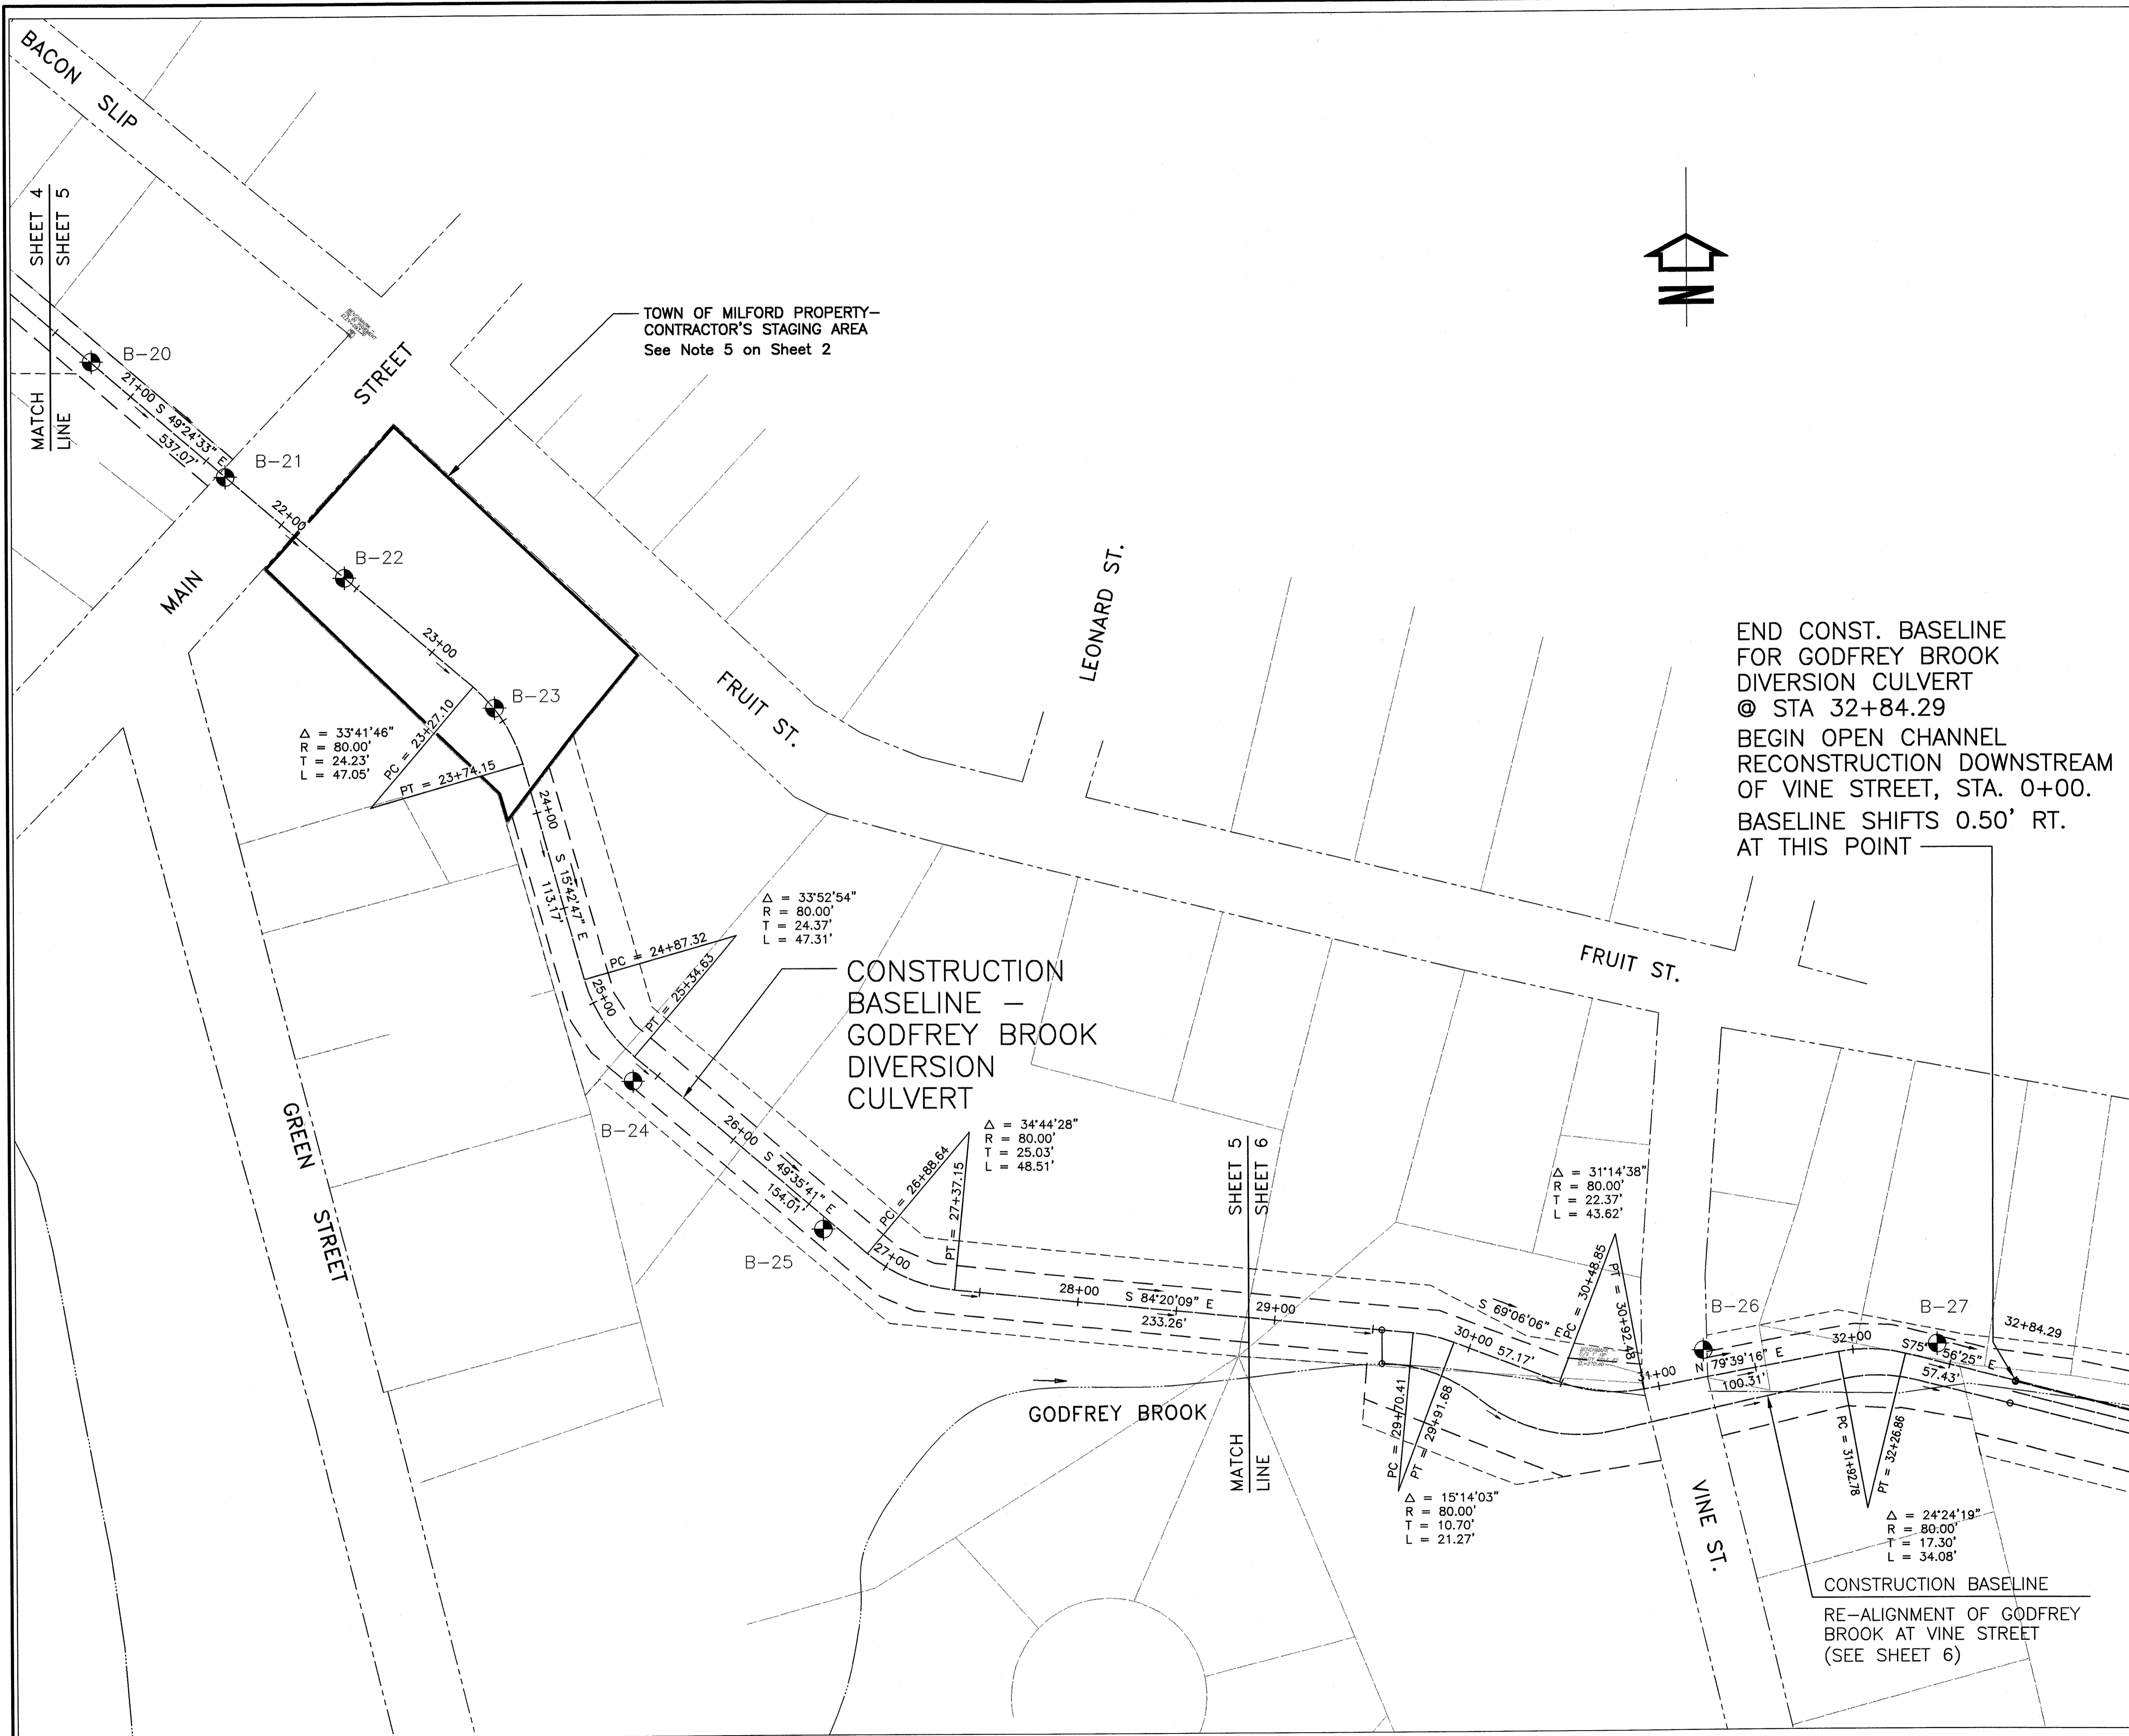

NOTE:
LOCAL COORDINATED CONTROL POINTS
WILL BE PROVIDED TO THE CONTRACTOR.


**CONSTRUCTION BASELINE
COORDINATE LISTINGS**

**GODFREY BROOK
DIVERSION CULVERT:**

STATION	COORDINATES
-0+20.00 (BEGIN)	N 414802.98 E 593331.85
32+84.29 (END)	N 412899.62 E 593812.61

BASELINE SHIFTS 0.50' RT.
AT GODFREY BROOK STA 32+84.29
= RECONSTRUCTION OF
GODFREY BROOK, STA 0+00.00

END CONST. BASELINE
FOR GODFREY BROOK
DIVERSION CULVERT
@ STA 32+84.29
BEGIN OPEN CHANNEL
RECONSTRUCTION DOWNSTREAM
OF VINE STREET, STA. 0+00.
BASELINE SHIFTS 0.50' RT.
AT THIS POINT


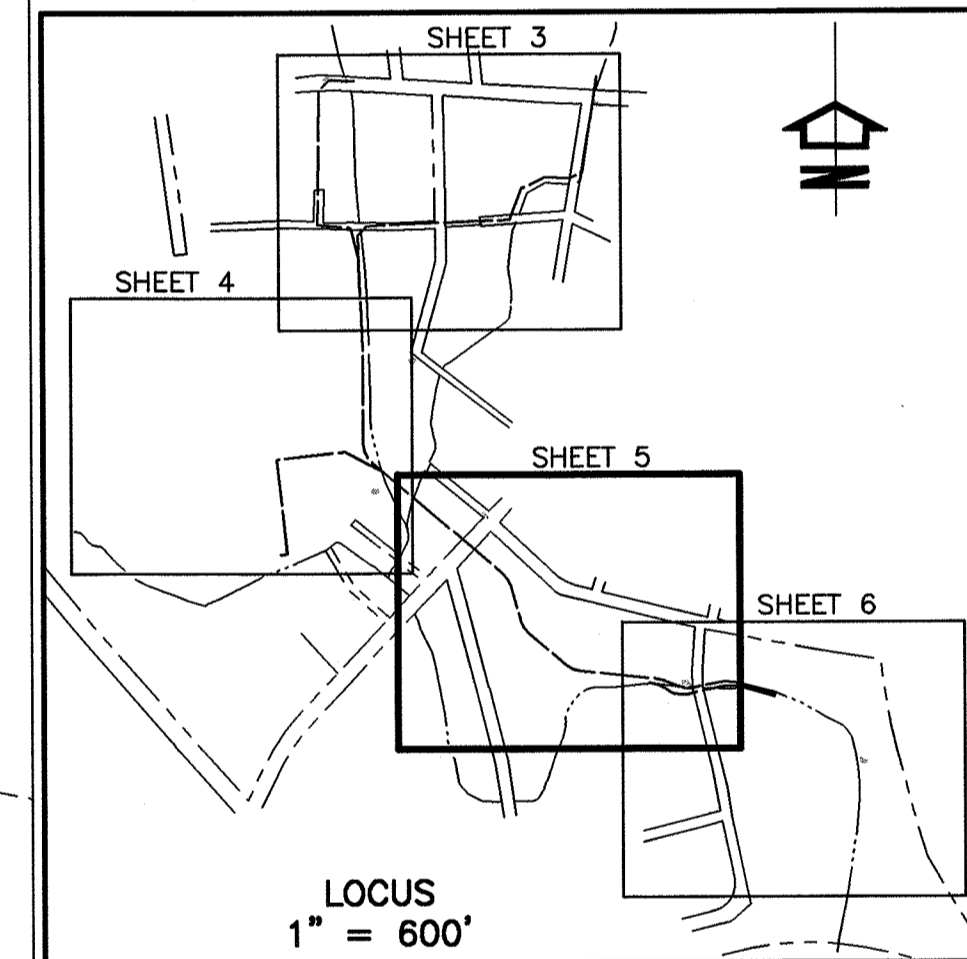


COORDINATES SHOWN ARE
MASSACHUSETTS COORDINATE SYSTEM
GRID NORTH - MAINLAND ZONE

LEGEND

- EXISTING STREAM CHANNELS
- APPROXIMATE STREET LINES
- APPROXIMATE PROPERTY LINES
- CONSTRUCTION BASELINES, WITH FLOW DIRECTION
- REQ'D. TEMPORARY EASEMENTS
- REQ'D. PERMANENT EASEMENTS
- APPROXIMATE BORING LOCATION
BORING LOGS INCLUDED WITH SPECIFICATIONS

DRAWING NO. 5 OF 35 SHEETS	
BAYSTATE ENVIRONMENTAL CONSULTANTS INC.	
Engineers 286 North Main Street East Longmeadow, MA 01028	Scientists Surveyors East Longmeadow, MA 01028
PROJECT NO. 94-1215 SCALE 1" = 40' DATE APRIL 1999 DRAWN BY EDM CHECKED BY TEJ	PROJECT TITLE Godfrey Brook Flood Mitigation Project Milford, Massachusetts
SHEET TITLE Layout Plan No. 3	PROJECT EDM TEJ BY
ISSUED AS RECORD PRINT 10/1/01	REVISION
ISSUED FOR BIDDING 8/12/99	DATE
NO.	REVISION

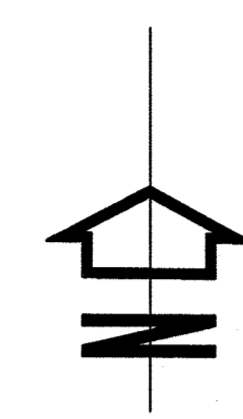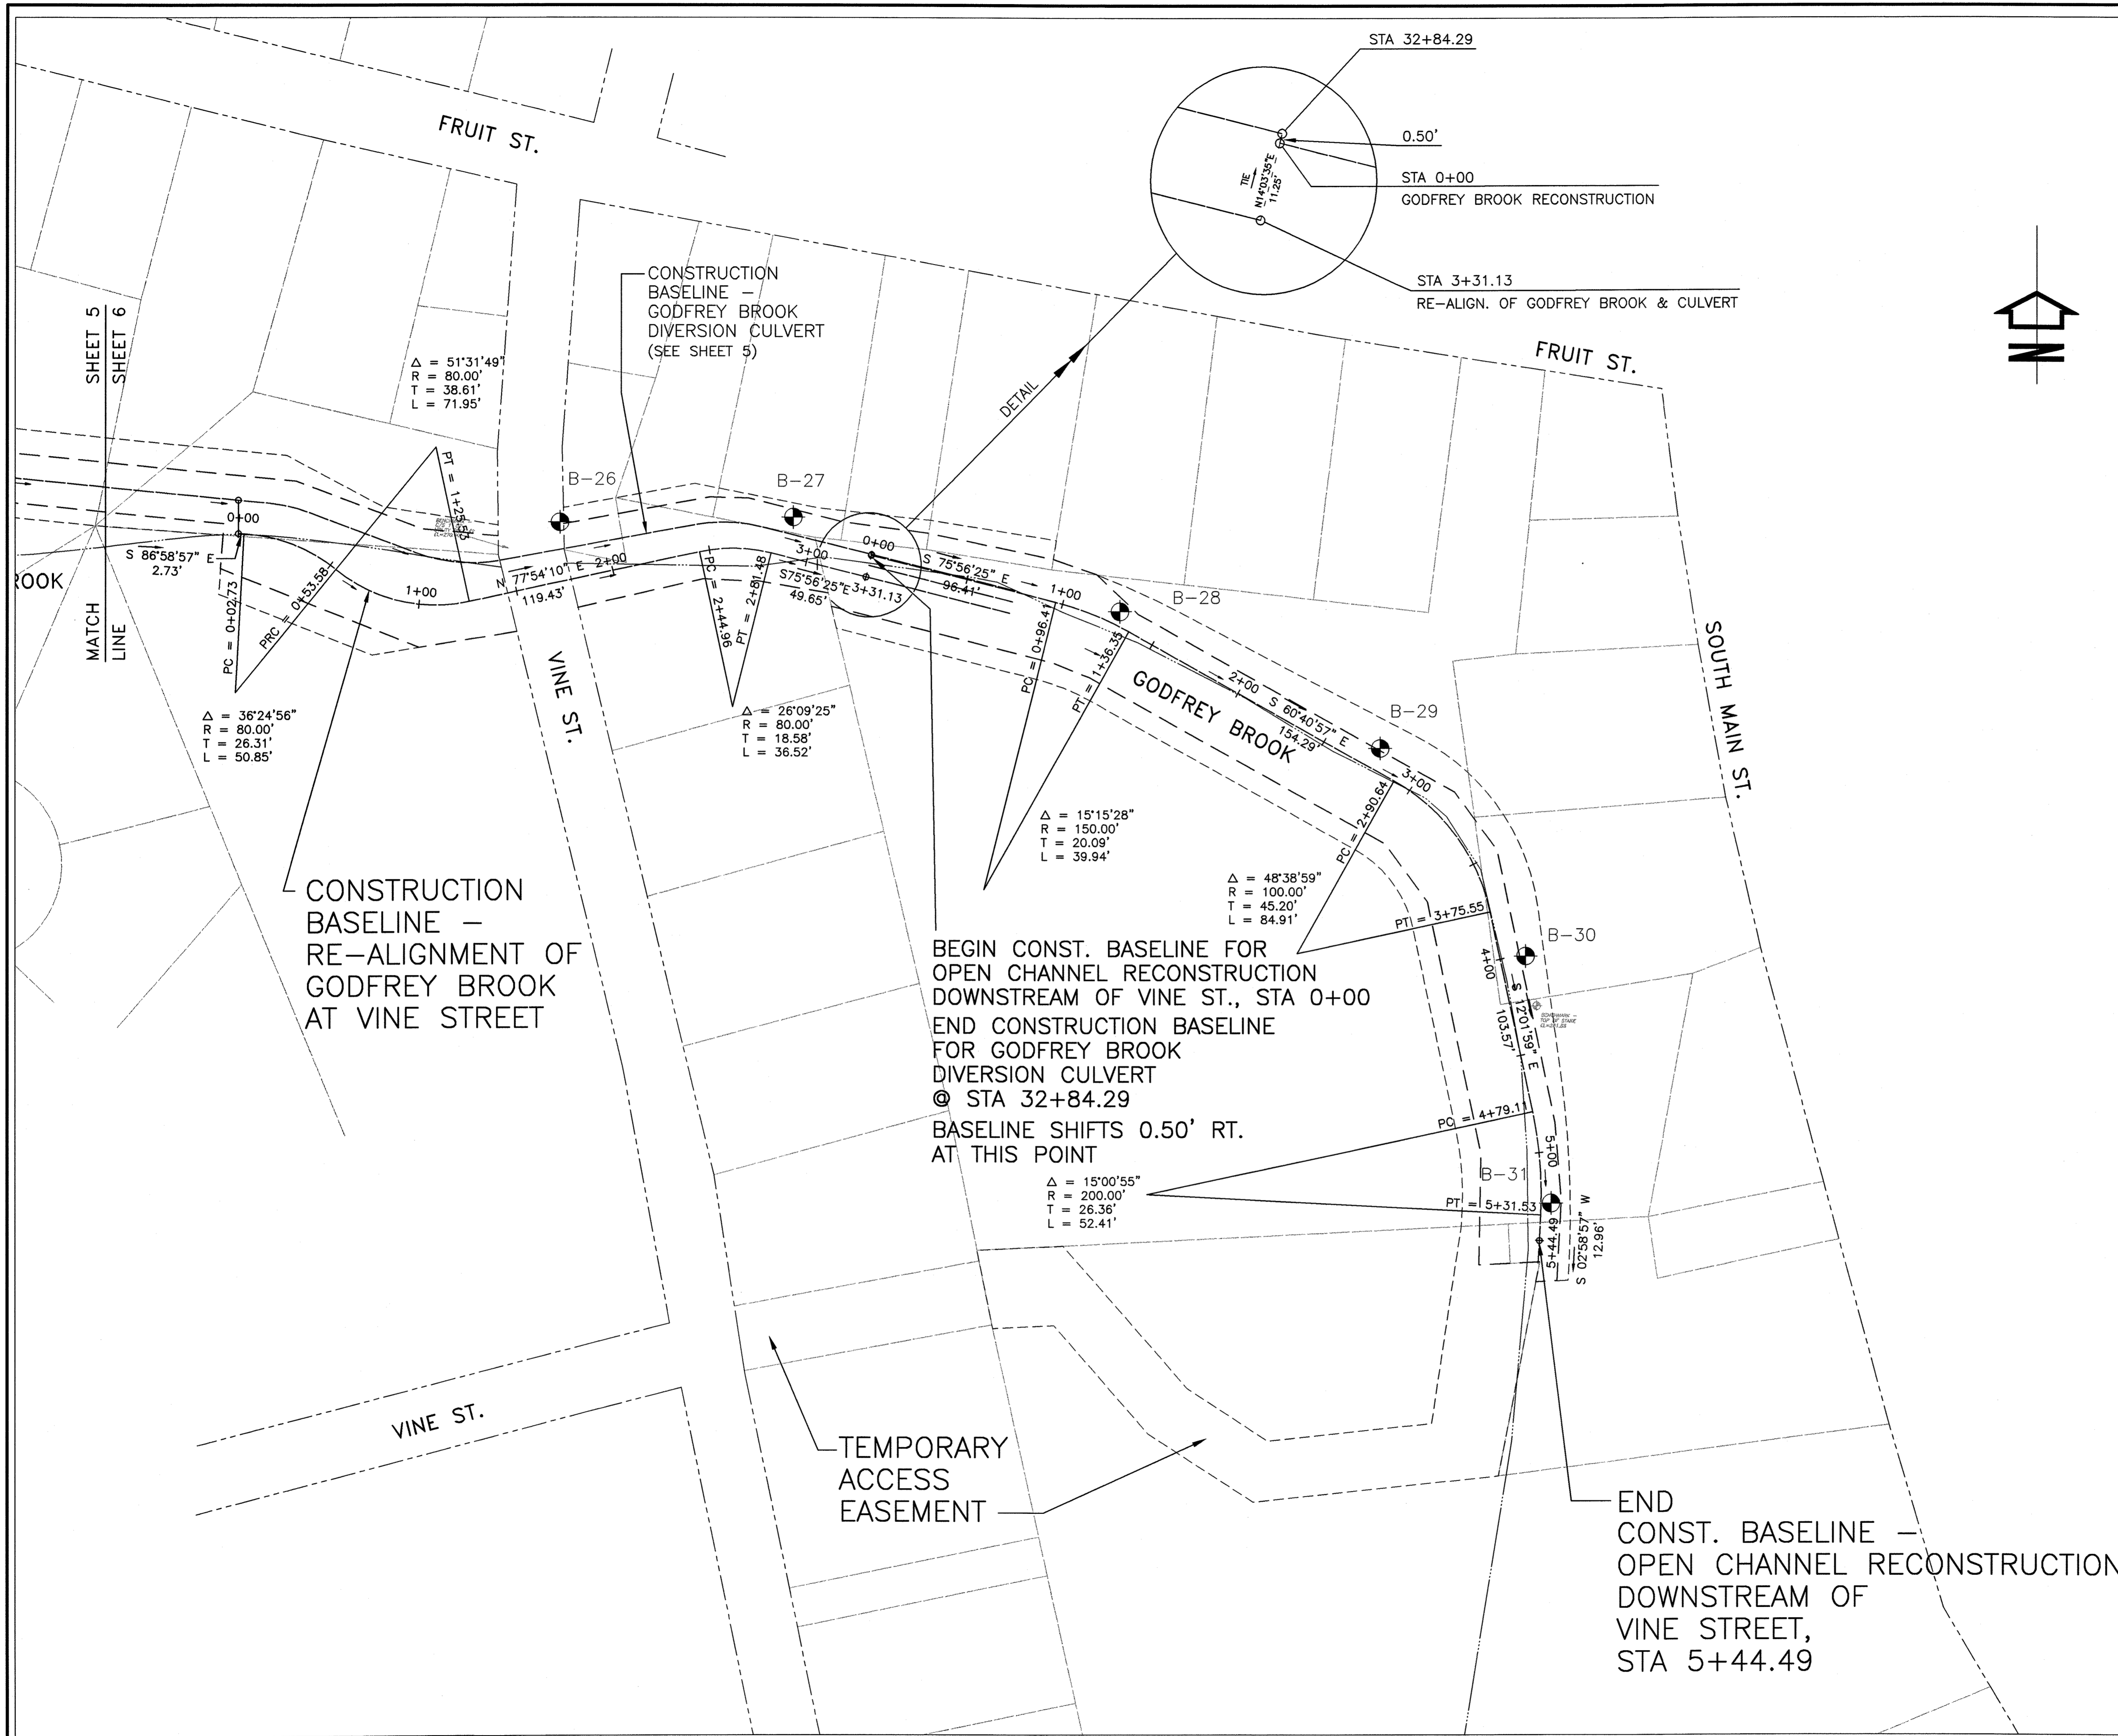

NOTE:
LOCAL COORDINATED CONTROL POINTS
WILL BE PROVIDED TO THE CONTRACTOR.


**CONSTRUCTION BASELINE
COORDINATE LISTINGS**

RE-ALIGNMENT OF GODFREY BROOK
AT VINE STREET:

STATION	COORDINATES
0+00.00 (BEGIN)	N 412910.55 E 523491.71
3+31.13 (END)	N 412888.22 E 593809.76

RECONSTRUCTION OF GODFREY BROOK
DOWNSTREAM OF VINE STREET:

STATION	COORDINATES
0+00.00 (BEGIN)	N 412899.13 E 593812.49
5+44.49 (END)	N 412552.75 E 594151.42


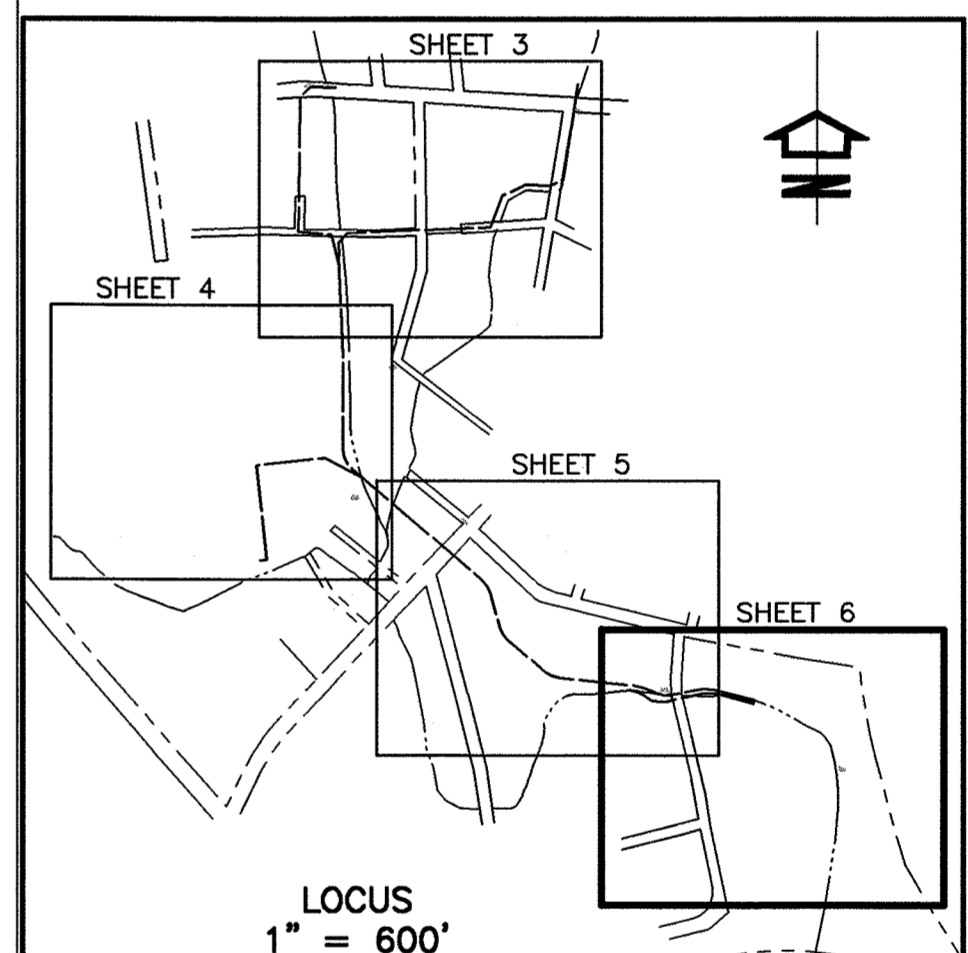


COORDINATES SHOWN ARE
MASSACHUSETTS COORDINATE SYSTEM
GRID NORTH - MAINLAND ZONE


LEGEND

- EXISTING STREAM CHANNELS
- APPROXIMATE STREET LINES
- APPROXIMATE PROPERTY LINES
- CONSTRUCTION BASELINES, WITH FLOW DIRECTION
- REQ'D. TEMPORARY EASEMENTS
- REQ'D. PERMANENT EASEMENTS
- APPROXIMATE BORING LOCATION
BORING LOGS INCLUDED WITH SPECIFICATIONS


6 of 35 SHEETS	
BAYSTATE ENVIRONMENTAL CONSULTANTS INC.	
Engineers 298 North Main Street Milford, Massachusetts 01208	Scientists East Longmeadow, MA 01028 Surveyors
PROJECT NO. 94-1215 SCALE 1" = 40' DATE APRIL 1999 DRAWN BY EDM CHECKED BY TEJ	SHEET TITLE Layout Plan No. 4
Godfrey Brook Flood Mitigation Project Milford, Massachusetts	
PROJECT EDM	BY
ISSUED AS RECORD PRINT 10/101	DATE
ISSUED FOR BIDDING 1	REVISION
9/12/99	DATE

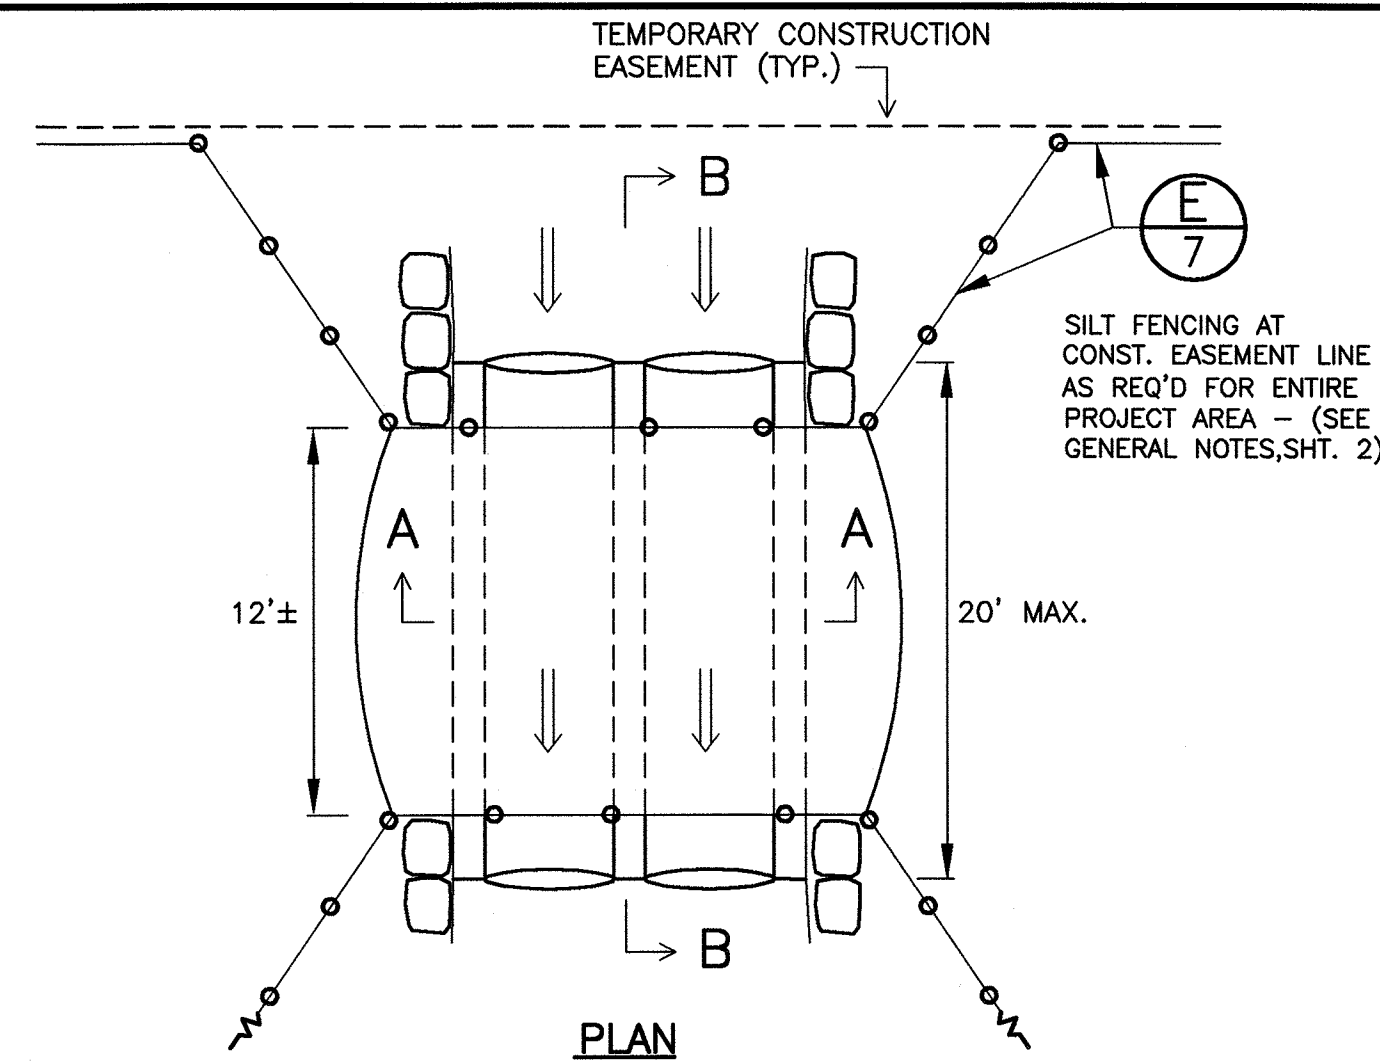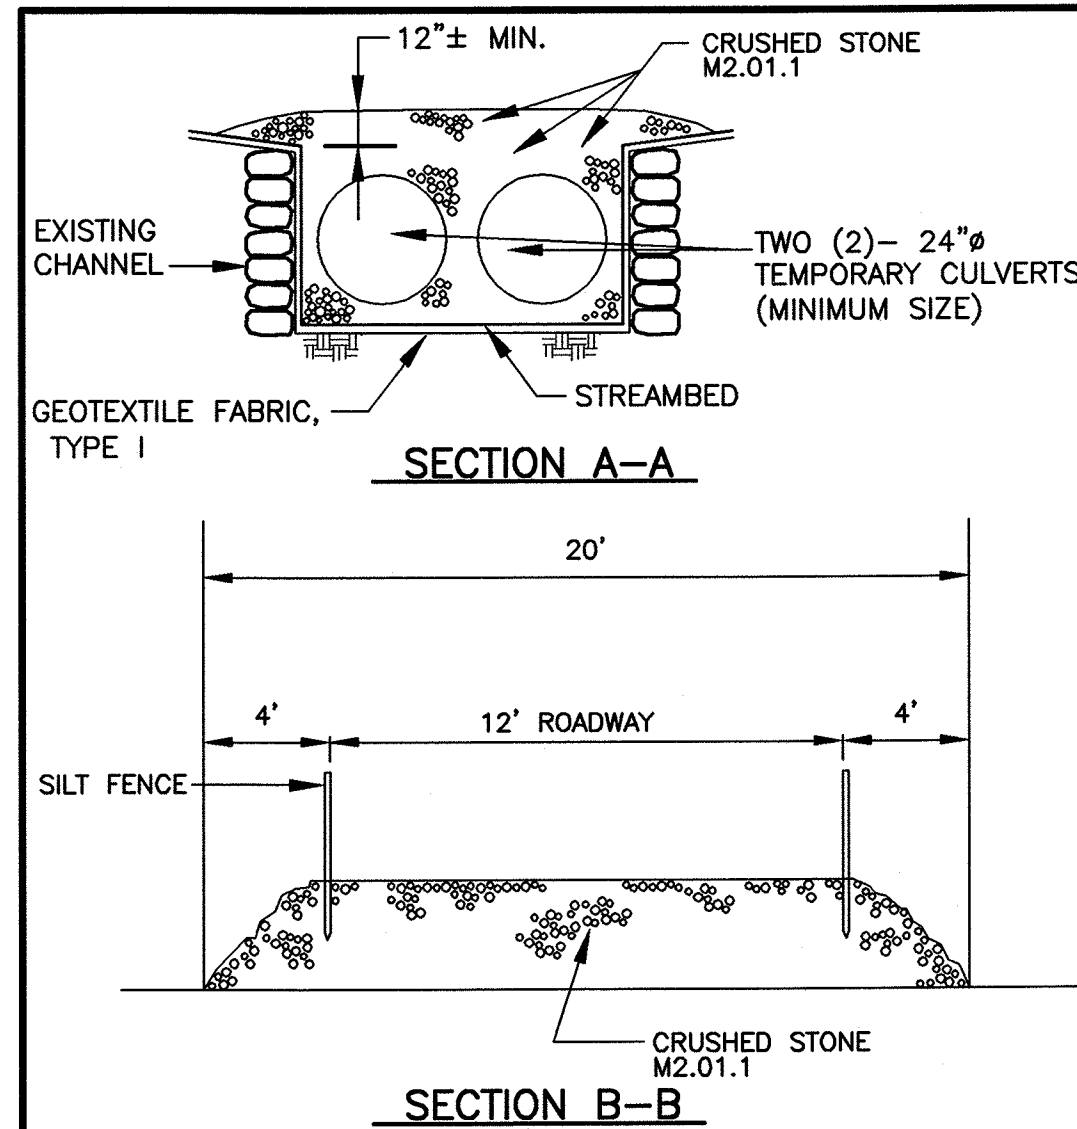


(A) 7 TEMPORARY BROOK CROSSING
TYPICAL DETAIL - APPLIES TO CROSSINGS OF HOSPITAL, O'BRIEN, & GODFREY BROOKS
NTS

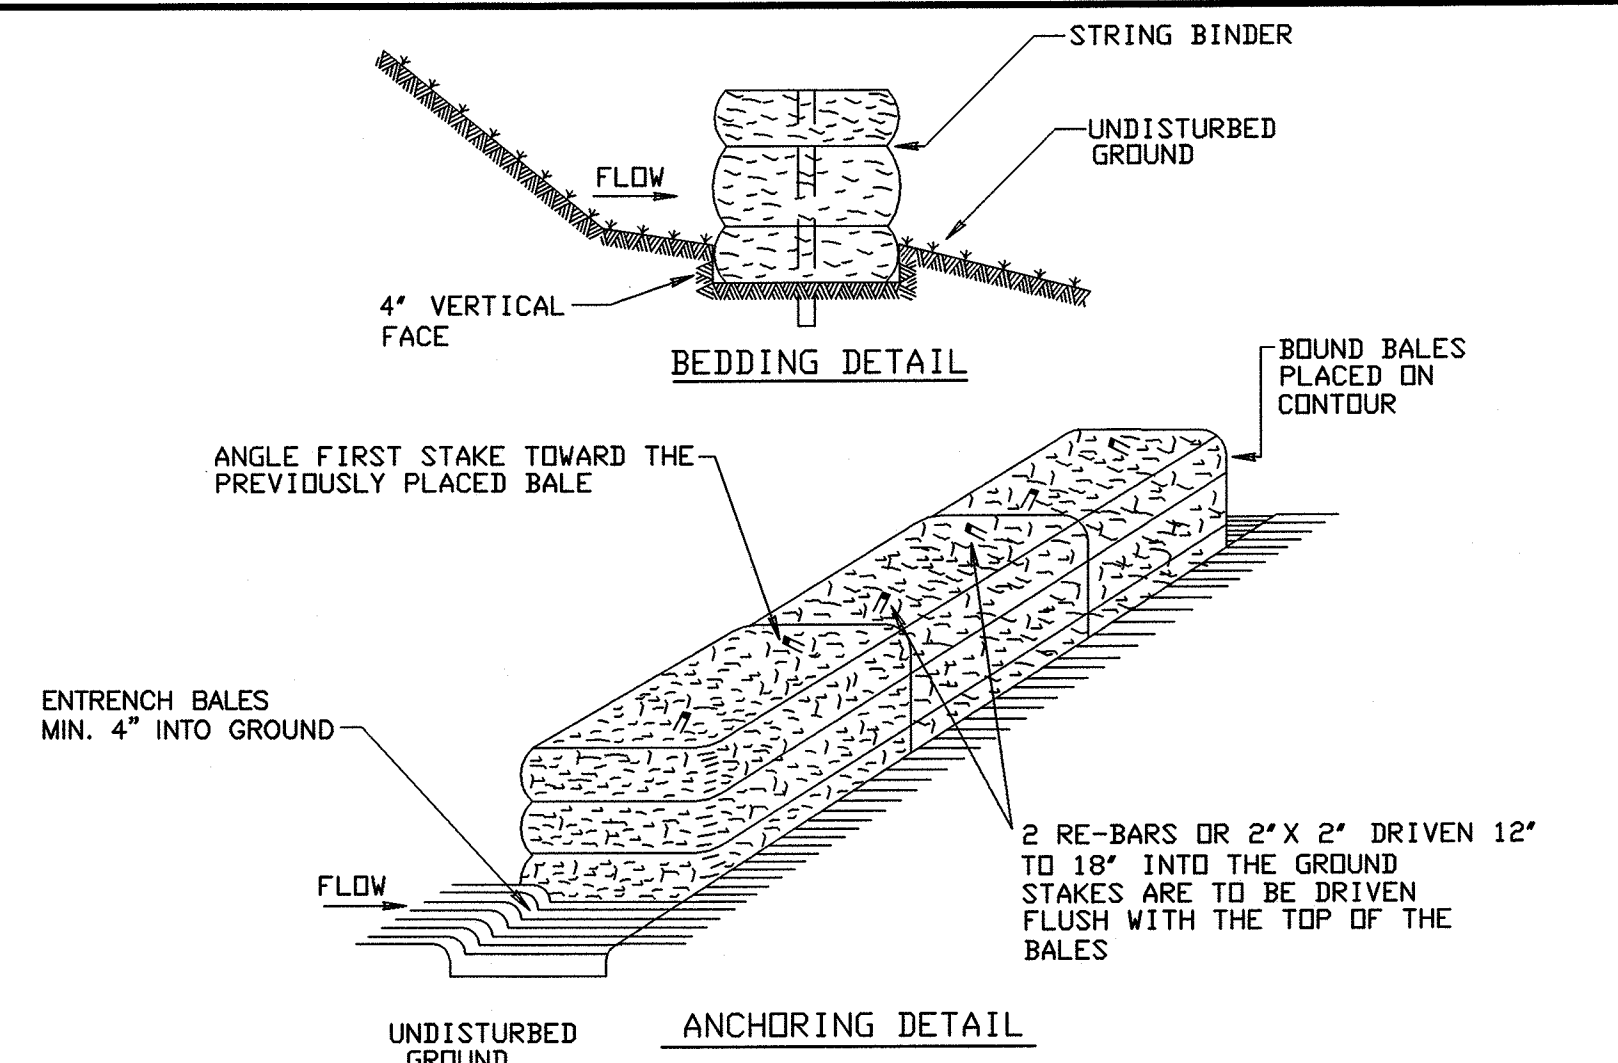


(B) 7 HAYBALE SILT BARRIER
NTS

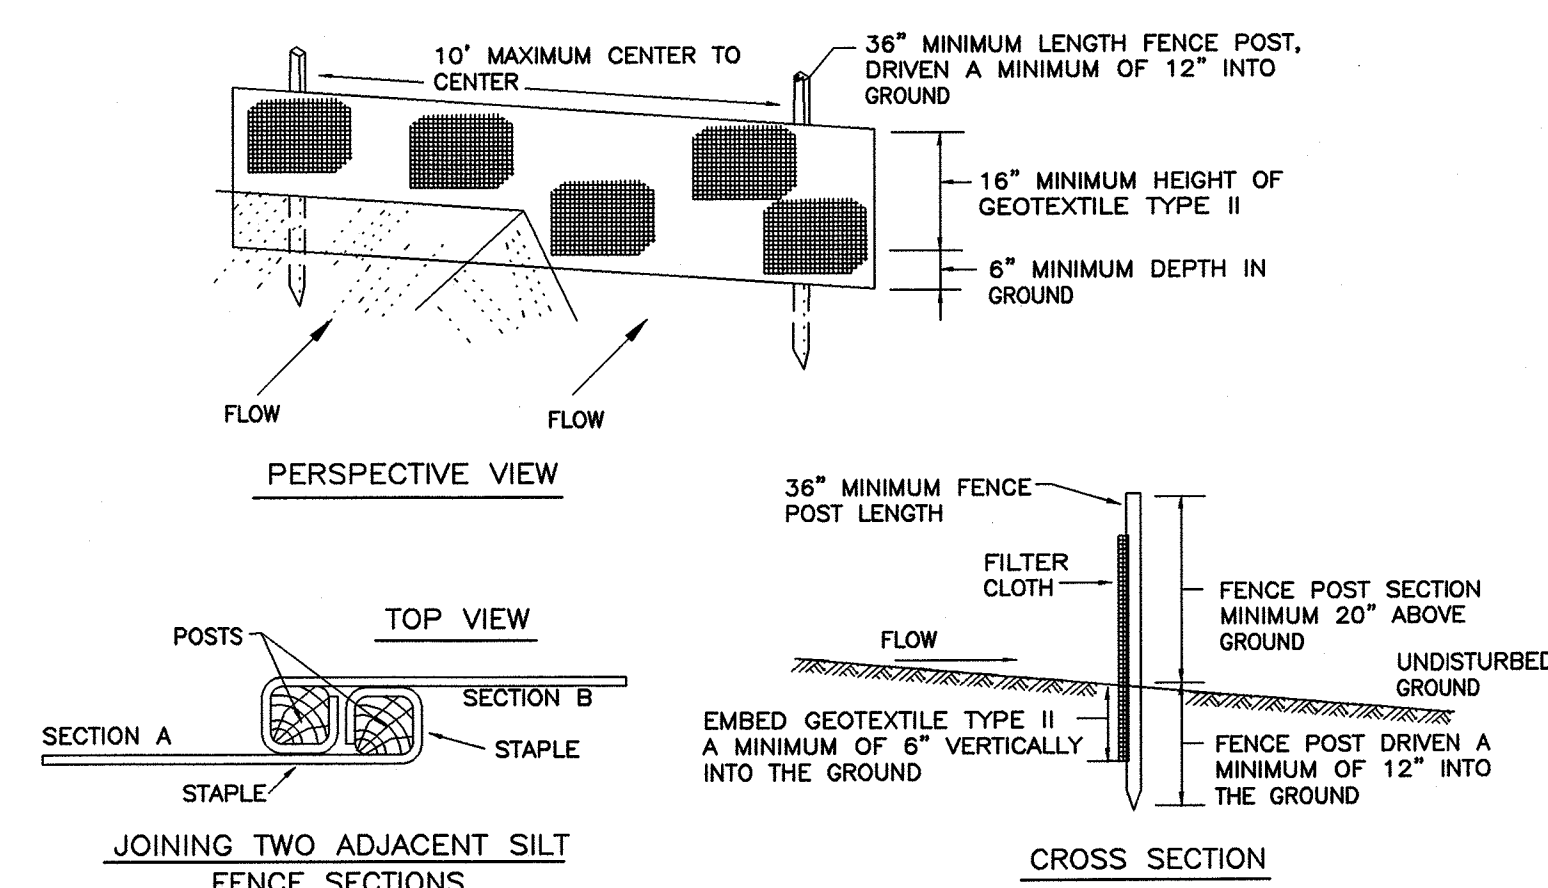


(E) 7 SILT FENCE DETAIL
NTS

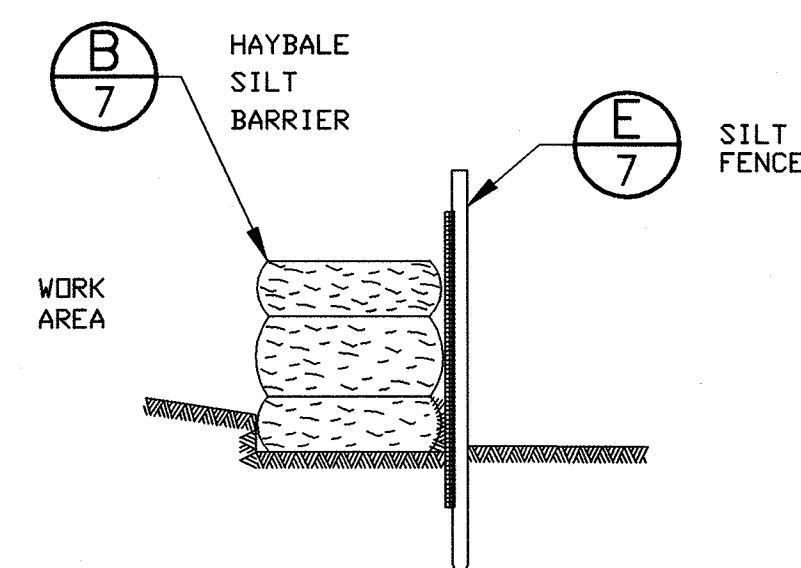


(F) 7 SUPPLEMENTARY EROSION CONTROL BARRIER
NTS

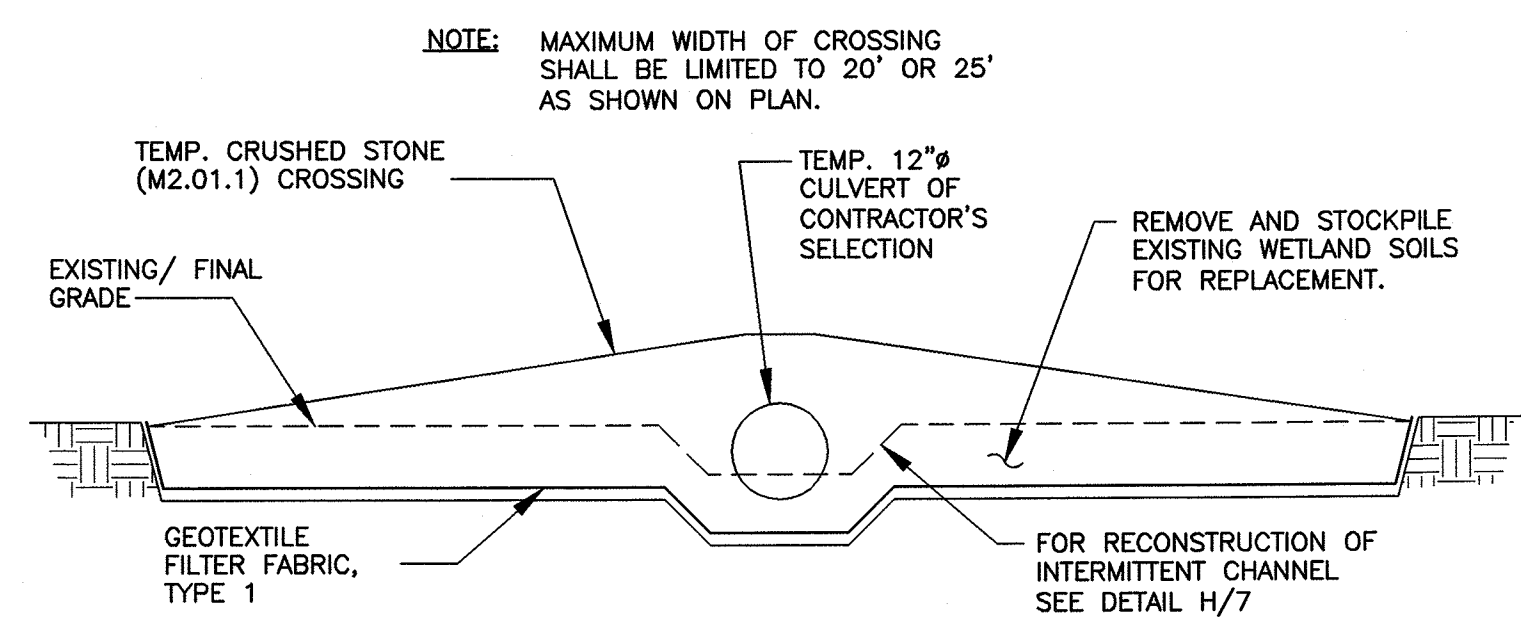


(G) 7 TEMPORARY CROSSING OF INTERMITTENT CHANNEL/ WETLAND AREA
NTS

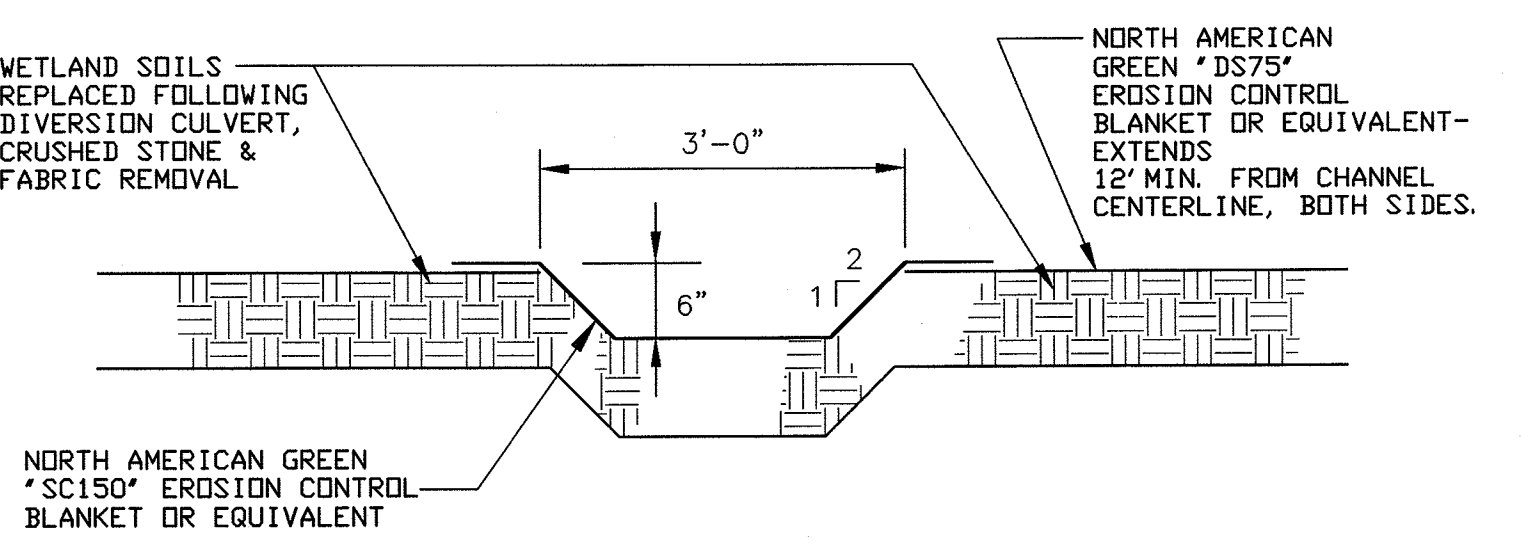


(H) 7 RECONSTRUCTION OF DISTURBED INTERMITTENT CHANNELS
NTS

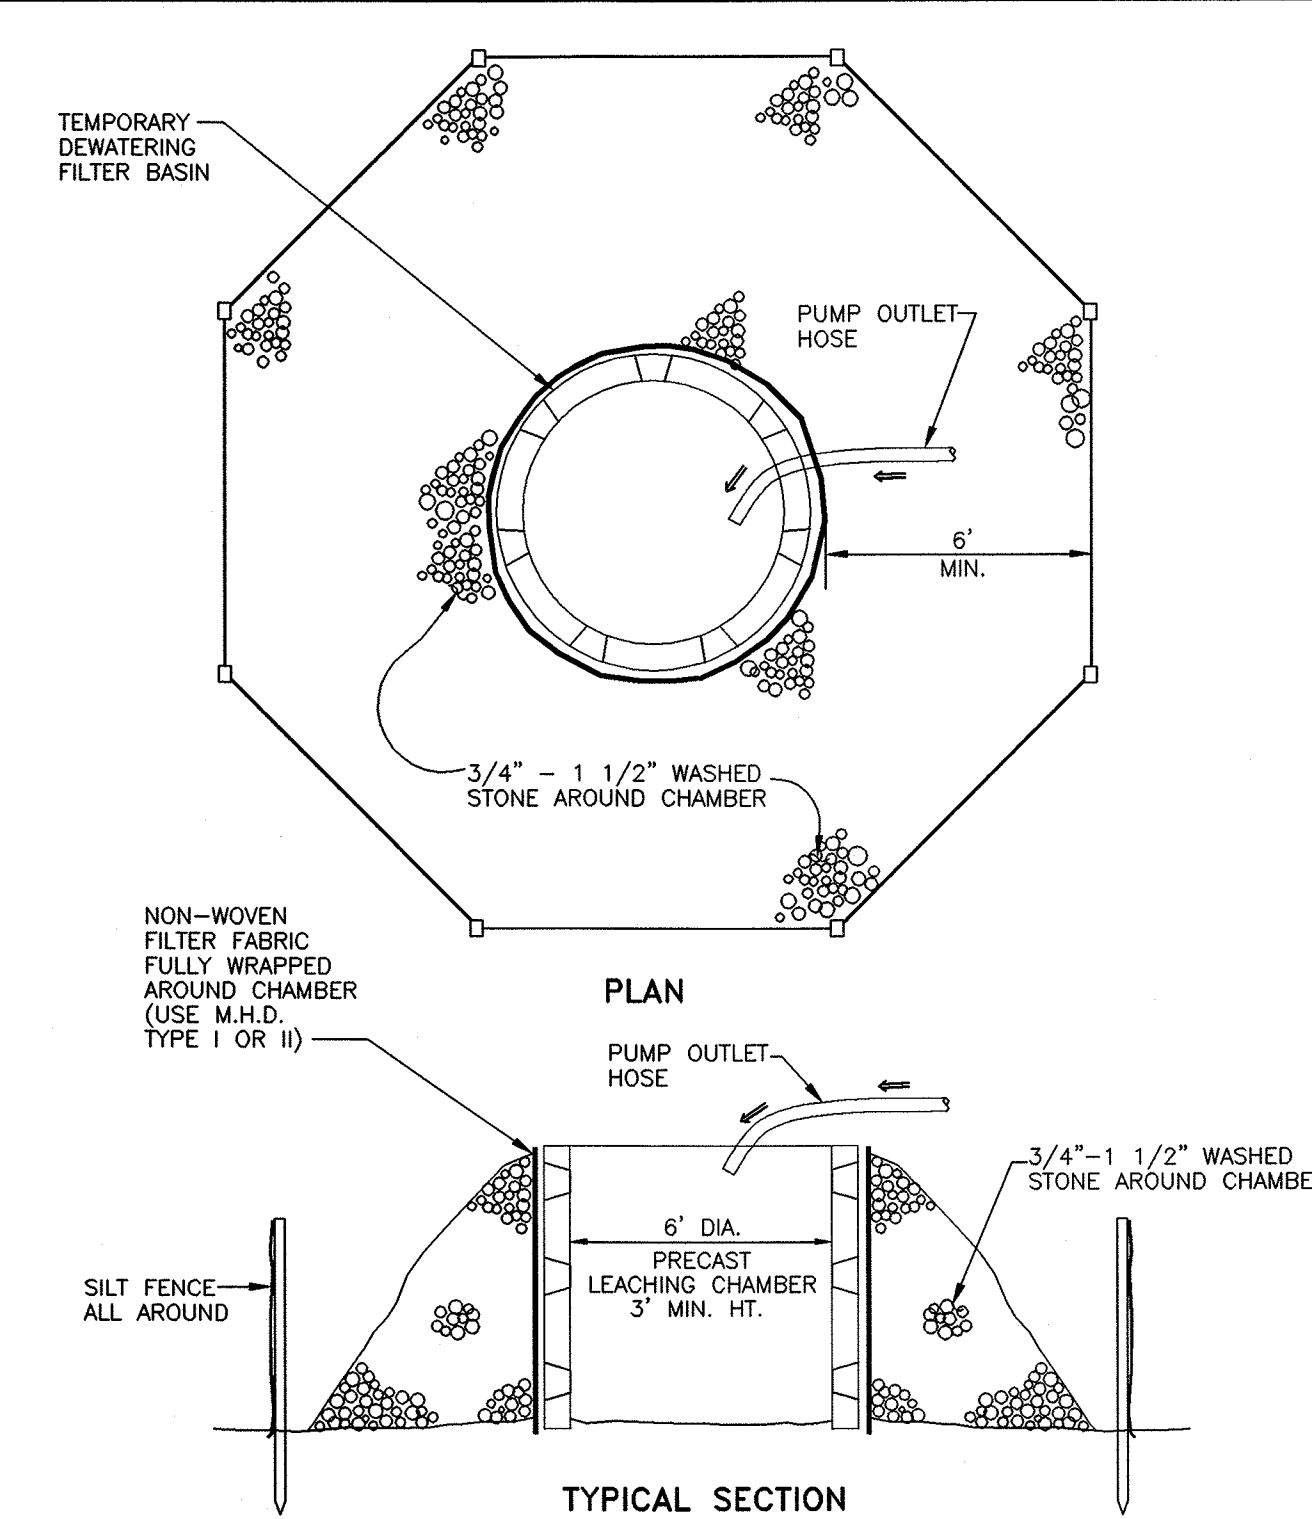

(C) 7 TEMPORARY DEWATERING FILTER BASIN
NTS

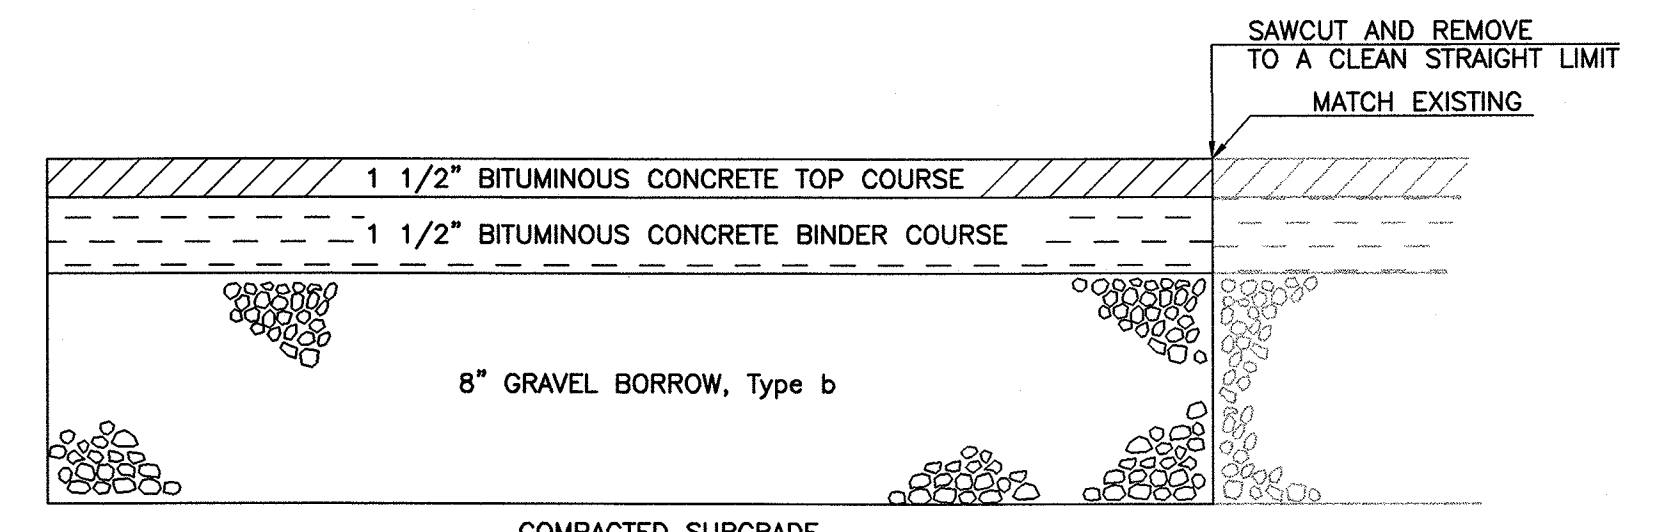

(J) 7 TYPICAL BIT. CONC. DRIVEWAY RECONSTRUCTION
NTS

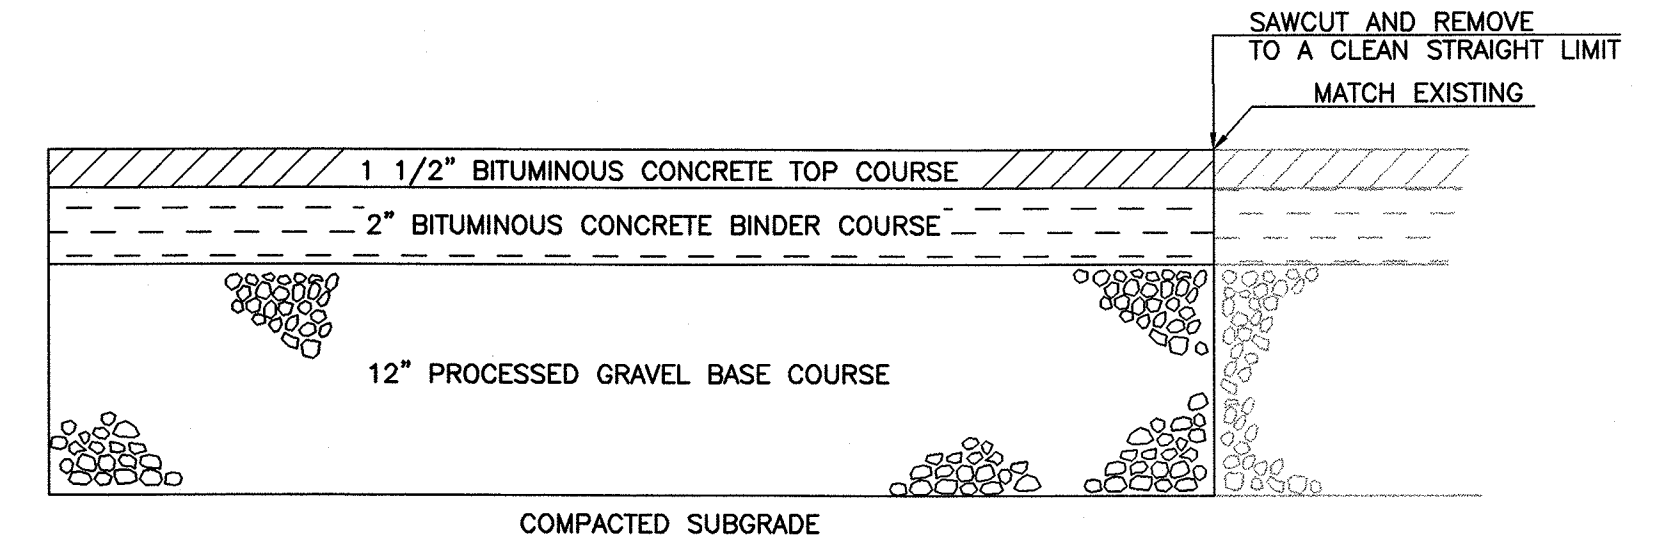


(K) 7 TYPICAL BIT. CONC. ROAD RECONSTRUCTION
NTS

APPROX. LIMITS OF ROAD RECONSTRUCTION

NOTE: CONTRACTOR SHALL RECORD EXIST. ELEVATIONS AT EACH STATION AND OFFSET LISTED BELOW FOR REFERENCE AND RE-ESTABLISHMENT DURING ROAD RECONSTRUCTION. POINTS REPRESENT FINISHED EDGE OF PAVING.

TAYLOR ST.	FARESE ROAD	FARESE RD. EXT.	O'BRIEN BROOK DIVERSION BASELINE		
5+66.8	14.3' Lt	8+17.0	14.3' Rt	0+86.0	5.5' Lt
5+85.8	14.9' Lt	8+17.6	8.8' Lt	0+93.1	9.0' Rt
6+00.0	5.6' Lt	8+18.0	10.2' Rt	1+37.1	5.9' Rt
6+05.1	14.4' Rt	8+21.7	7.3' Rt	1+43.9	8.8' Lt
6+13.0	15.3' Rt	8+22.1	7.6' Lt	1+44.6	9.2' Lt
6+19.4	15.0' Rt	8+25.0	6.4' Rt	1+71.4	3.8' Rt
6+25.0	6.4' Lt	8+50.0	8.0' Lt	2+50.5	3.9' Rt
6+50.0	7.1' Lt	8+50.0	4.6' Rt	3+36.4	2.3' Rt
6+51.7	13.9' Rt	8+75.0	7.2' Lt	3+91.8	2.9' Rt
6+60.3	7.4' Lt	8+75.0	4.2' Rt	4+44.8	4.4' Rt
6+64.2	9.5' Lt	9+00.0	6.4' Lt	4+80.5	2.5' Rt
6+65.7	10.7' Lt	9+00.0	4.3' Rt	4+86.1	6.2' Rt
6+75.0	10.2' Rt	9+25.0	7.1' Lt	4+87.8	9.8' Rt
6+81.9	10.2' Rt	9+25.0	3.9' Rt	4+94.9	10.0' Lt
6+82.7	13.0' Rt	9+35.4	7.7' Lt	5+06.8	9.5' Rt
6+83.0	10.5' Lt	9+46.5	9.3' Lt	5+25.4	11.0' Lt
6+84.2	8.3' Lt	9+50.0	12.2' Lt	5+27.7	5.6' Lt
6+86.6	7.8' Lt	9+50.0	5.0' Rt		
7+00.0	7.5' Lt	9+75.0	6.2' Rt		
7+11.3	12.7' Rt	9+92.8	12.5' Lt		
7+14.4	9.0' Rt	9+95.2	8.2' Lt	-0+27.7	454.8' Lt
7+25.0	7.2' Lt	10+00.0	10.0' Rt	5+40.4	108.4' Lt
7+25.0	8.8' Rt	10+25.0	11.9' Rt	5+83.3	4.5' Lt
7+50.0	7.3' Lt	10+28.1	8.5' Lt	6+03.1	15.3' Lt
7+50.0	8.7' Rt	10+44.0	10.0' Rt		
7+89.2	8.4' Rt	10+51.5	6.2' Rt		
7+89.3	7.6' Lt	10+51.8	9.1' Rt		
		10+67.2	10.9' Lt		

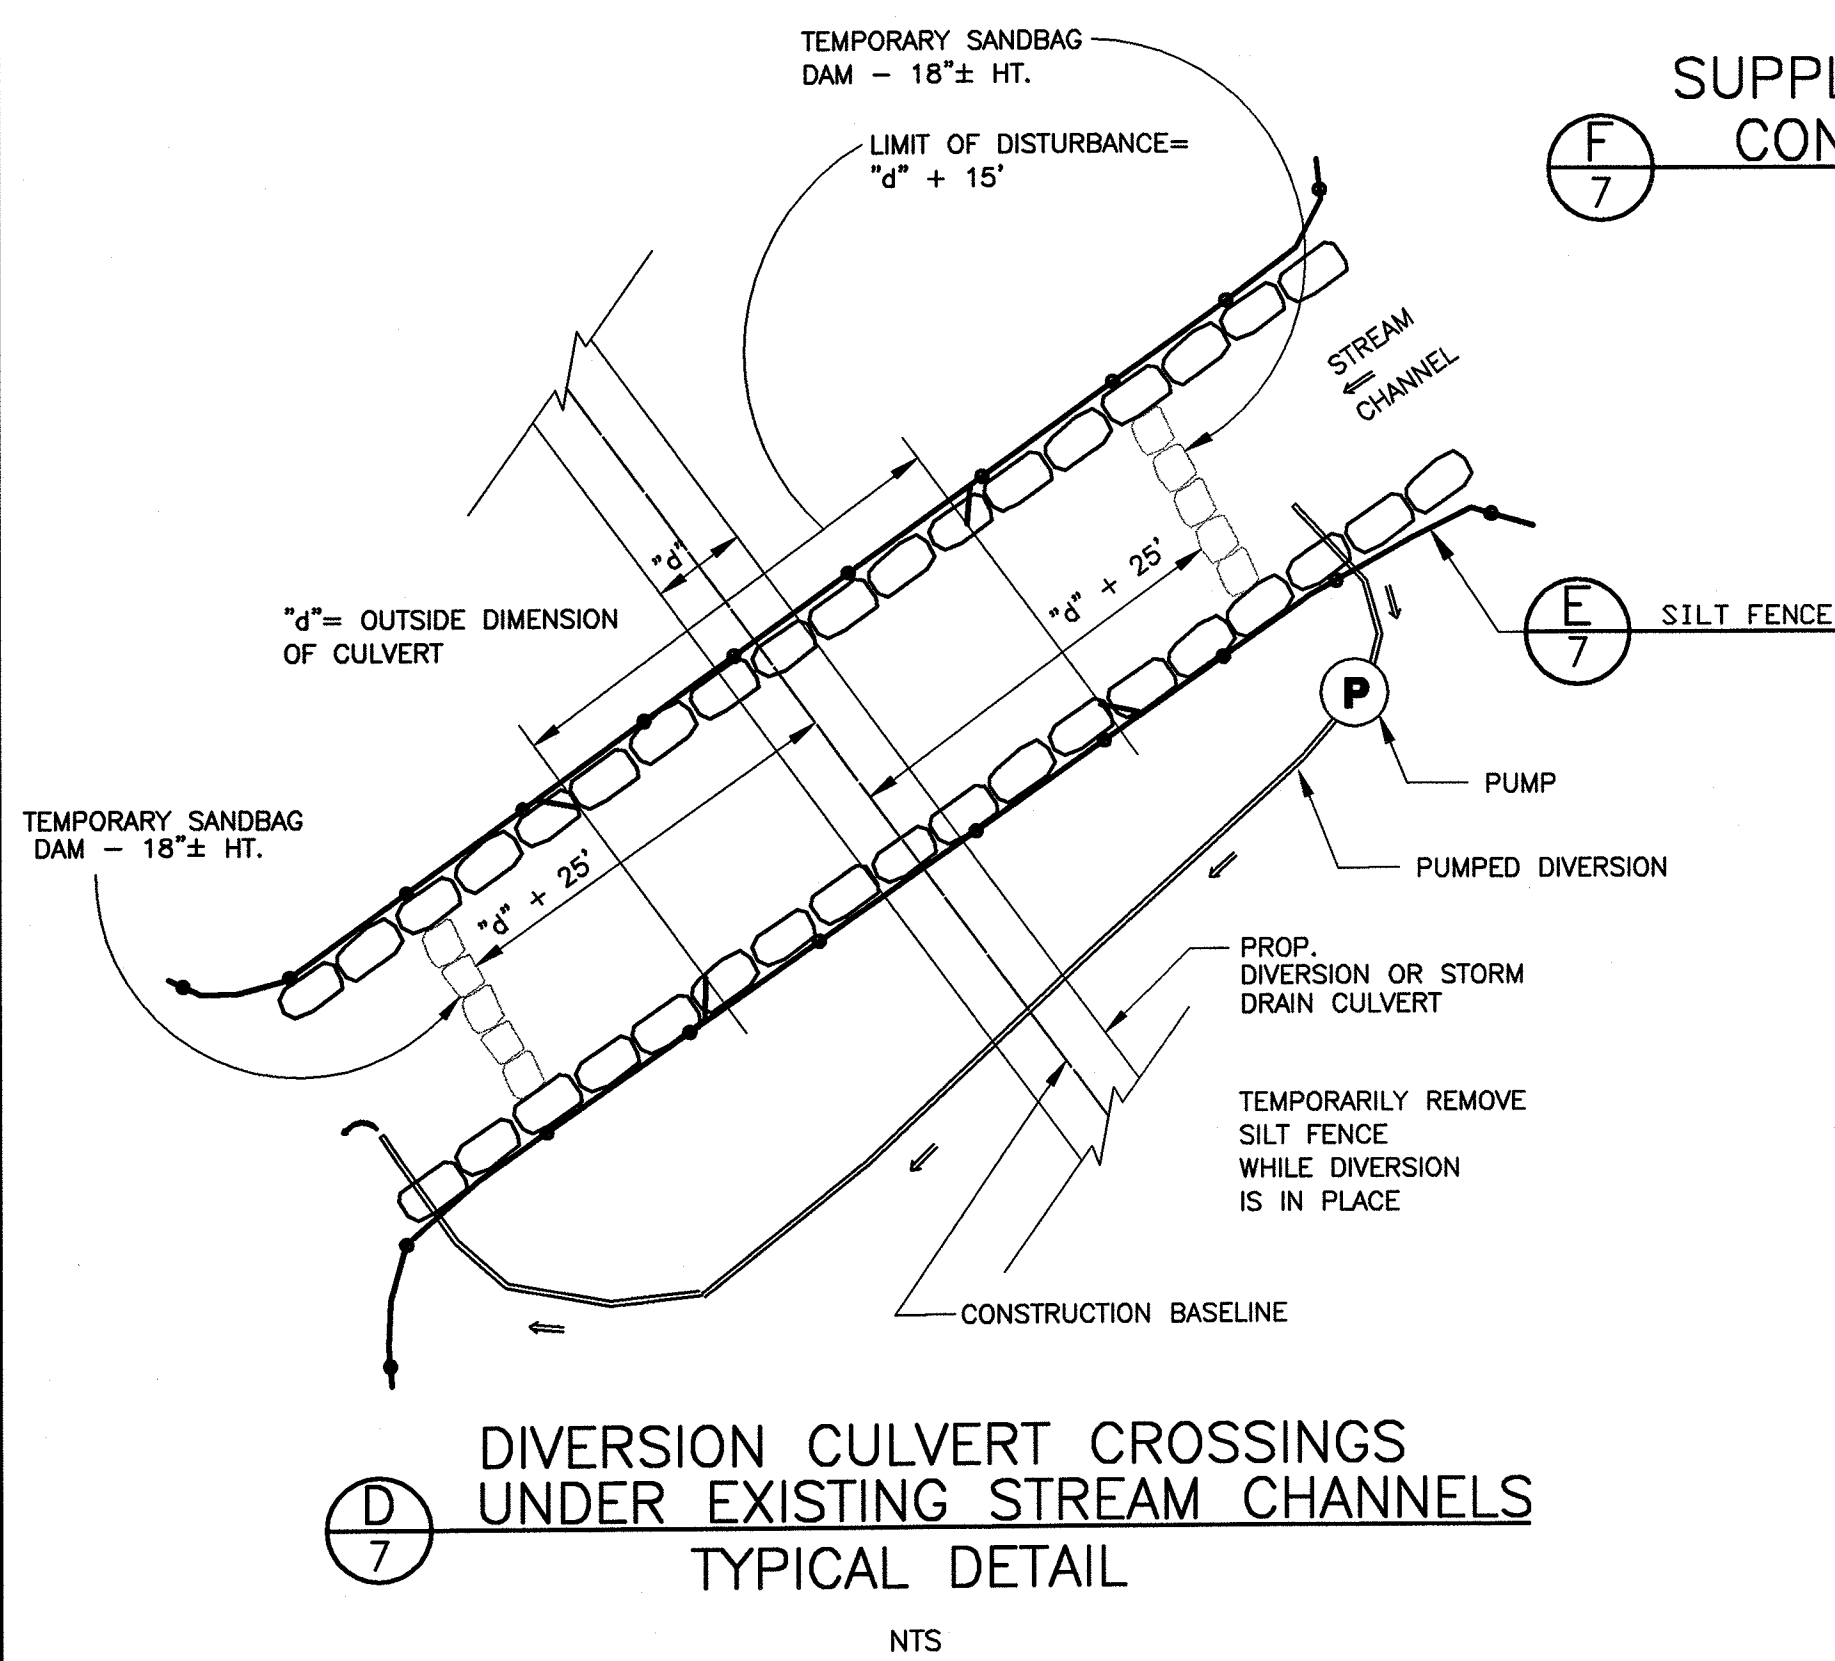

(D) 7 DIVERSION CULVERT CROSSINGS UNDER EXISTING STREAM CHANNELS
TYPICAL DETAIL
NTS

NOTES FOR TEMPORARY DIVERSIONS:

- EROSION CONTROL BARRIERS SHALL BE IN PLACE PRIOR TO ANY OTHER WORK TAKING PLACE.
- HAVE PUMP IN PLACE PRIOR TO PLACING TEMPORARY SANDBAG DAMS.
- PUMPS SHALL BE CAPABLE OF DISCHARGING 1,500 GPM (3.3±CFS) UNDER THE INSTALLED CONDITIONS. PRIOR TO INSTALLING THE DIVERSION, A STANDBY PUMP OF EQUAL OR GREATER CAPACITY SHALL BE ON SITE FOR SUBSTITUTION IN CASE OF MALFUNCTION OR FOR DUPLEX USE IN CASE OF HIGH FLOWS IN THE STREAM CHANNEL.
- ONCE STARTED, THE PUMPED DIVERSION SHALL REMAIN IN PLACE UNTIL THE WORK IS COMPLETE. PUMPS SHALL BE ATTENDED 24-HOURS PER DAY DURING THE PERIOD OF PUMPED DIVERSION.
- ACTUAL DISTURBANCE TO THE STREAM CHANNEL SHALL BE LIMITED TO FIFTEEN FEET (15') GREATER THAN THE OUTSIDE DIMENSION OF THE CULVERT BEING INSTALLED.
- FOLLOWING INSTALLATION OF THE CULVERT AND PROPER BACKFILL, THE CHANNEL WALLS AND FLOOR SHALL BE RECONSTRUCTED IN KIND TO THE SATISFACTION OF THE ENGINEER.
- PRIOR TO REMOVING THE DIVERSION, THE STREAM CHANNEL IN THE WORK AREA SHALL BE THOROUGHLY CLEANED, WITH ALL DEBRIS AND EXTRANEOUS MATERIAL REMOVED.
- REMOVE ALL TEMPORARY SANDBAGGING AT THE COMPLETION OF THE PUMPED DIVERSION.

7 of 35 SHEETS


BAYSTATE ENVIRONMENTAL CONSULTANTS INC.
Scientists
Surveyors
Engineers
296 North Main Street
East Longmeadow, MA 01028

DEC


PROJECT NO. 94-1215
SCALE AS NOTED
DATE APRIL 1999
DRAWN BY SMR
CHECKED BY TEJ

Construction Details No. 1
Godfrey Brook Flood Mitigation Project
Milford, Massachusetts

NO.	DATE	BY	REVISION
2	10/10/01	EDM	ISSUED AS RECORD PRINT
1	8/12/99	TEJ	ISSUED FOR BIDDING

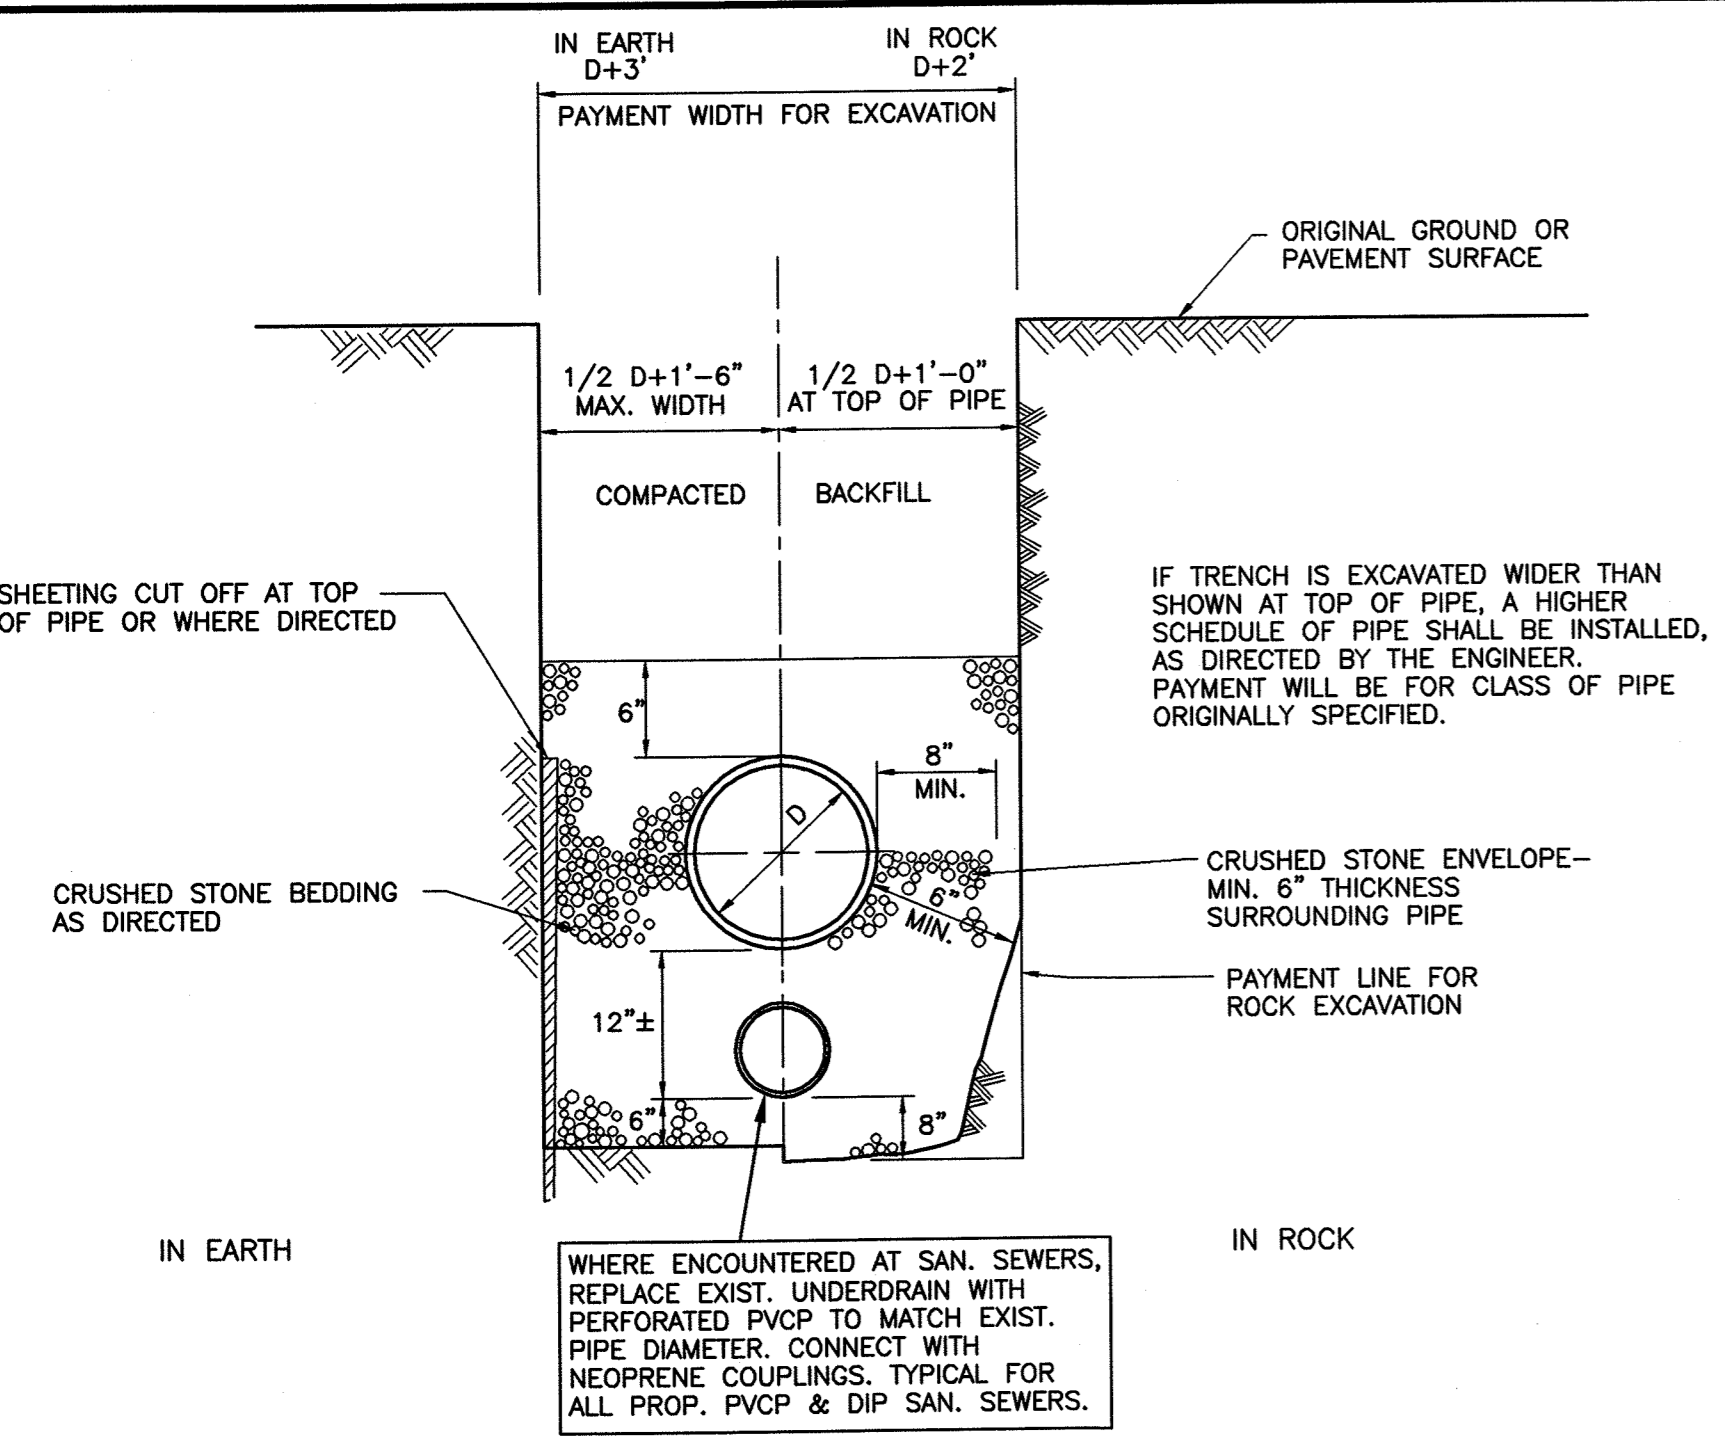


(A) TYPICAL TRENCH DETAIL - PVC PIPE
NTS

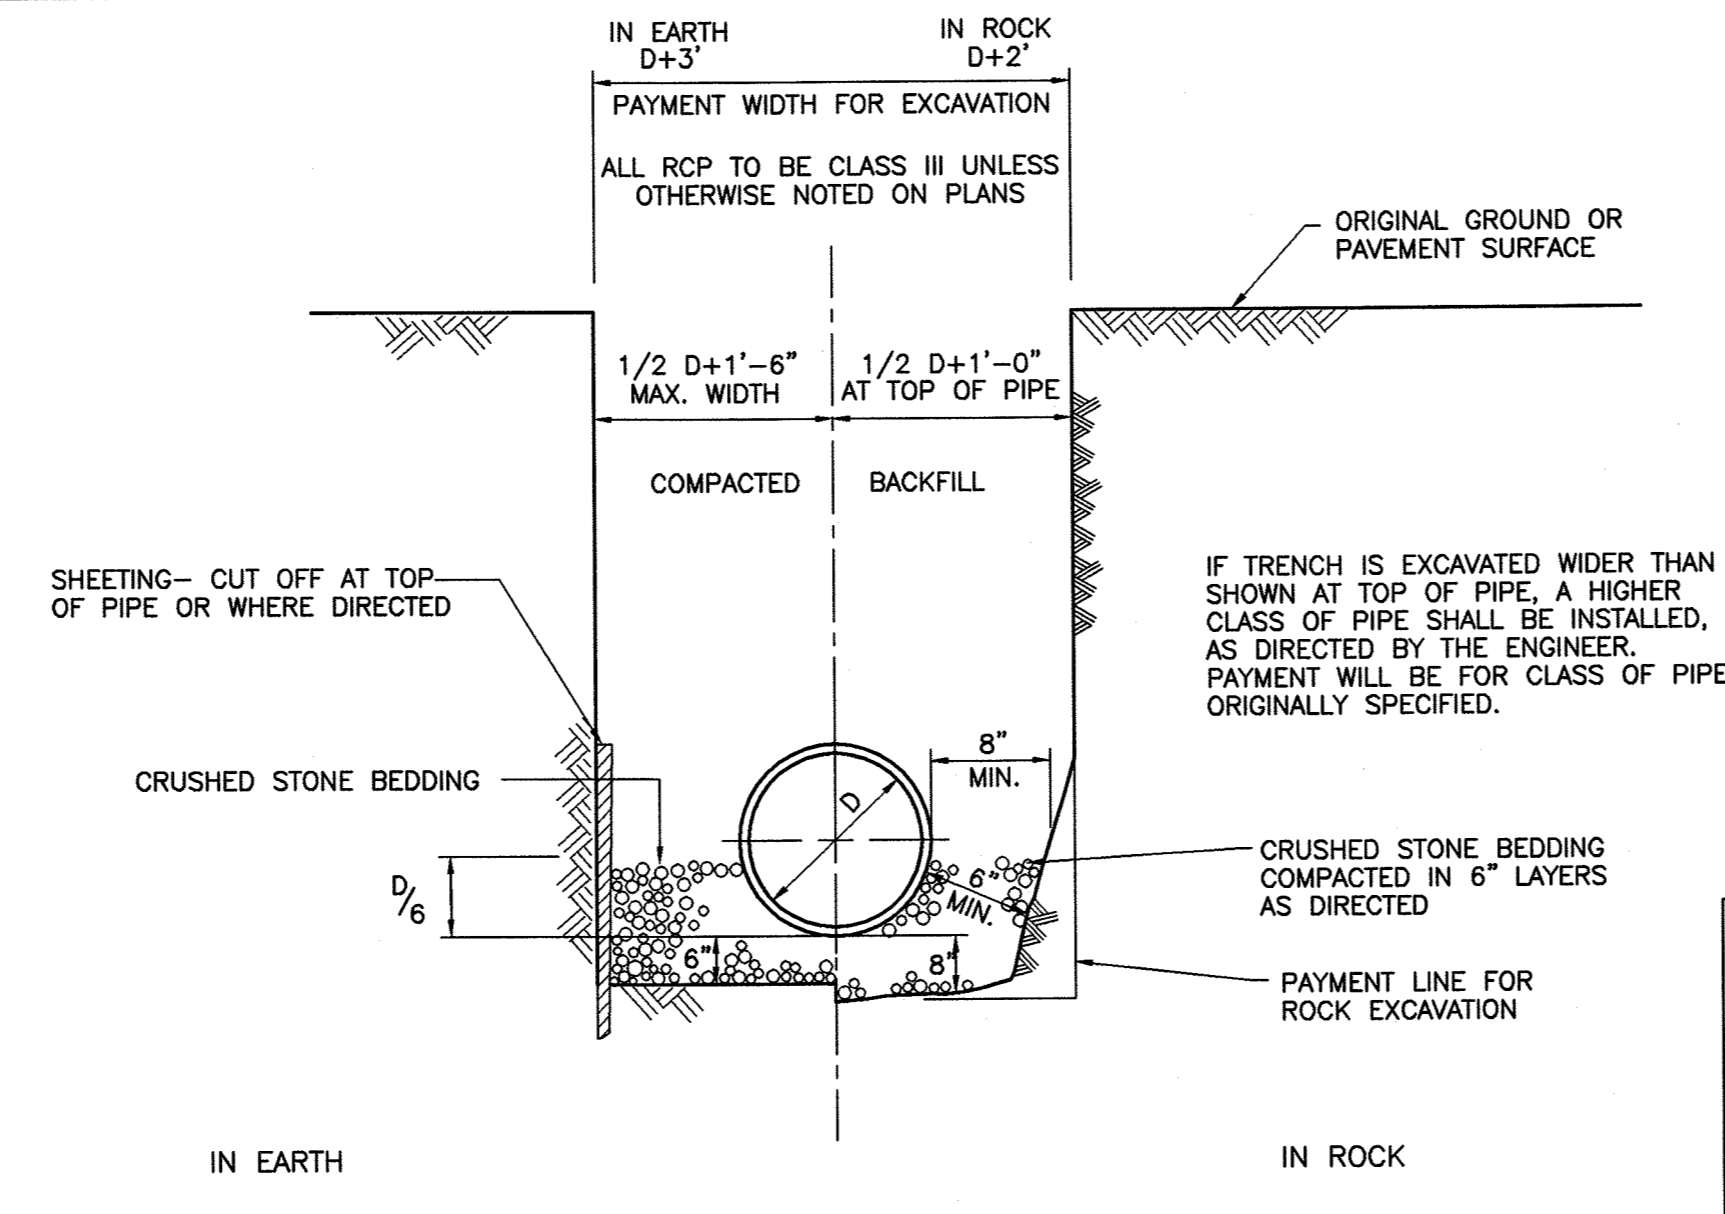

(B) TYPICAL TRENCH DETAIL
- REINFORCED CONCRETE PIPE
- DUCTILE IRON PIPE
NTS

BACKFILL TO SUBGRADE:
OUTSIDE OF PAVED AREAS:
BACKFILL SHALL CONSIST OF SUITABLE EXCAVATED MATERIAL OR, WHERE SPECIFICALLY REQUIRED BY THE ENGINEER, "ORDINARY BORROW"
WITHIN PAVED AREAS:
BACKFILL SHALL CONSIST OF "ORDINARY BORROW"

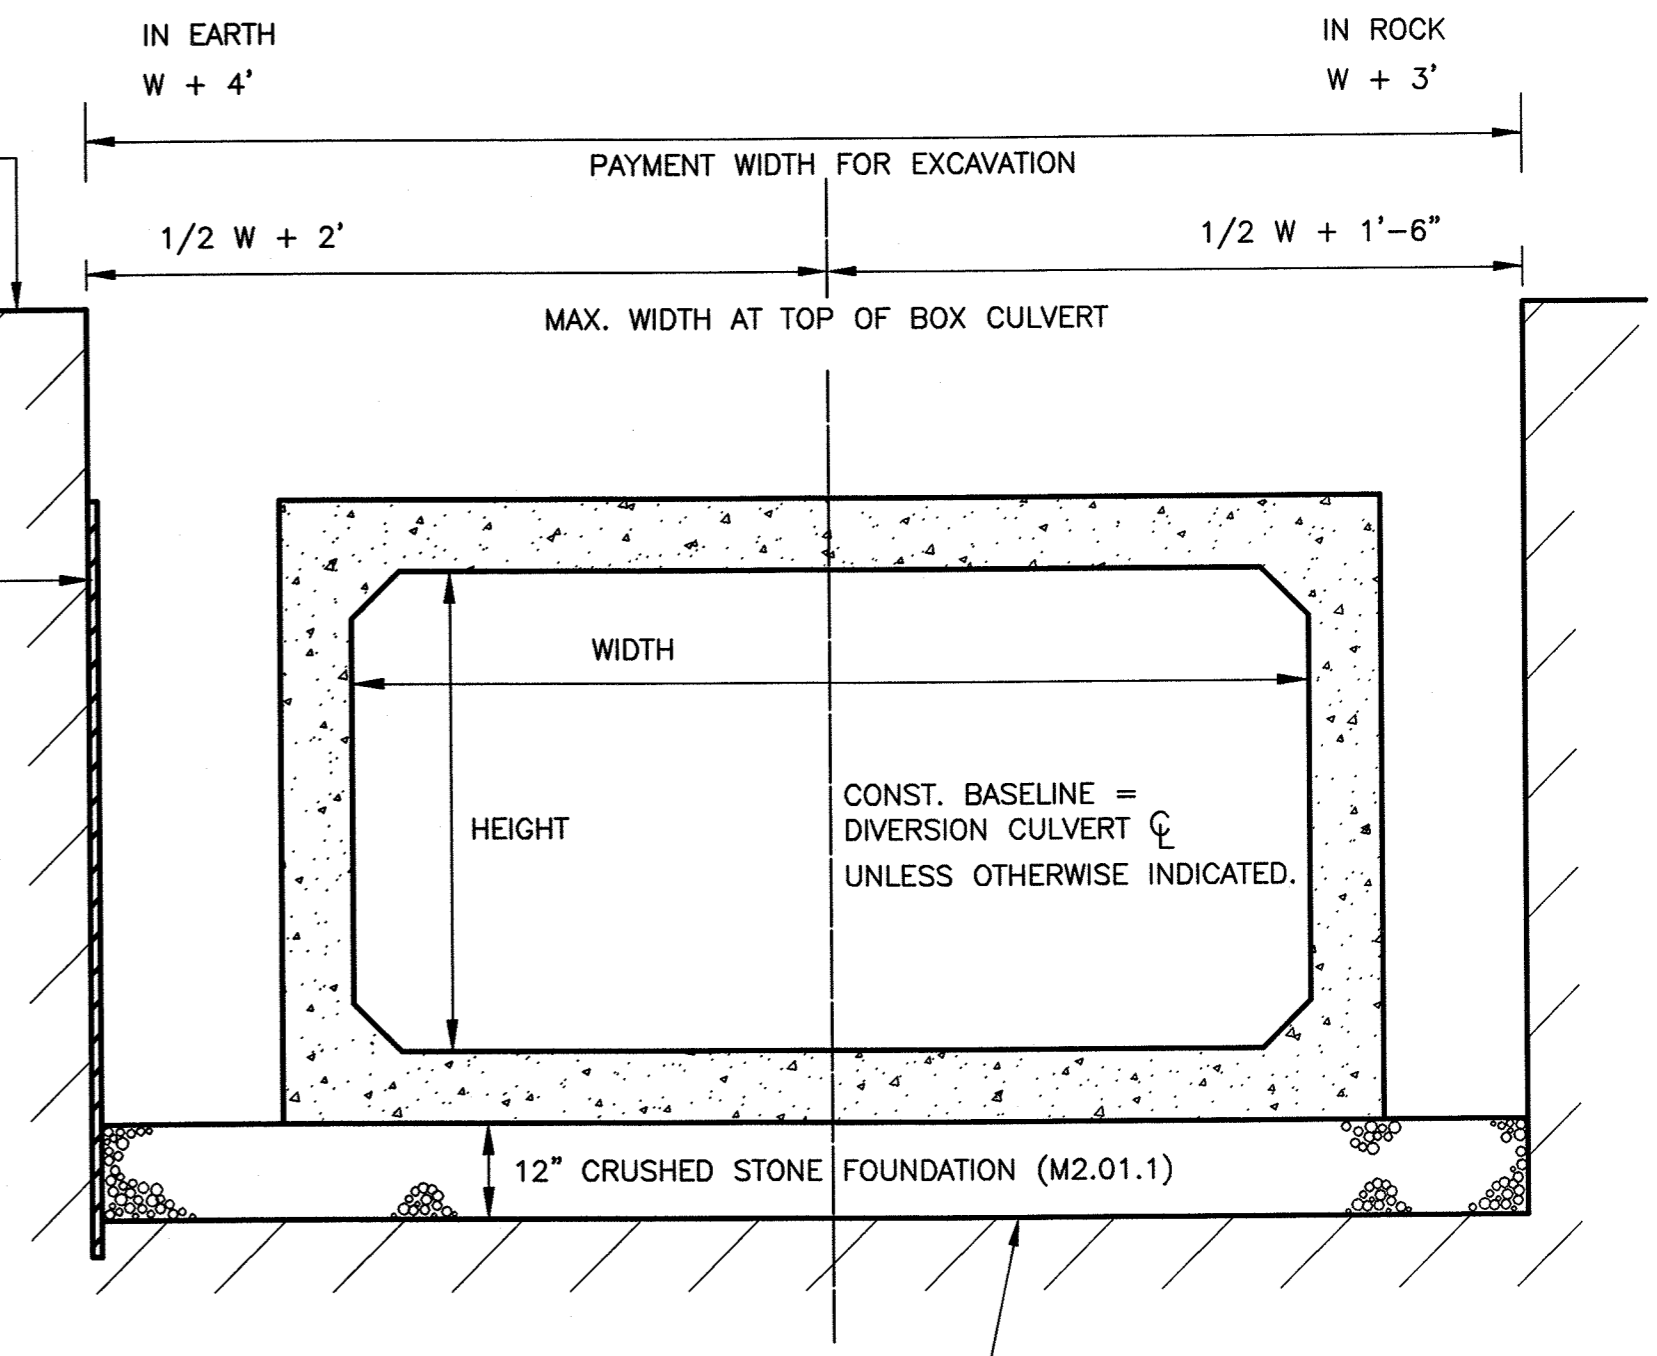

(C) TYPICAL TRENCH DETAIL
PRECAST BOX CULVERT
NTS


PRECAST BOX CULVERT DESIGN NOTES

CONCRETE MINIMUM STRENGTH = 5000 PSI @ 28 DAYS
STEEL REINFORCEMENT - ASTM A615, GRADE 60
WHEEL LOADING - AASHTO HS25-40
COVER TO STEEL - 1.5 INCHES
EARTH COVER - 0'-0" MINIMUM, 13'-6" MAXIMUM
UNIT WEIGHT OF EARTH - 125 POUNDS PER CUBIC FOOT
ACTIVE PRESSURE COEFFICIENT - 0.25 MIN., 0.5 MAX.
2'-0" LIVE LOAD SURCHARGE APPLIED TO 13'-6" DEPTH
EXTERIOR GROUND WATER AT FINISHED GRADE
DESIGN SHALL BE IN ACCORDANCE WITH AASHTO SPECIFICATIONS FOR HIGHWAY BRIDGES, ACI 318-83, AND LOAD FACTOR DESIGN (AASHTO)


LOAD FACTORS
DEAD LOAD 1.5
LIVE LOAD 2.17
HYDROSTATIC PRESSURE 1.4
EARTH PRESSURE, HORIZ. 1.7

CAPACITY REDUCTION FACTORS
SHEAR 0.85
MOMENT 0.90


WEEP HOLES IN BOX CULVERT SECTIONS - EACH PRECAST SECTION SHALL CONTAIN A MINIMUM OF TWO (2) 4" WEEP HOLES.

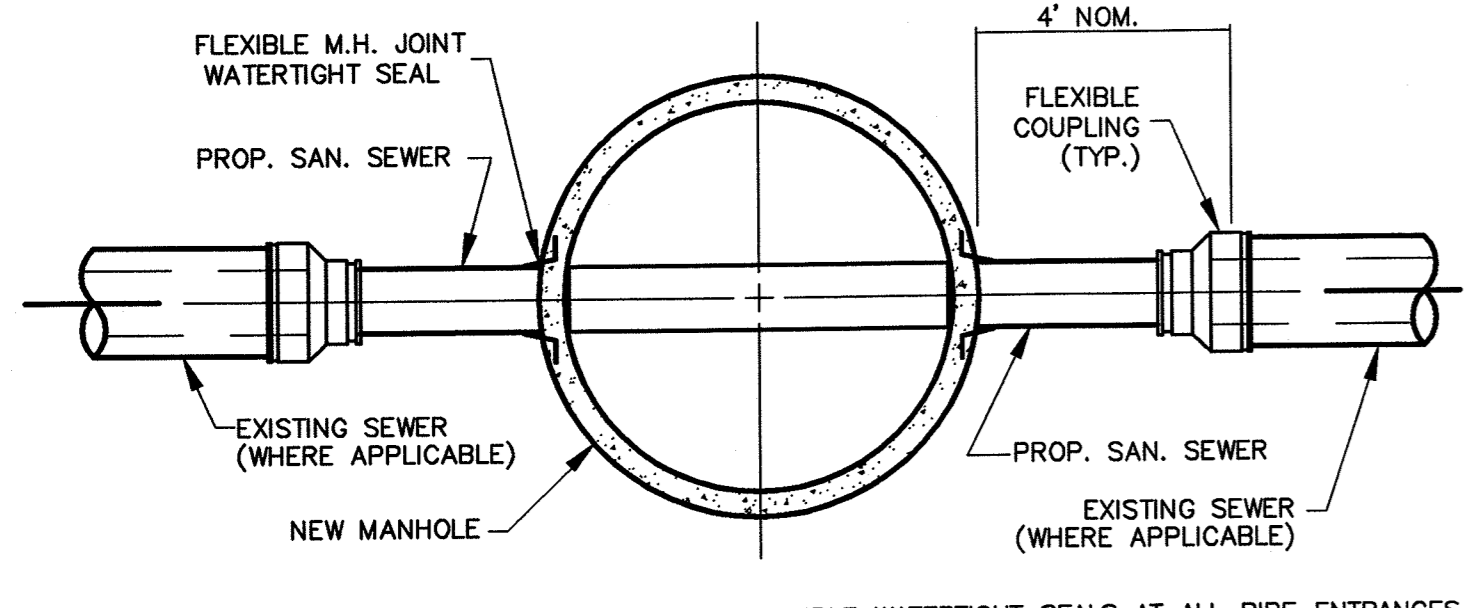


(D) CONNECTION OF SANITARY SEWERS TO NEW MANHOLES
NTS

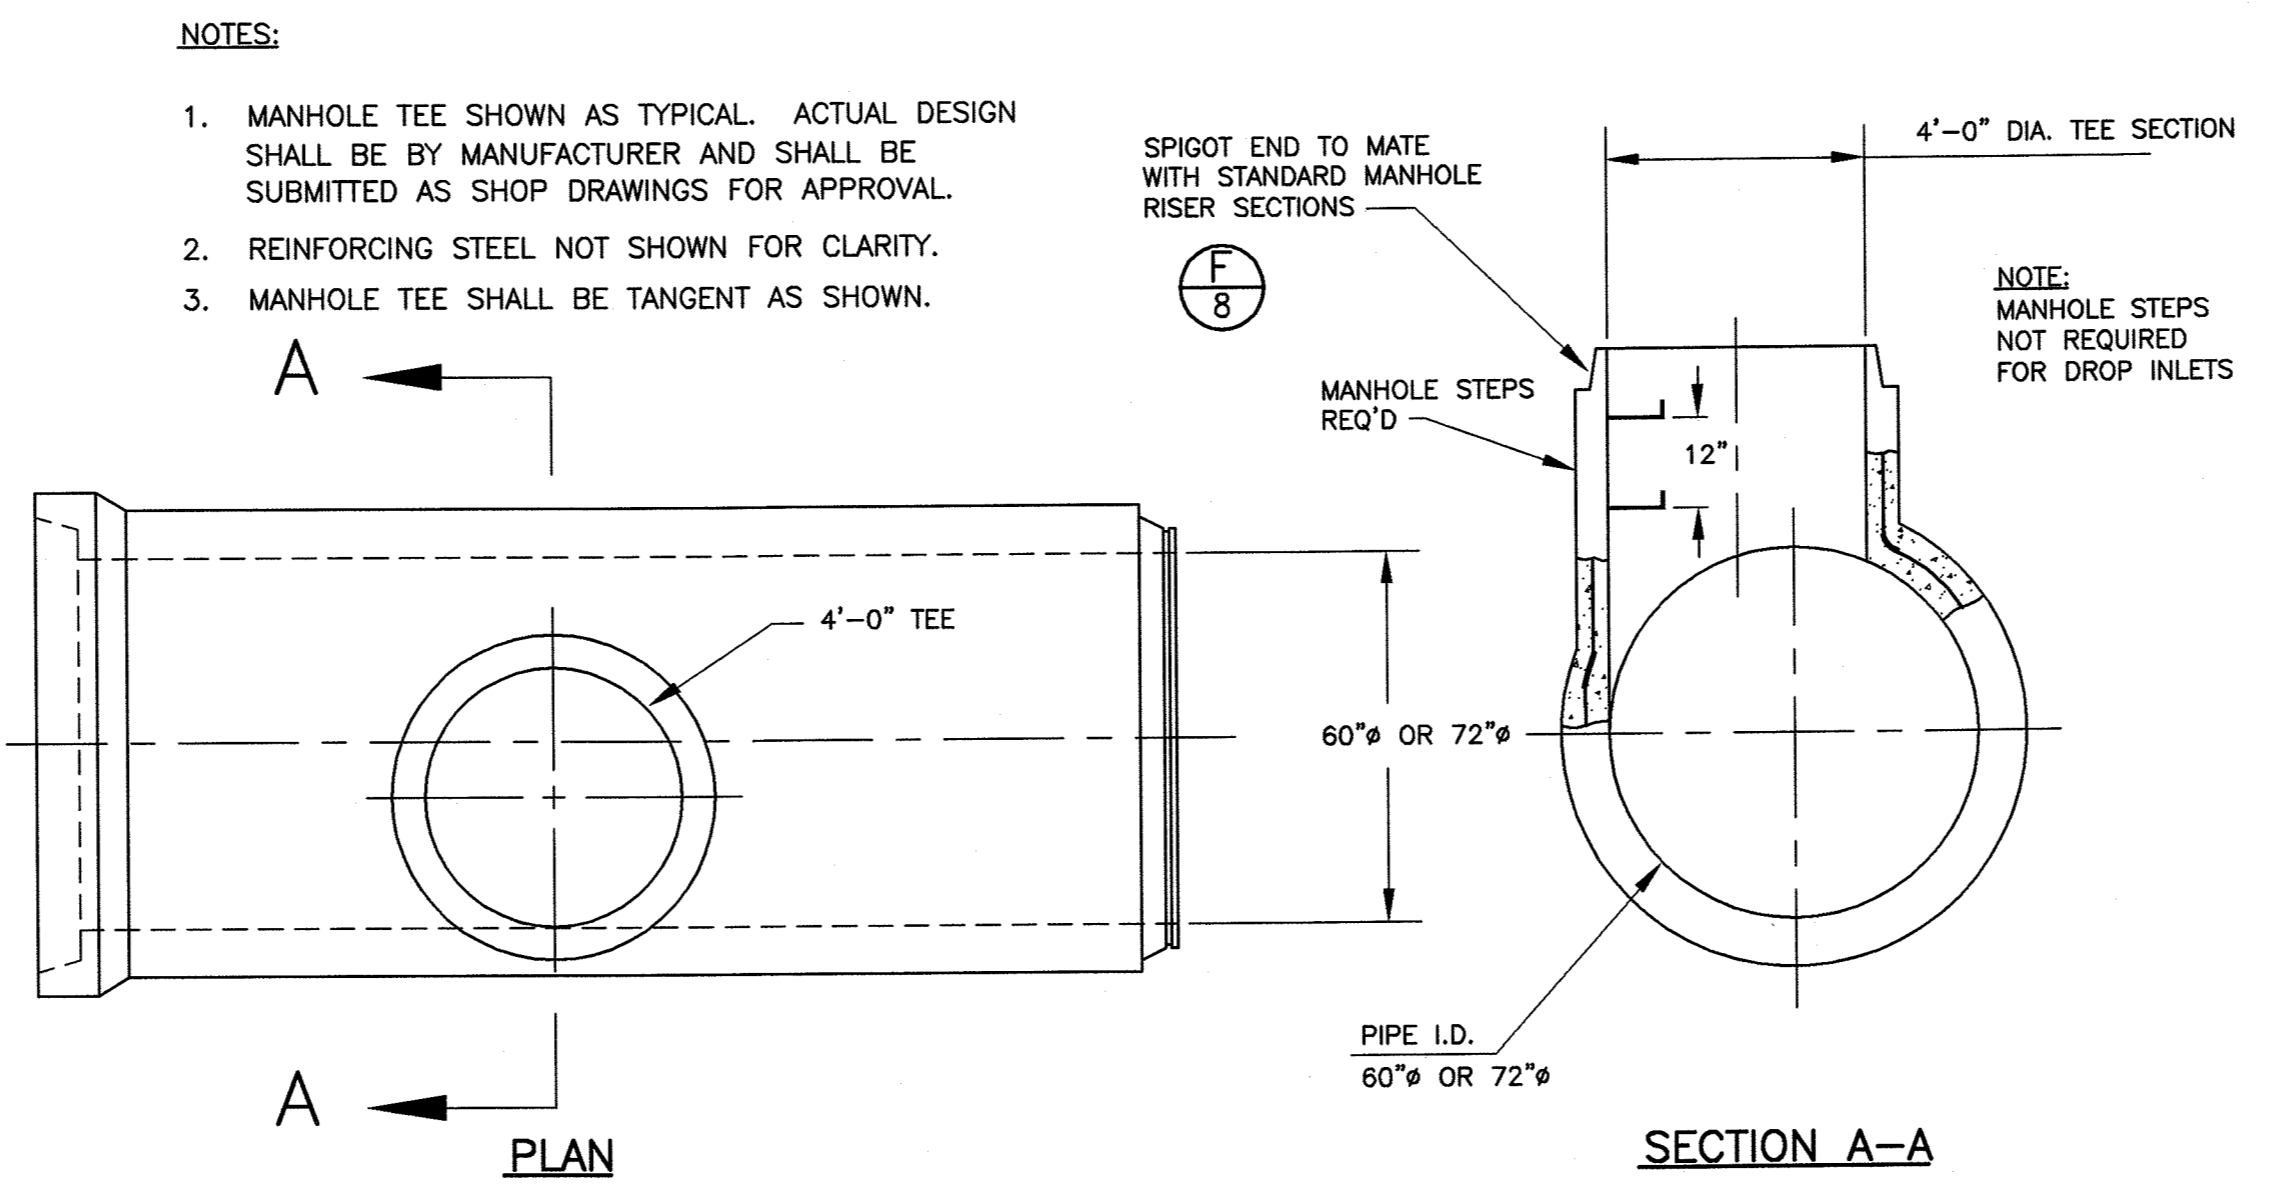


(E) MANUFACTURED ECCENTRIC MANHOLE TEE
NTS

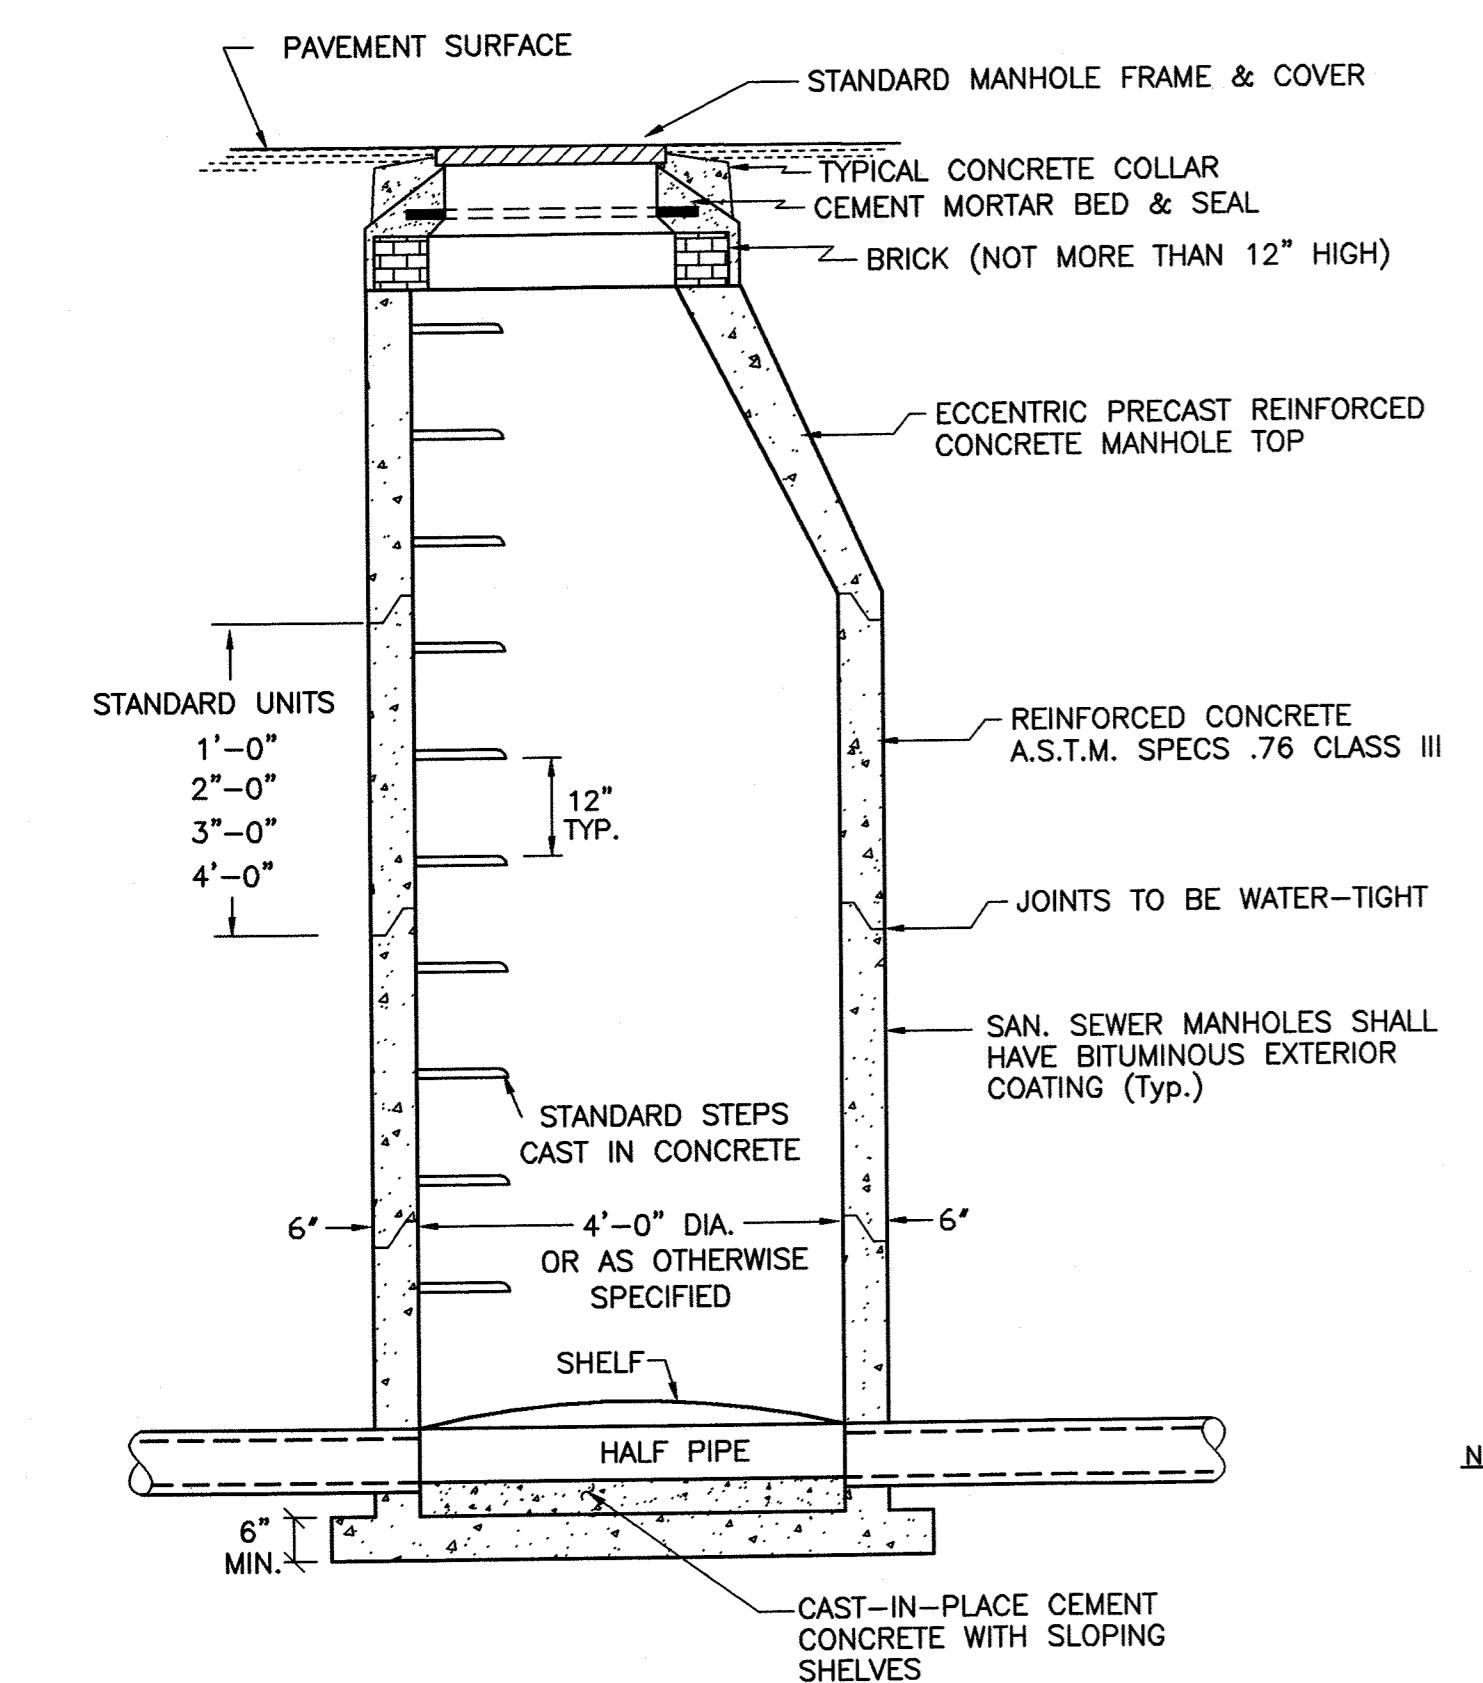


(F) PRECAST MANHOLE - TYPICAL DETAIL
NTS

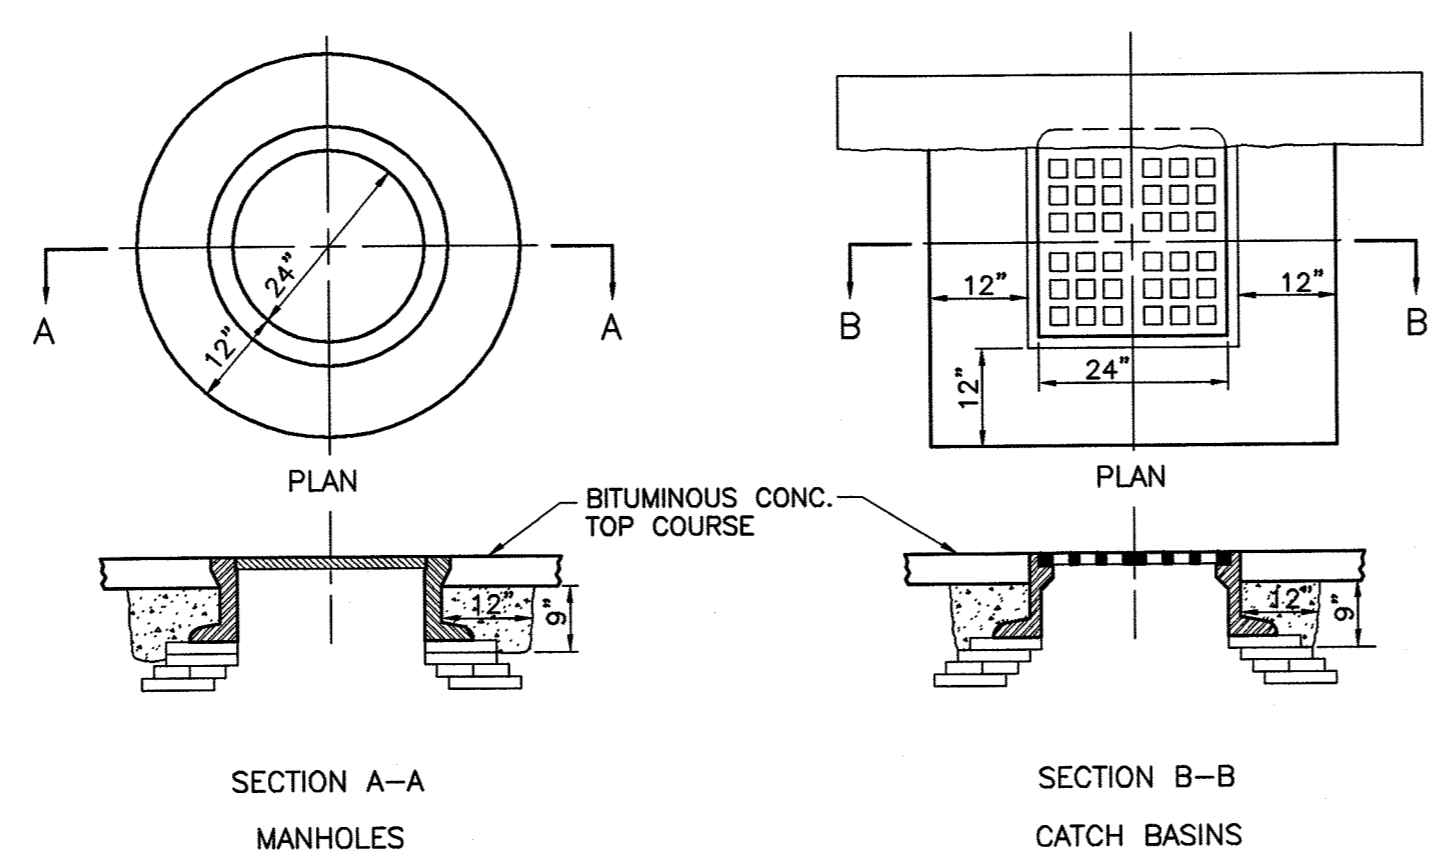

(G) CONCRETE COLLARS
NTS

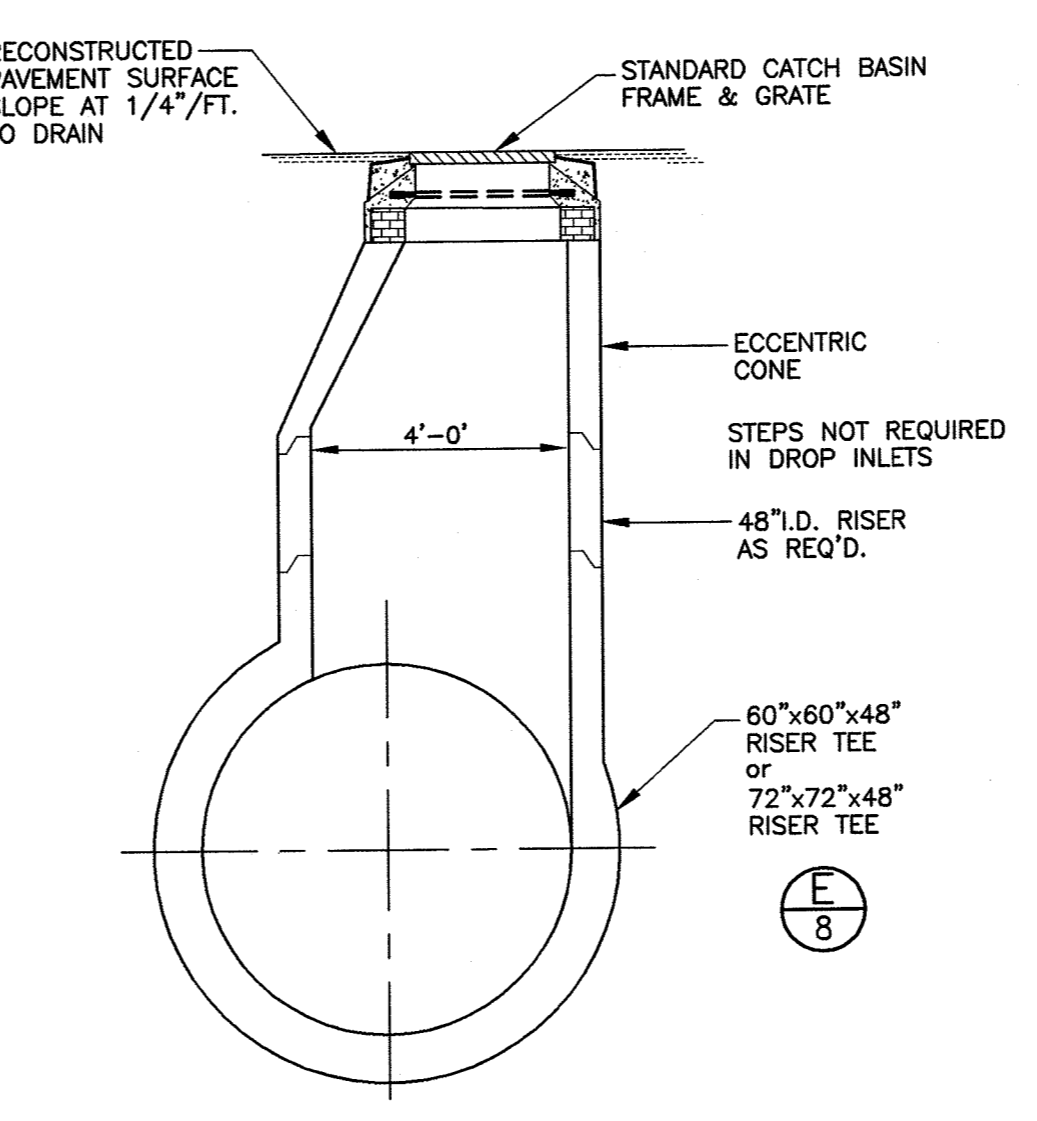

(H) DROP INLET
NTS

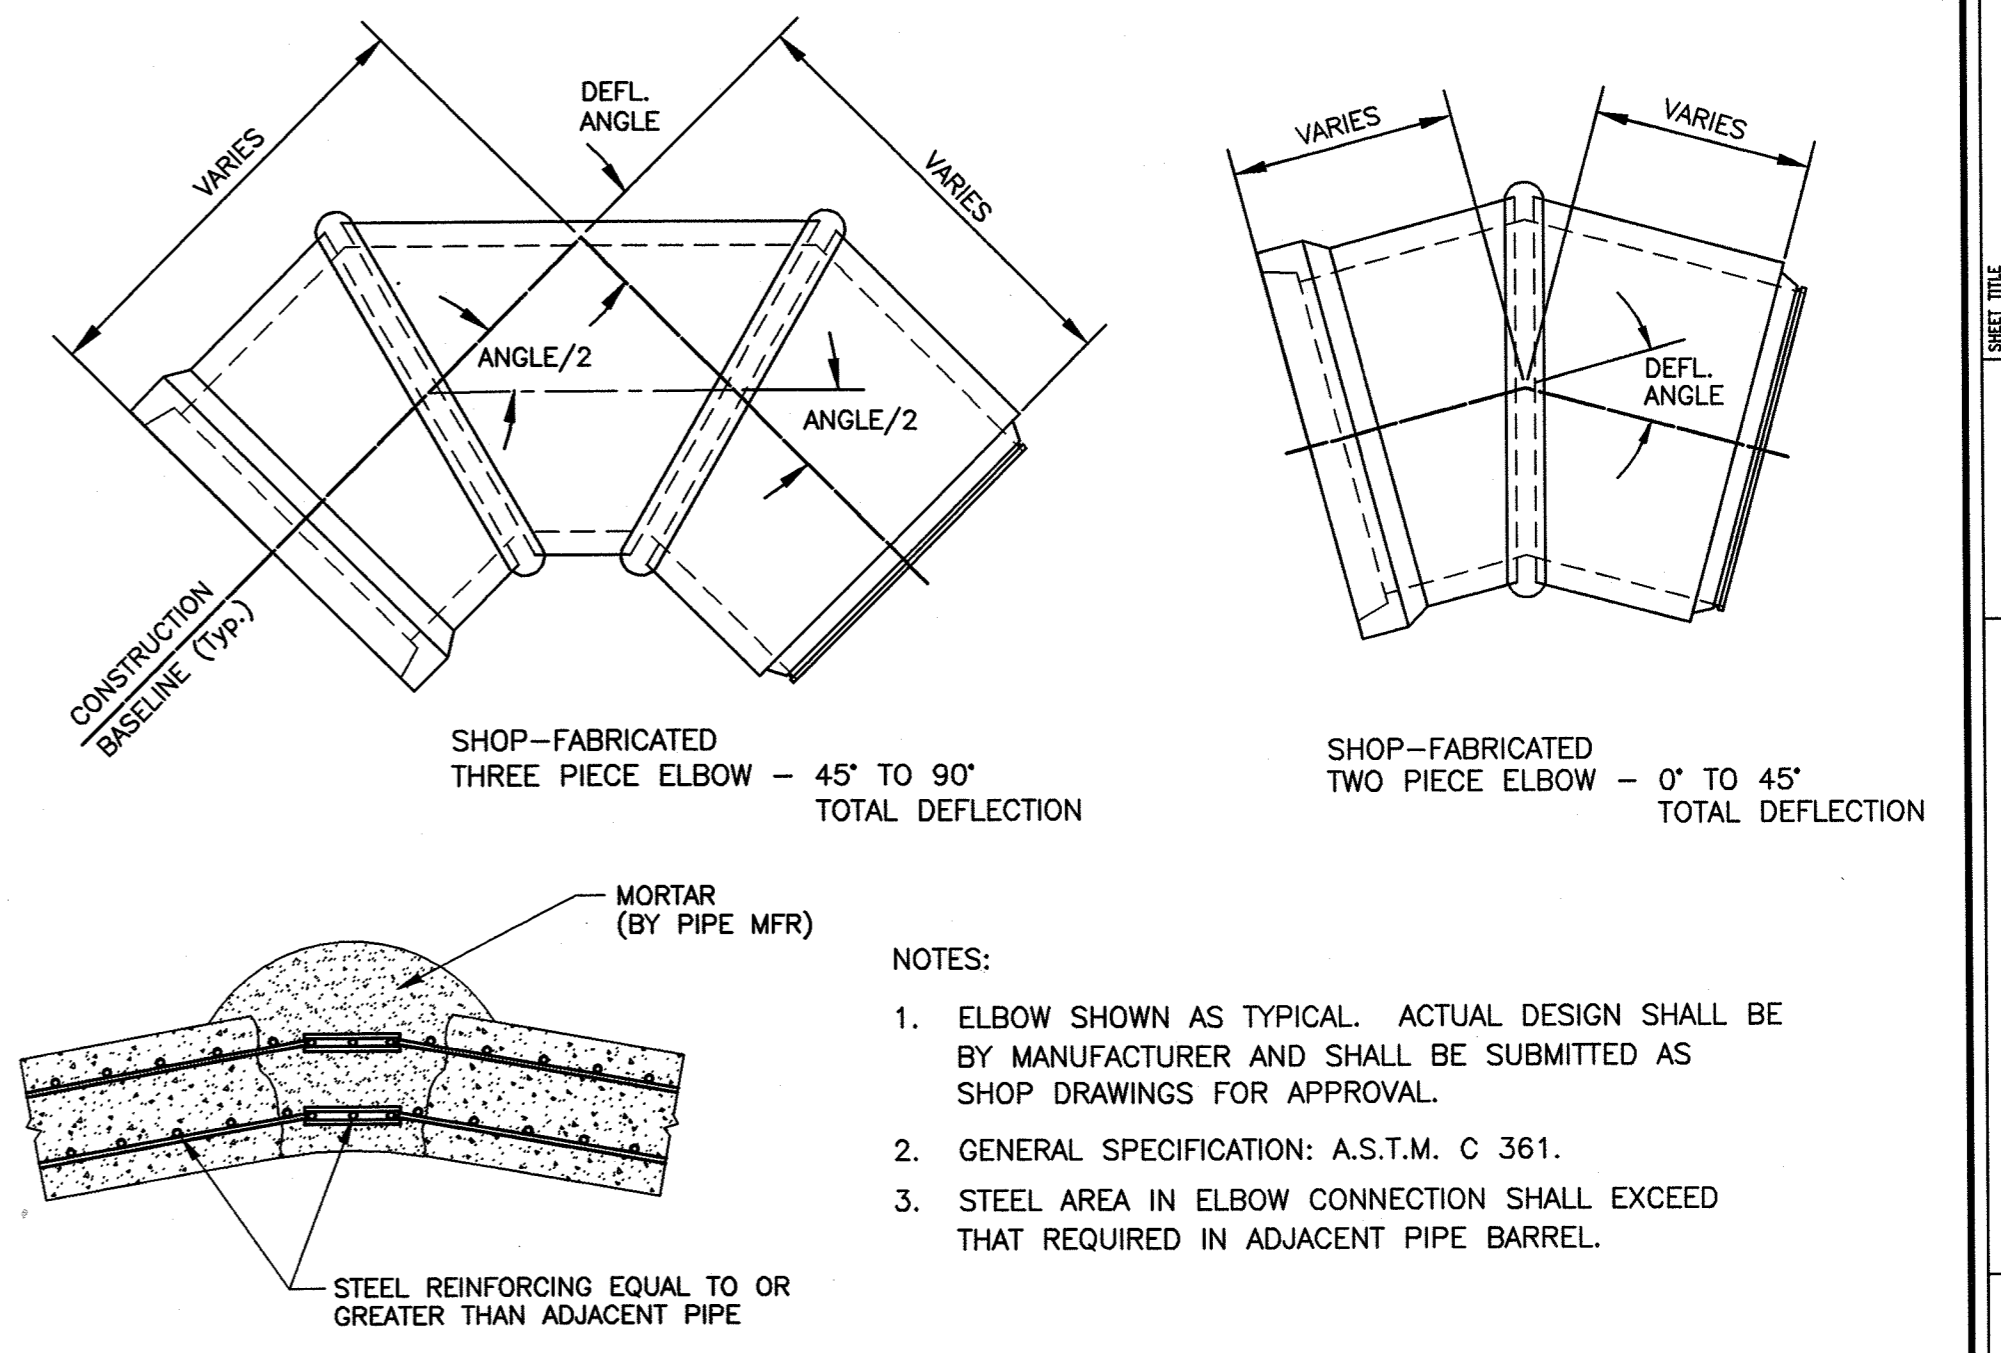


(J) TWO AND THREE PIECE ELBOW
60" & 72" REINFORCED CONCRETE PIPE
NTS

- NOTES:
1. MANHOLE TEE SHOWN AS TYPICAL. ACTUAL DESIGN SHALL BE BY MANUFACTURER AND SHALL BE SUBMITTED AS SHOP DRAWINGS FOR APPROVAL.
 2. REINFORCING STEEL NOT SHOWN FOR CLARITY.
 3. MANHOLE TEE SHALL BE TANGENT AS SHOWN.


AutoCAD File: P:\AUTOCAD\KADWIN\B4215\RECORD DRAWINGS\Sheet 7 8 9.dwg Plotted at: Tue Oct 02 08:44:03 2001 REC, Inc.

PROJECT NO. 94-1215		SCALE AS NOTED		DATE APRIL 1999		DRAWN BY SMR		CHECKED BY TEJ	
BAYSTATE ENVIRONMENTAL CONSULTANTS INC. Surveyors East Longmeadow, MA 01028 Scientists 286 North Main Street Milford, Massachusetts									
Construction Details No. 2					Godfrey Brook Flood Mitigation Project Milford, Massachusetts				
ISSUED AS RECORD PRINT									
ISSUED FOR BIDDING									
NO. DATE									
1 8/12/99									
2 10/01									
BY									
TEJ									
BY									
TEJ									
BY									
TEJ									


AutoCAD File: P:\AUTOCAD\ACAD\DRAWINGS\RECORD DRAWINGS\Sheet 7 B 9.dwg Plotted at: Tue Oct 02 08:45:25 2001
BEC, Inc.

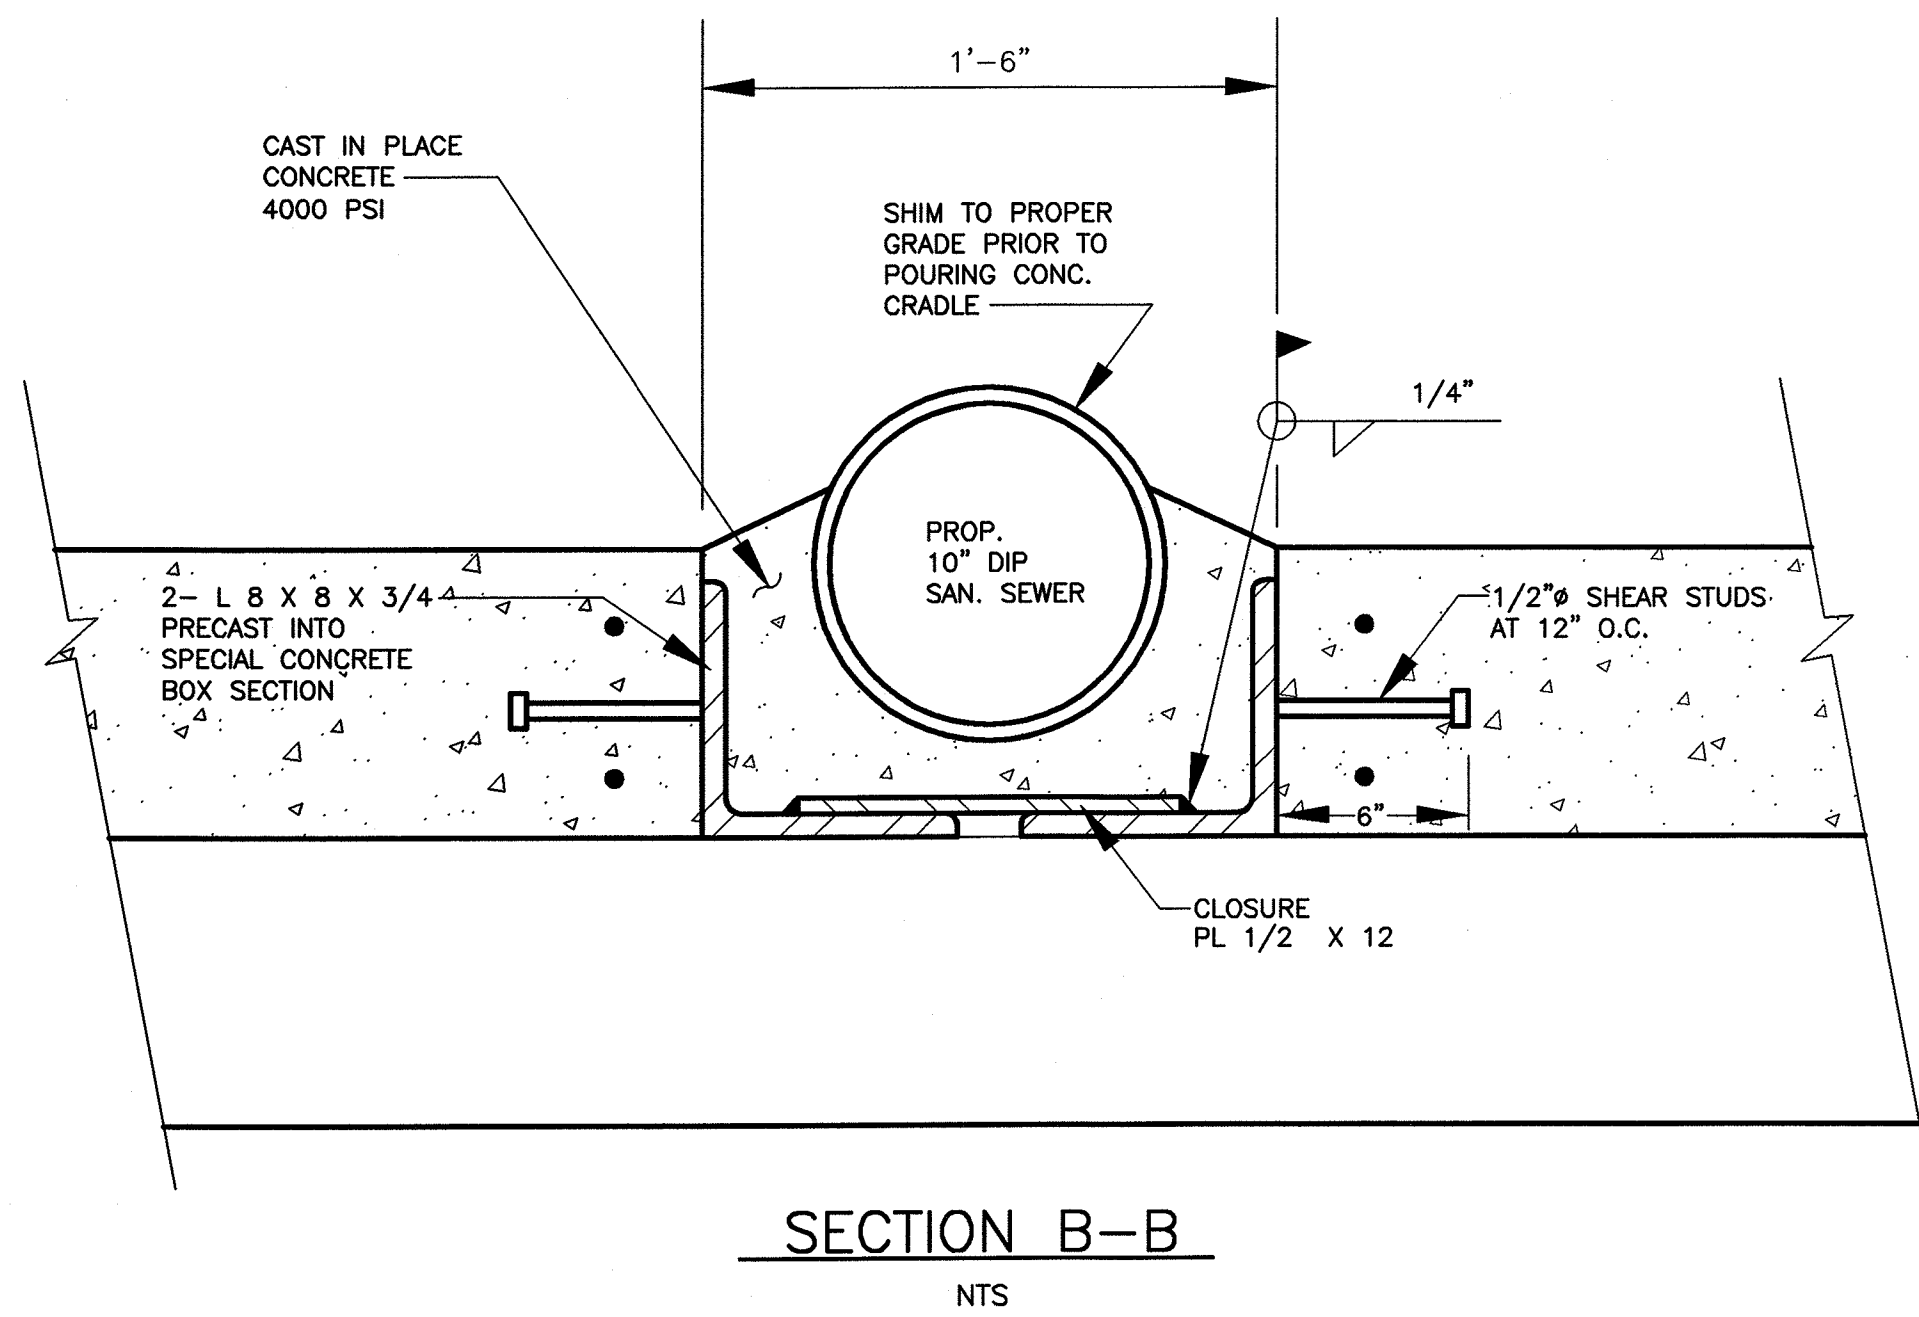

SECTION B-B
NTS

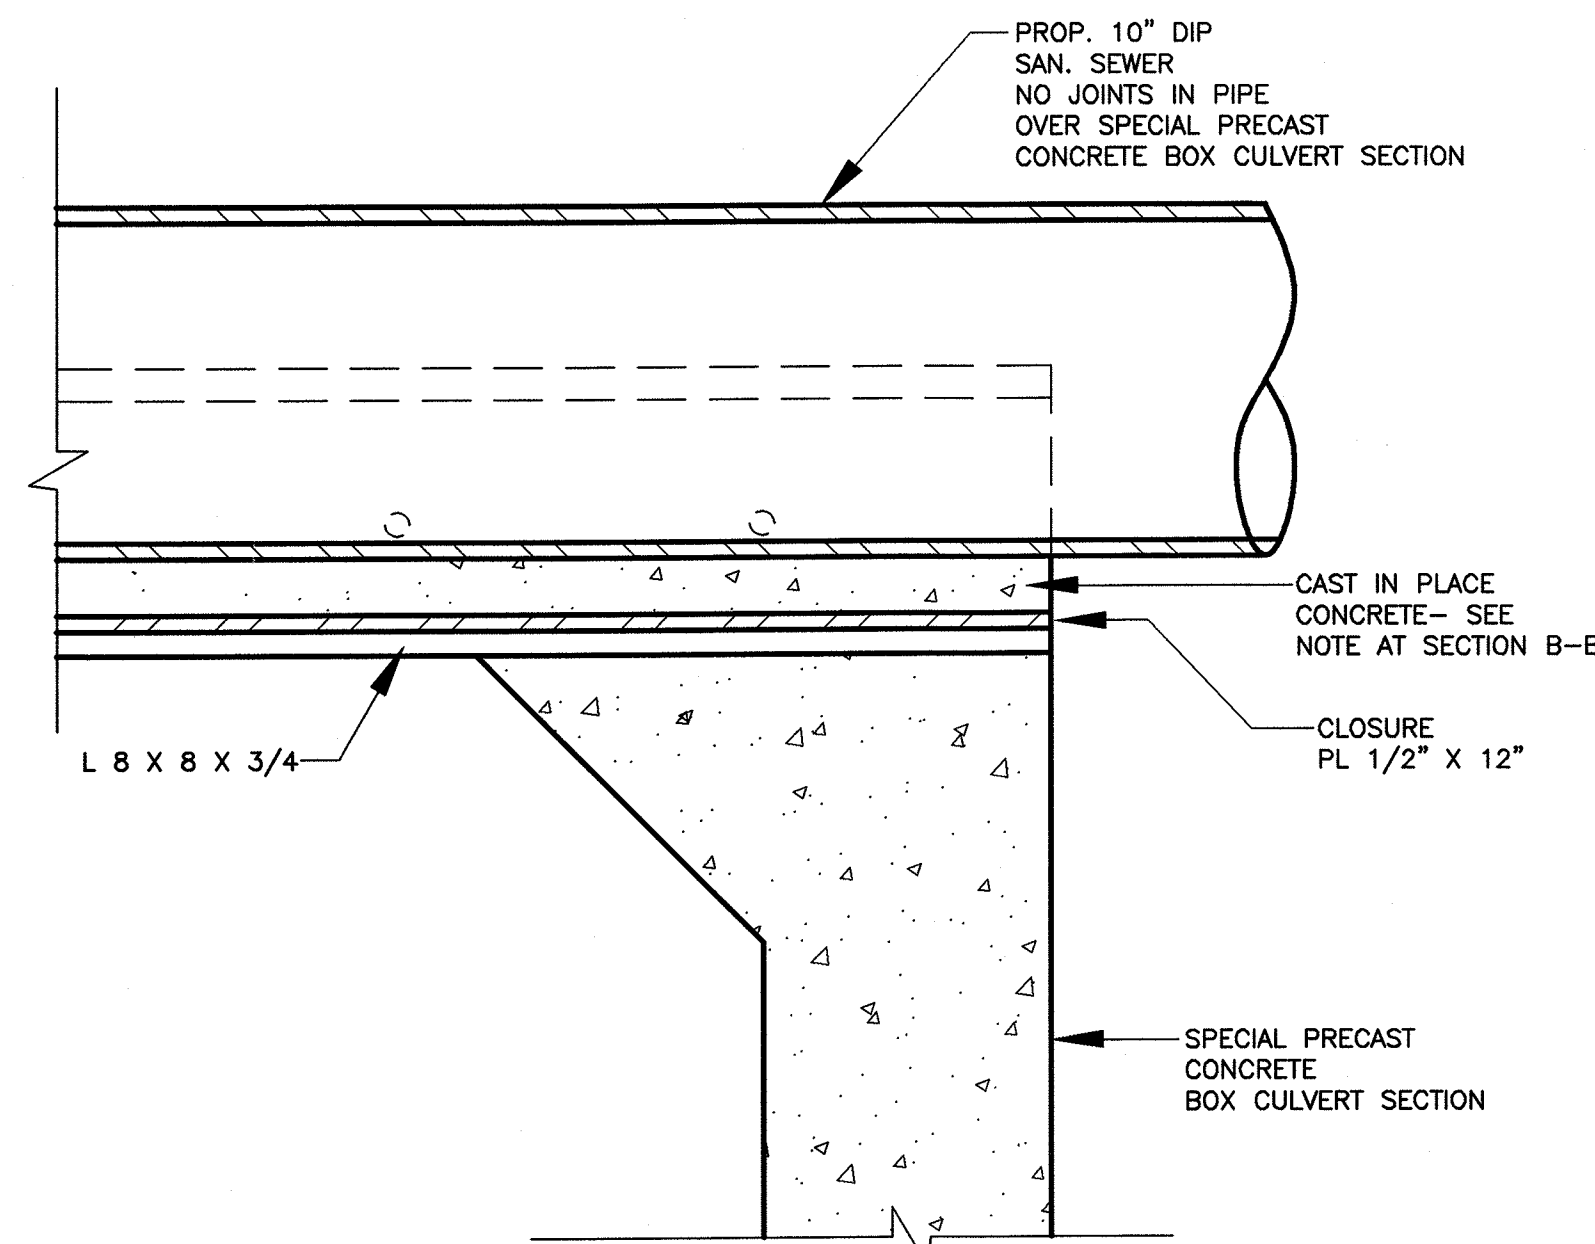


SECTION A-A
NTS

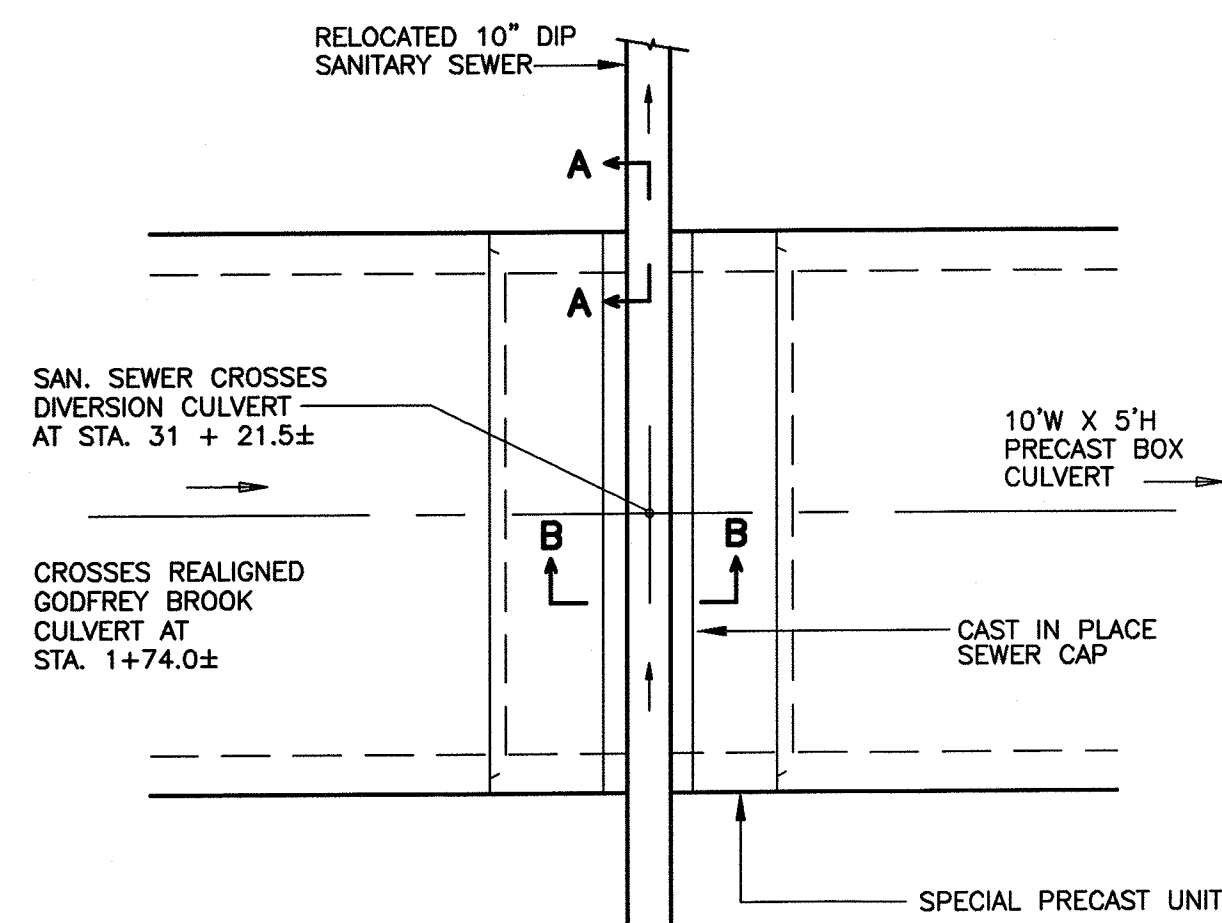


SECTION A-A
SPECIAL PRECAST BOX UNIT WITH CAST-IN-PLACE TOP
NTS

LAYOUT INFORMATION:
PIPE END #1 GODFREY BROOK BASELINE
 STA. 3+28.4, 11.2' LT
 STA. 3+30.2, 23.1' LT
 TOTAL LENGTH OF FRONT FACE= 12'-0"
 TOP OF WALL ELEV.= 302.50
PIPE END #2 O'BRIEN BROOK BASELINE
 STA. -0+11.3, 32.2' LT
 STA. -0+27.2, 32.8' LT
 TOTAL LENGTH OF FRONT FACE= 16'-0"
 TOP OF WALL ELEV.= 307.80

CONCRETE NOTES:
 1. CONCRETE (C) = 4,000 psi, Class A
 2. REINF. - ASTM A-81 GRADE 60, EPOXY COATED
 3. ALL SURFACES VISIBLE WHEN COMPLETED SHALL HAVE RUBBED FINISH.
 4. 1"x1" CHAMFER ALL CONC. CORNERS

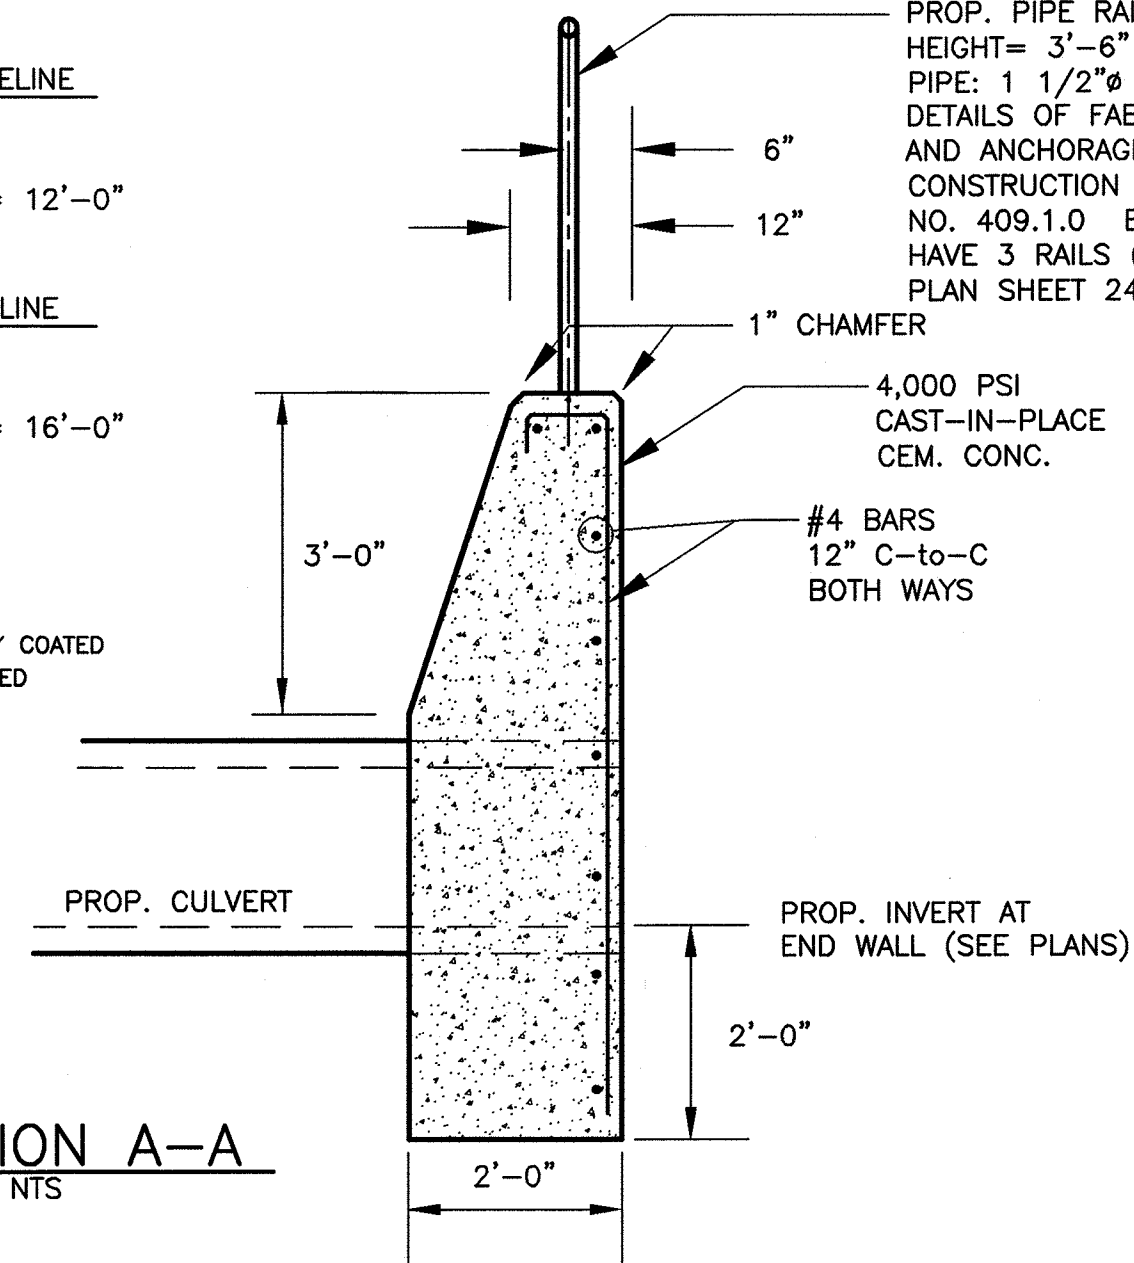


SECTION A-A
NTS

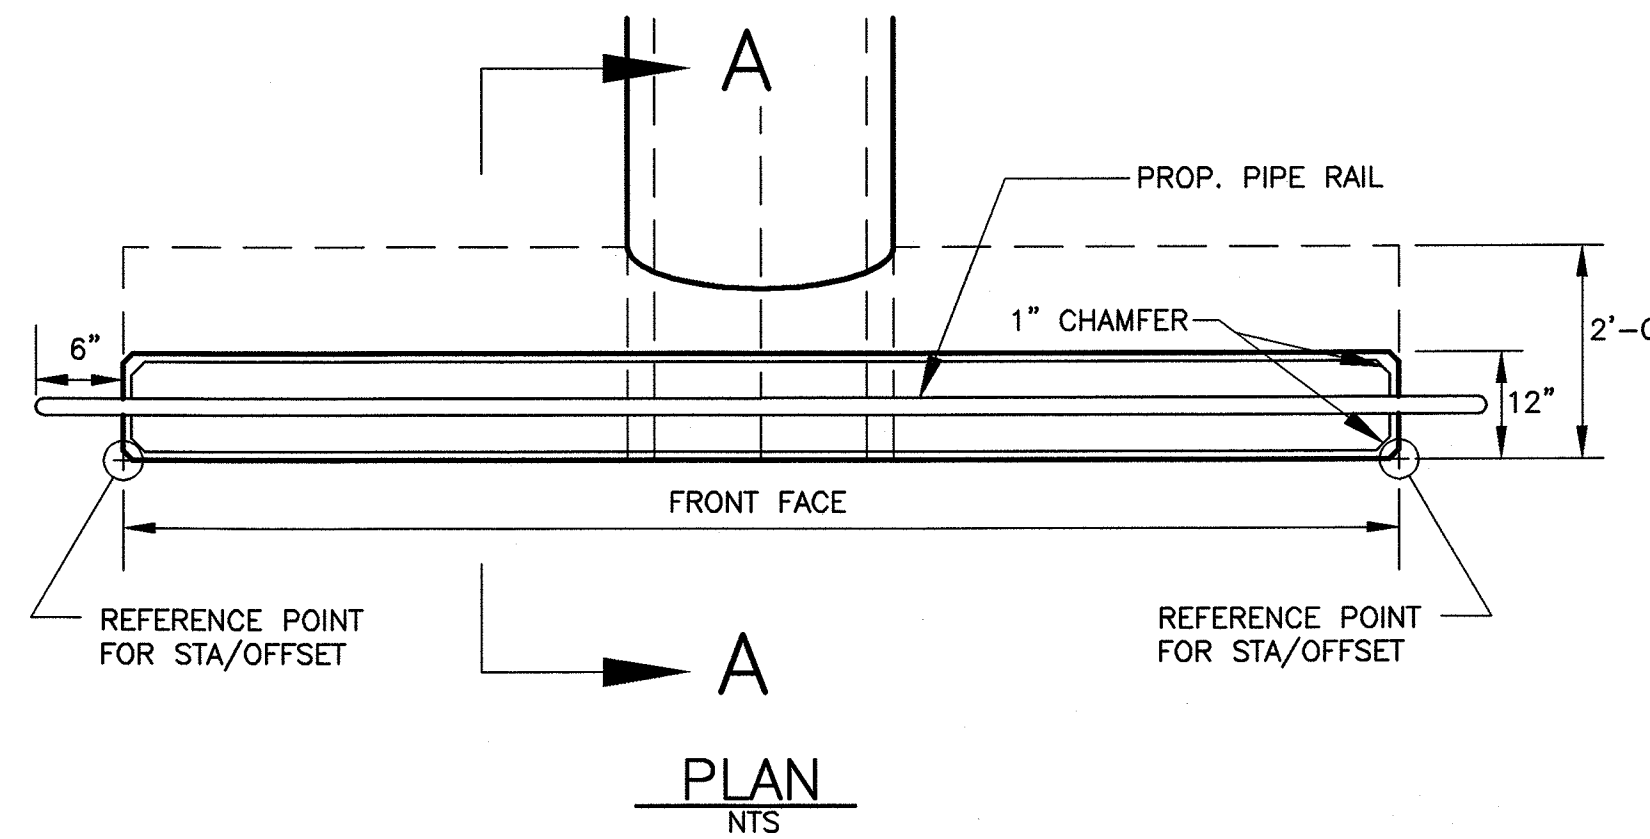


PLAN
NTS


SECTION B-B
CEM. CONC. MASONRY PIPE ENDS
NTS

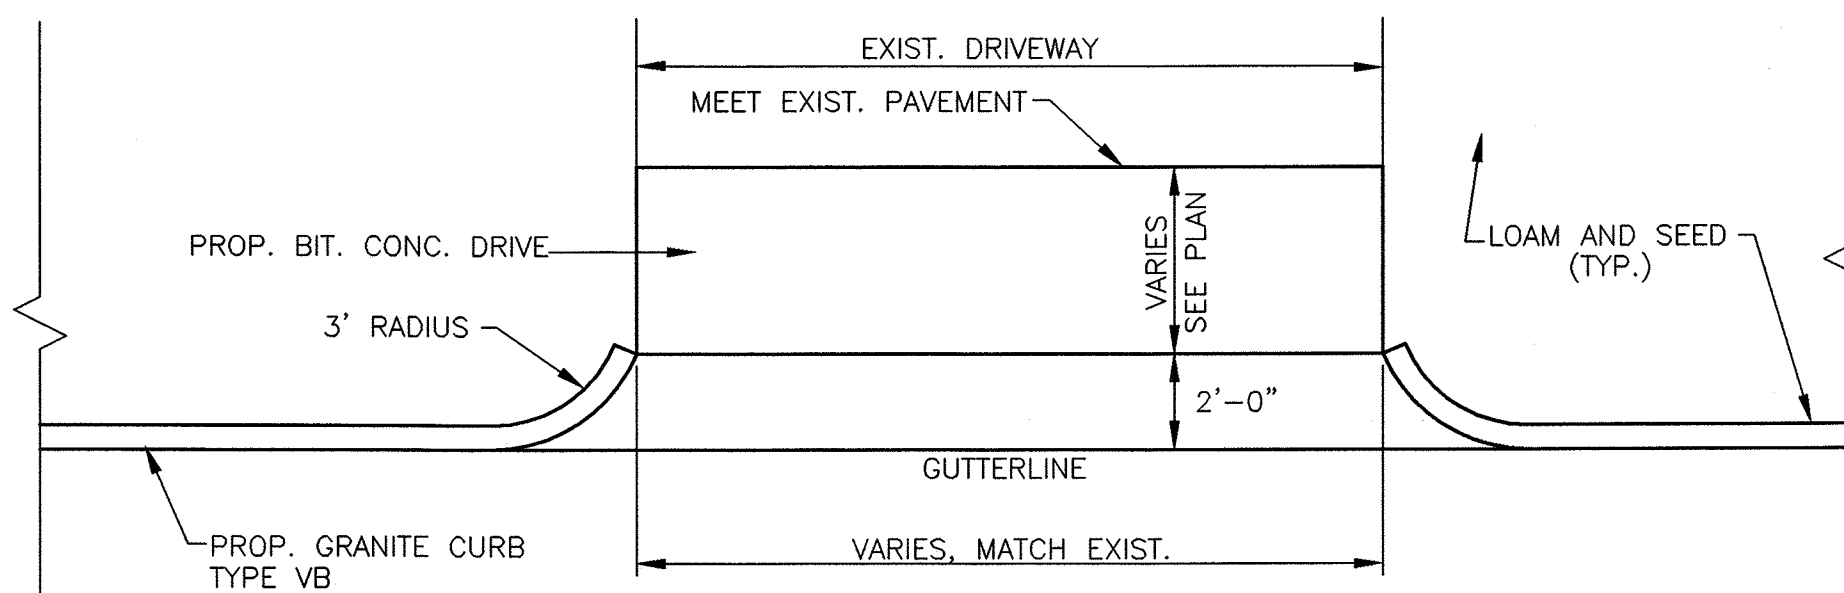


DETAIL FOR DRIVEWAY WITHOUT SIDEWALK
NTS

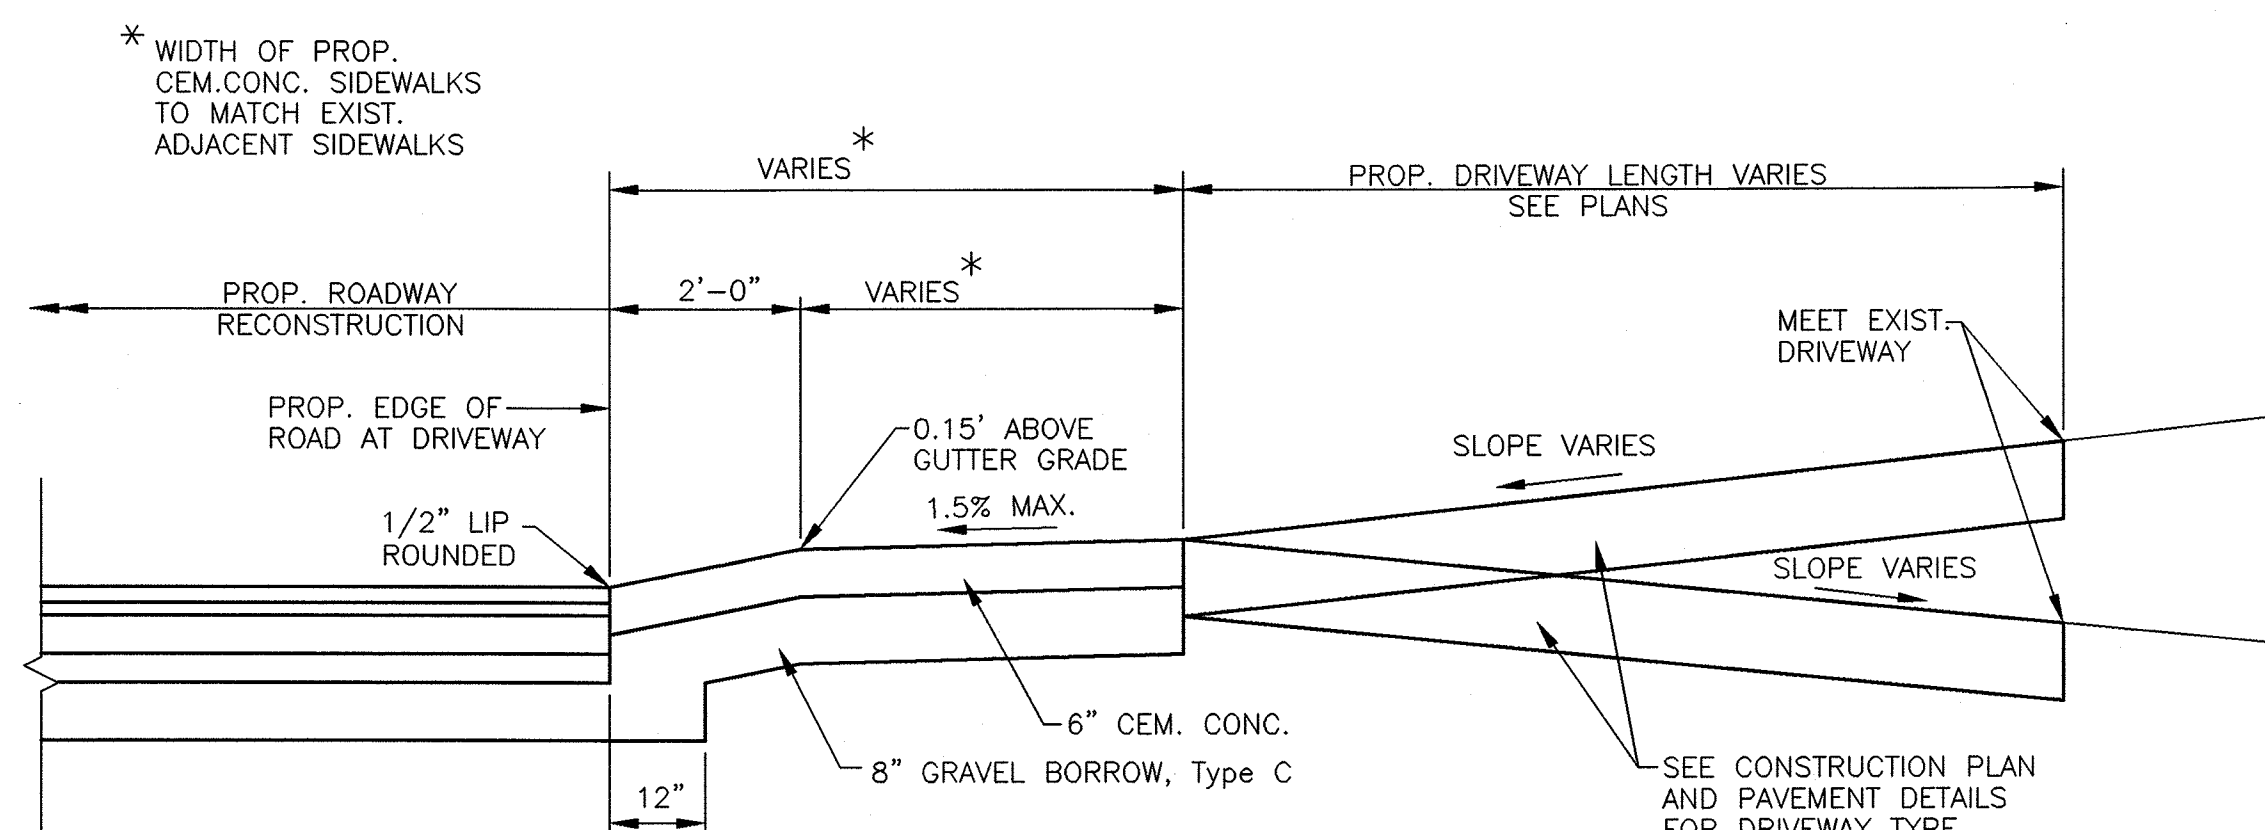


DETAIL FOR TYPICAL DRIVEWAY SECTION
NTS

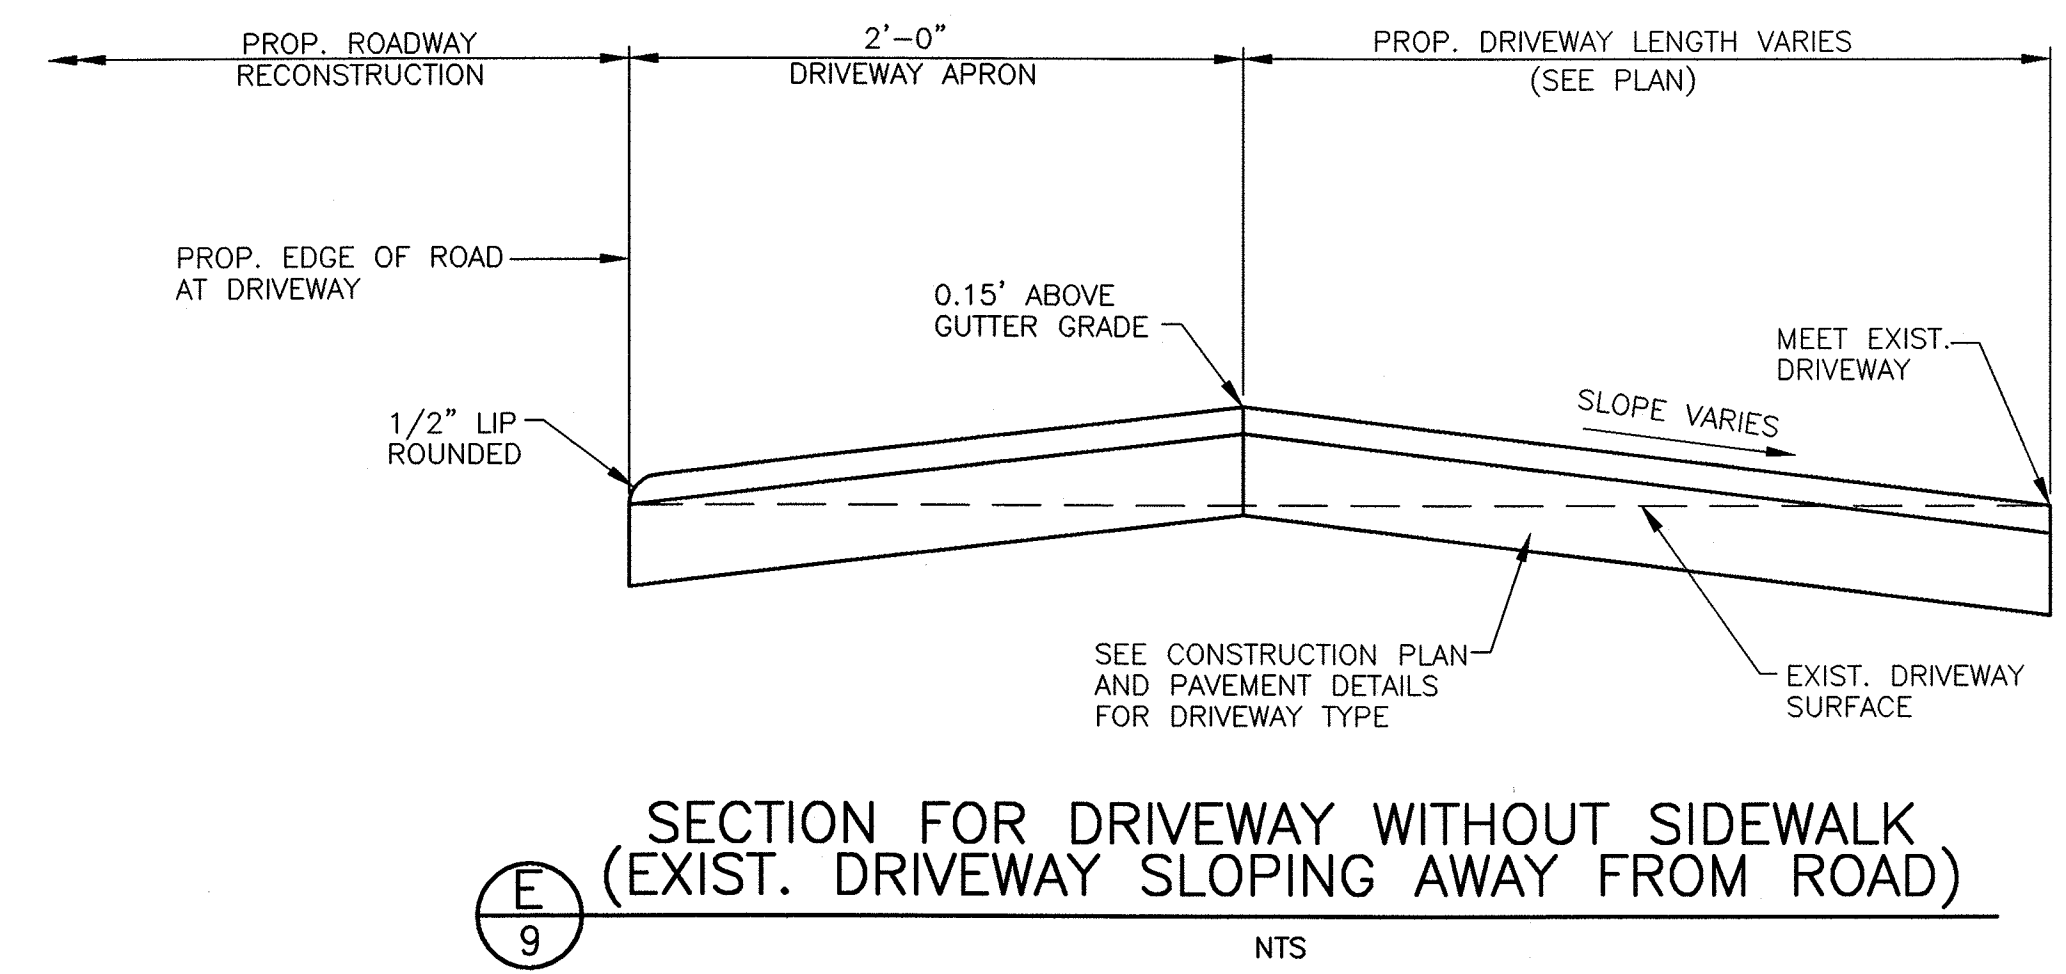

SECTION E
NTS

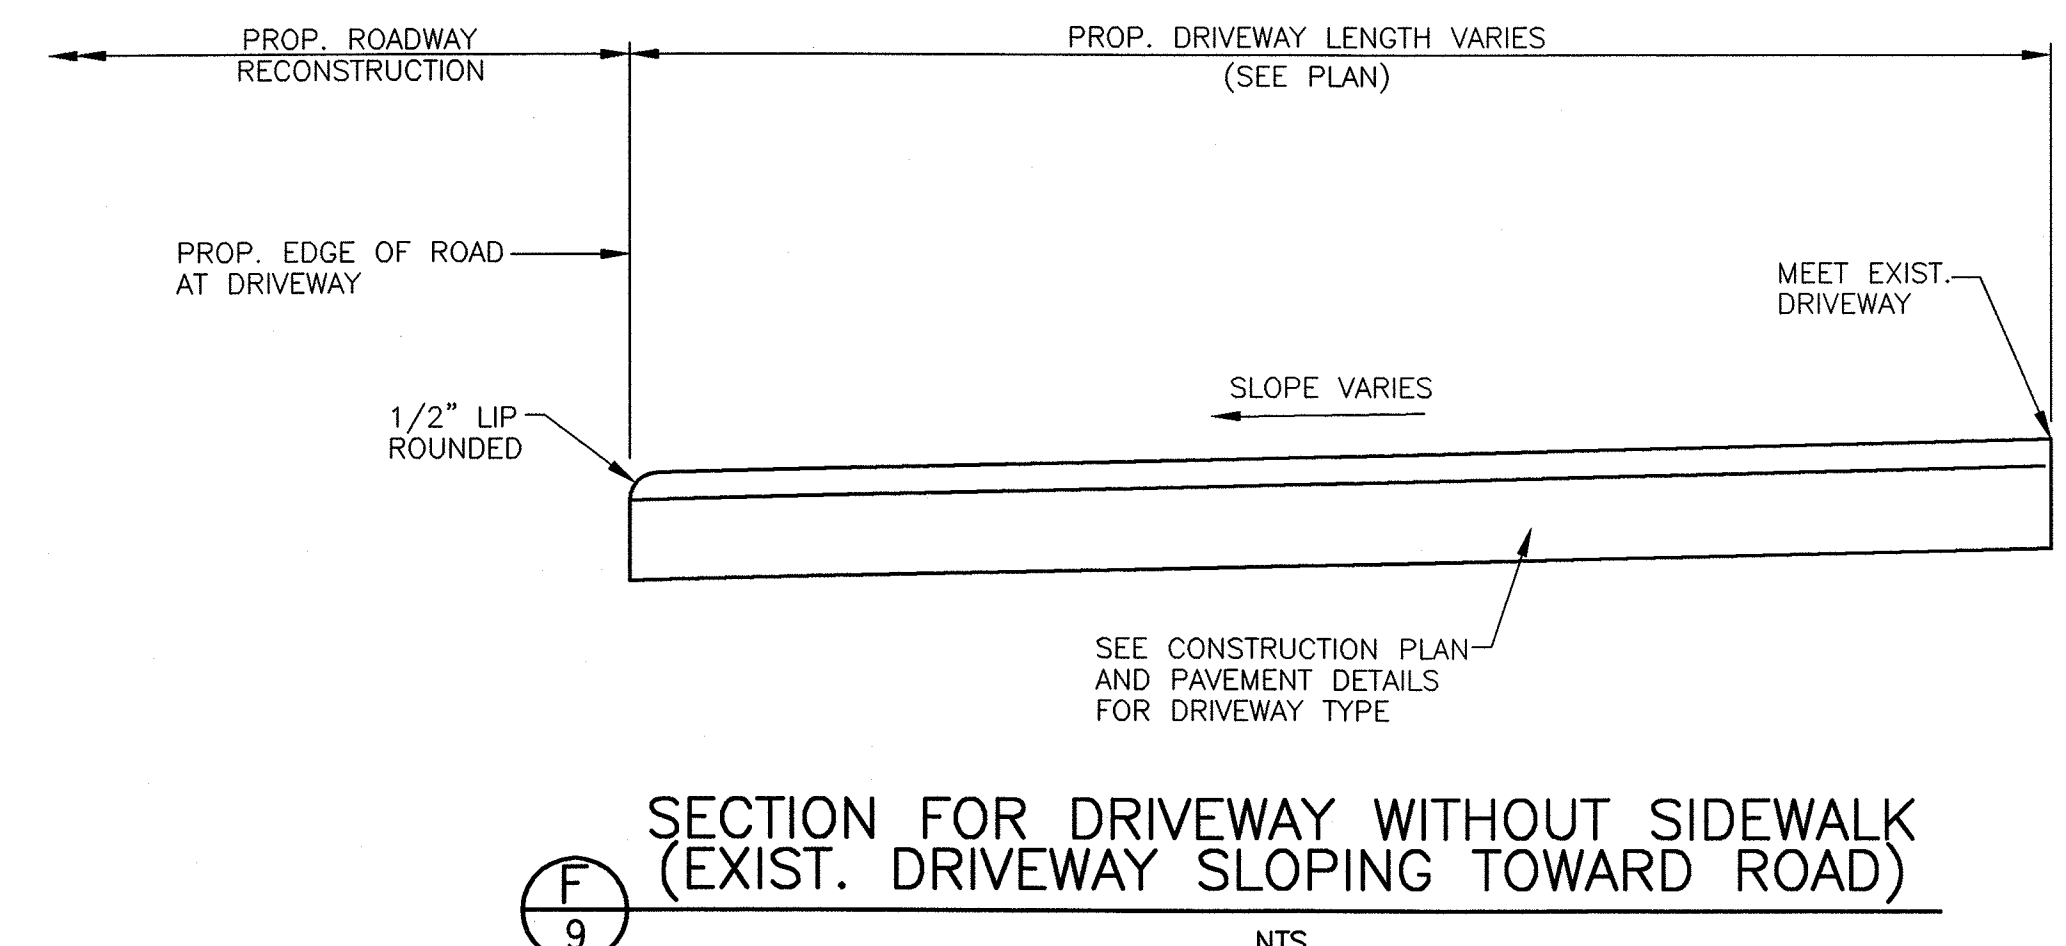


SECTION F
NTS

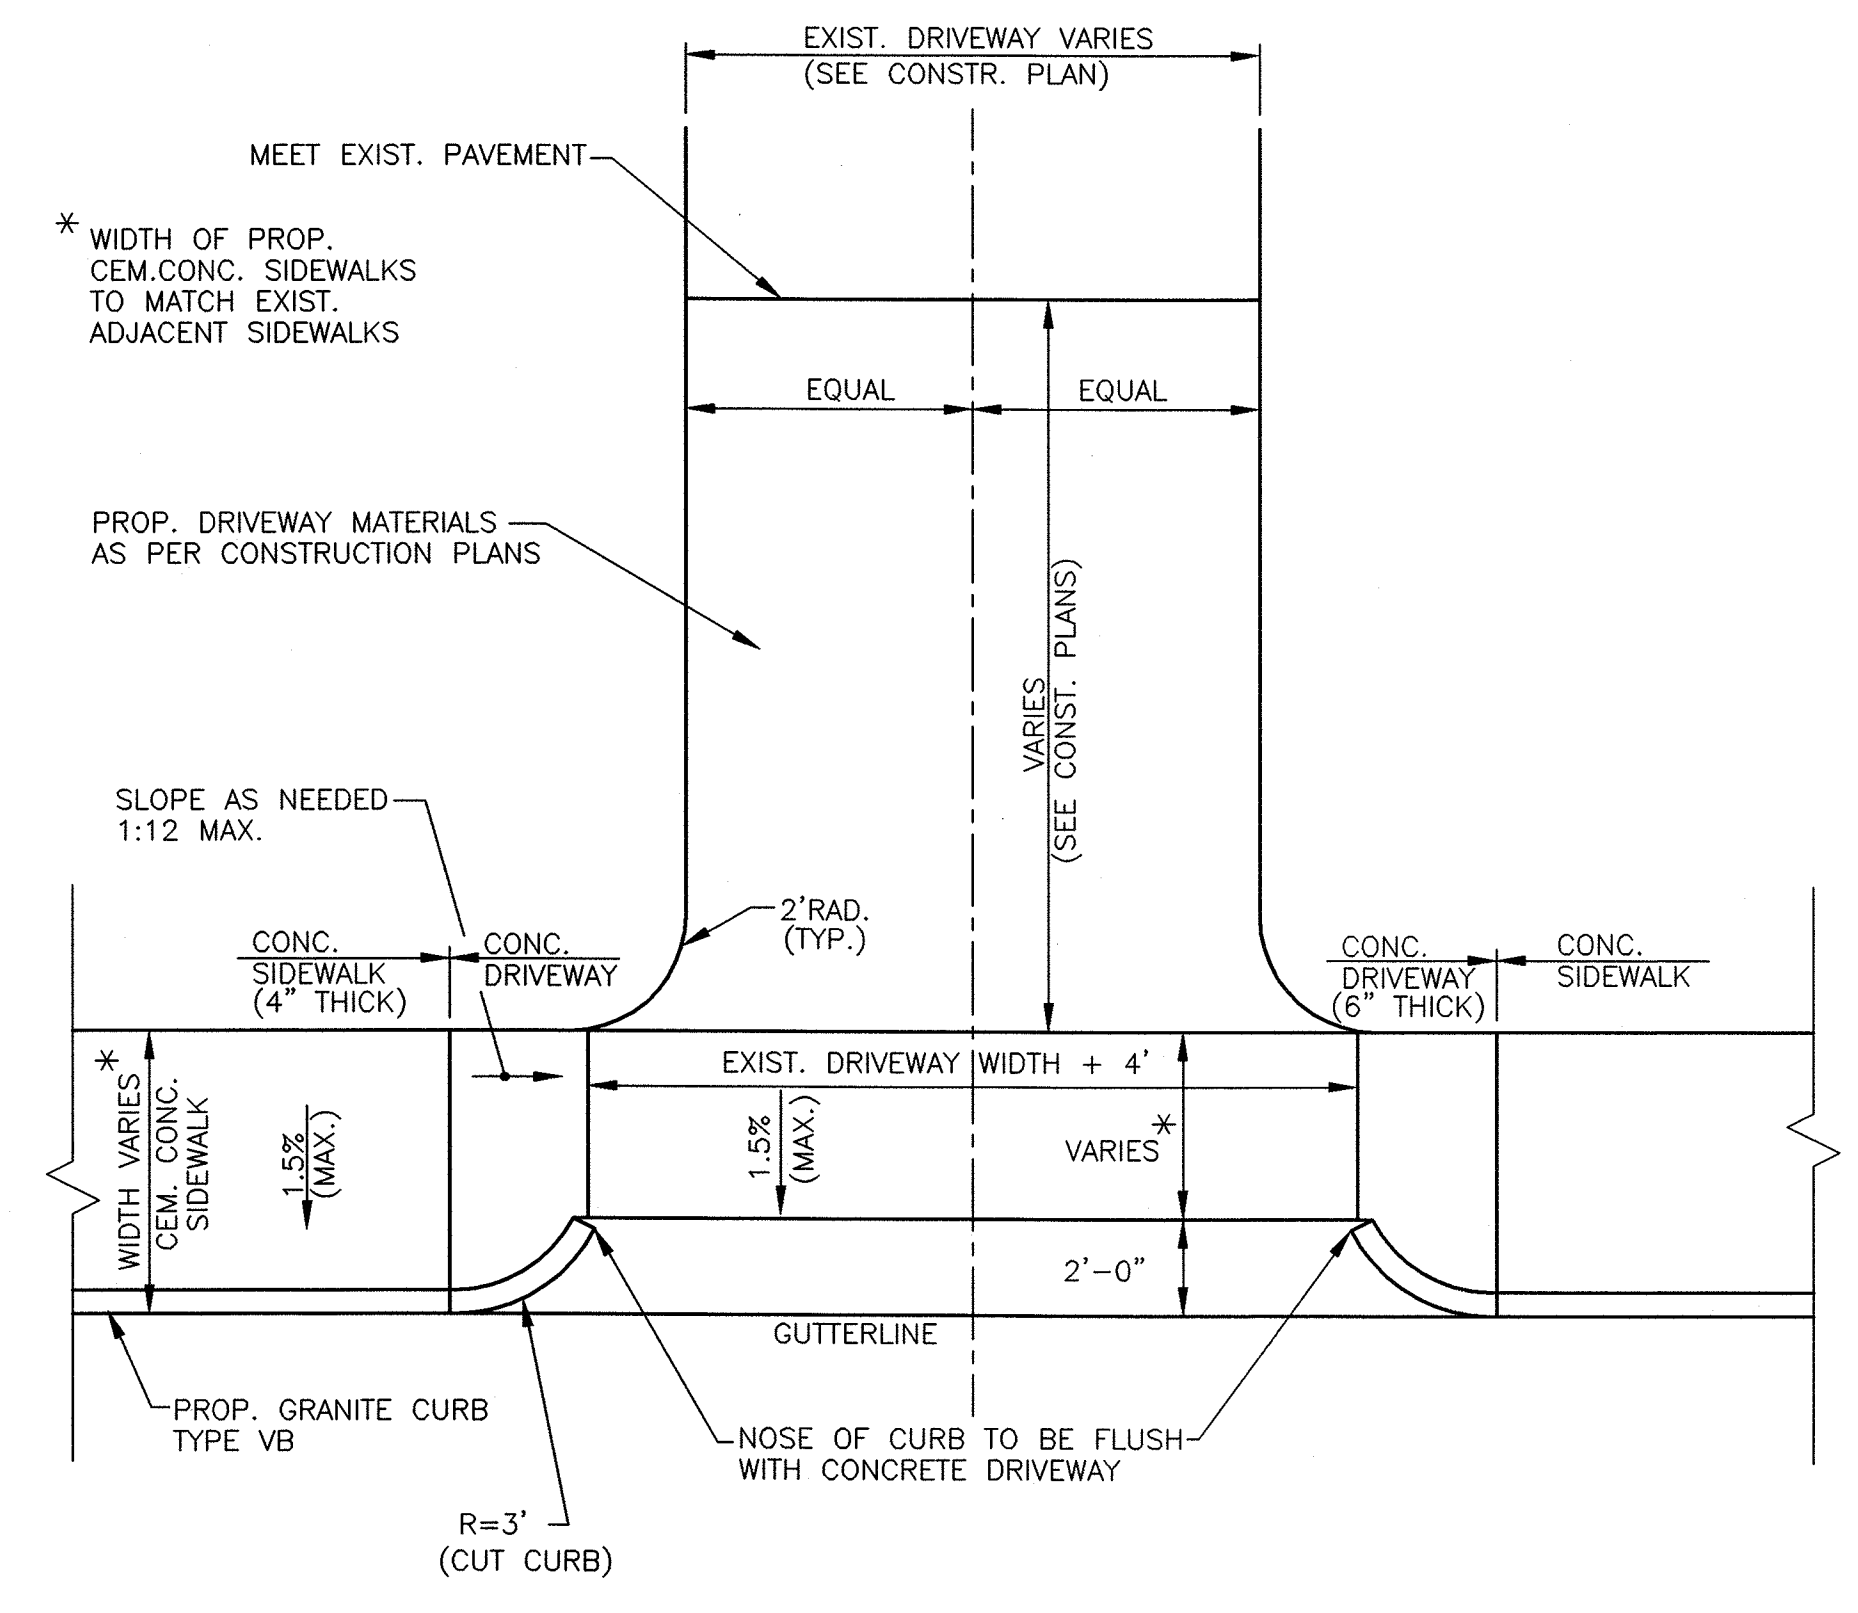


DETAIL FOR DRIVEWAY WITH SIDEWALK
NTS

PROJECT NO. 94-1215		SCALE AS NOTED		DATE APRIL 1999		DRAWN BY SMR		CHECKED BY TEJ	
PROJECT		EDM		TEJ		BY		NO. DATE	
2		10/101		8/12/99		ISSUED FOR BIDDING		REVISION	
1									

BAYSTATE ENVIRONMENTAL CONSULTANTS INC.
 Engineers
 296 North Main Street
 East Longmeadow, MA 01028
 Scientists
 Surveyors

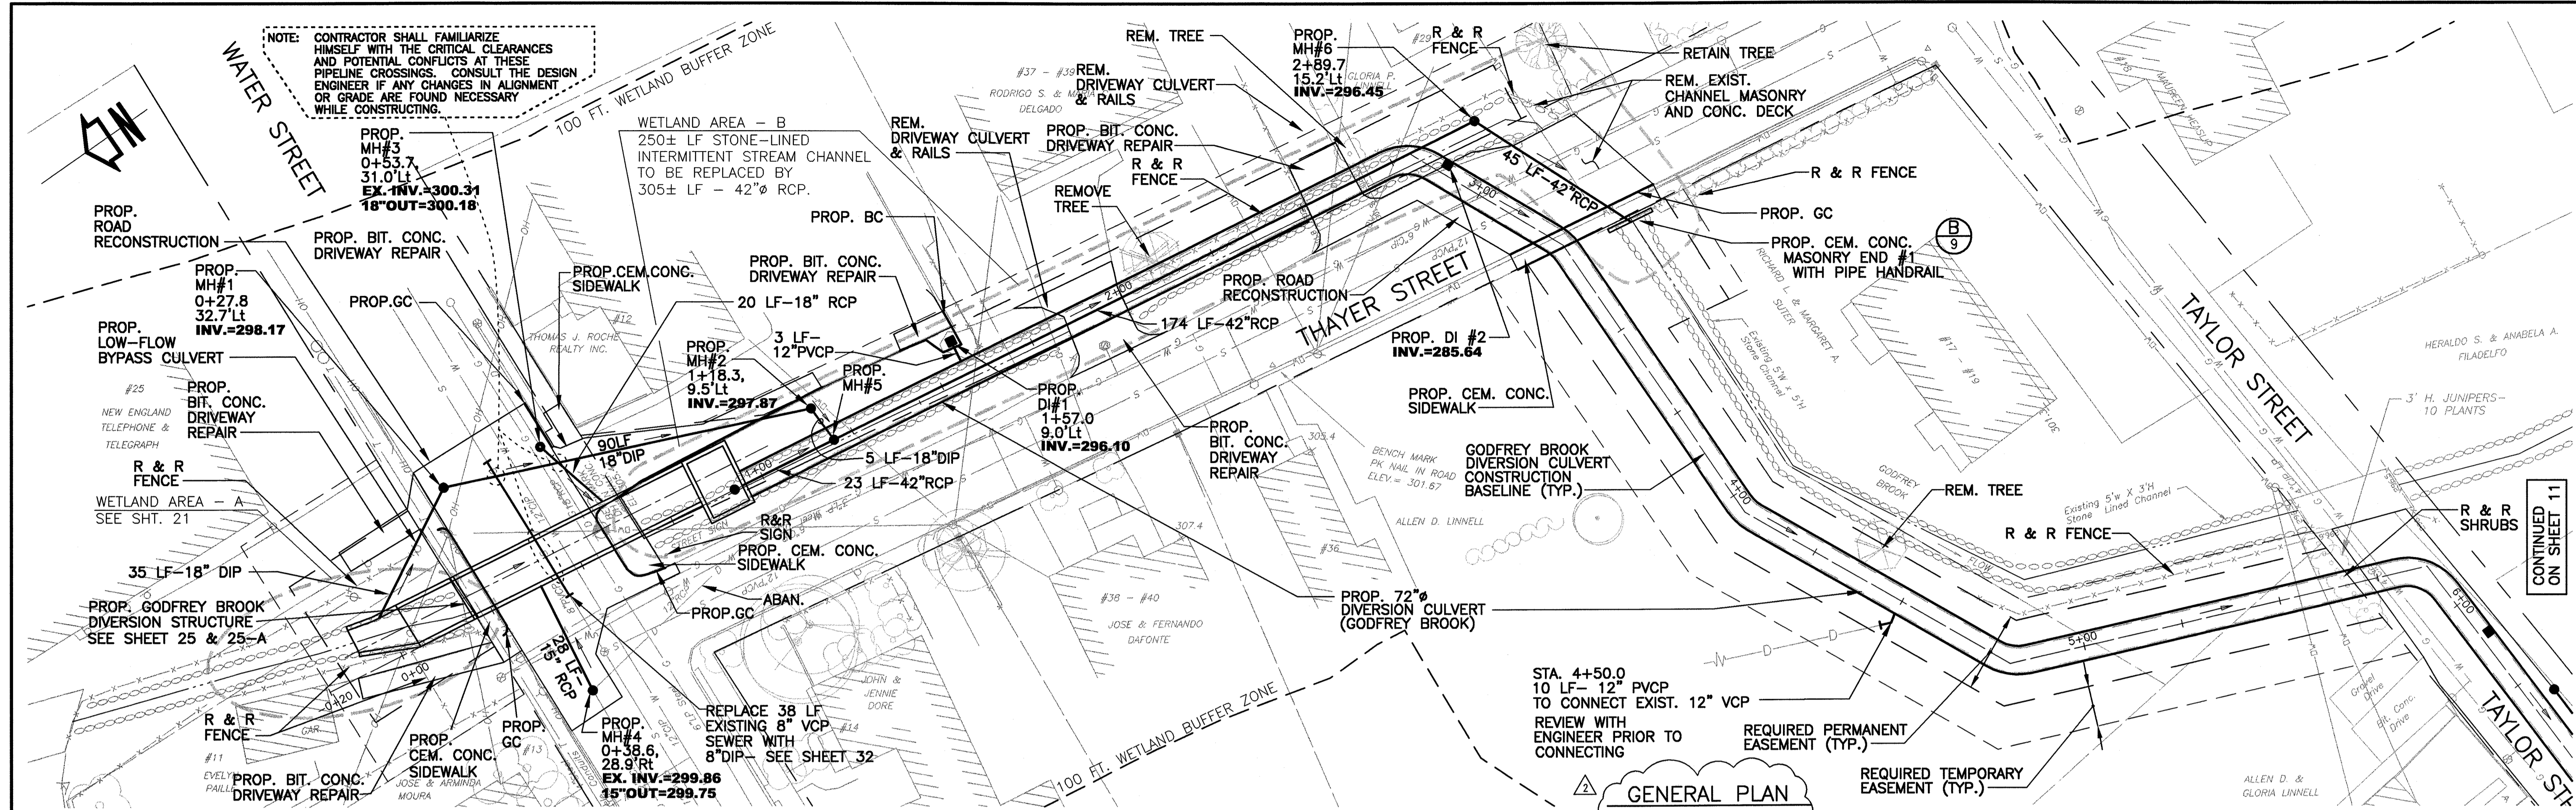

GENERAL PLAN
1" = 20'

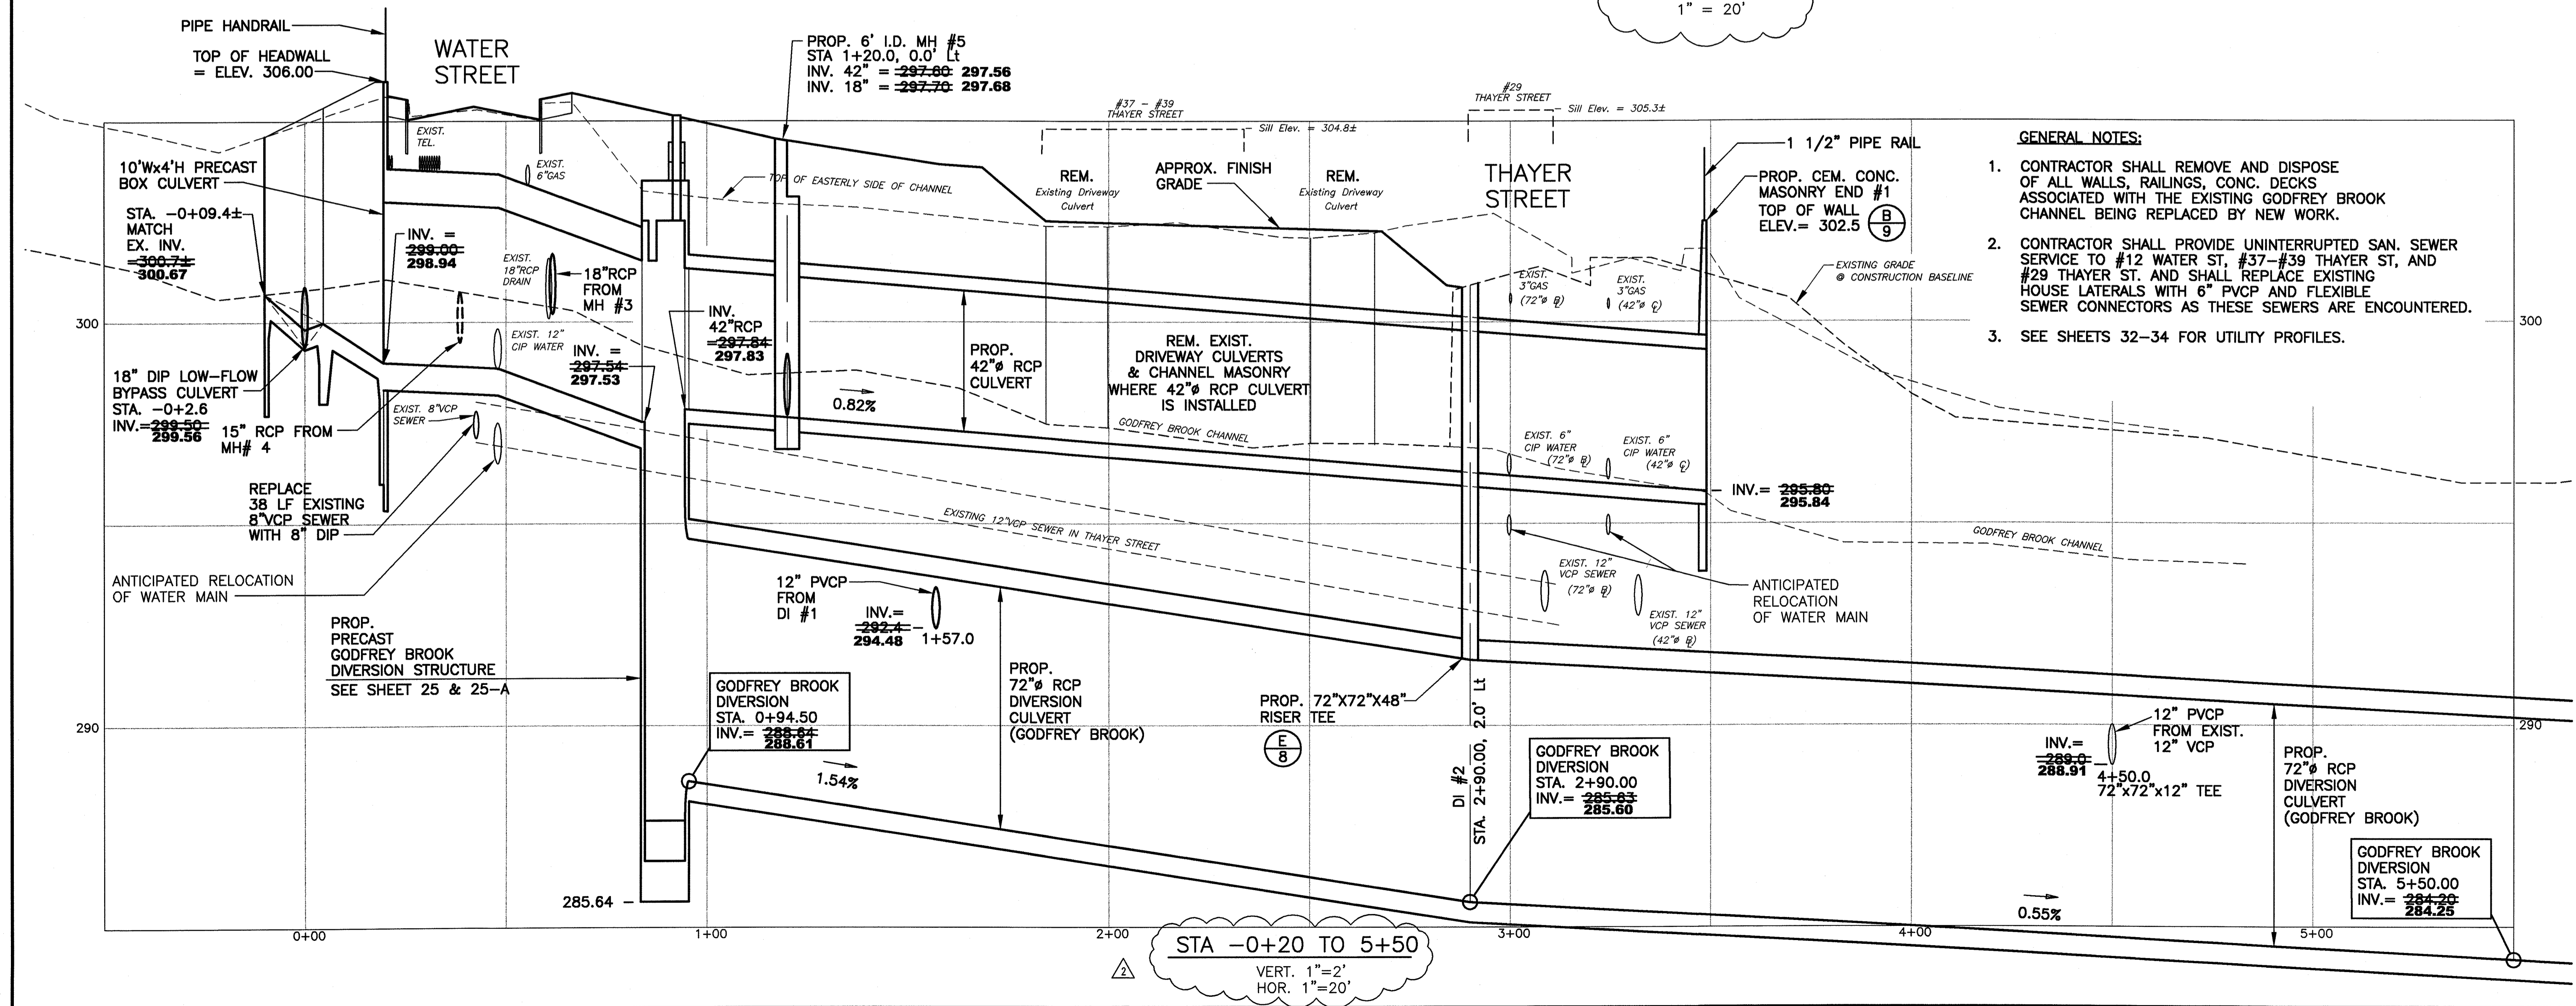

STA -0+20 TO 5+50
VERT. 1"=2'
HOR. 1"=20'

- GENERAL NOTES:**
- CONTRACTOR SHALL REMOVE AND DISPOSE OF ALL WALLS, RAILINGS, CONC. DECKS ASSOCIATED WITH THE EXISTING GODFREY BROOK CHANNEL BEING REPLACED BY NEW WORK.
 - CONTRACTOR SHALL PROVIDE UNINTERRUPTED SAN. SEWER SERVICE TO #12 WATER ST, #37-#39 THAYER ST, AND #29 THAYER ST. AND SHALL REPLACE EXISTING HOUSE LATERALS WITH 6" PVC AND FLEXIBLE SEWER CONNECTORS AS THESE SEWERS ARE ENCOUNTERED.
 - SEE SHEETS 32-34 FOR UTILITY PROFILES.

PROJECT NO. 94-1215		SCALE AS NOTED		DATE APRIL 1999		DRAWN BY EDM		CHECKED BY TEJ	
PROJECT TITLE		Plan / Profile		Sta. -0+20 to 5+50		Godfrey Brook Diversion Culvert		Godfrey Brook Flood Mitigation Project	
SHEET TITLE		Plan / Profile		Sta. -0+20 to 5+50		Godfrey Brook Diversion Culvert		Milford, Massachusetts	
ISSUED AS RECORD PRINT		10/1/01		11/13/00		8/12/99		DATE	
NO.		1		1		1		NO.	
REVISION		ISSUED FOR BIDDING		STRUCTURE, MISC. EDITS		TEJ		BY	
DATE		8/12/99		TEJ		EDM		BY	



BAYSTATE ENVIRONMENTAL CONSULTANTS INC.
Engineers
296 North Main Street
East Longmeadow, MA 01028

Scientists
Surveyors

10 of 35 SHEETS

AutoCAD File: P:\AUTOCAD\ACAD\M\941215\RECORD DRAWINGS\Sheet 10 & 32.dwg Plotted at: Mon Oct 01 16:01:59 2001
BEC, Inc.

Autocad File: P:\AUTOCAD\ACAD\IN\941215\RECORD DRAWINGS\Sheet12 13 14 15 23.dwg Plotted at: Mon Oct 01 15:27:37 2001
BEC, Inc.

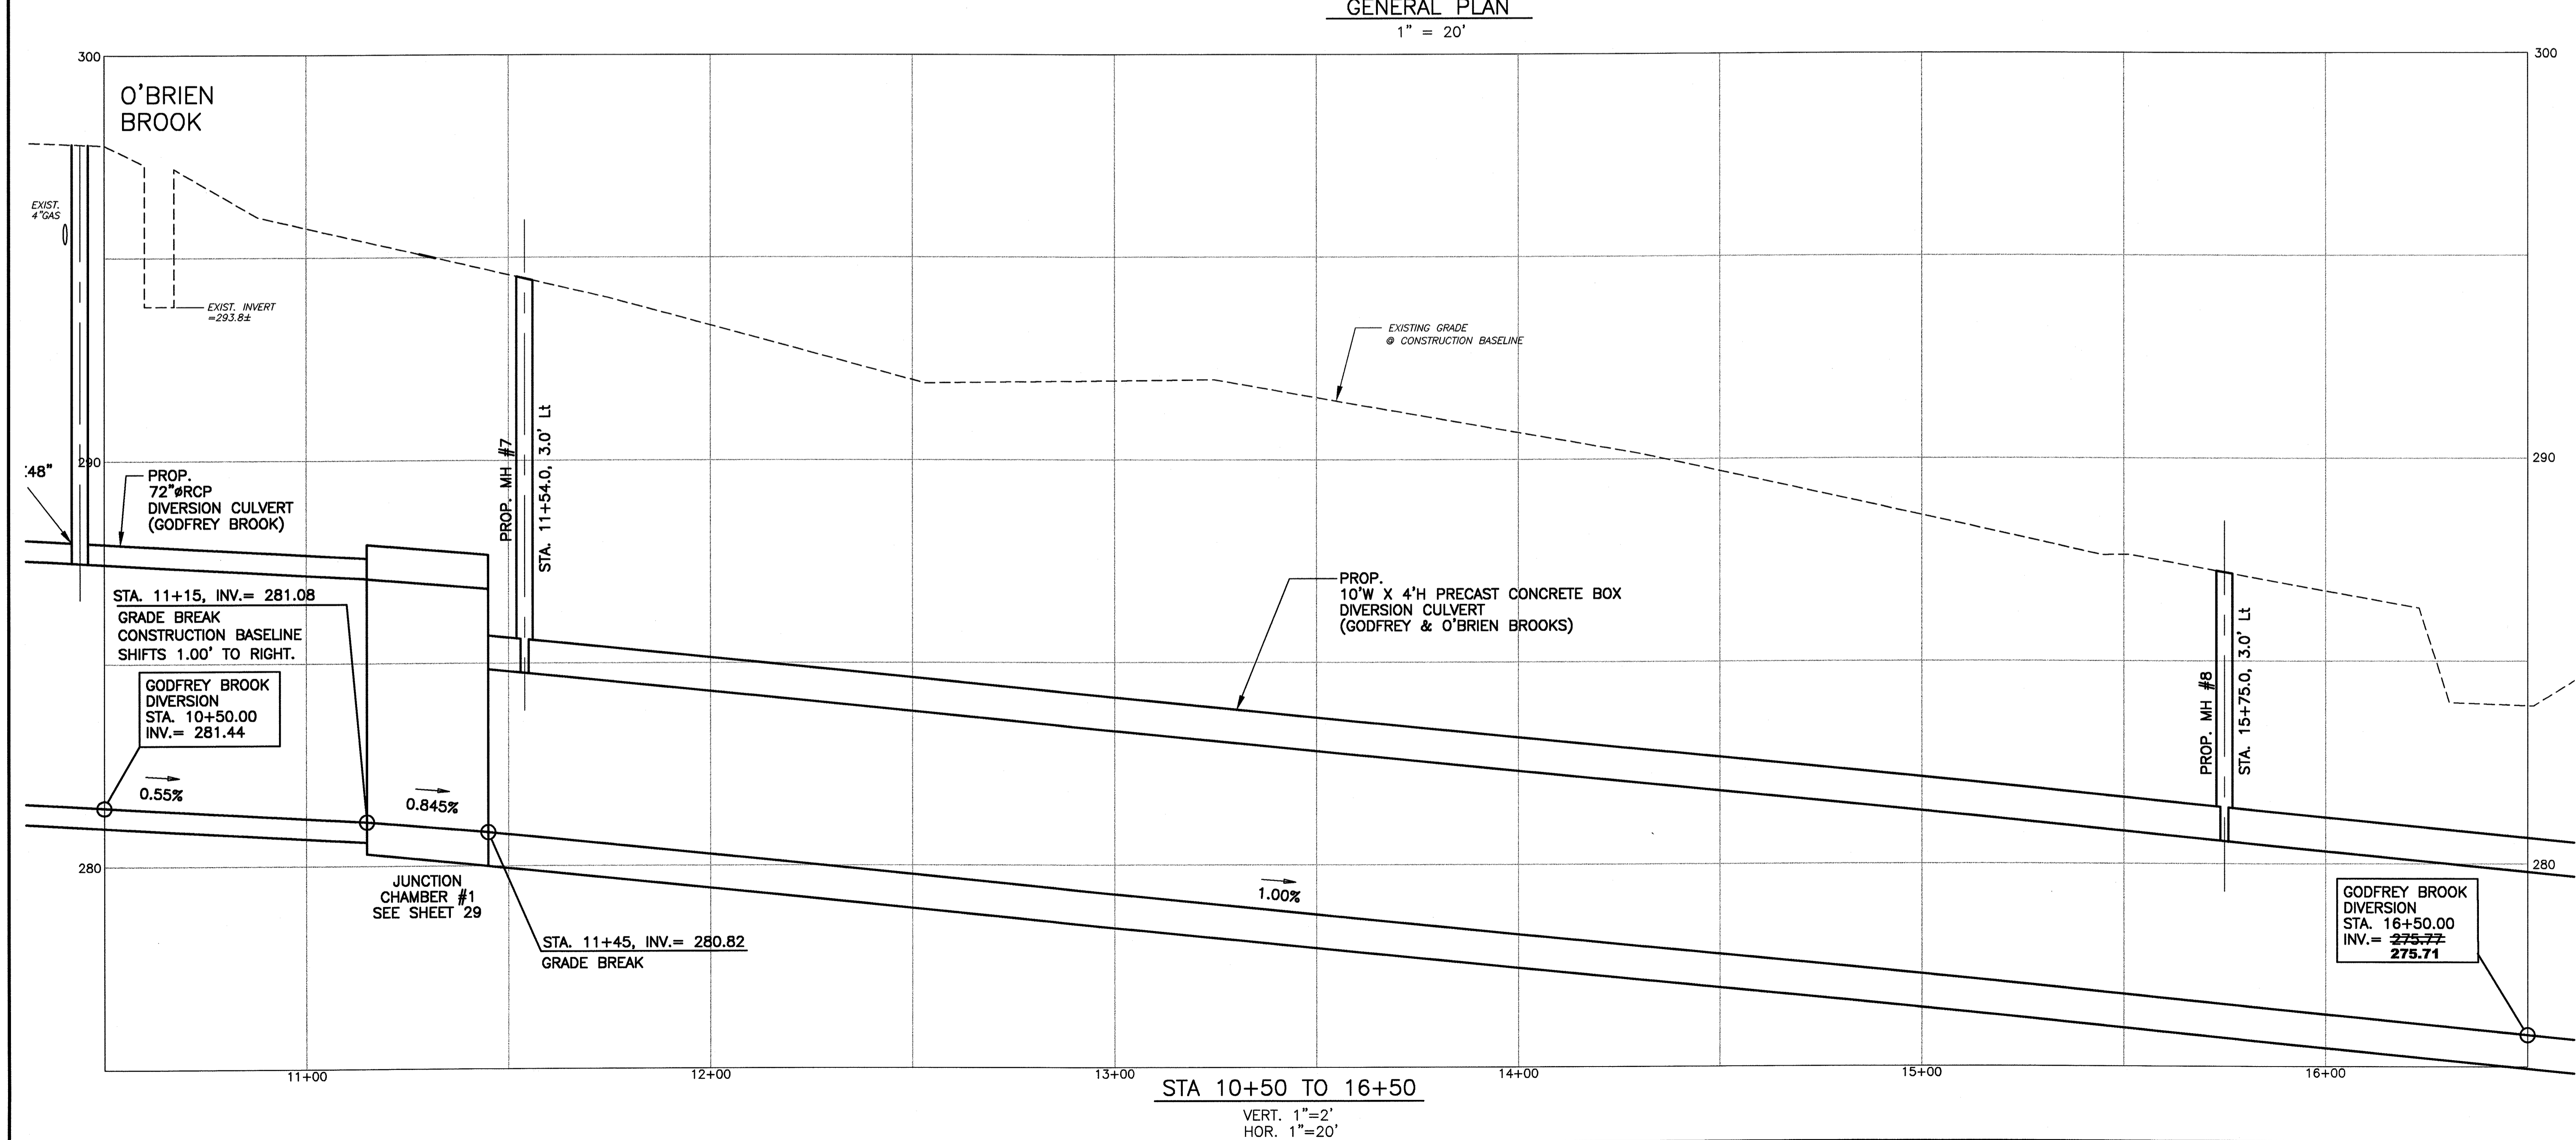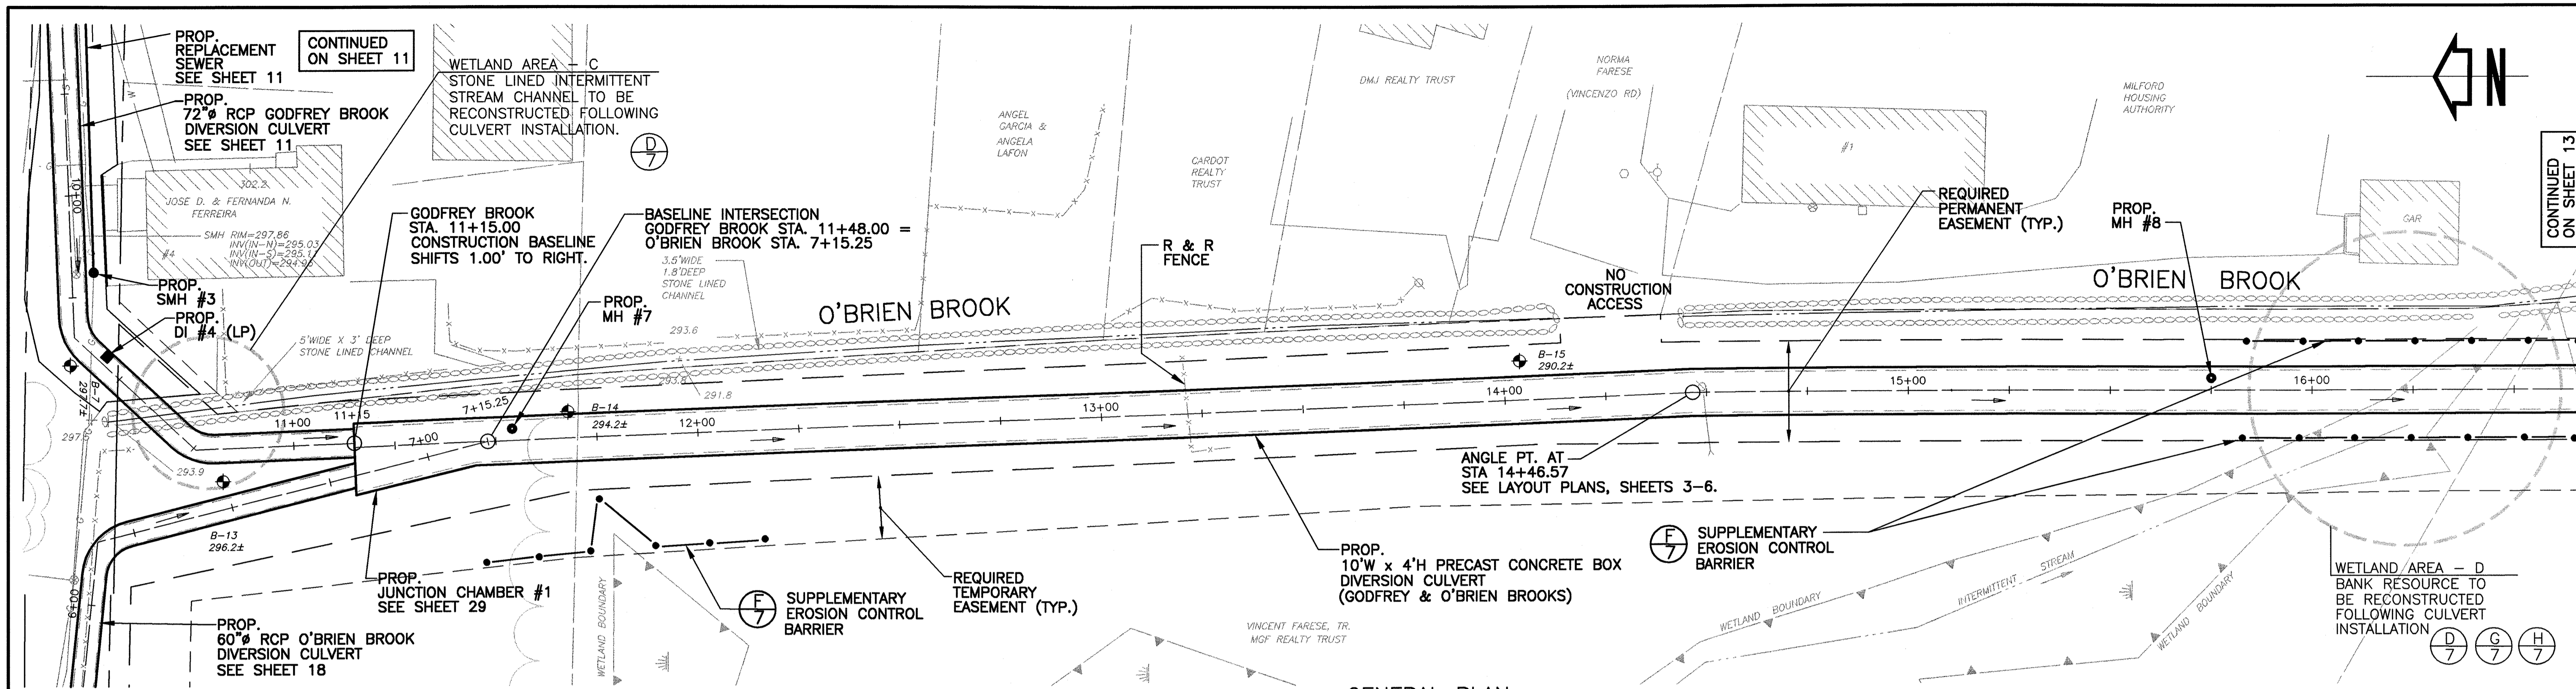

PROJECT NO. 94-1215		DATE APRIL 1999	
SCALE AS NOTED		DRAWN BY EDM	
CHECKED BY TEJ		DATE	
Plan / Profile Sta. 10+50 to 16+50 Godfrey Brook Diversion Culvert Godfrey Brook Flood Mitigation Project Milford, Massachusetts			
ISSUED AS RECORD PRINT		ISSUED FOR BIDDING	
NO.	DATE	REVISION	BY
2	10/01/99		TEJ
1	8/12/99		TEJ

PROJECT TITLE: Godfrey Brook Flood Mitigation Project

PROJECT: Godfrey Brook Diversion Culvert


LOCATION: Milford, Massachusetts

ENGINEERS: BAYSTATE ENVIRONMENTAL CONSULTANTS INC.
296 North Main Street
East Longmeadow, MA 01028


SCIENTISTS: East Longmeadow, MA 01028

SURVEYORS: East Longmeadow, MA 01028

12 of 35 SHEETS

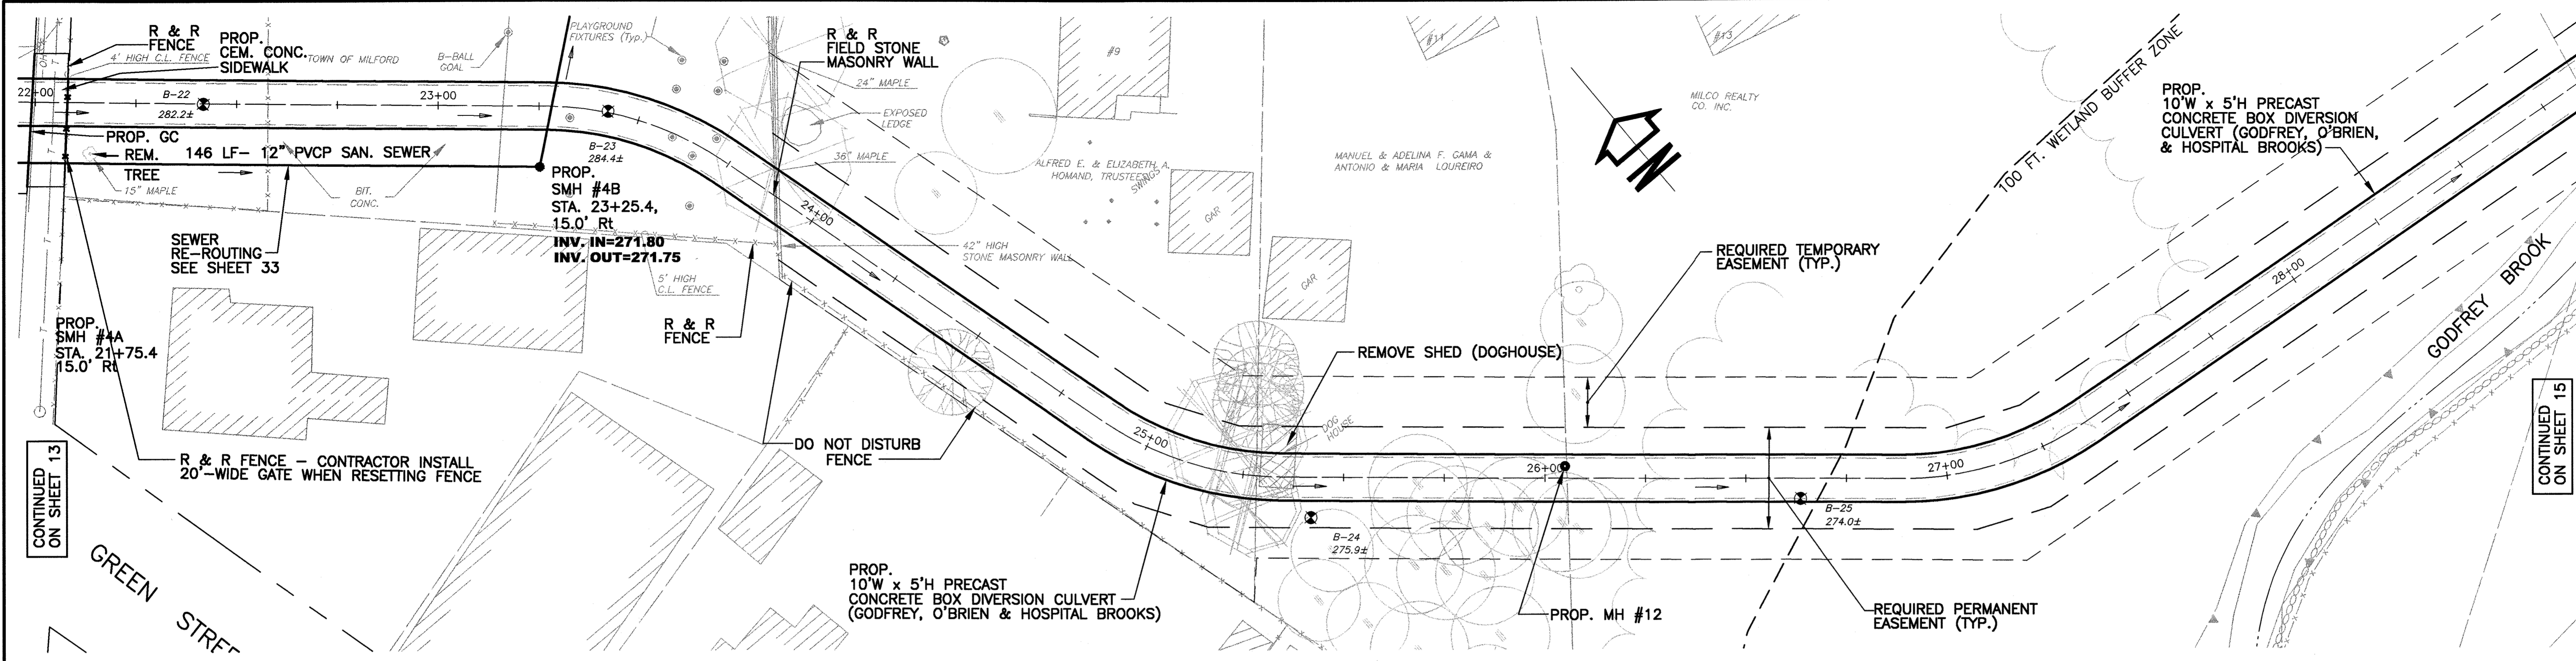

GENERAL PLAN
1" = 20'

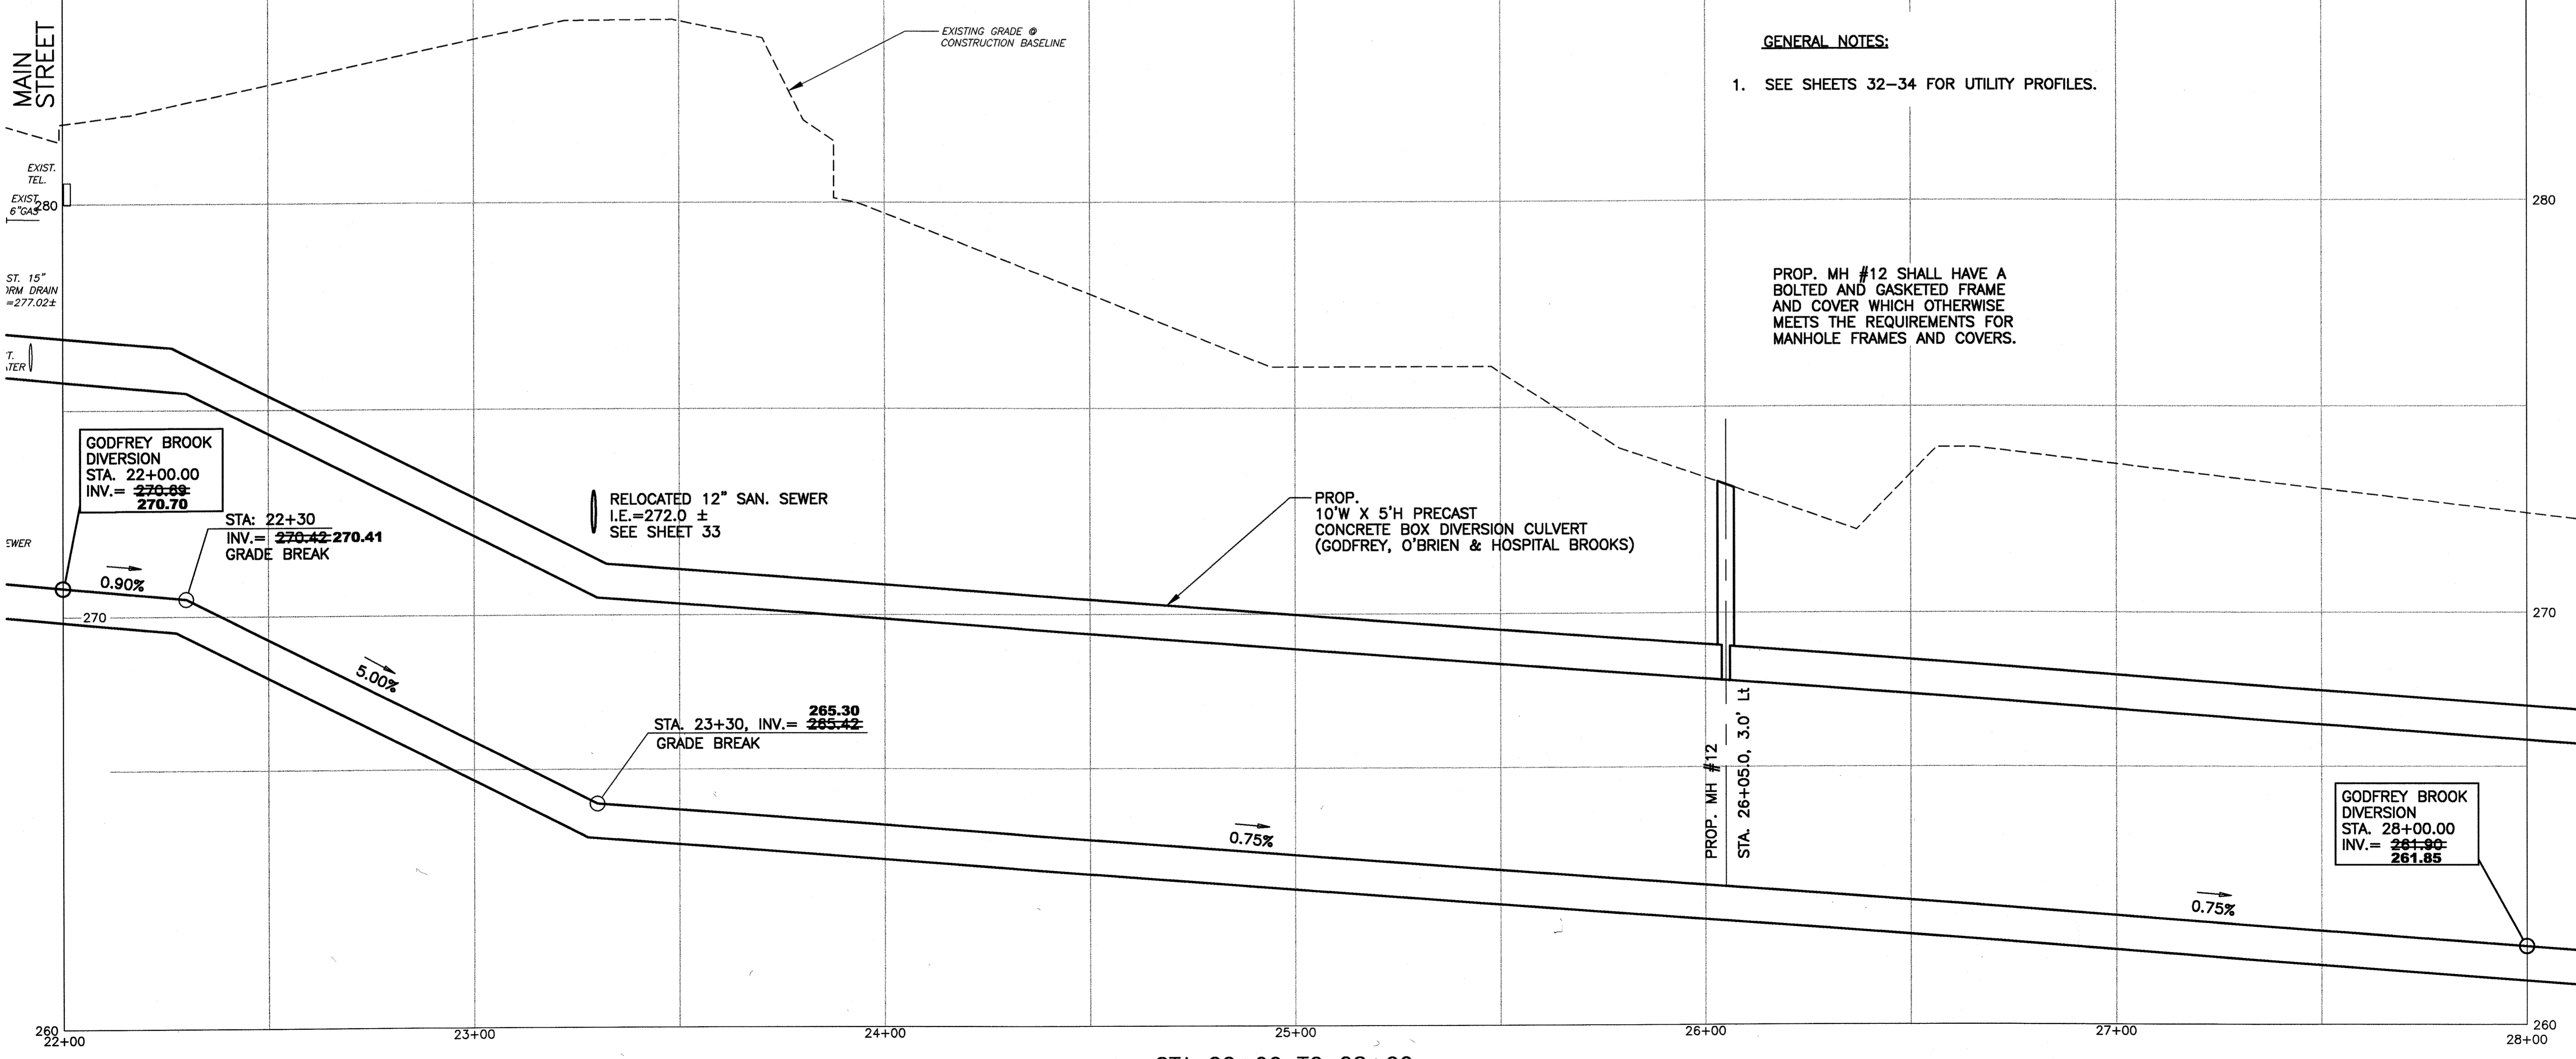



STA 22+00 TO 28+00
VERT. 1"=2'
HOR. 1"=20'

GENERAL NOTES:
1. SEE SHEETS 32-34 FOR UTILITY PROFILES.

PROP. MH #12 SHALL HAVE A BOLTED AND GASKETED FRAME AND COVER WHICH OTHERWISE MEETS THE REQUIREMENTS FOR MANHOLE FRAMES AND COVERS.

AutoCAD File: P:\AUTOCAD\ADMIN\941245\RECORD DRAWINGS\Sheet12 13 14 15 23.dwg Plotted at: Mon Oct 01 15:33:47 2001
BEC, Inc.

14 OF 35 SHEETS			
BAYSTATE ENVIRONMENTAL CONSULTANTS INC.			
Engineers 296 North Main Street East Longmeadow, MA 01028	Scientists Surveyors		
PROJECT NO. 94-1215	SCALE AS NOTED		
DATE APRIL 1999	DRAWN BY EDM		
	CHECKED BY TEJ		
Plan / Profile Sta. 22+00 to 28+00 Godfrey Brook Diversion Culvert Godfrey Brook Flood Mitigation Project Milford, Massachusetts			
NO.	DATE	REVISION	BY
2	10/01	ISSUED AS RECORD PRINT	EDM
1	8/12/99	ISSUED FOR BIDDING	TEJ

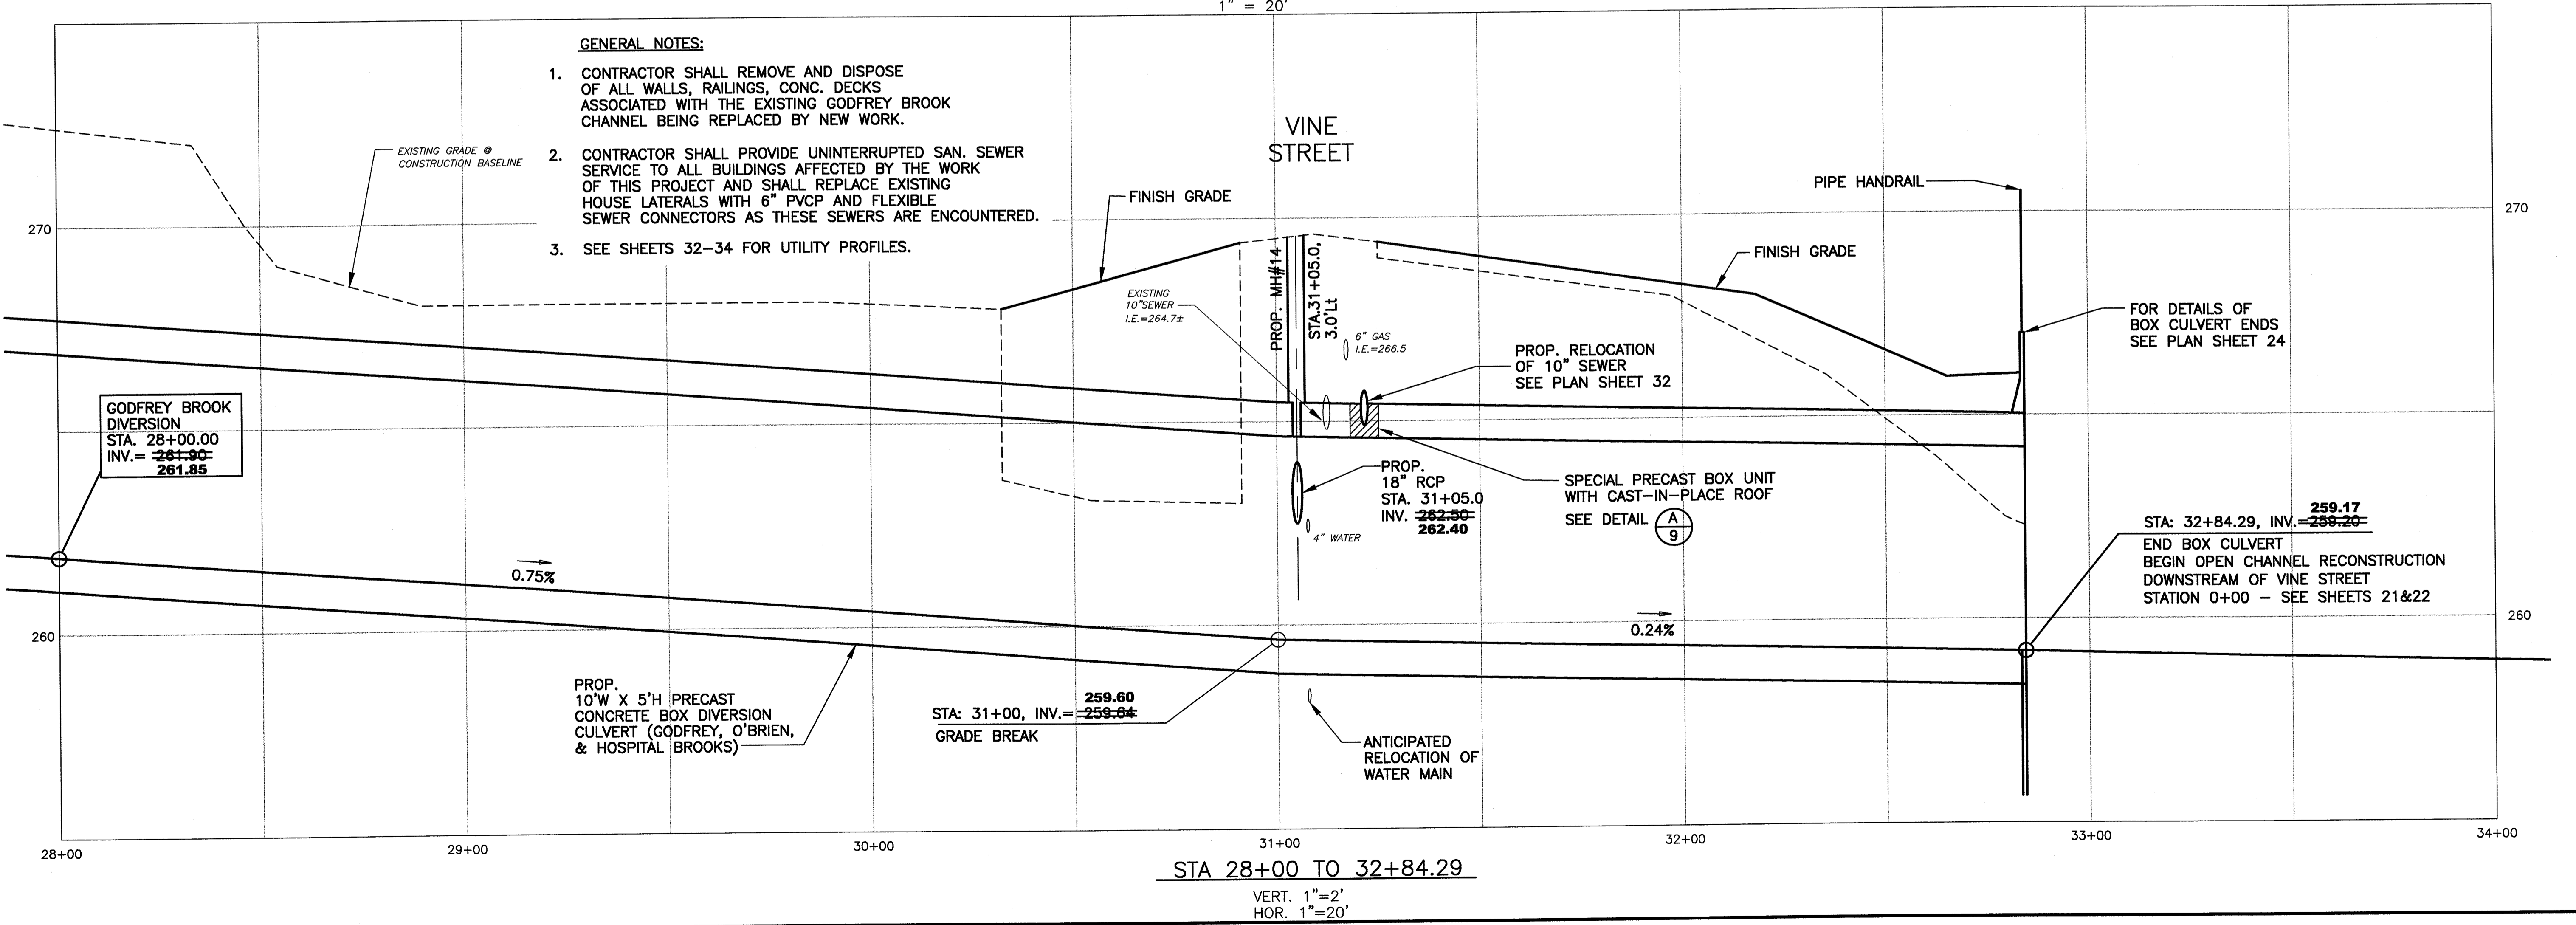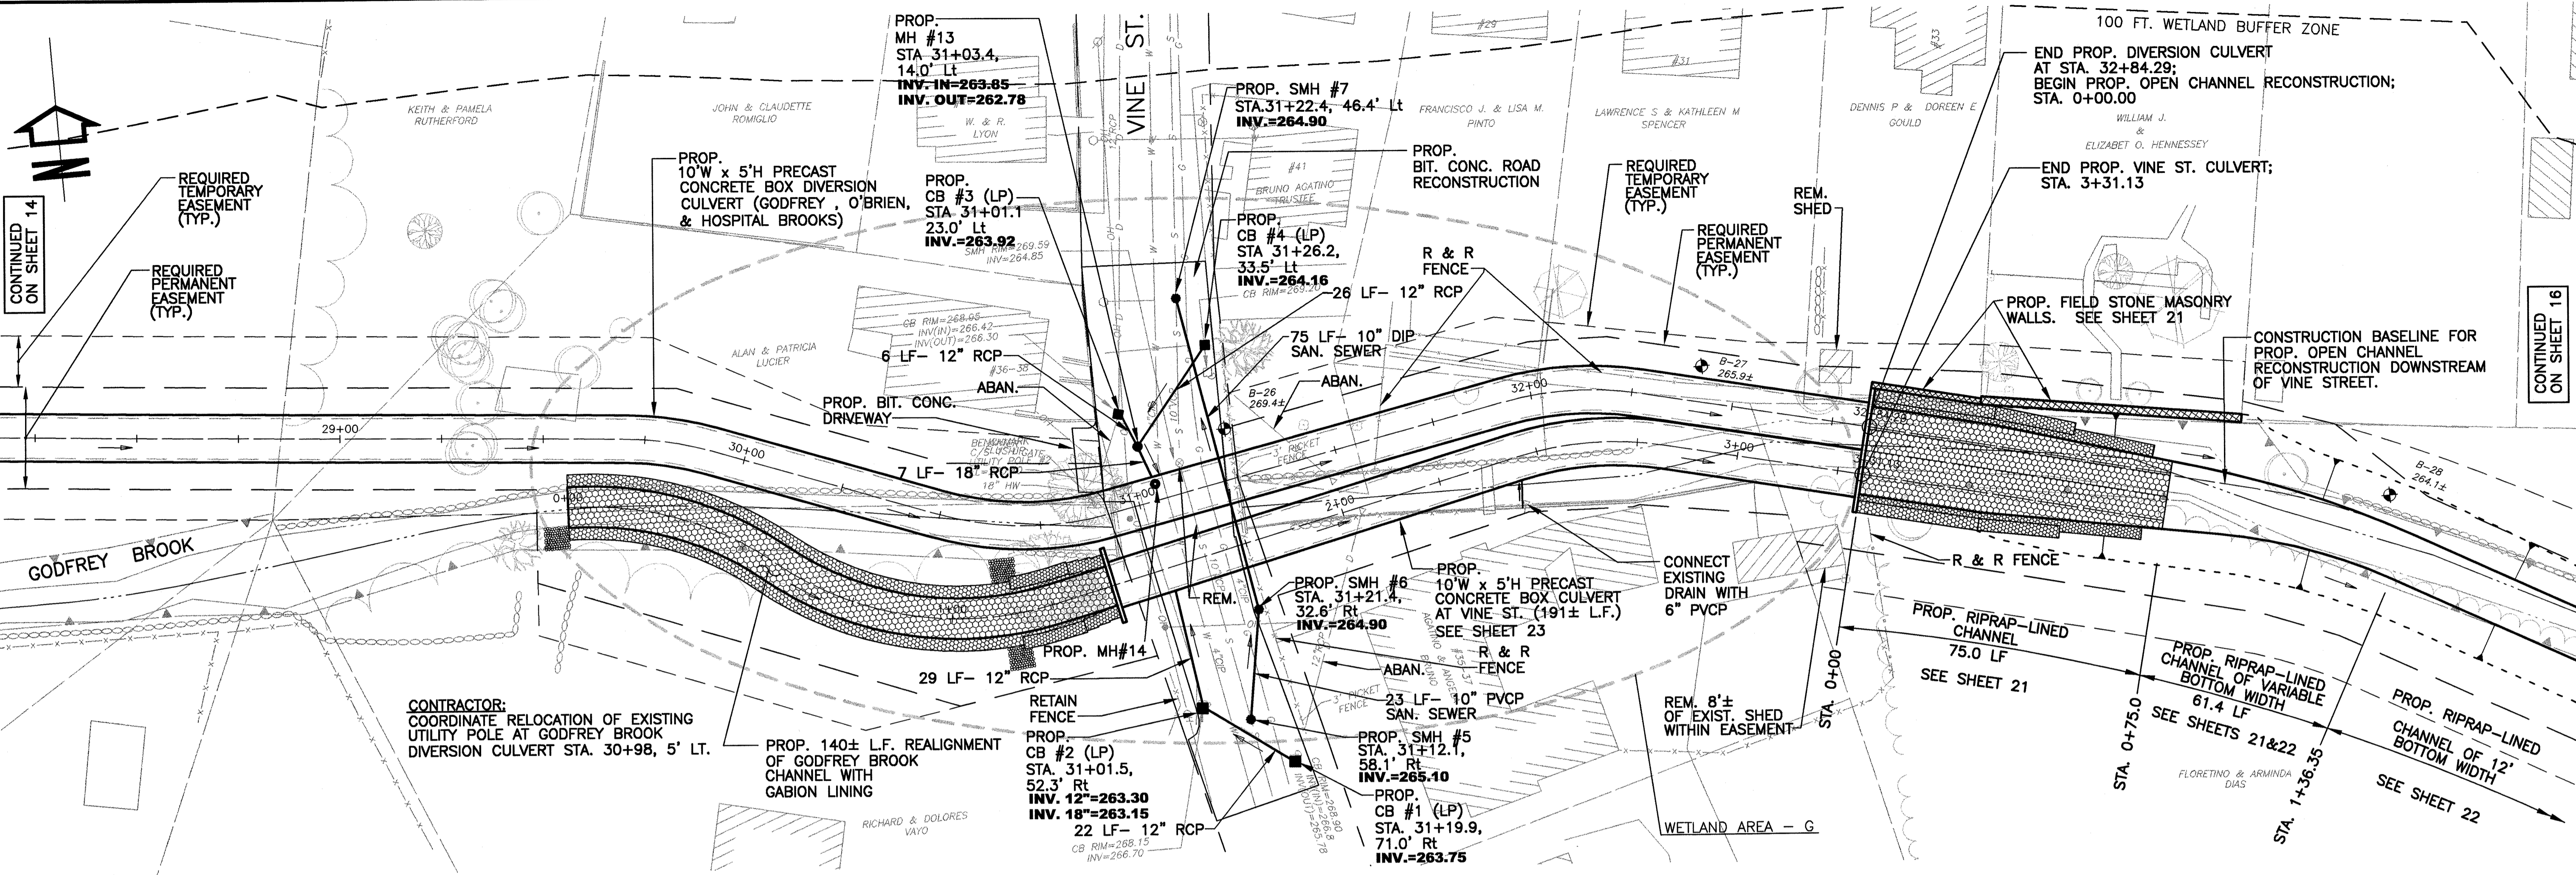

AutoCAD File: P:\AUTOCAD\ADMIN\941215\RECORD DRAWINGS\Sheet 12.13.14.15.23.dwg Plotted at: Thu Oct 04 08:55:11 2001
 BEC, INC.

DRAWING NO. **15** OF **35** SHEETS

BAYSTATE ENVIRONMENTAL CONSULTANTS INC.

Engineers
296 North Main Street
Milford, MA 01828


Scientists
East Longmeadow, MA 01028

Surveyors
East Longmeadow, MA 01028


PROJECT NO. 94-1215
 SCALE AS NOTED
 DATE APRIL 1999
 DRAWN BY EDM
 CHECKED BY TEJ

Plan / Profile
 Sta. 28+00 to 32+84.29
 Godfrey Brook Flood Mitigation Project
 Milford, Massachusetts

NO.	DATE	REVISION
2	10/10/01	ISSUED AS RECORD PRINT
1	8/12/99	ISSUED FOR BIDDING

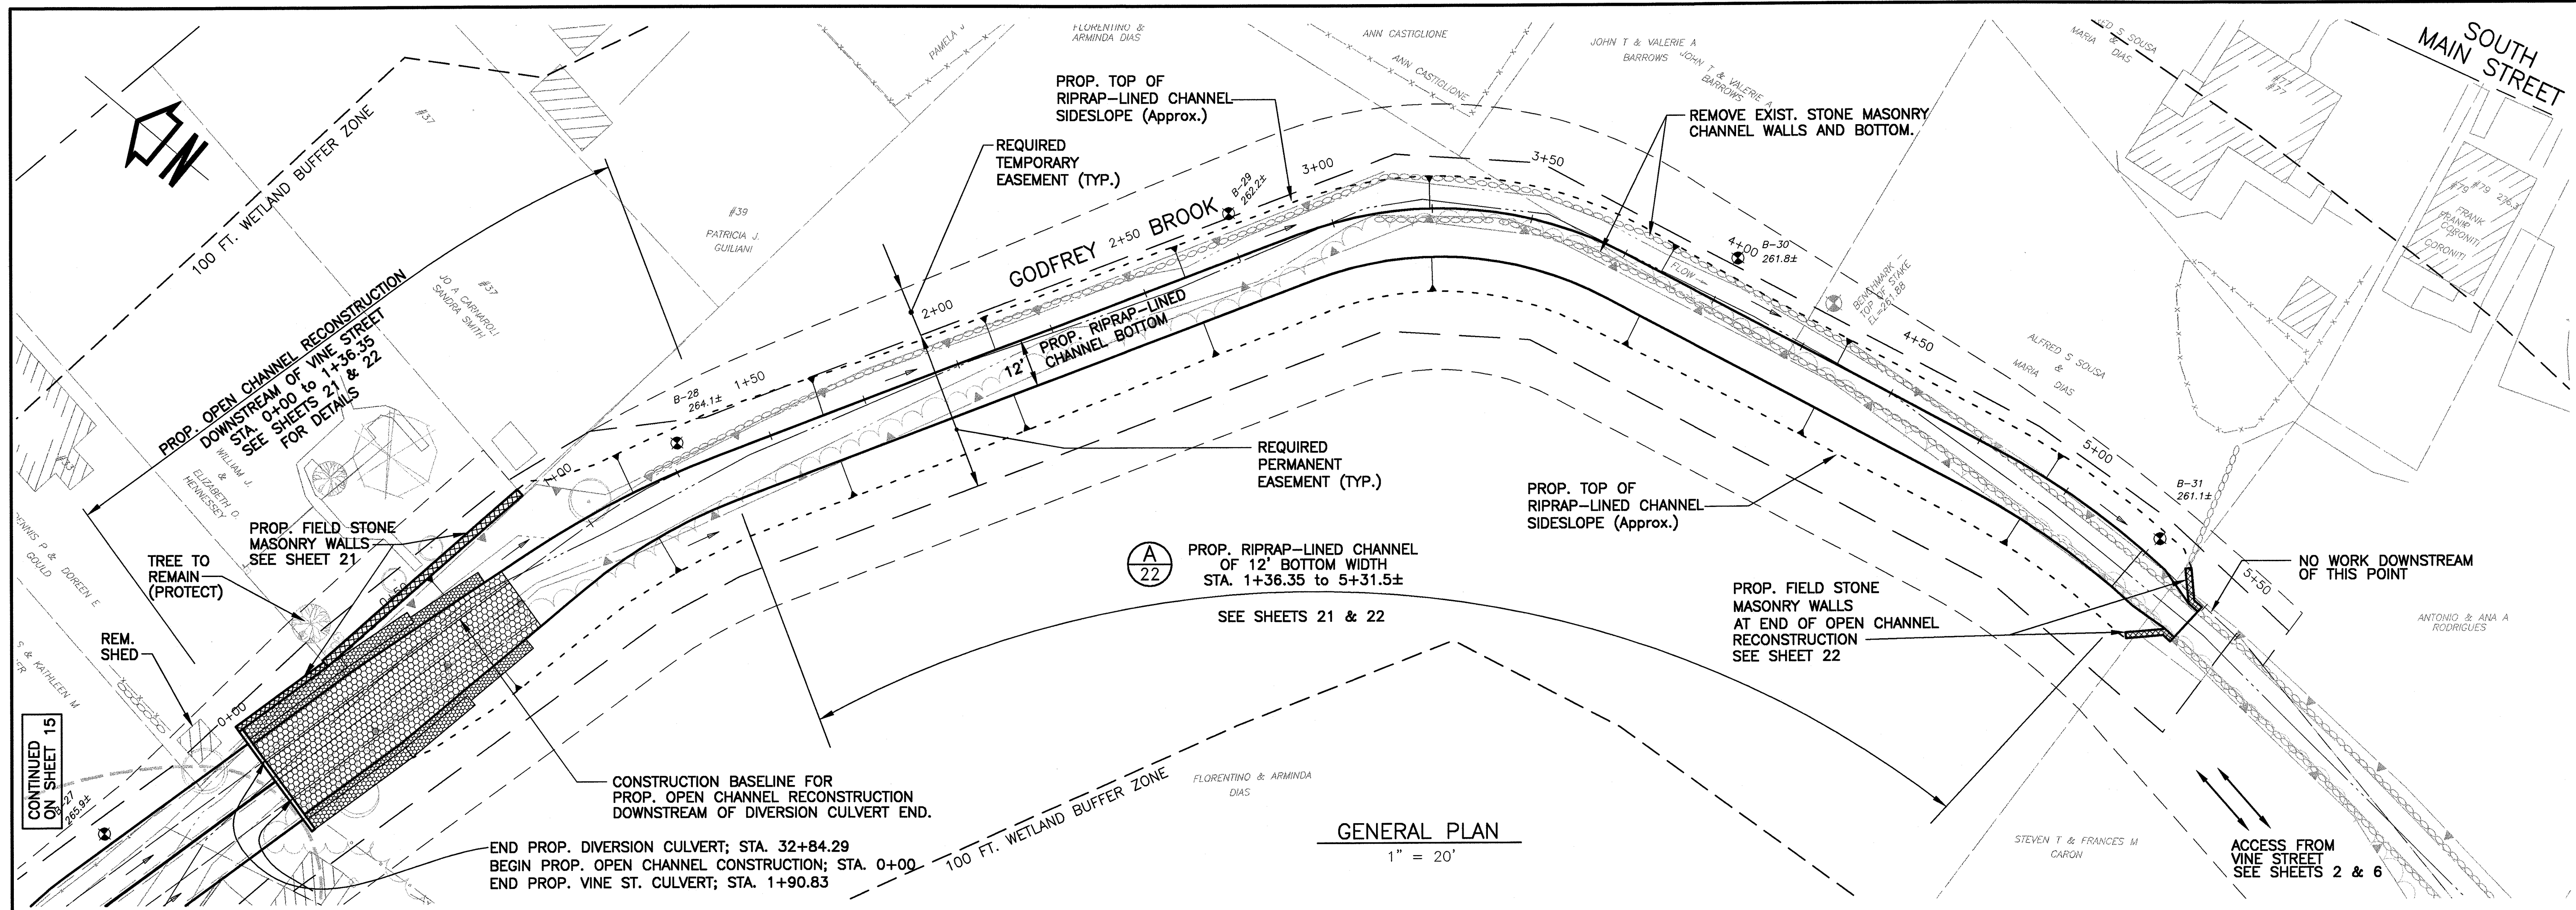

GENERAL PLAN
1" = 20'

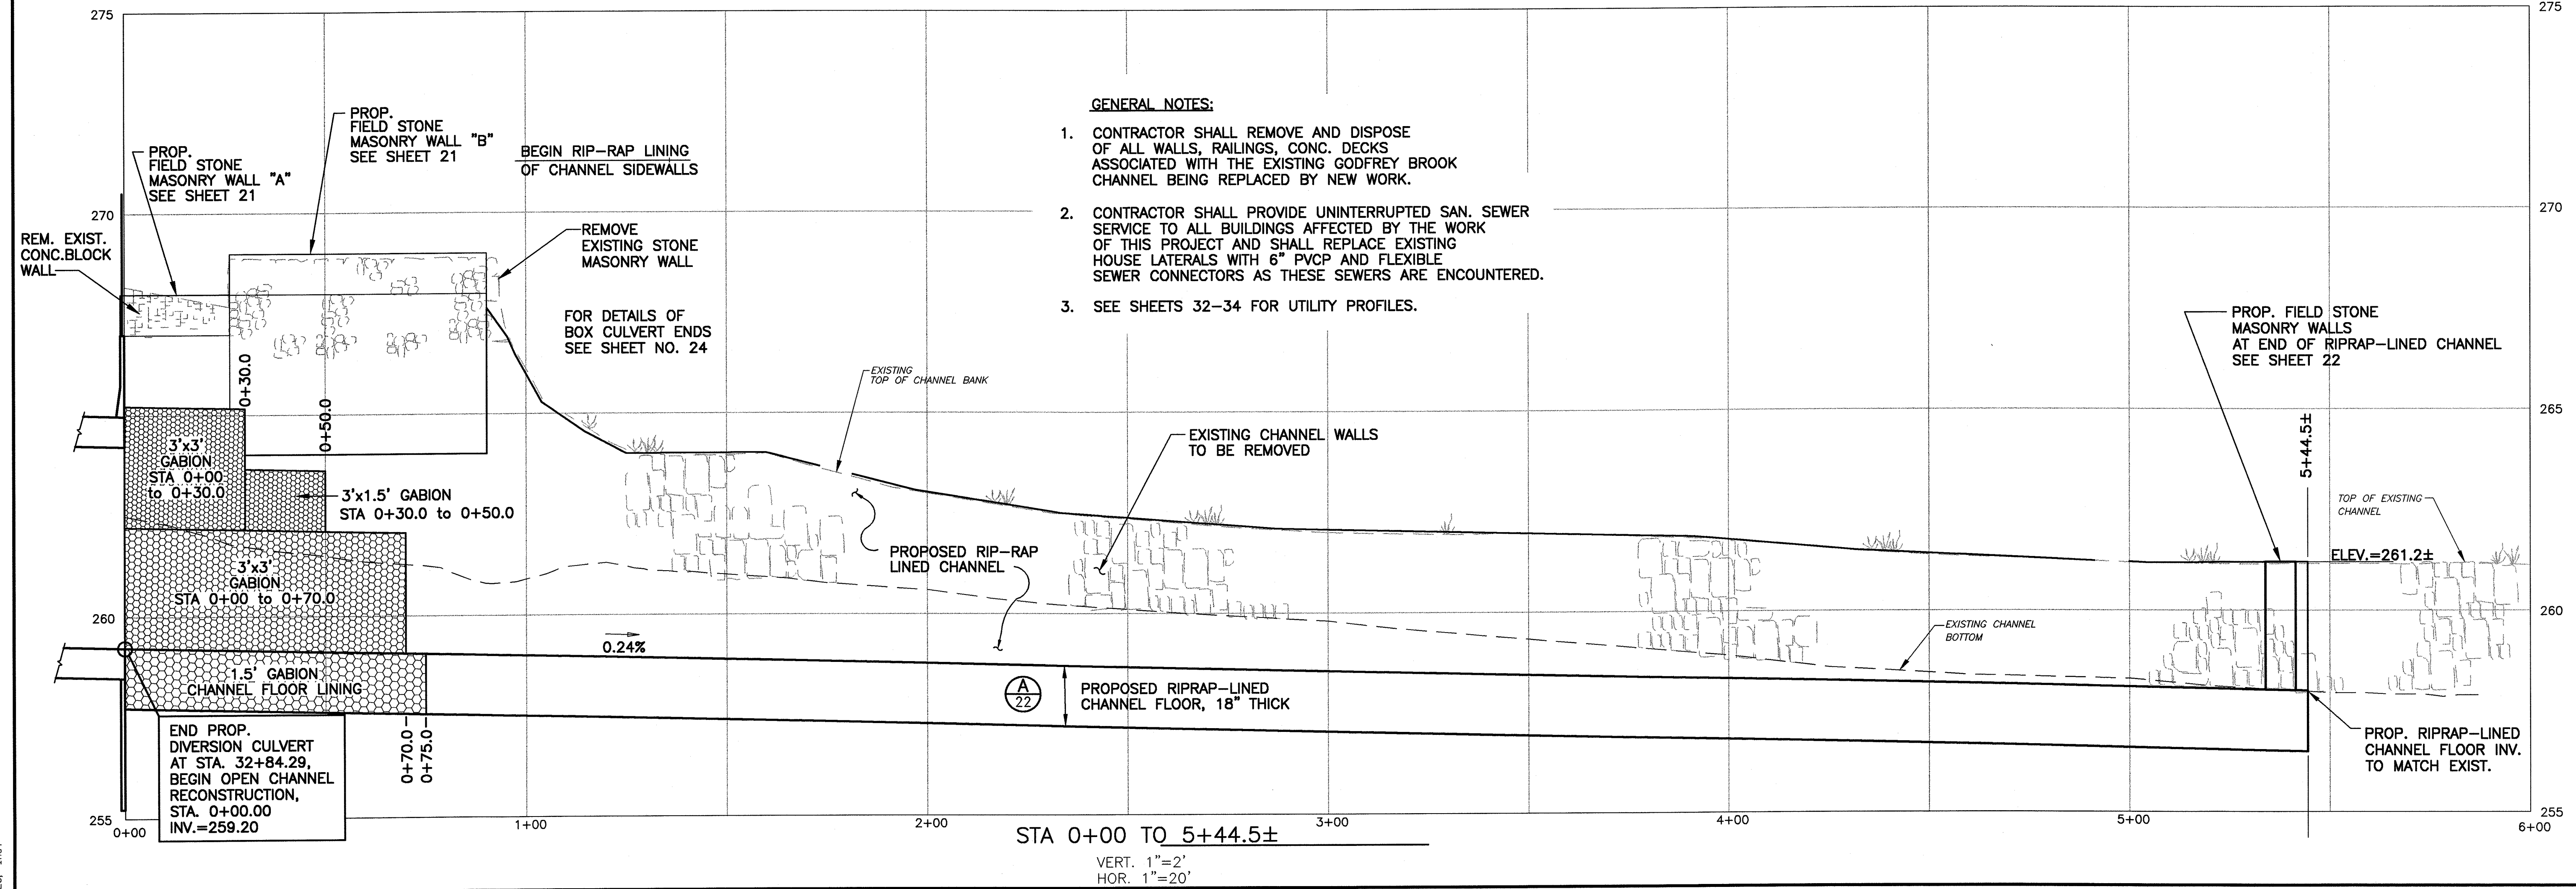


- GENERAL NOTES:
1. CONTRACTOR SHALL REMOVE AND DISPOSE OF ALL WALLS, RAILINGS, CONC. DECKS ASSOCIATED WITH THE EXISTING GODFREY BROOK CHANNEL BEING REPLACED BY NEW WORK.
 2. CONTRACTOR SHALL PROVIDE UNINTERRUPTED SAN. SEWER SERVICE TO ALL BUILDINGS AFFECTED BY THE WORK OF THIS PROJECT AND SHALL REPLACE EXISTING HOUSE LATERALS WITH 6" PVC AND FLEXIBLE SEWER CONNECTORS AS THESE SEWERS ARE ENCOUNTERED.
 3. SEE SHEETS 32-34 FOR UTILITY PROFILES.

STA 0+00 TO 5+44.5±
VERT. 1"=2'
HOR. 1"=20'

AutoCAD File: P:\AUTOCAD\ADMIN\941215\RECORD DRAWINGS\Sheet 16 17 18 22 34.dwg Plotted at: Tue Oct 02 06:08:31 2001
BEC, Inc.

16 of 35 SHEETS	
BAYSTATE ENVIRONMENTAL CONSULTANTS INC.	
Engineers 296 North Main Street East Longmeadow, MA 01028	Scientists East Longmeadow, MA 01028
Surveyors	
PROJECT NO. 94-1215	SCALE AS NOTED
DATE APRIL 1999	DRAWN BY EDM
CHECKED BY TEJ	BY
SHEET TITLE: Plan / Profile of Sta. 0+00 to 5+44.5± Open Channel Reconstruction Downstream of Vine Street	
PROJECT: Godfrey Brook Flood Mitigation Project Milford, Massachusetts	
NO. 2	DATE 10/01
1	8/12/99
ISSUED AS RECORD PRINT	ISSUED FOR BIDDING
REVISION	BY

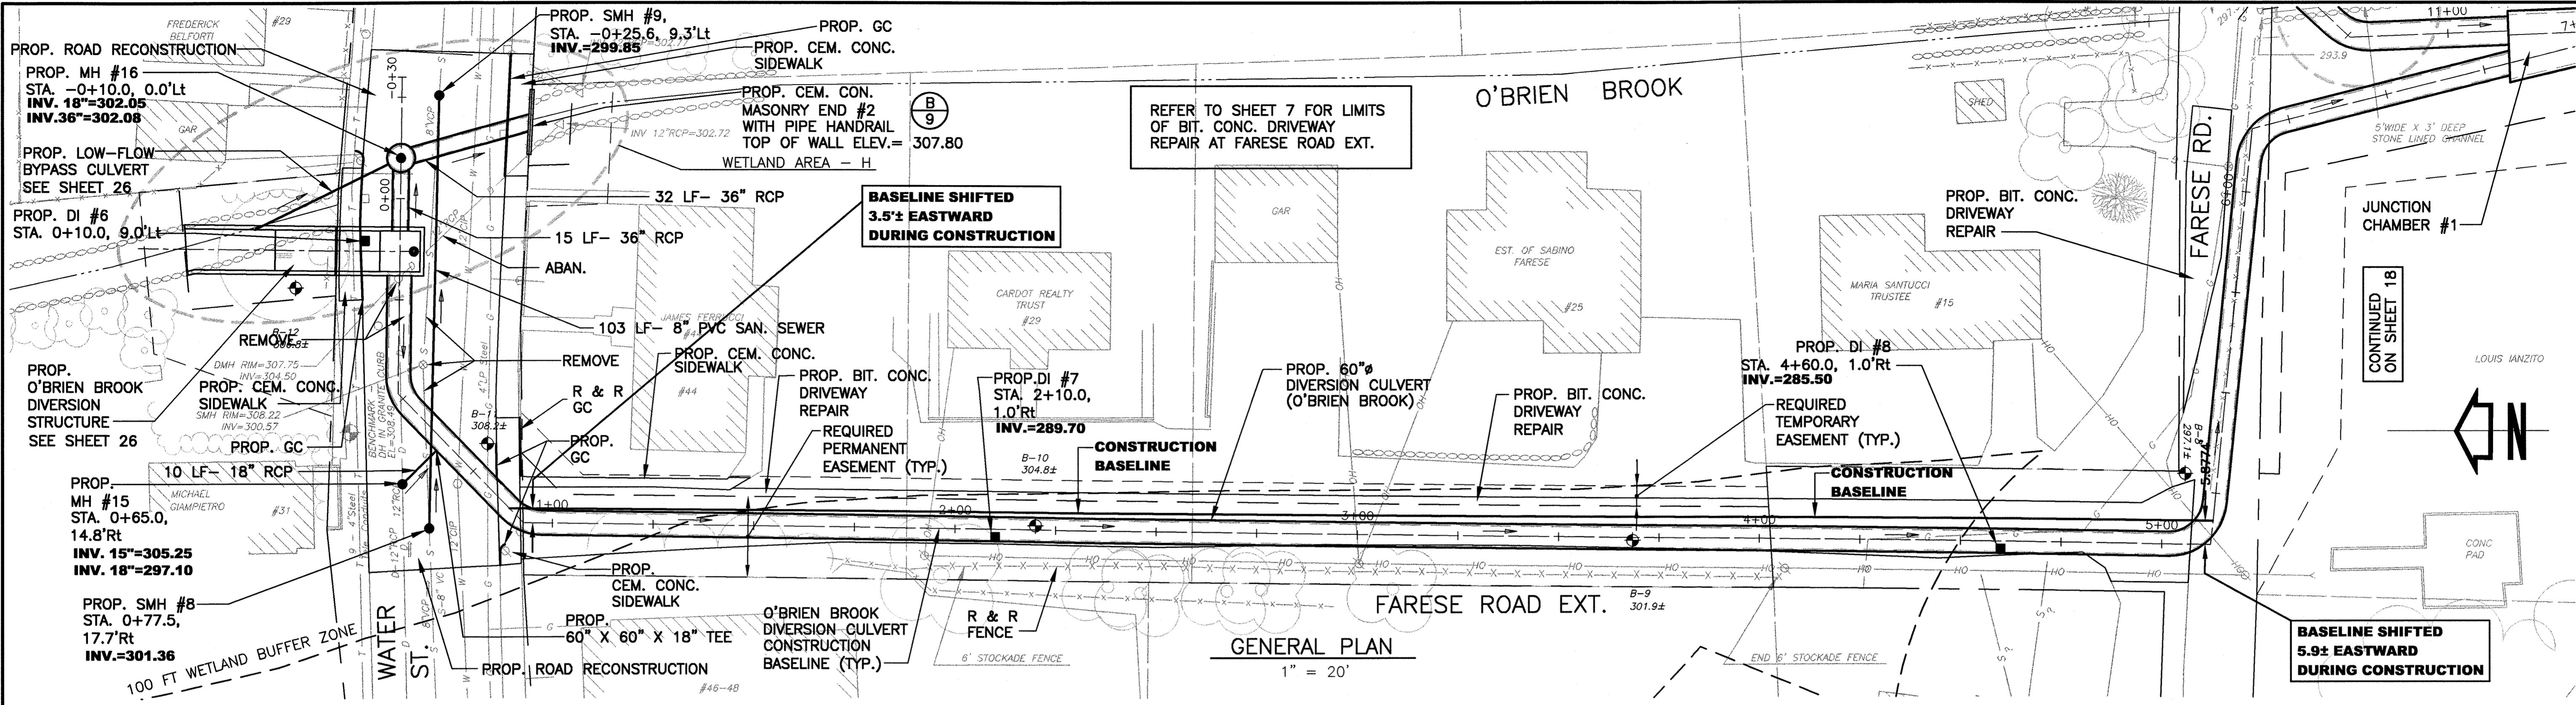

REFER TO SHEET 7 FOR LIMITS OF BIT. CONC. DRIVEWAY REPAIR AT FARESE ROAD EXT.


BASELINE SHIFTED 3.5'± EASTWARD DURING CONSTRUCTION

CONSTRUCTION BASELINE

CONSTRUCTION BASELINE

BASELINE SHIFTED 5.9'± EASTWARD DURING CONSTRUCTION

GENERAL PLAN
1" = 20'

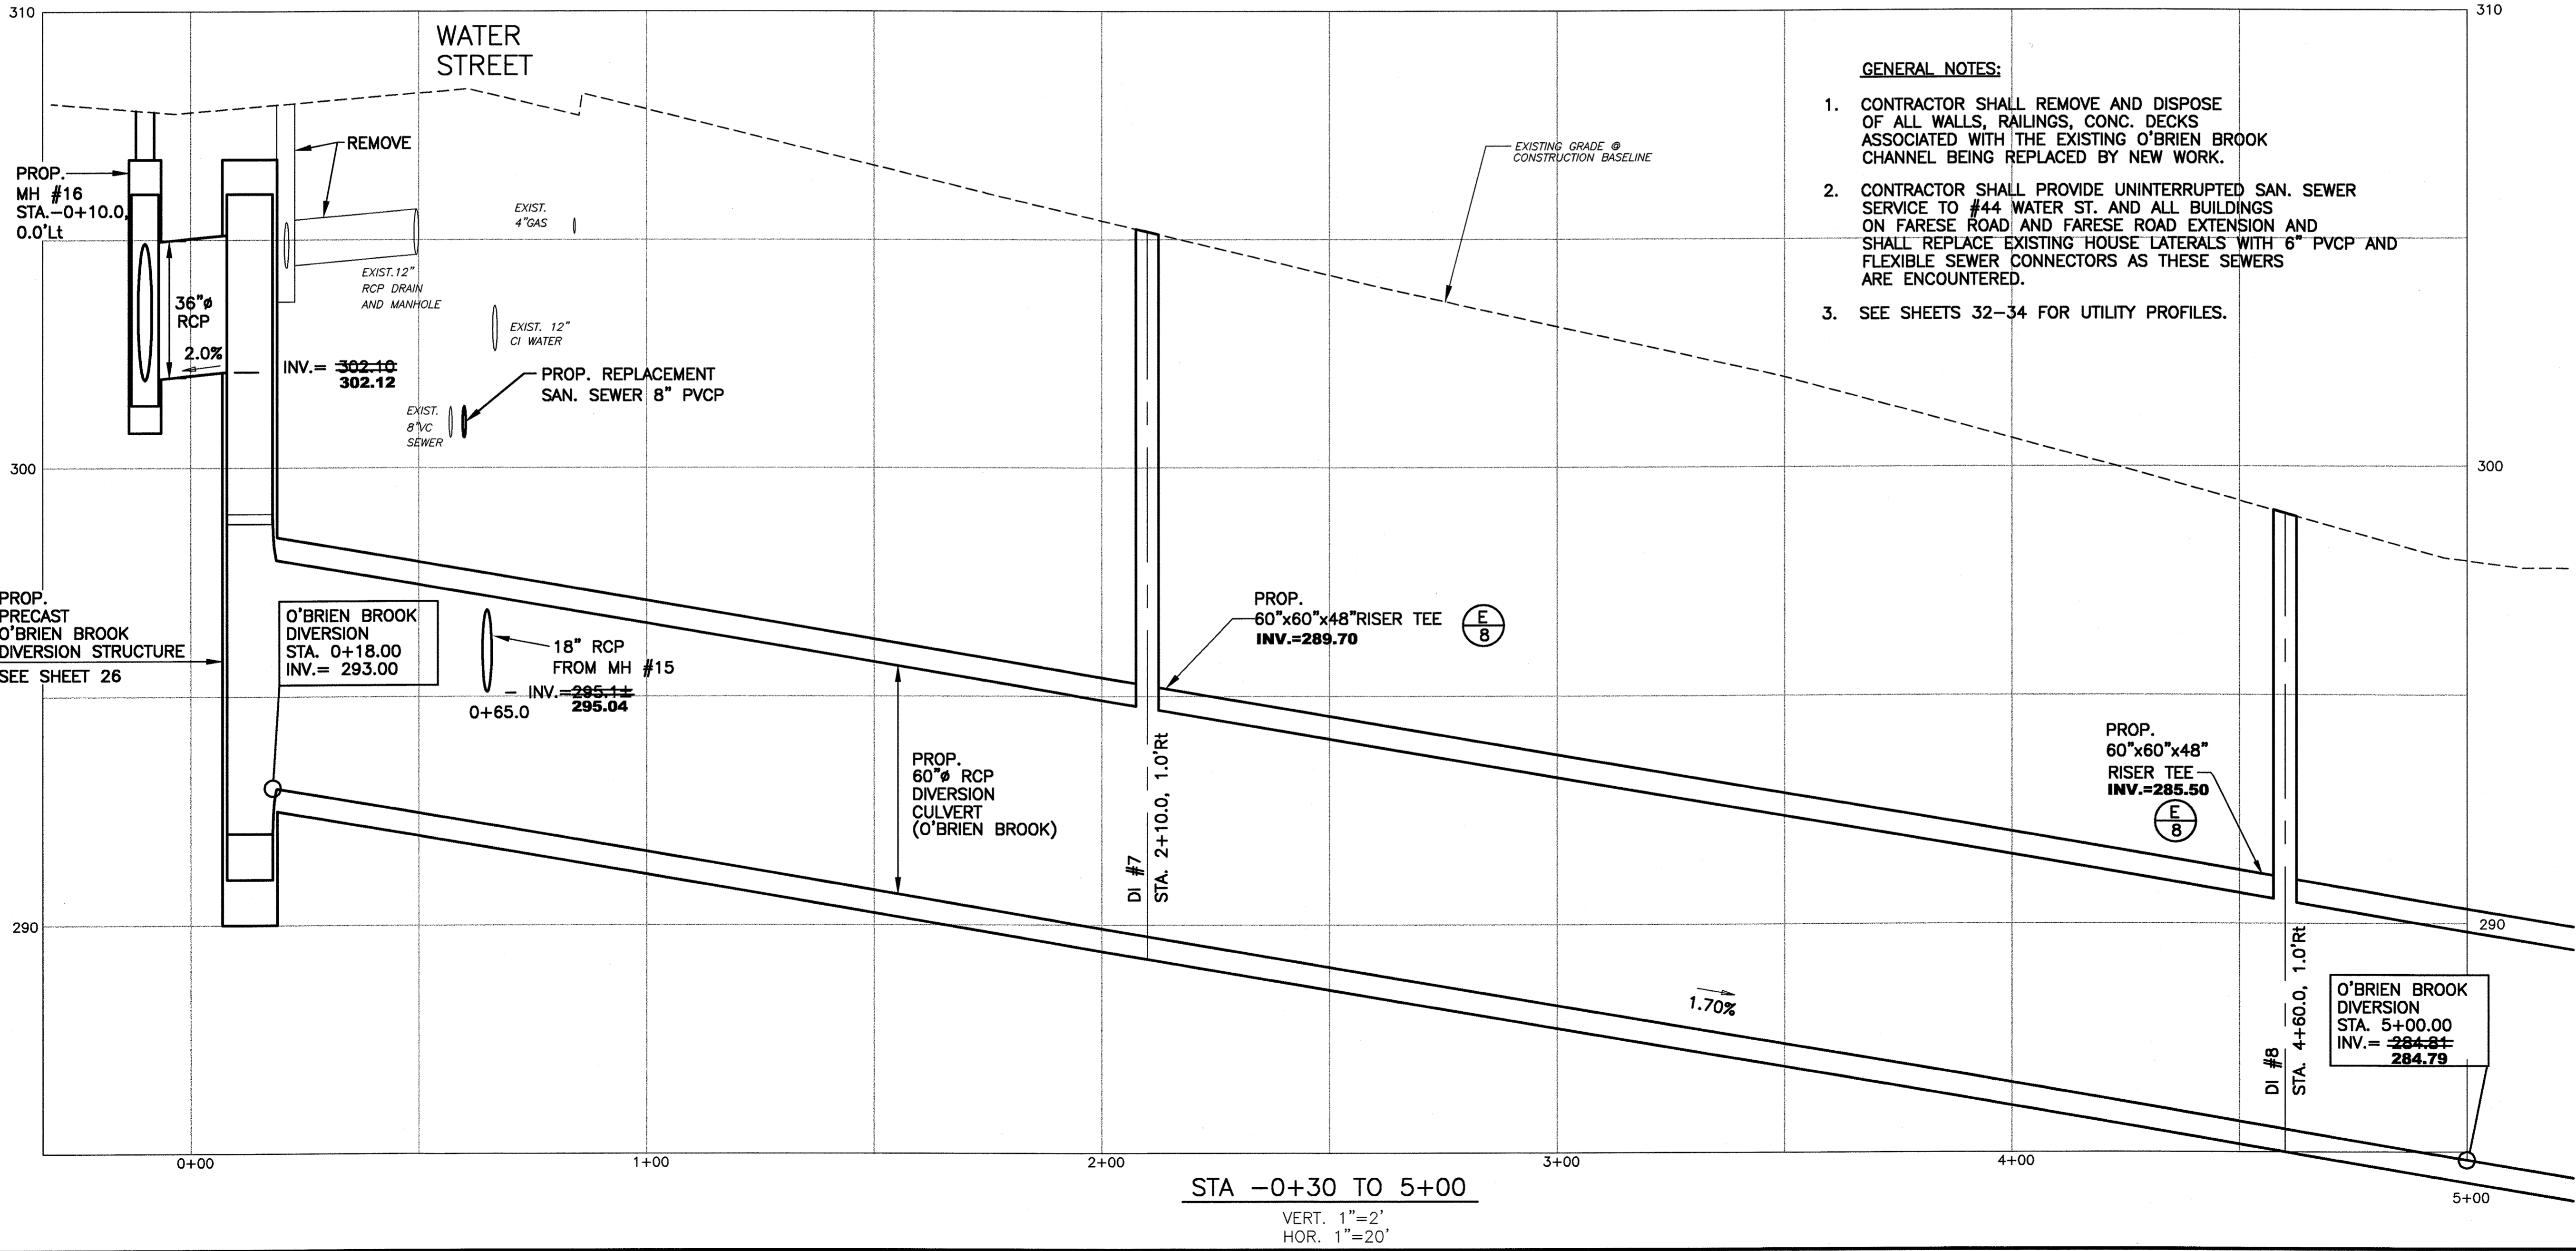


- GENERAL NOTES:**
1. CONTRACTOR SHALL REMOVE AND DISPOSE OF ALL WALLS, RAILINGS, CONC. DECKS ASSOCIATED WITH THE EXISTING O'BRIEN BROOK CHANNEL BEING REPLACED BY NEW WORK.
 2. CONTRACTOR SHALL PROVIDE UNINTERRUPTED SAN. SEWER SERVICE TO #44 WATER ST. AND ALL BUILDINGS ON FARESE ROAD AND FARESE ROAD EXTENSION AND SHALL REPLACE EXISTING HOUSE LATERALS WITH 6\"/>


STA -0+30 TO 5+00
VERT. 1"=2'
HOR. 1"=20'

<p>BAYSTATE ENVIRONMENTAL CONSULTANTS INC. Engineers 296 North Main Street East Longmeadow, MA 01028</p>		<p>17 OF 35 SHEETS</p>
<p>PROJECT NO. 94-1215 SCALE AS NOTED DATE APRIL 1999 DRAWN BY EDM CHECKED BY TEJ</p>		
<p>Plan / Profile Sta -0+30 to 5+00 O'Brien Brook Diversion Culvert Godfrey Brook Flood Mitigation Project Milford, Massachusetts</p>		
NO.	DATE	REVISION
2	10/01	ISSUED AS RECORD PRINT
1	8/12/99	ISSUED FOR BIDDING

AutoCAD File: P:\AUTOCAD\LDK\DWG\941215\RECORD DRAWINGS\Sheet 15 17 19 22 34.dwg Plotted at: Thu Oct 04 08:40:21 2001
BEC, Inc.

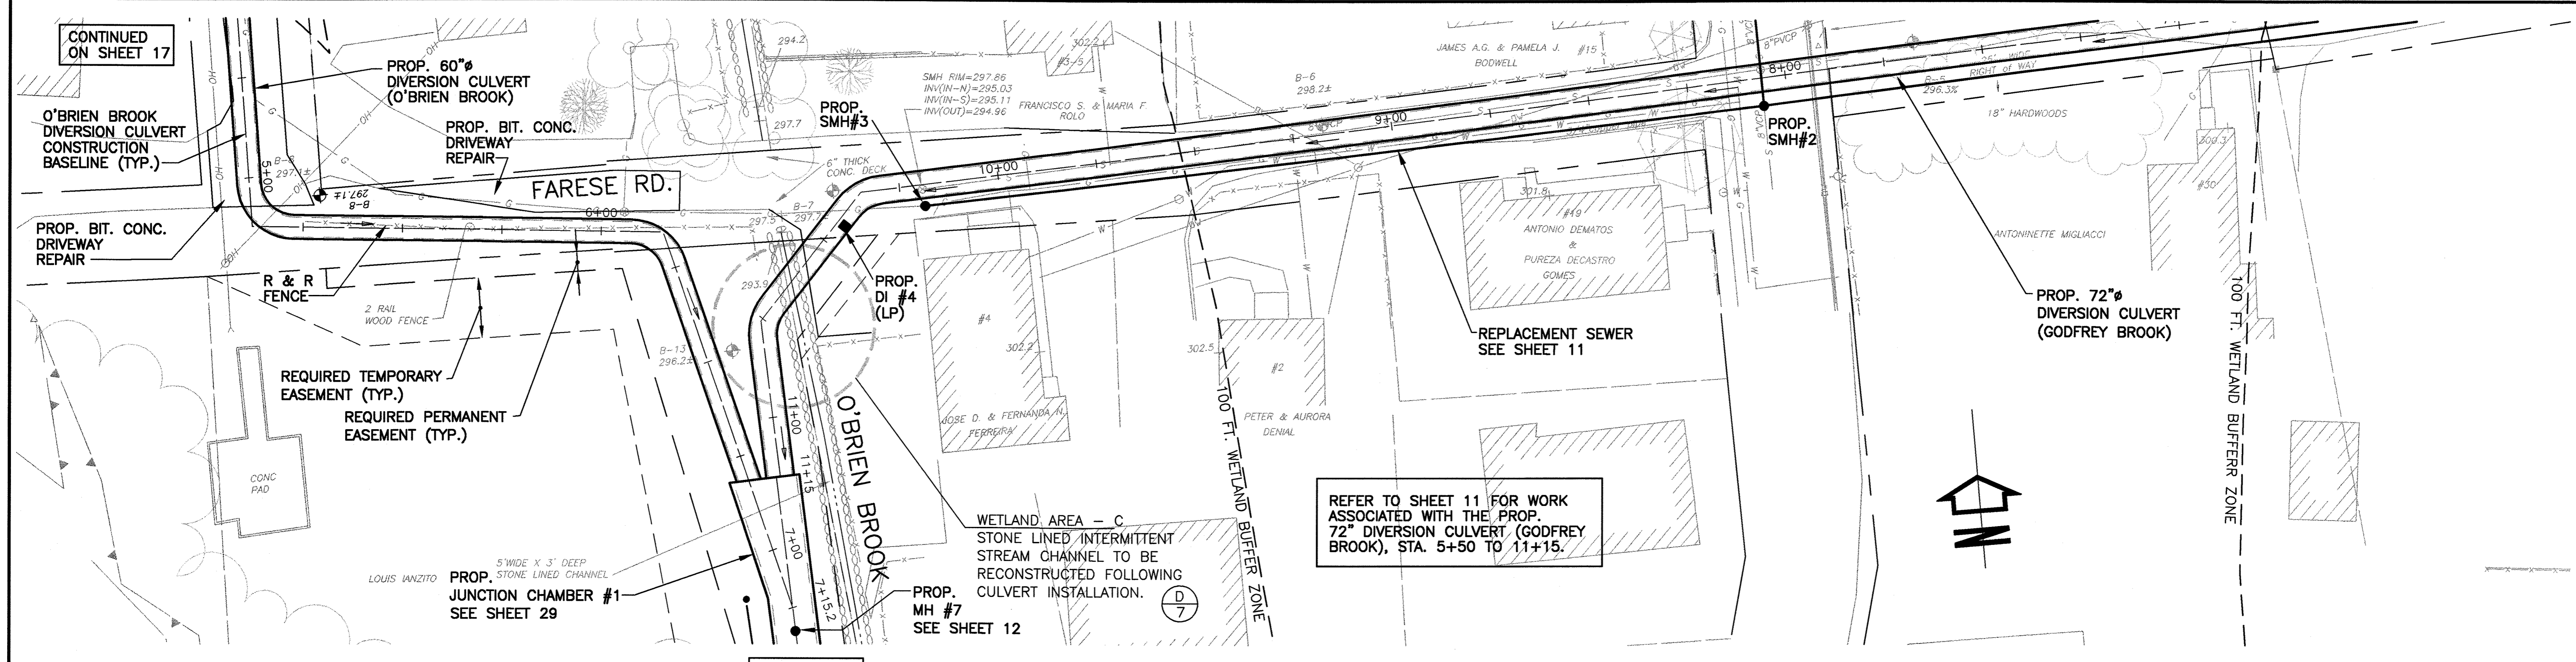


GENERAL PLAN
1" = 20'

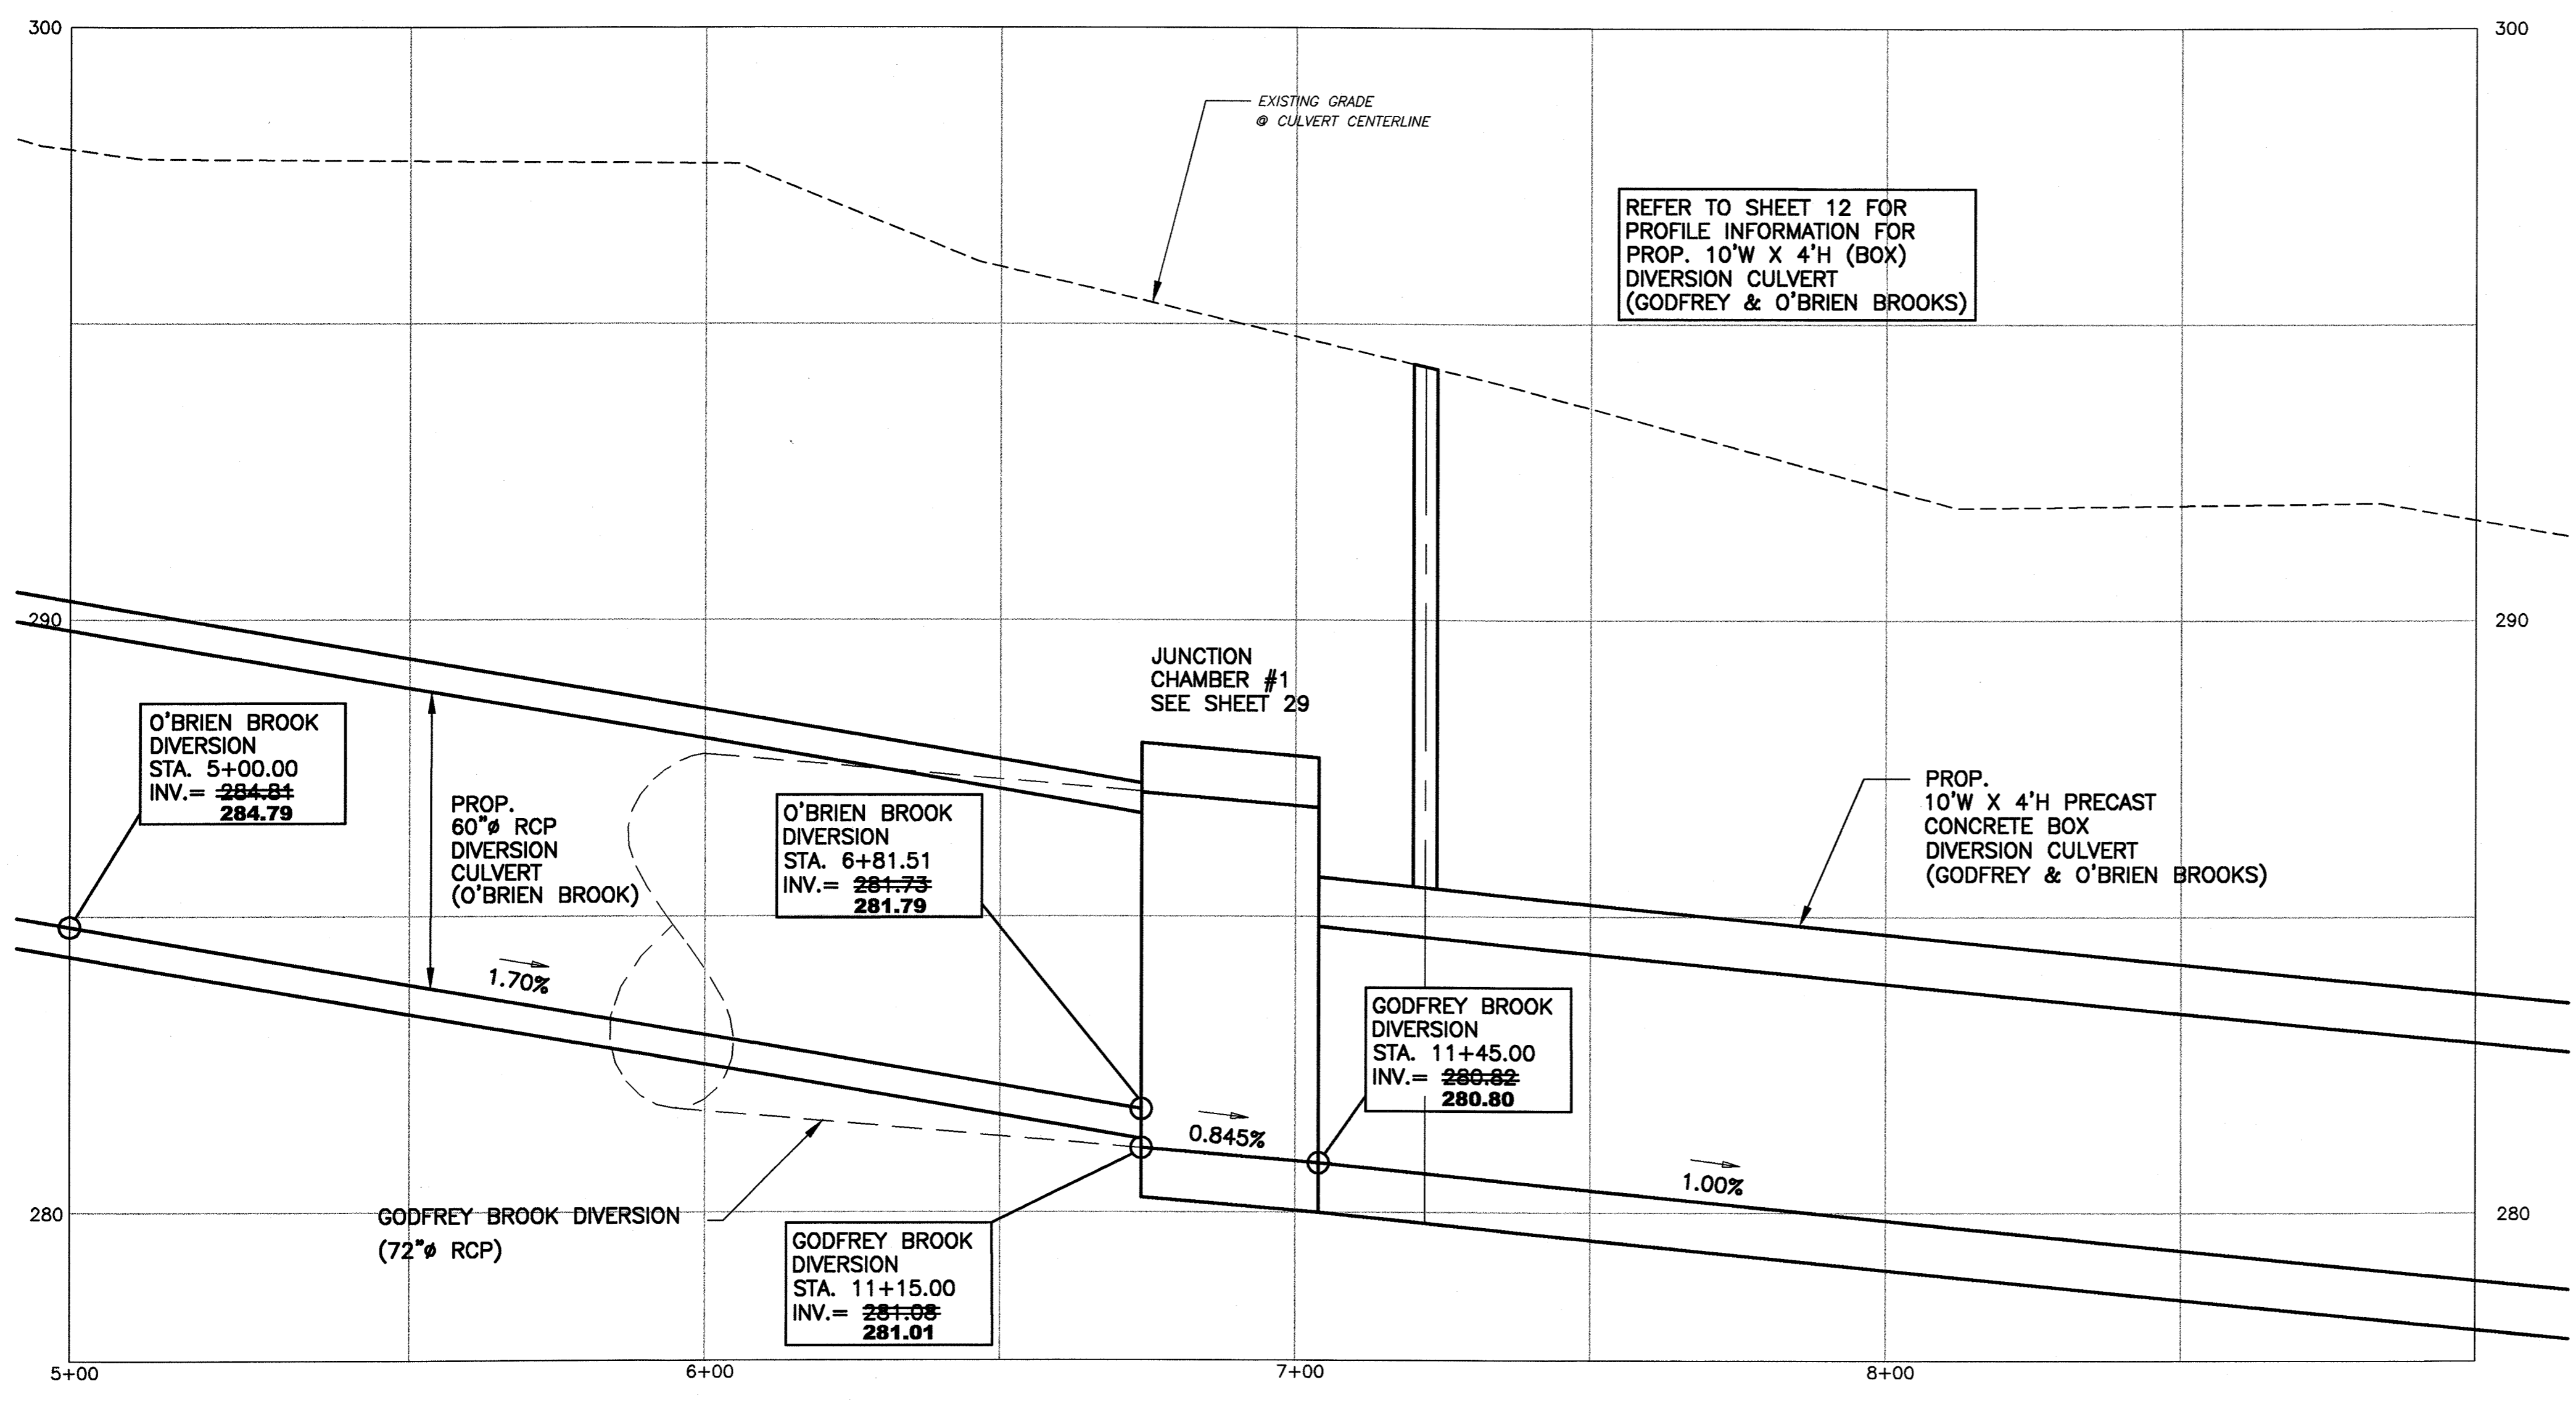

STA 5+00 TO 6+81.51
VERT. 1"=2'
HOR. 1"=20'

- GENERAL NOTES:
- CONTRACTOR SHALL REMOVE AND DISPOSE OF ALL WALLS, RAILINGS, CONC. DECKS ASSOCIATED WITH THE EXISTING GODFREY BROOK CHANNEL BEING REPLACED BY NEW WORK.
 - CONTRACTOR SHALL PROVIDE UNINTERRUPTED SAN. SEWER SERVICE TO ALL BUILDINGS AFFECTED BY THE WORK OF THIS PROJECT AND SHALL REPLACE EXISTING HOUSE LATERALS WITH 6" PVC AND FLEXIBLE SEWER CONNECTORS AS THESE SEWERS ARE ENCOUNTERED.
 - SEE SHEETS 32-34 FOR UTILITY PROFILES.

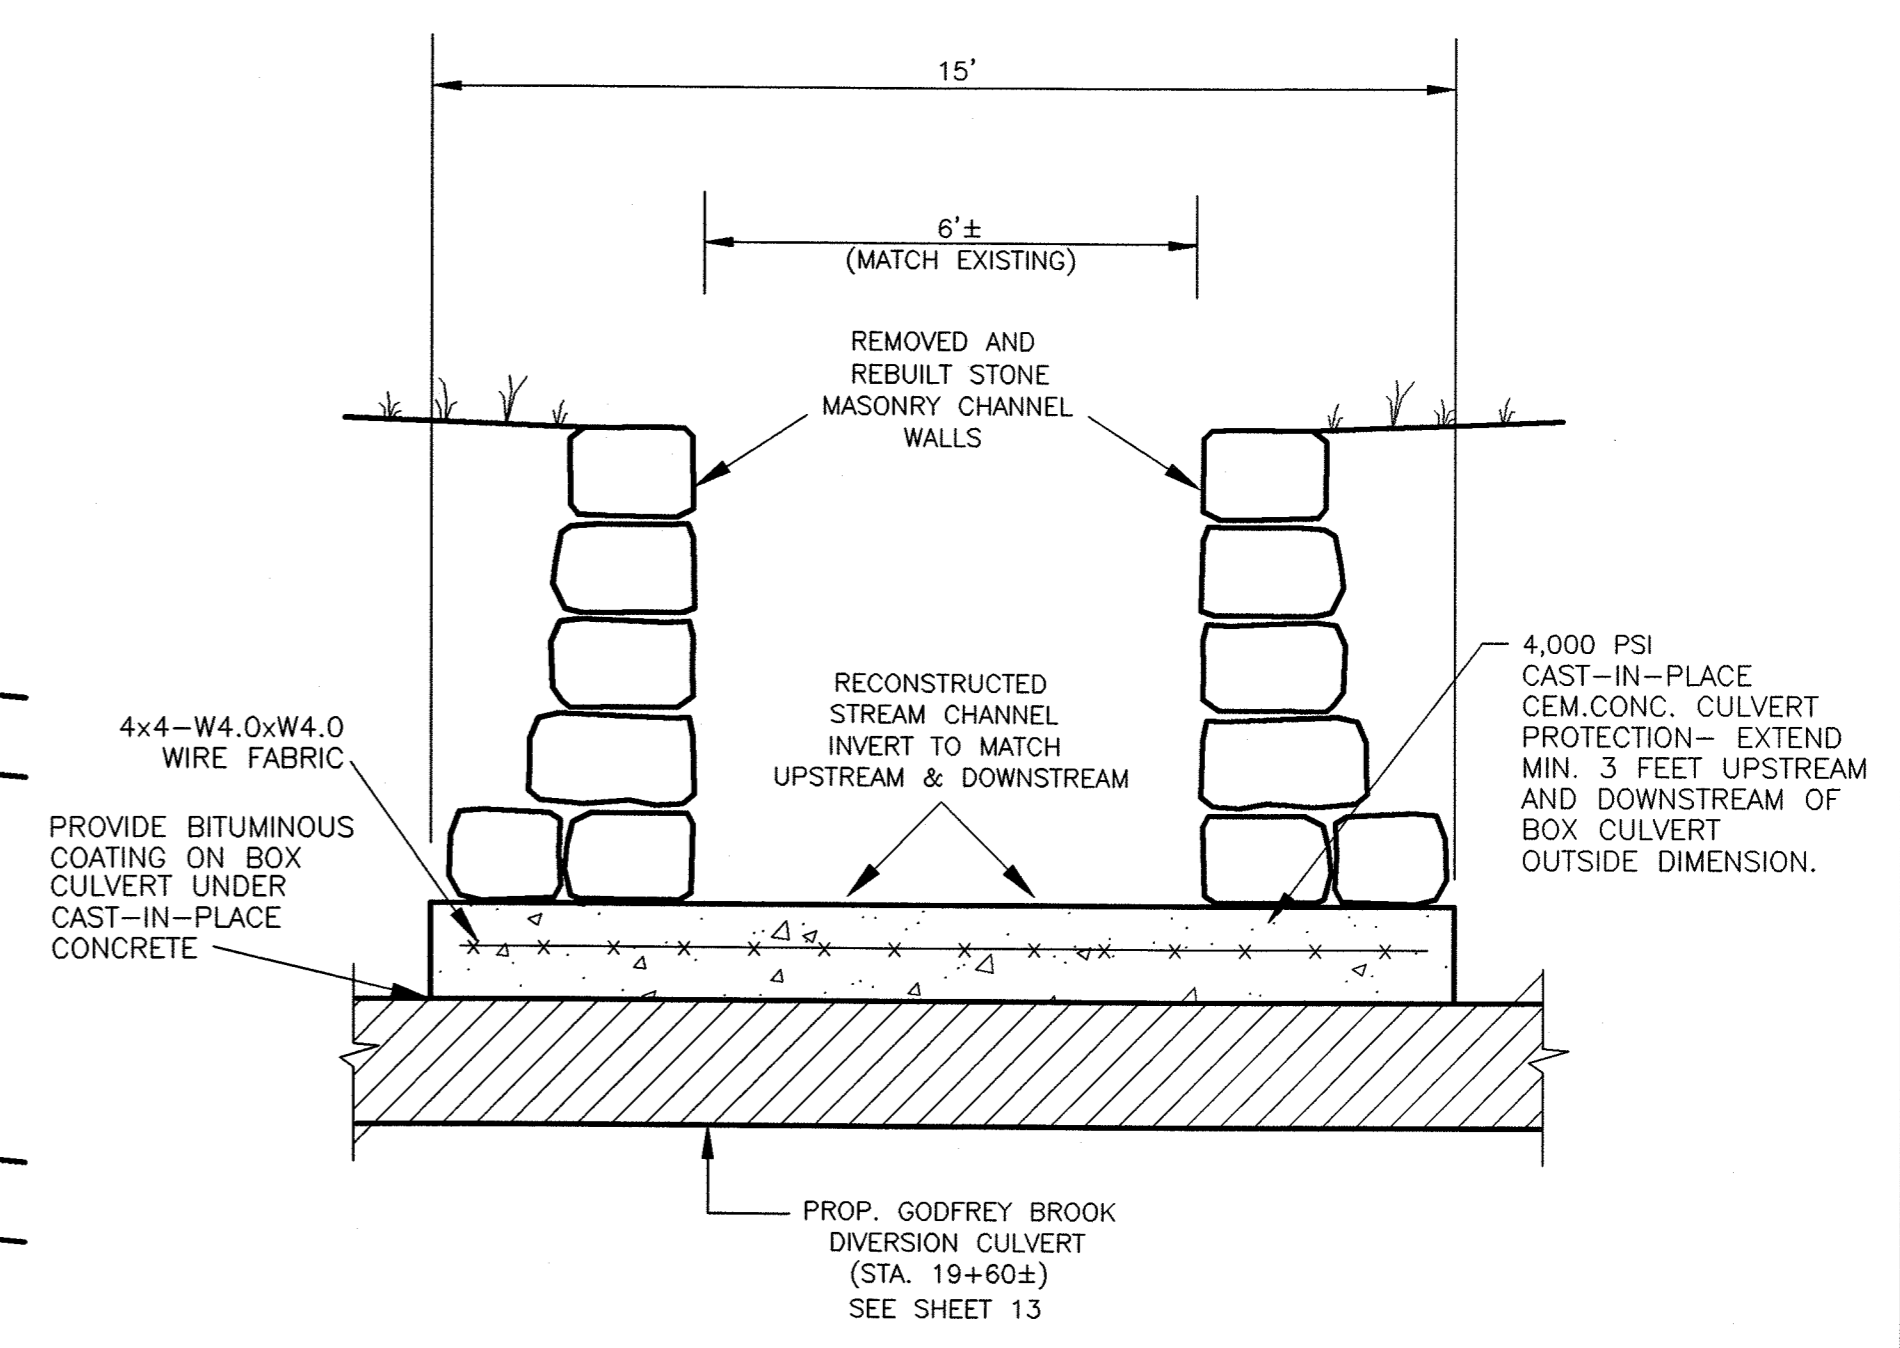

A
18 CEM. CONC. CULVERT PROTECTION
NTS

AutoCAD File: P:\AUTOCAD\ADMIN\941215\RECORD DRAWINGS\Sheet 15 17 18 22 34.dwg Plotted at: Tue Oct 02 08:33:59 2001
BEC, Inc.

18 of 35 SHEETS

BAYSTATE ENVIRONMENTAL CONSULTANTS INC.
Scientists
Surveyors
Engineers
296 North Main Street
East Longmeadow, MA 01028




DEC

PROJECT NO. 94-1215
SCALE AS NOTED
DATE APRIL 1999
DRAWN BY EDM
CHECKED BY TEJ

Plan / Profile
Sta. 5+00 to 6+81.51
O'Brien Brook Diversion Culvert
Godfrey Brook Flood Mitigation Project
Milford, Massachusetts


NO.	DATE	REVISION
1	5/12/99	ISSUED FOR BIDDING
2	10/01	ISSUED AS RECORD PRINT

AutoCAD File: P:\AUTOCAD\WORK\1941215\RECORD DRAWINGS\Sheet 19.dwg Plotted at: Tue Oct 02 08:52:07 2001
BEC, Inc.

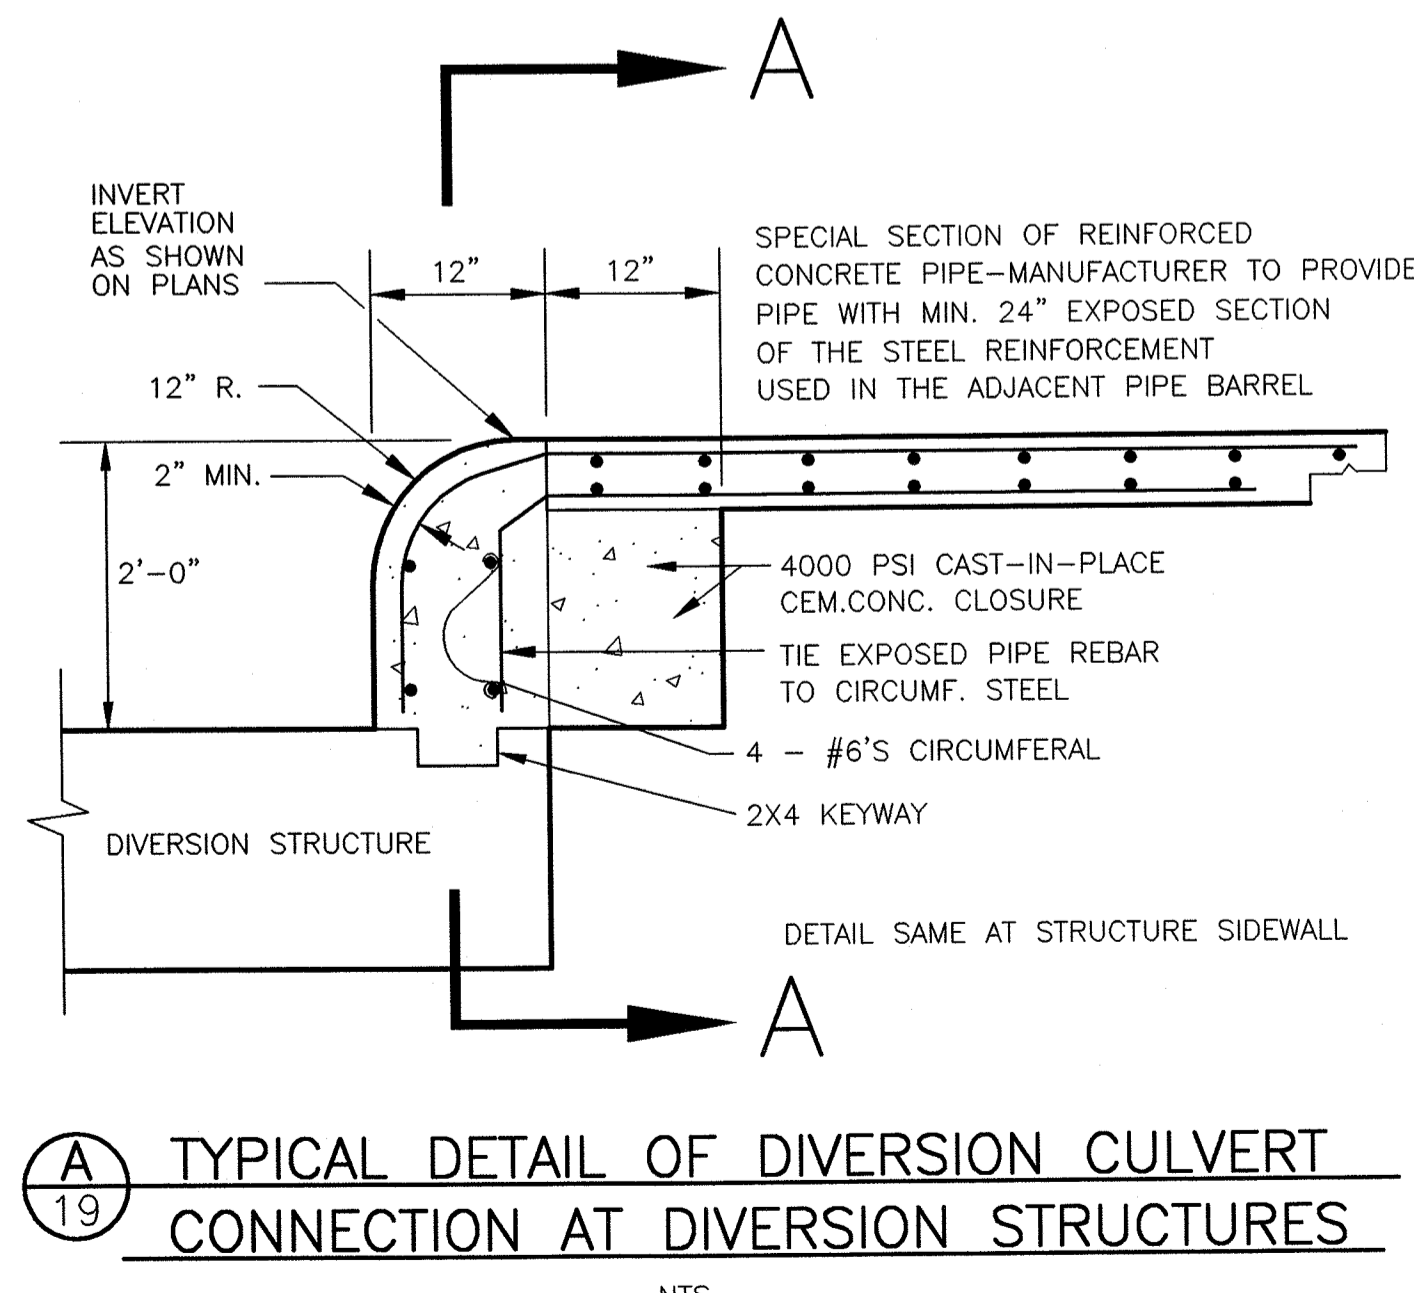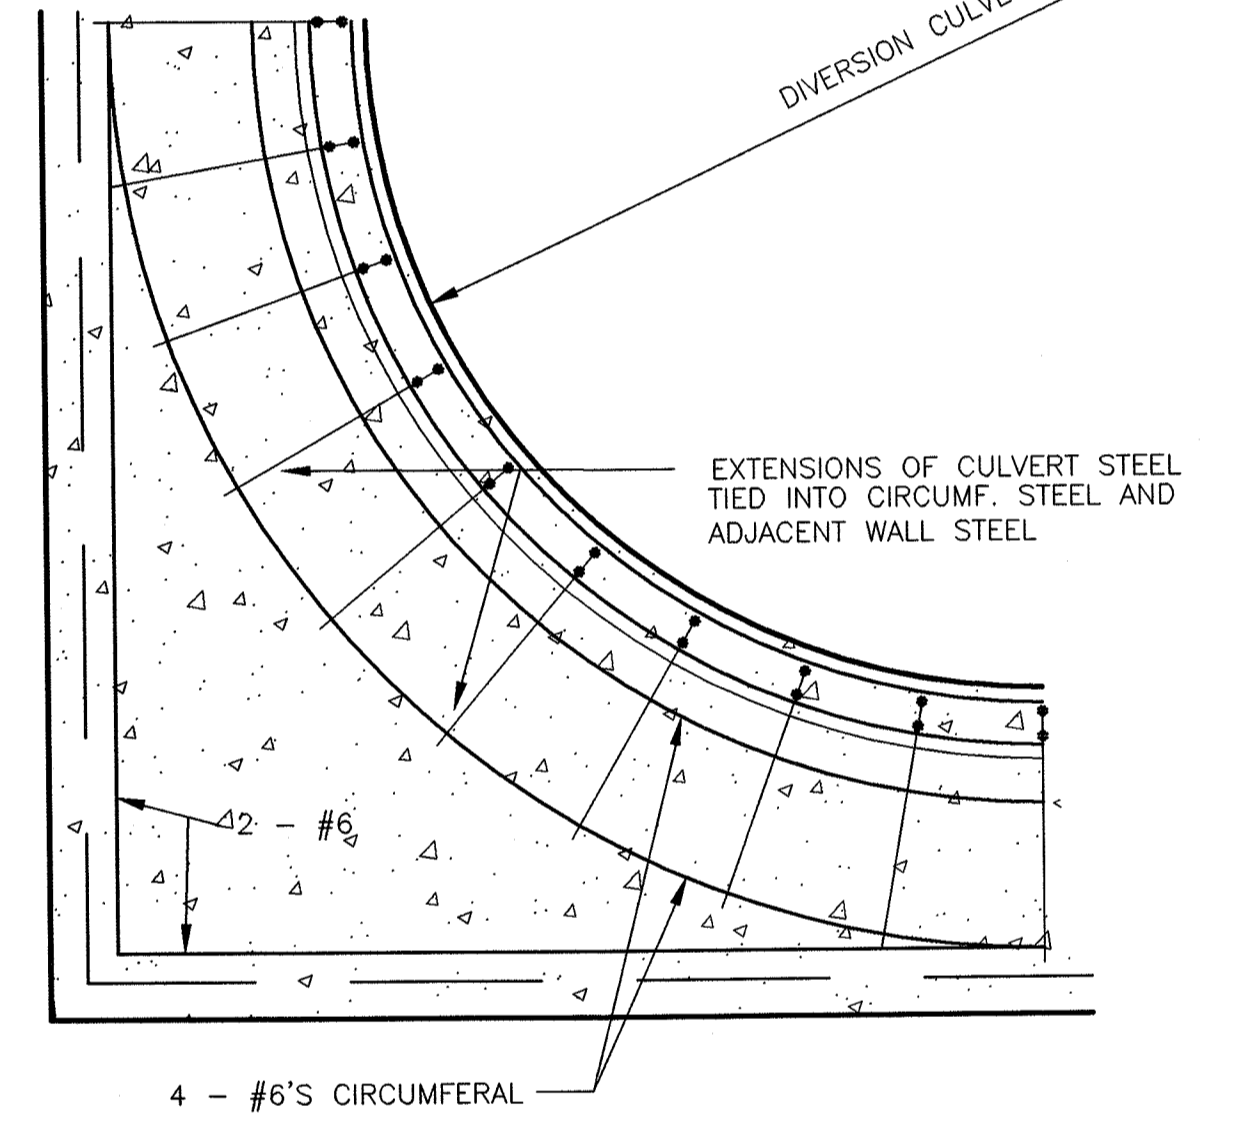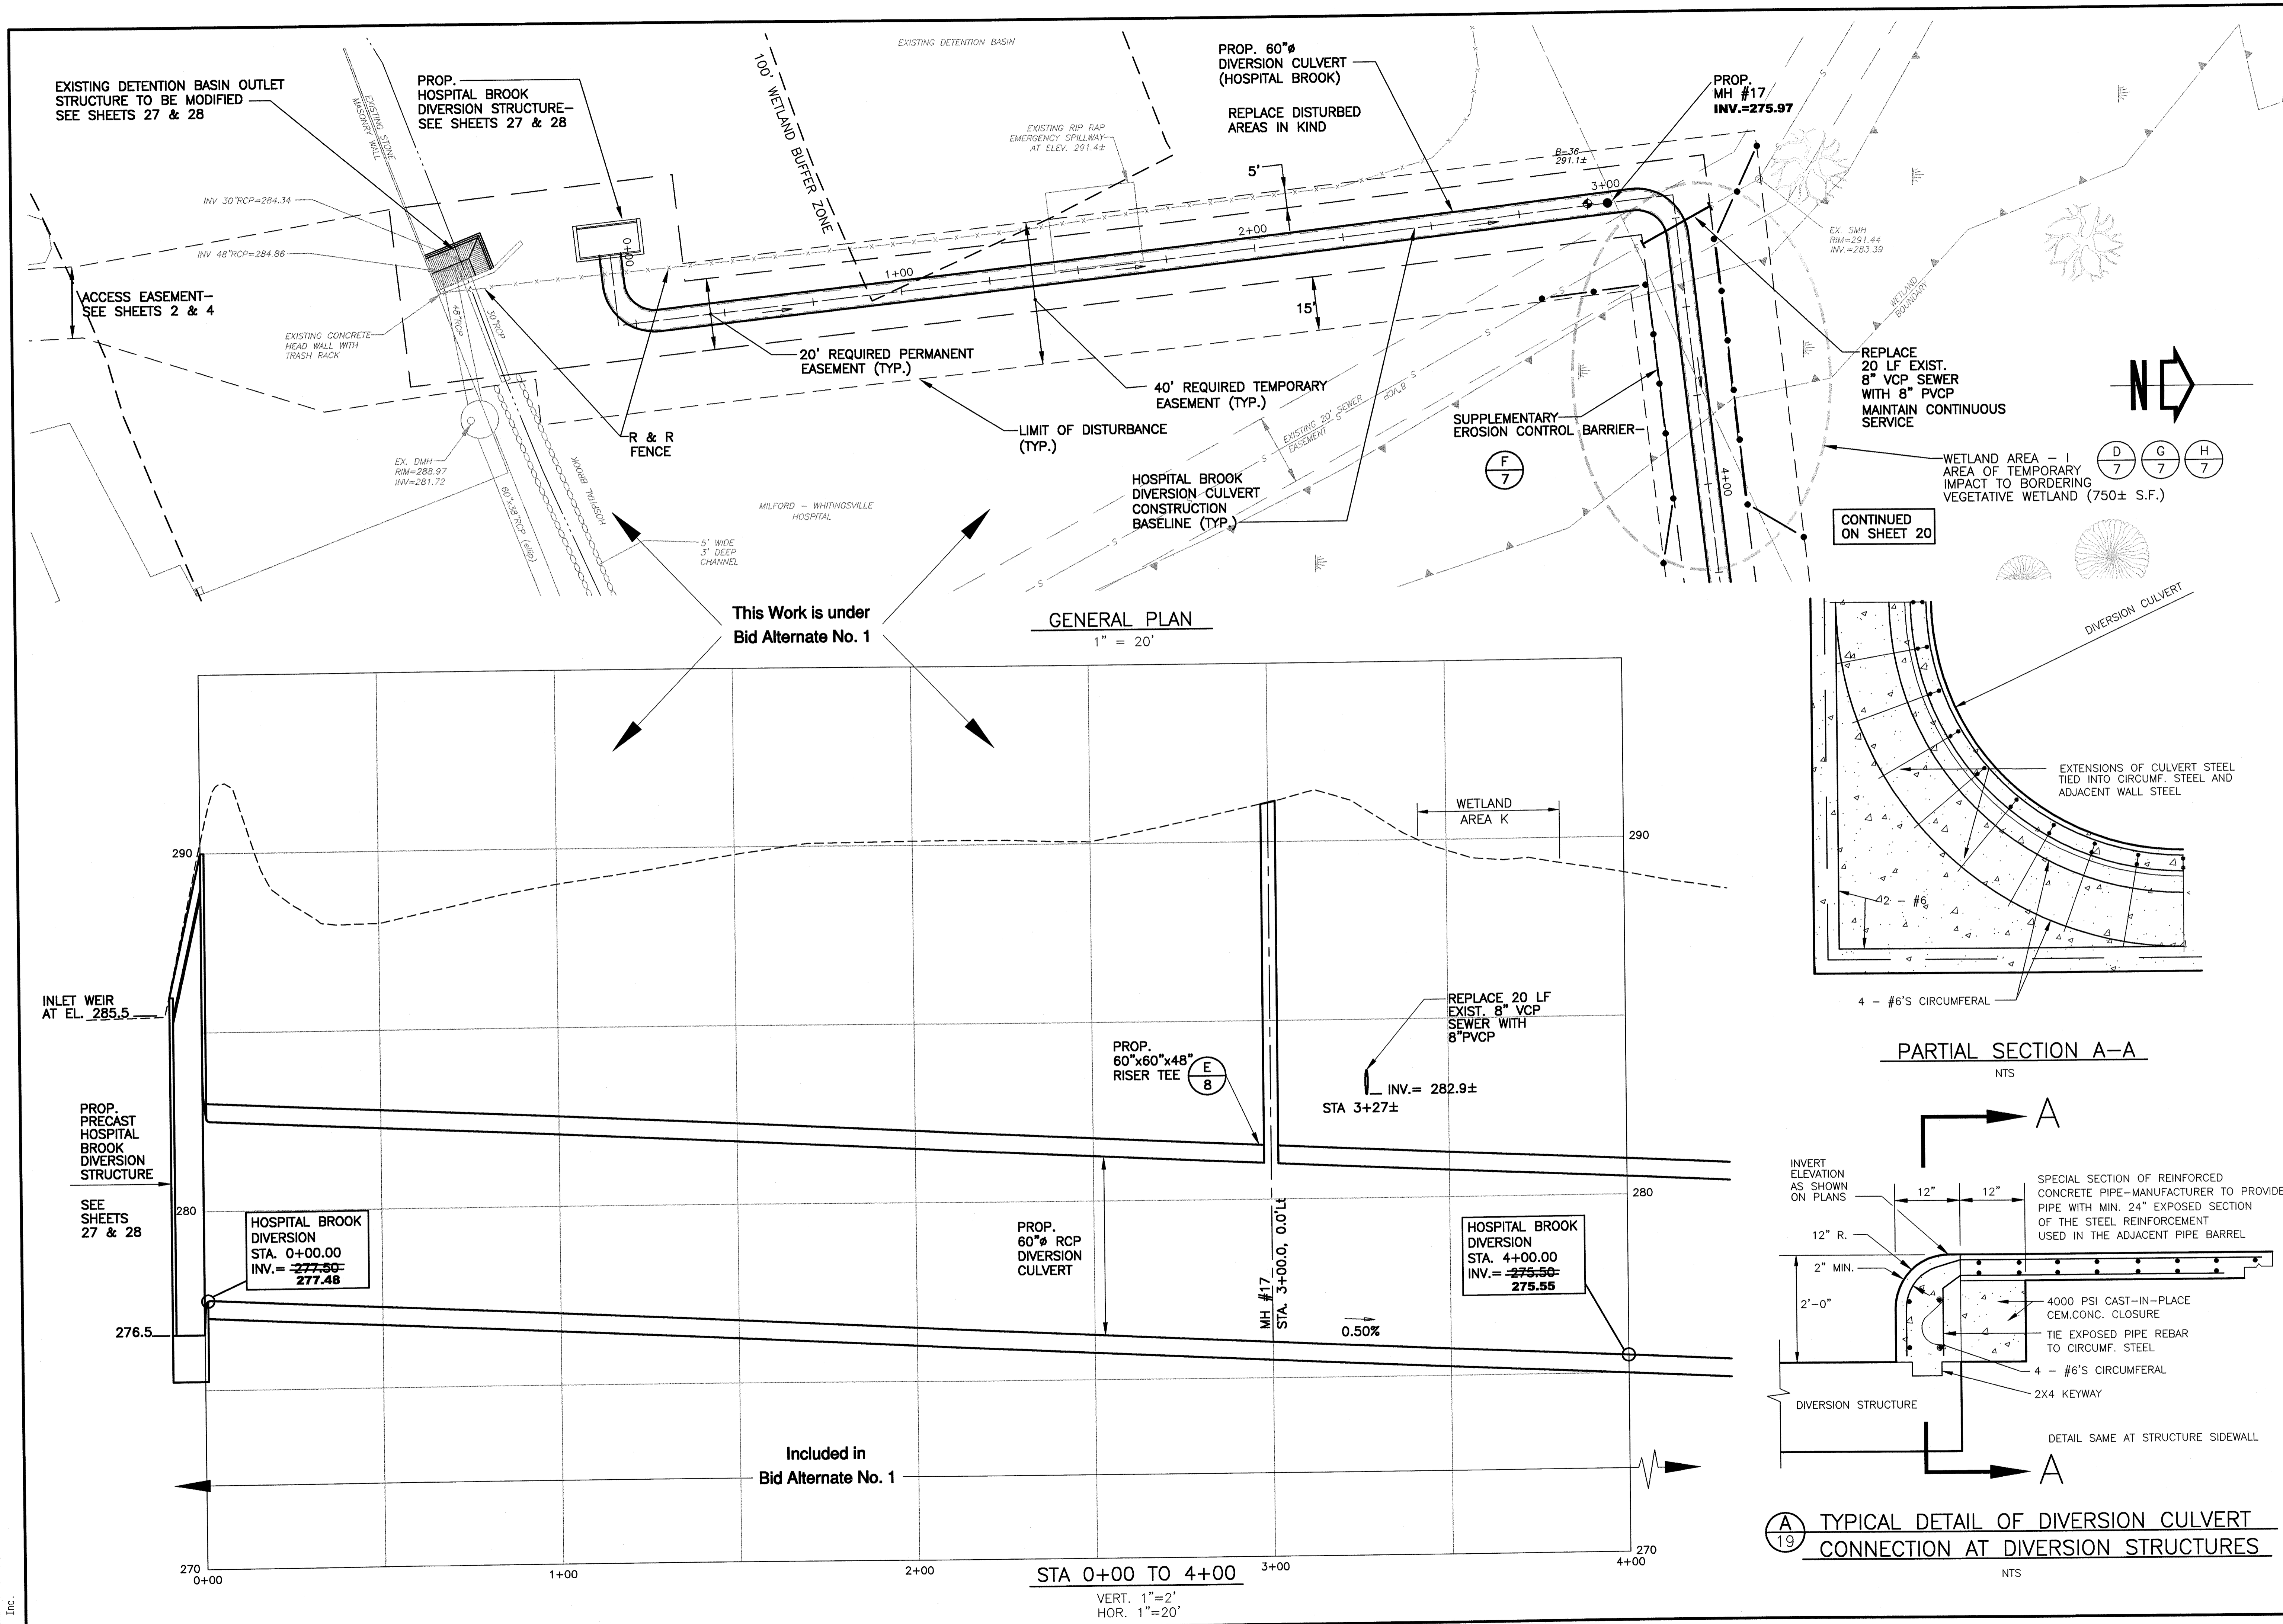

PROJECT NO. 94-1215		SCALE AS NOTED		DATE APRIL 1999		DRAWN BY EDM		CHECKED BY TEJ	
Plan / Profile Sta. 0+00 to 4+00 Hospital Brook Diversion Culvert Godfrey Brook Flood Mitigation Project Milford, Massachusetts									
PROJECT TITLE: Hospital Brook Diversion Culvert PROJECT: Godfrey Brook Flood Mitigation Project LOCATION: Milford, Massachusetts									
NO.	DATE	REVISION	BY	EDM	TEJ	BY			
2	10/10/01	ISSUED AS RECORD PRINT							
1	8/12/99	ISSUED FOR BIDDING							


BAYSTATE ENVIRONMENTAL CONSULTANTS INC.
 Engineers
 296 North Main Street
 East Longmeadow, MA 01028
 Scientists
 Surveyors

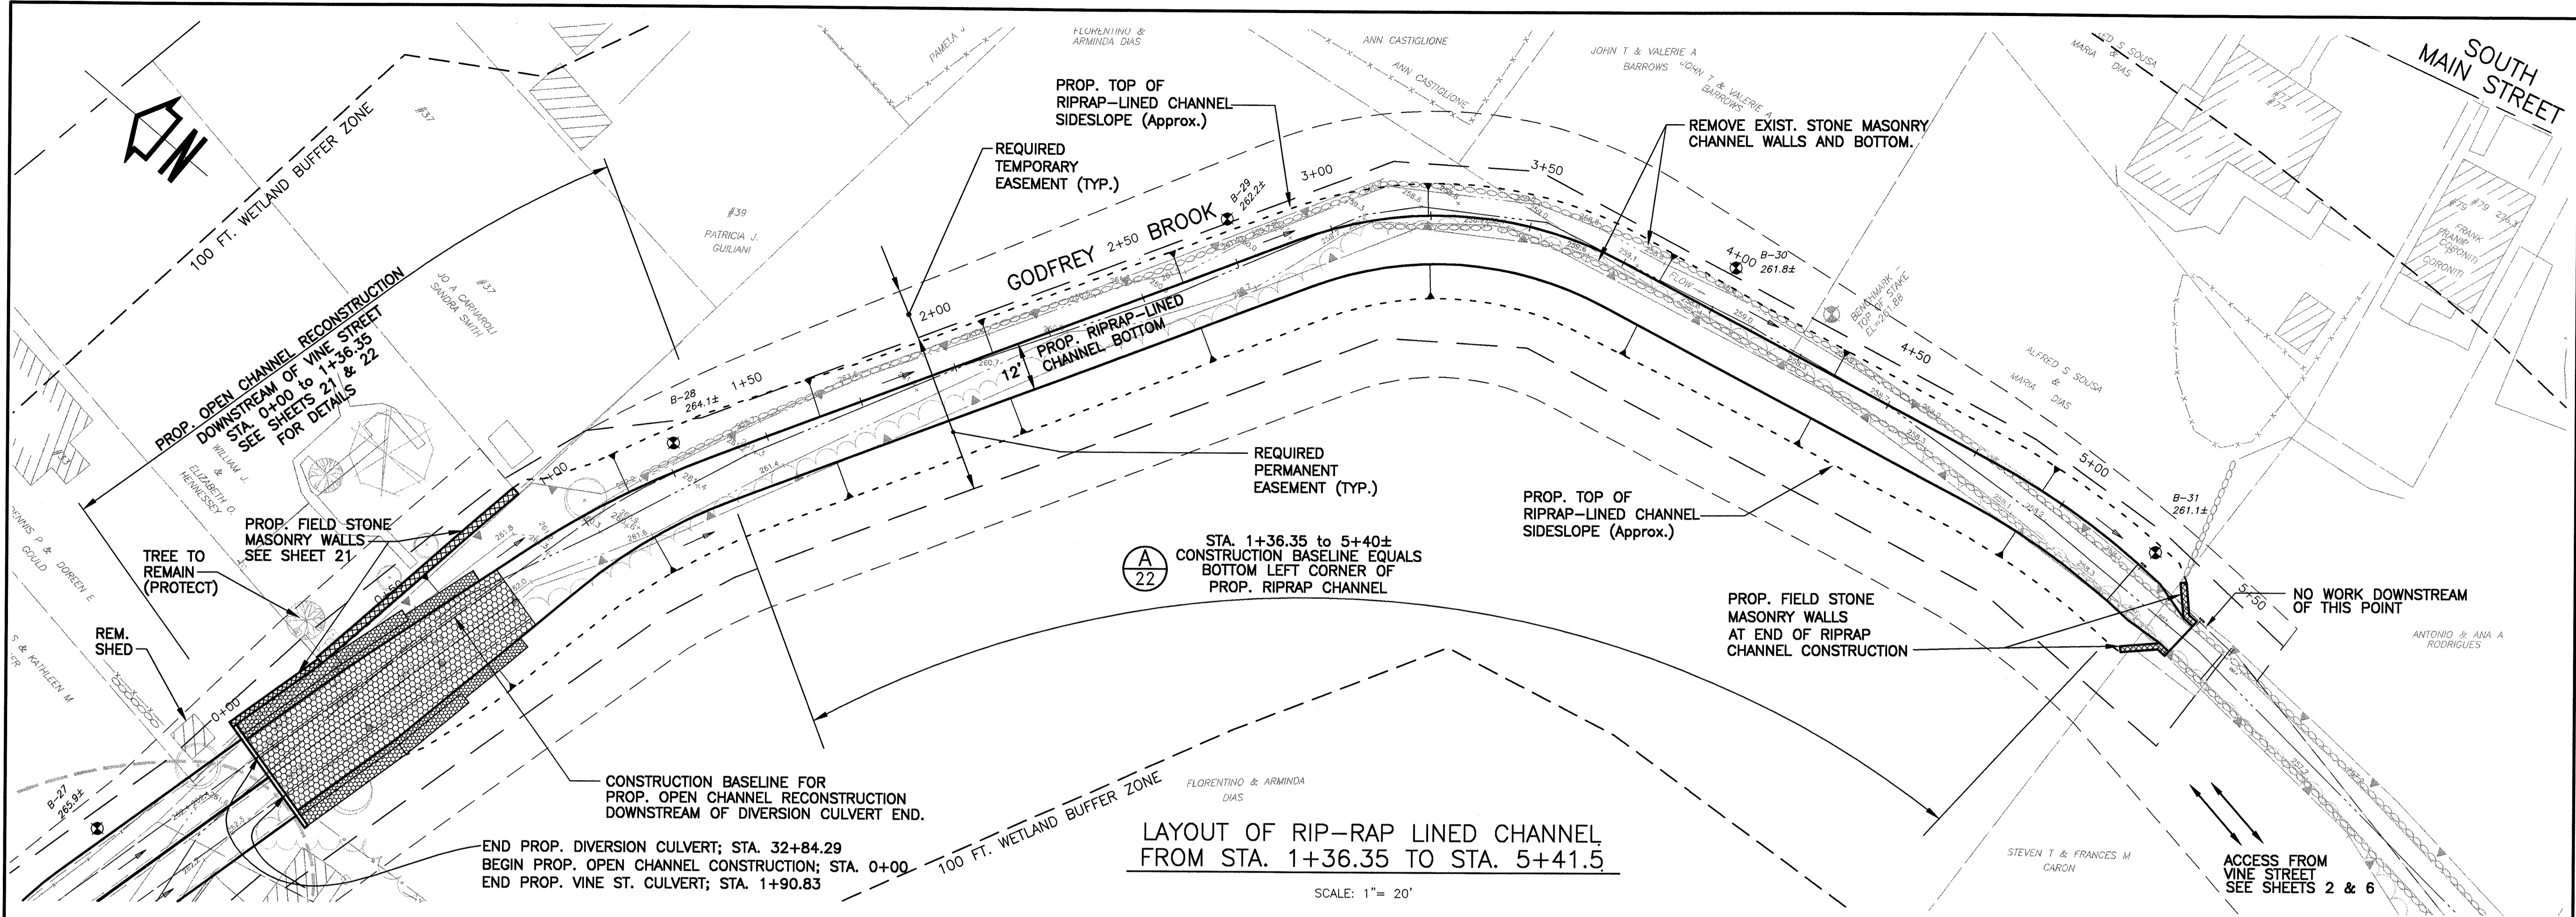


LAYOUT OF RIP-RAP LINED CHANNEL FROM STA. 1+36.35 TO STA. 5+41.5

SCALE: 1" = 20'


- NOTES:
1. FIELDSTONE MASONRY TO BE COMPOSED OF NATIVE MILFORD GRANITE OTHERWISE MEETING THE REQUIREMENTS OF M9.04.4.

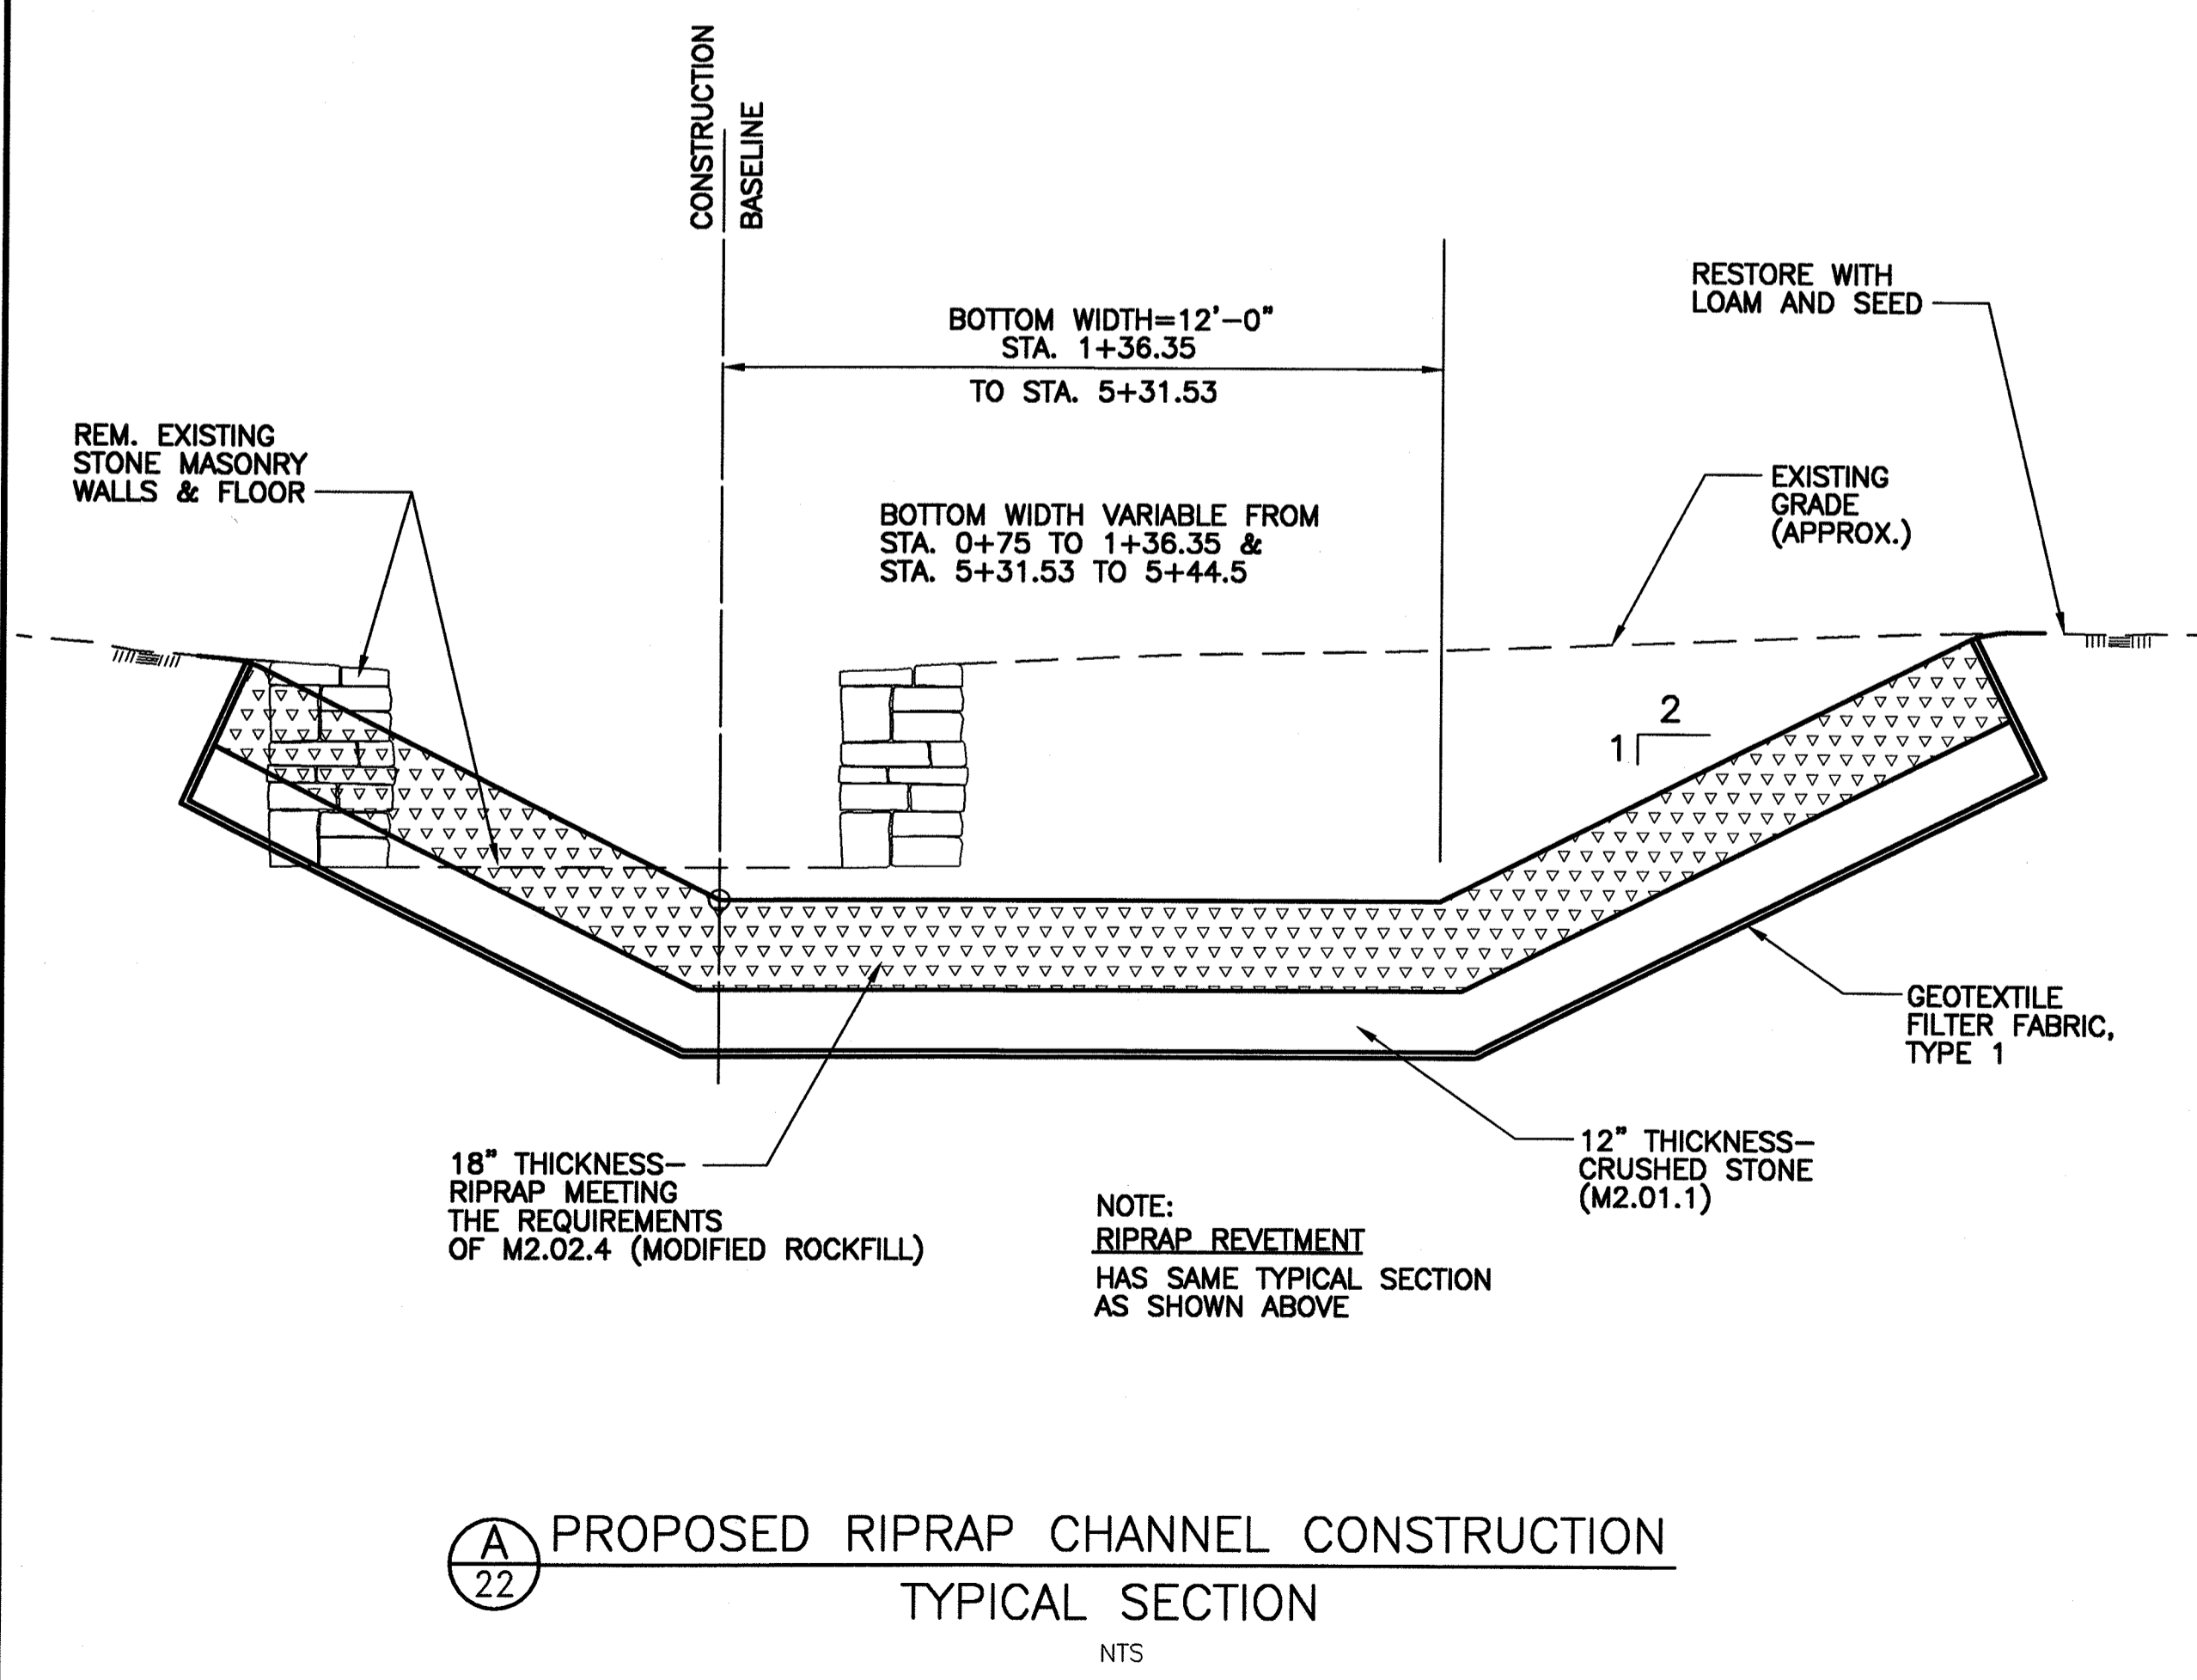

(A) 22 PROPOSED RIPRAP CHANNEL CONSTRUCTION
TYPICAL SECTION
NTS

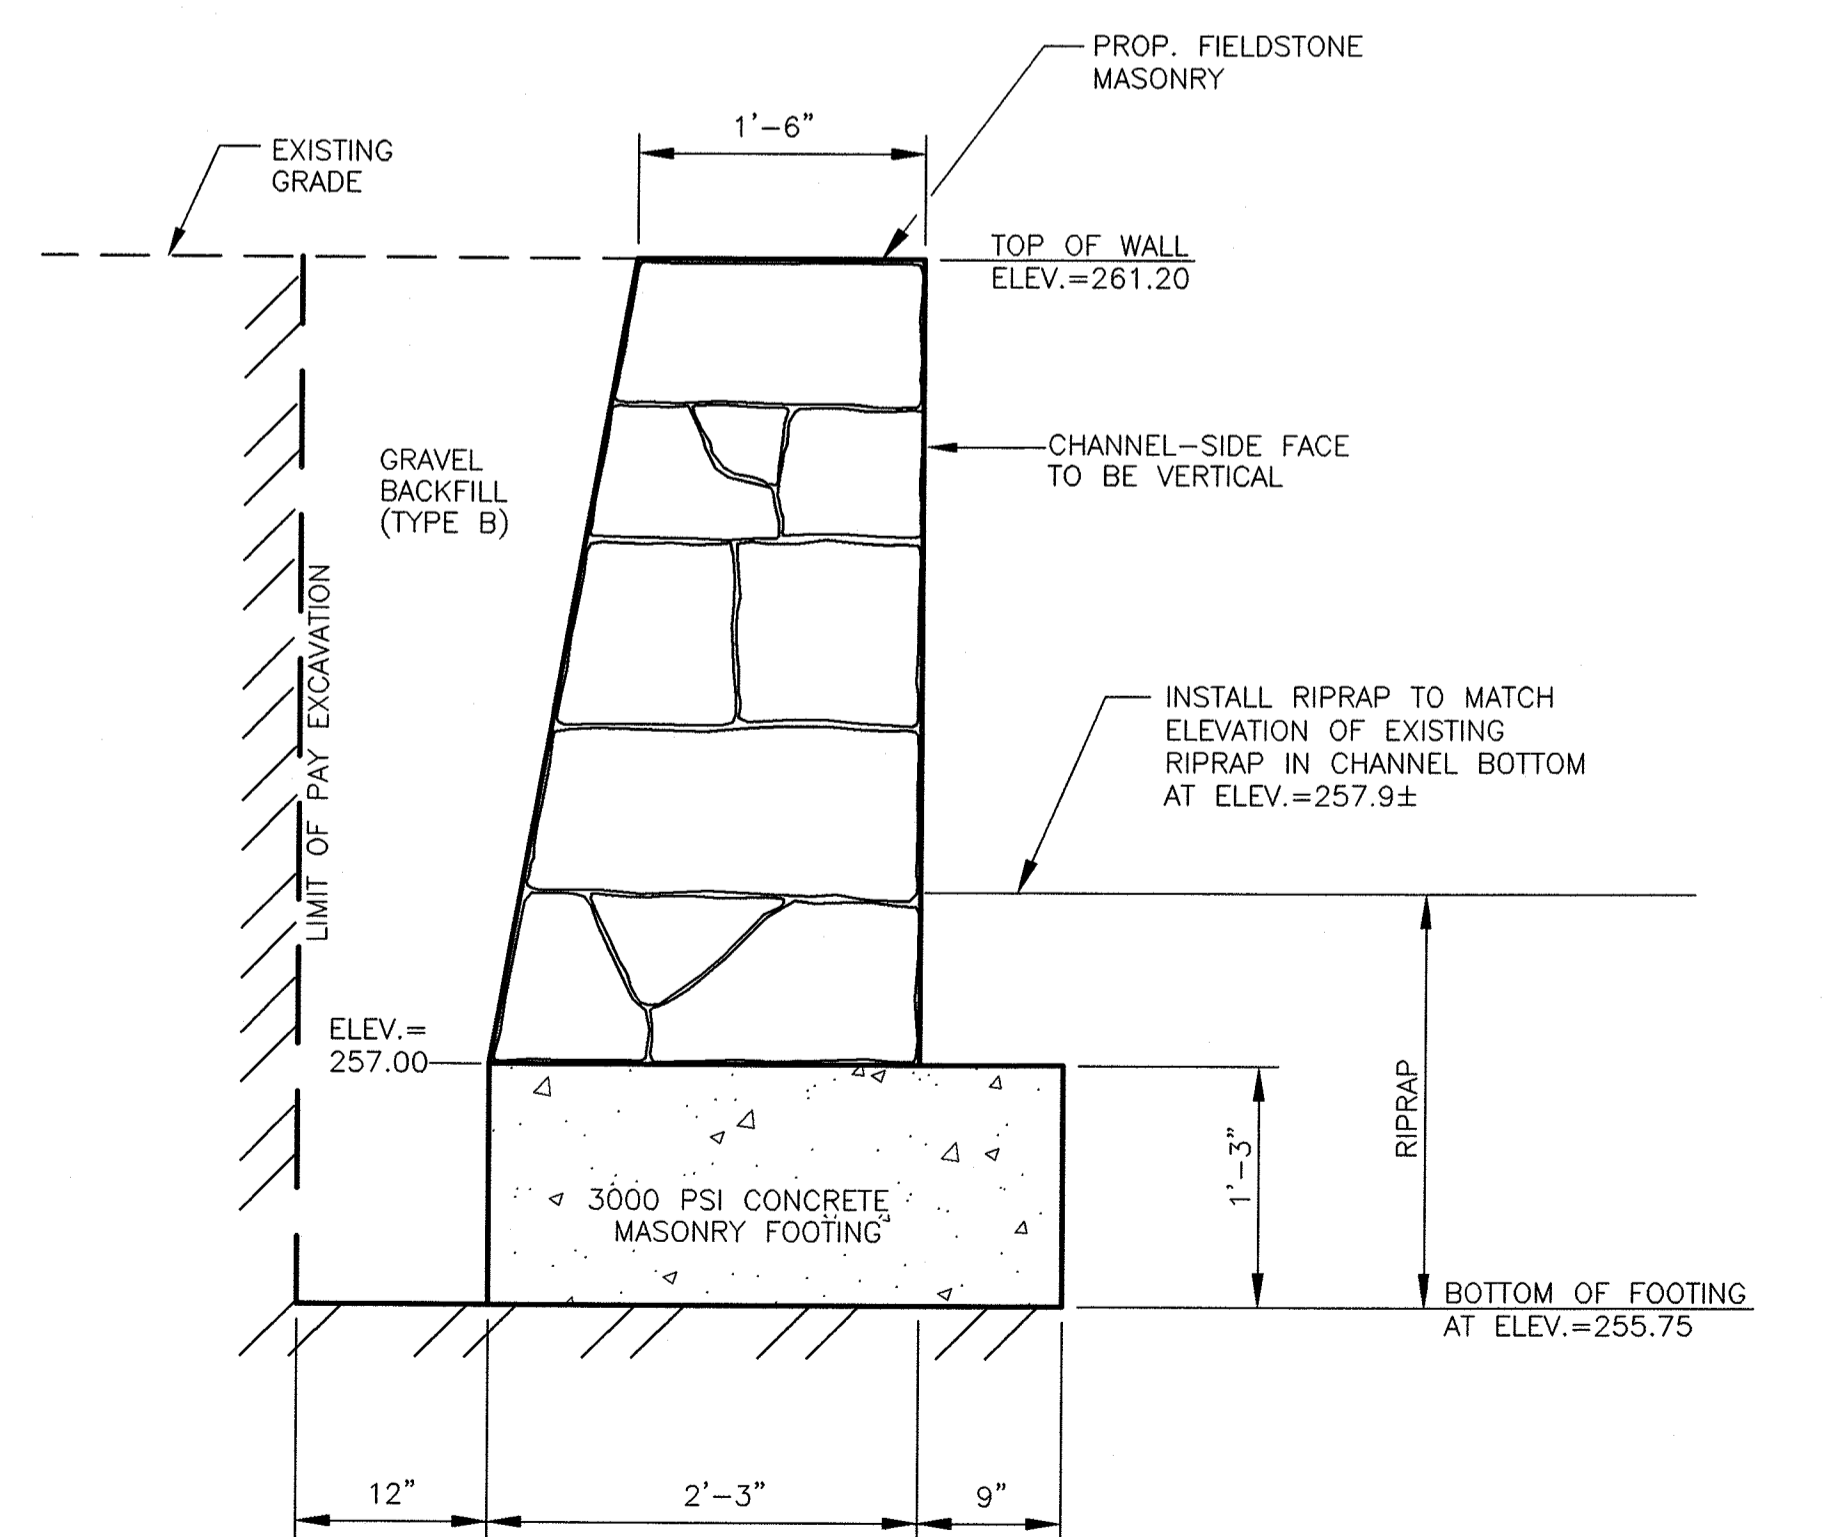

PROPOSED FIELD STONE WALLS AT END OF RIPRAP CHANNEL
TYPICAL SECTION
NTS

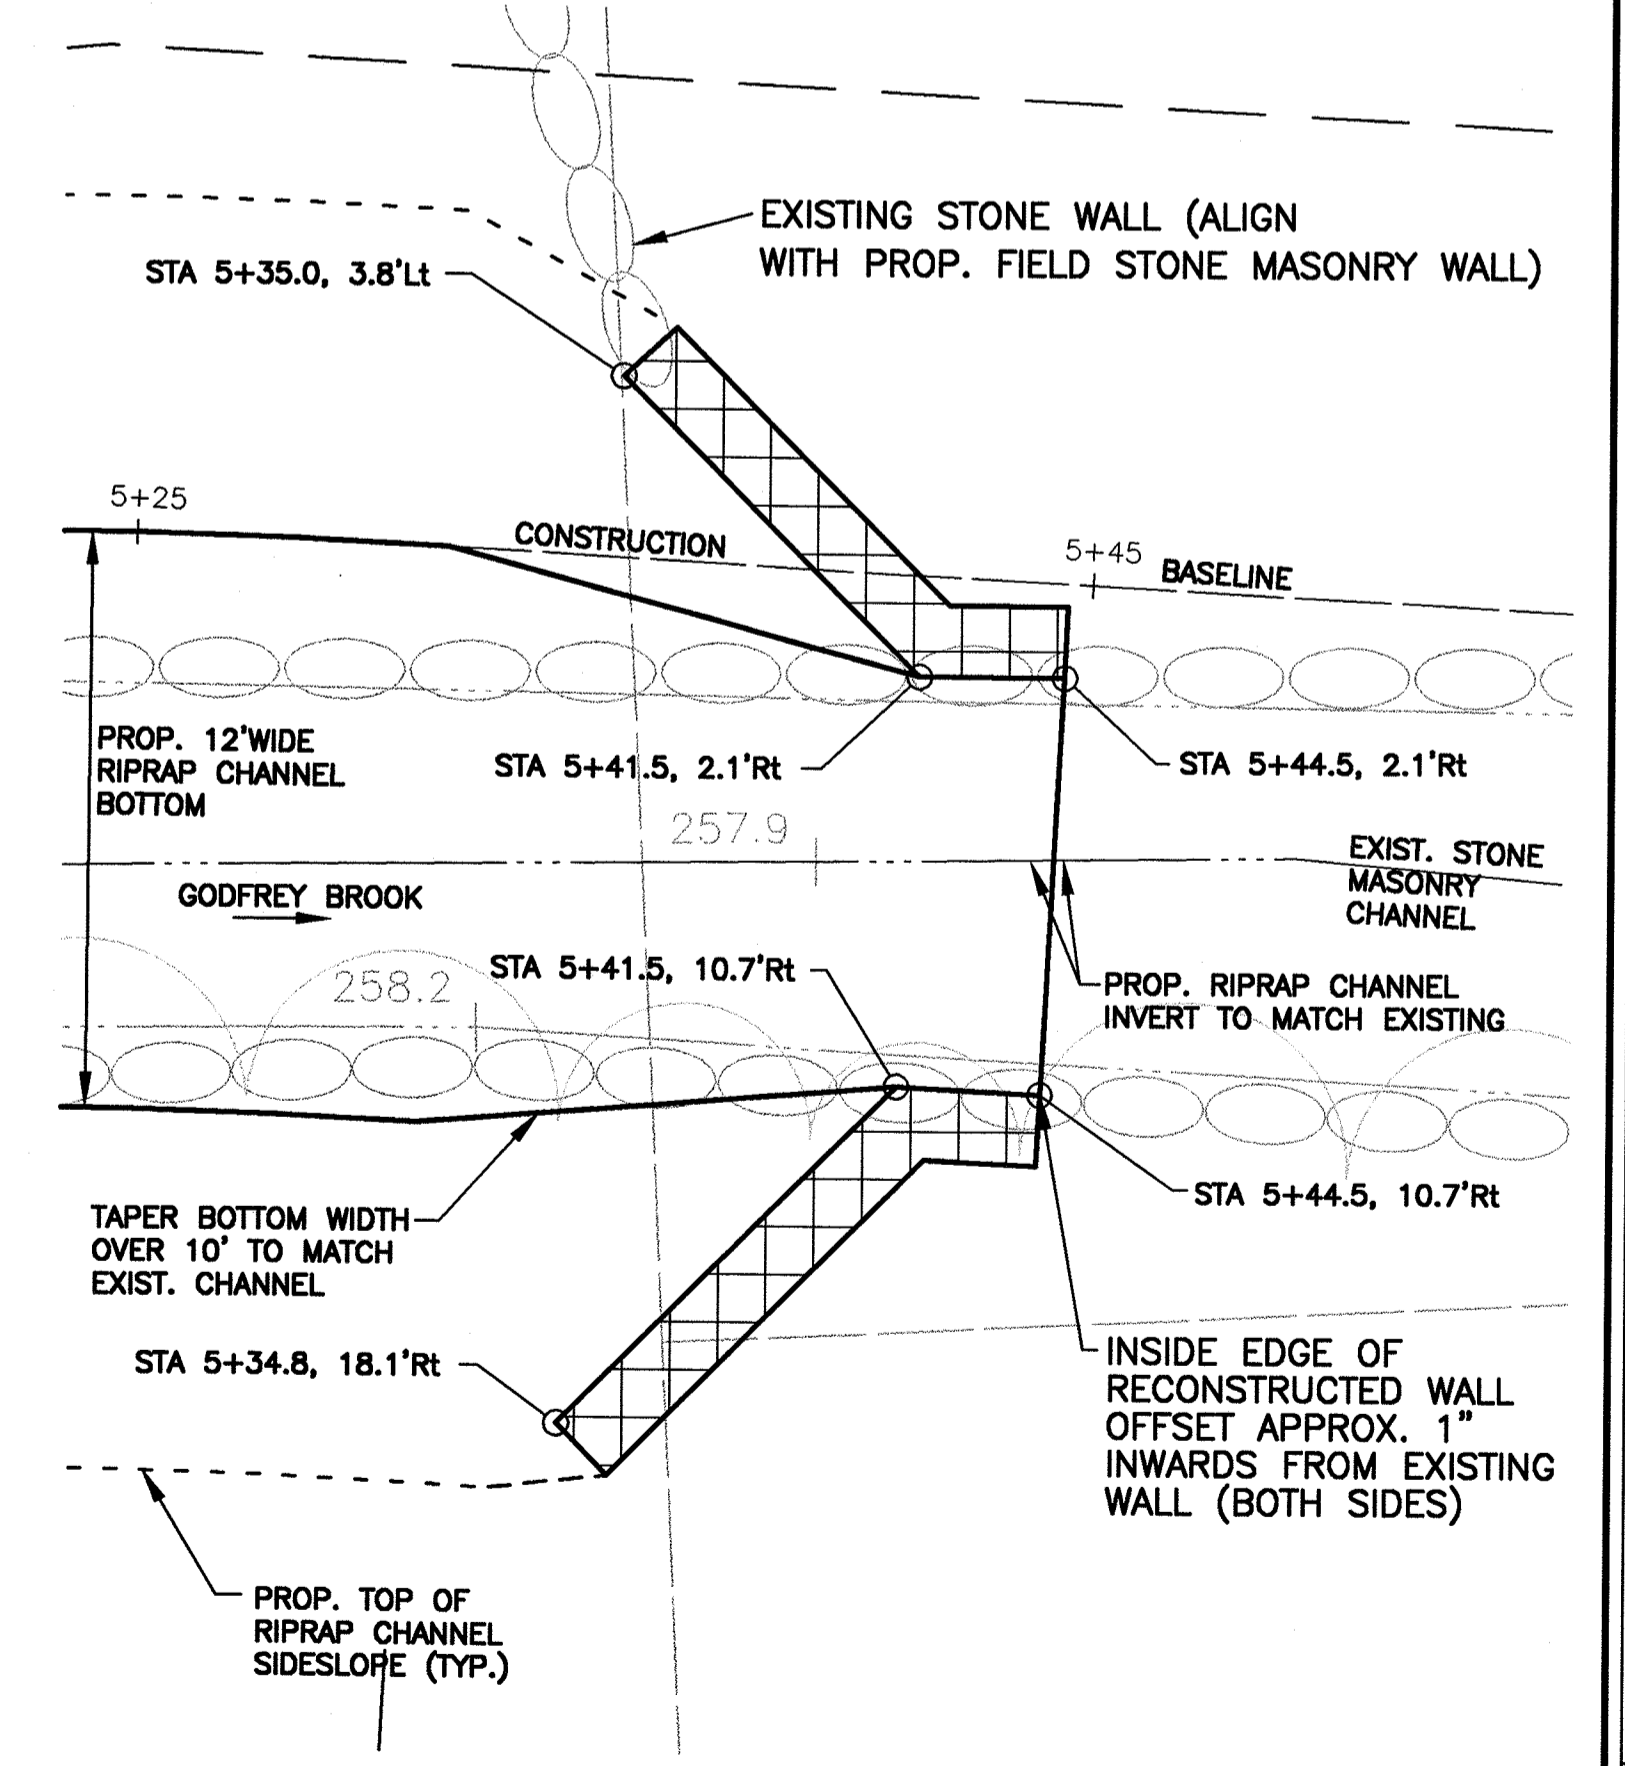

PROPOSED FIELD STONE WALLS AT END OF RIPRAP CHANNEL
DETAIL PLAN
1" = 4'

DRAWING NO. **22** OF **35** SHEETS

BAYSTATE ENVIRONMENTAL CONSULTANTS INC.
Surveyors
East Longmeadow, MA 01028

DEC
Engineers
286 North Main Street

PROJECT NO. 94-1215
SCALE AS NOTED
DATE APRIL 1999
DRAWN BY EDM
CHECKED BY TEJ




SHEET NO. 22
PROJECT: **Plan & Details - Sta. 1+36.35 to 5+44.5+1
Open Channel Reconstruction
Downstream of Vine Street
Godfrey Brook Flood Mitigation Project
Milford, Massachusetts**

NO.	DATE	REVISION
1	8/12/99	ISSUED FOR BIDDING
2	10/01	ISSUED AS RECORD PRINT

EDM
TEJ
BY

AutoCAD File: P:\AUTOCAD\ADMIN\941215\RECORD DRAWINGS\Sheet 16 17 18 22 34.dwg Plotted at: Tue Oct 02 08:35:47 2001
BEC, Inc.

AutoCAD File: P:\AUTOCAD\VICOR\IN\941215\RECORD\DRM\IN\SHEET12 13 14 15 23.dwg Plotted at: Mon Oct 01 16:00:24 2001
BEC, Inc.

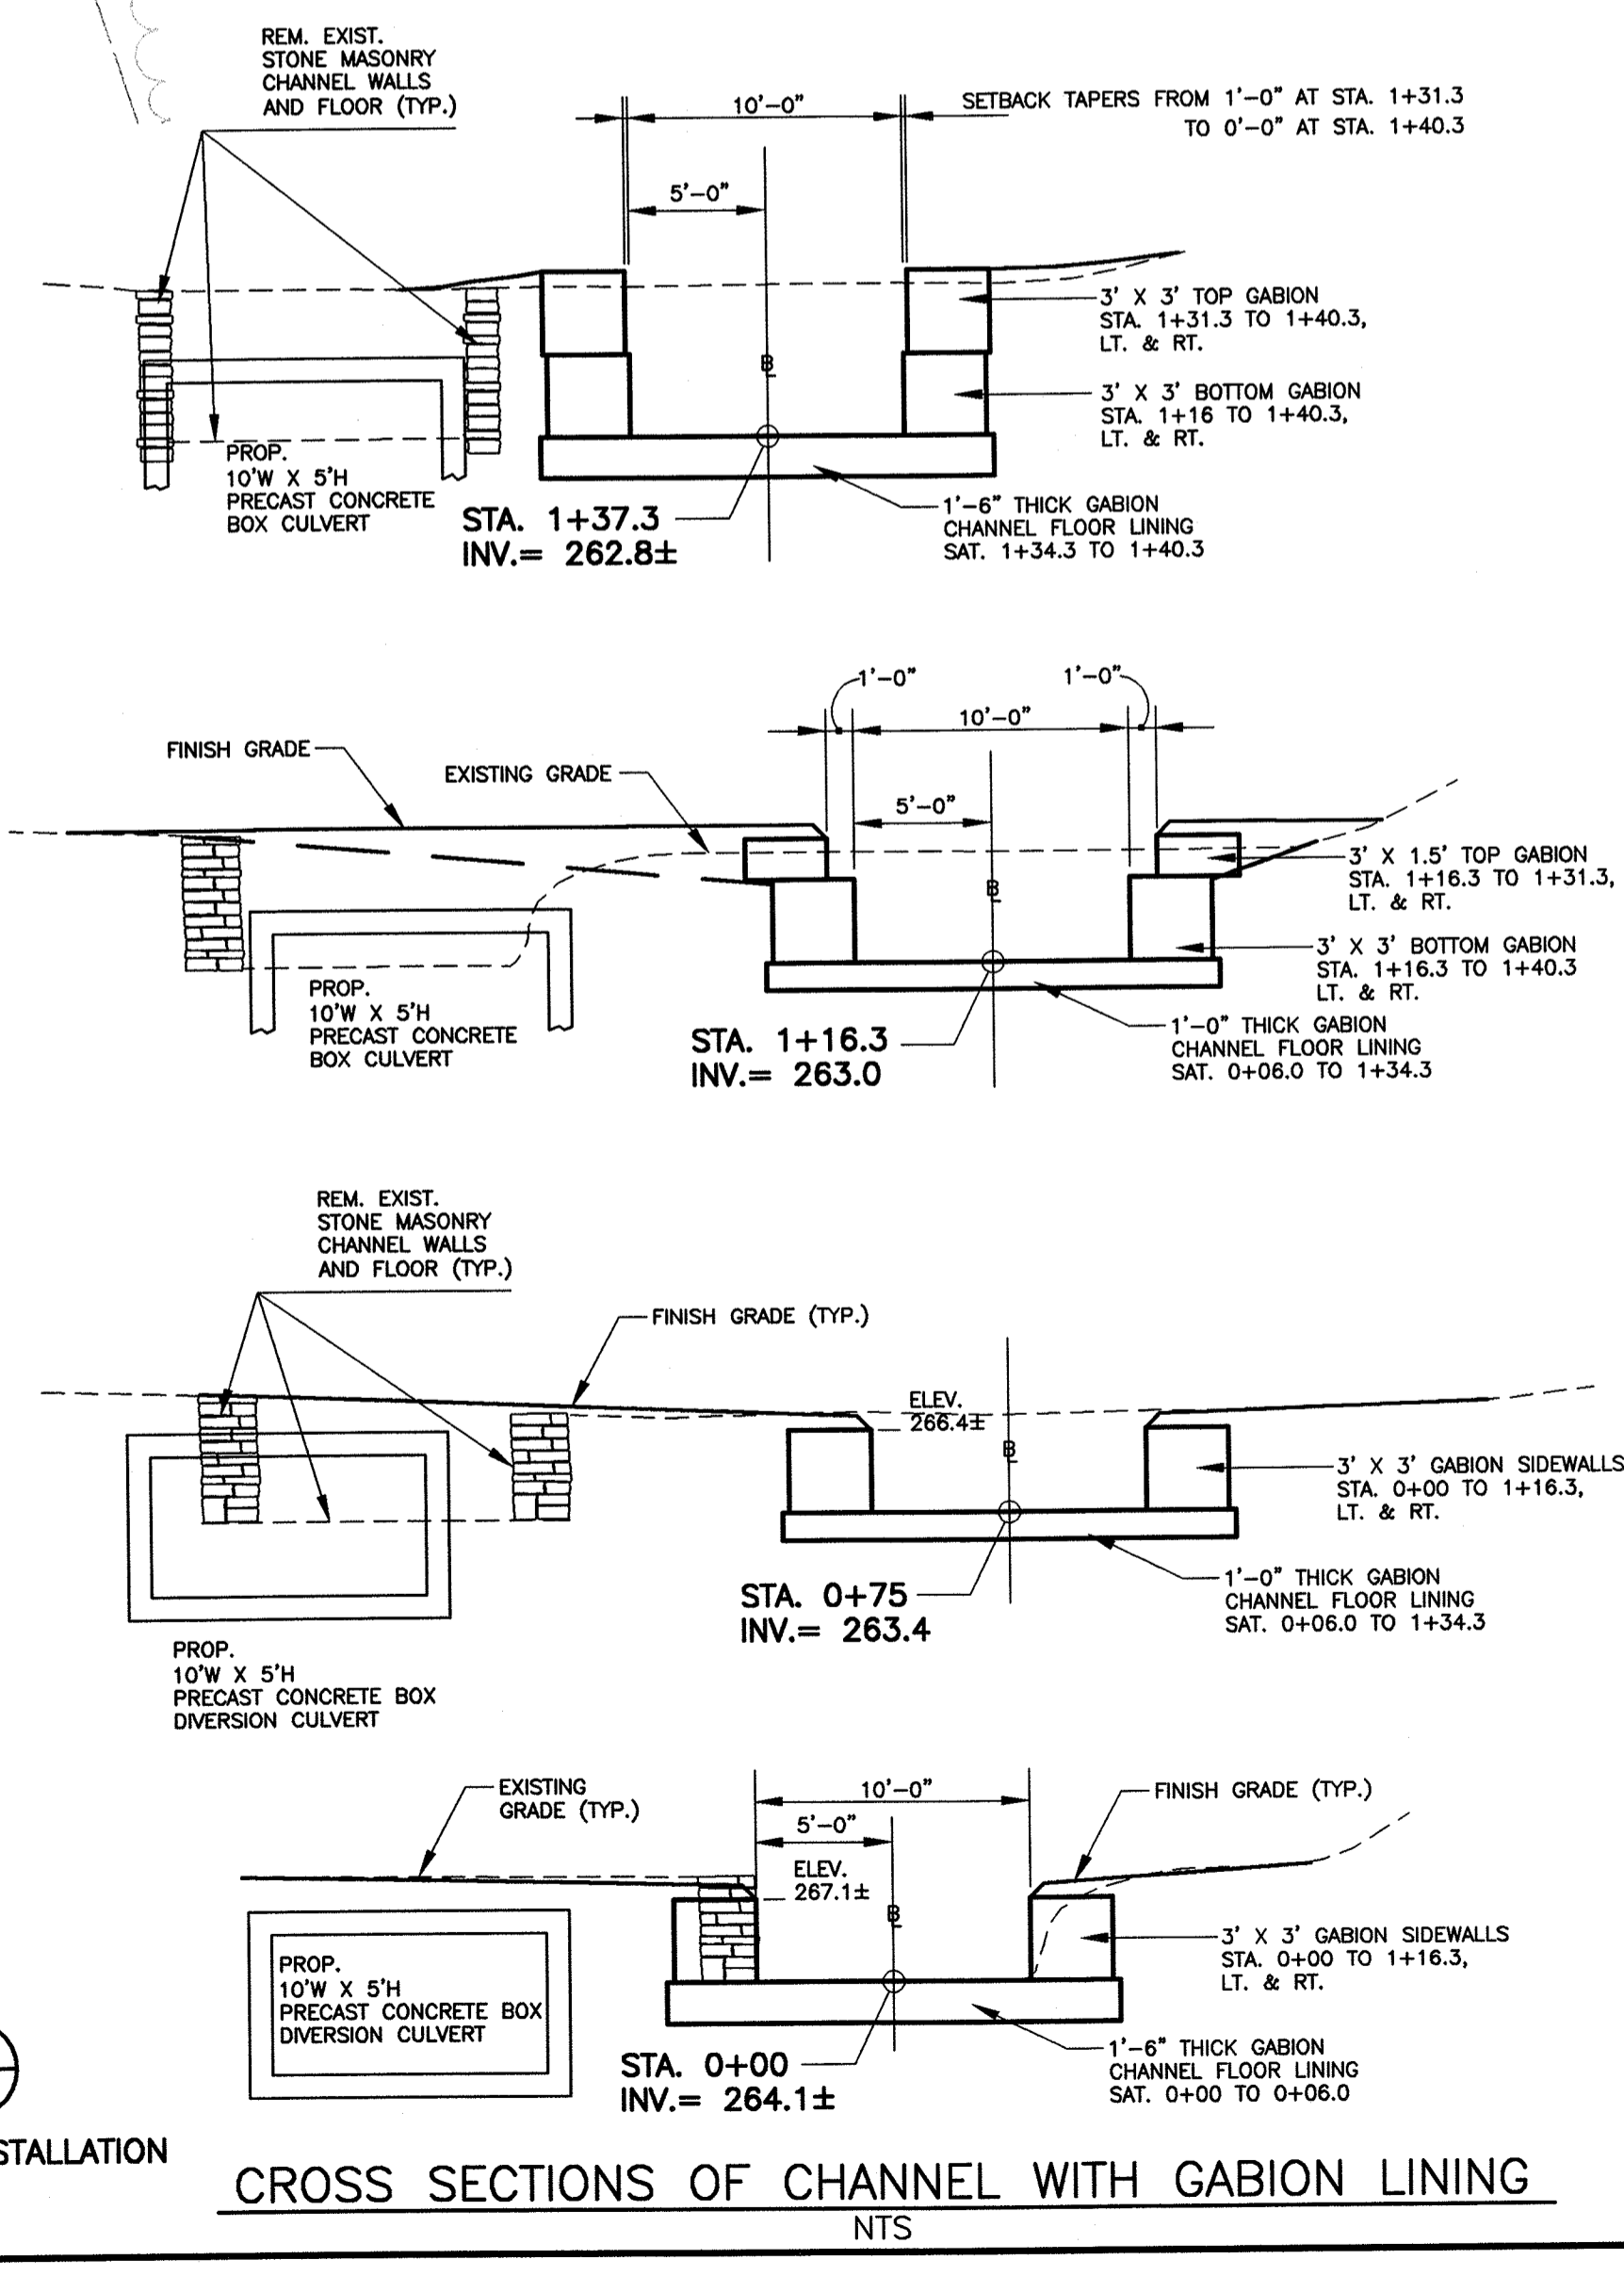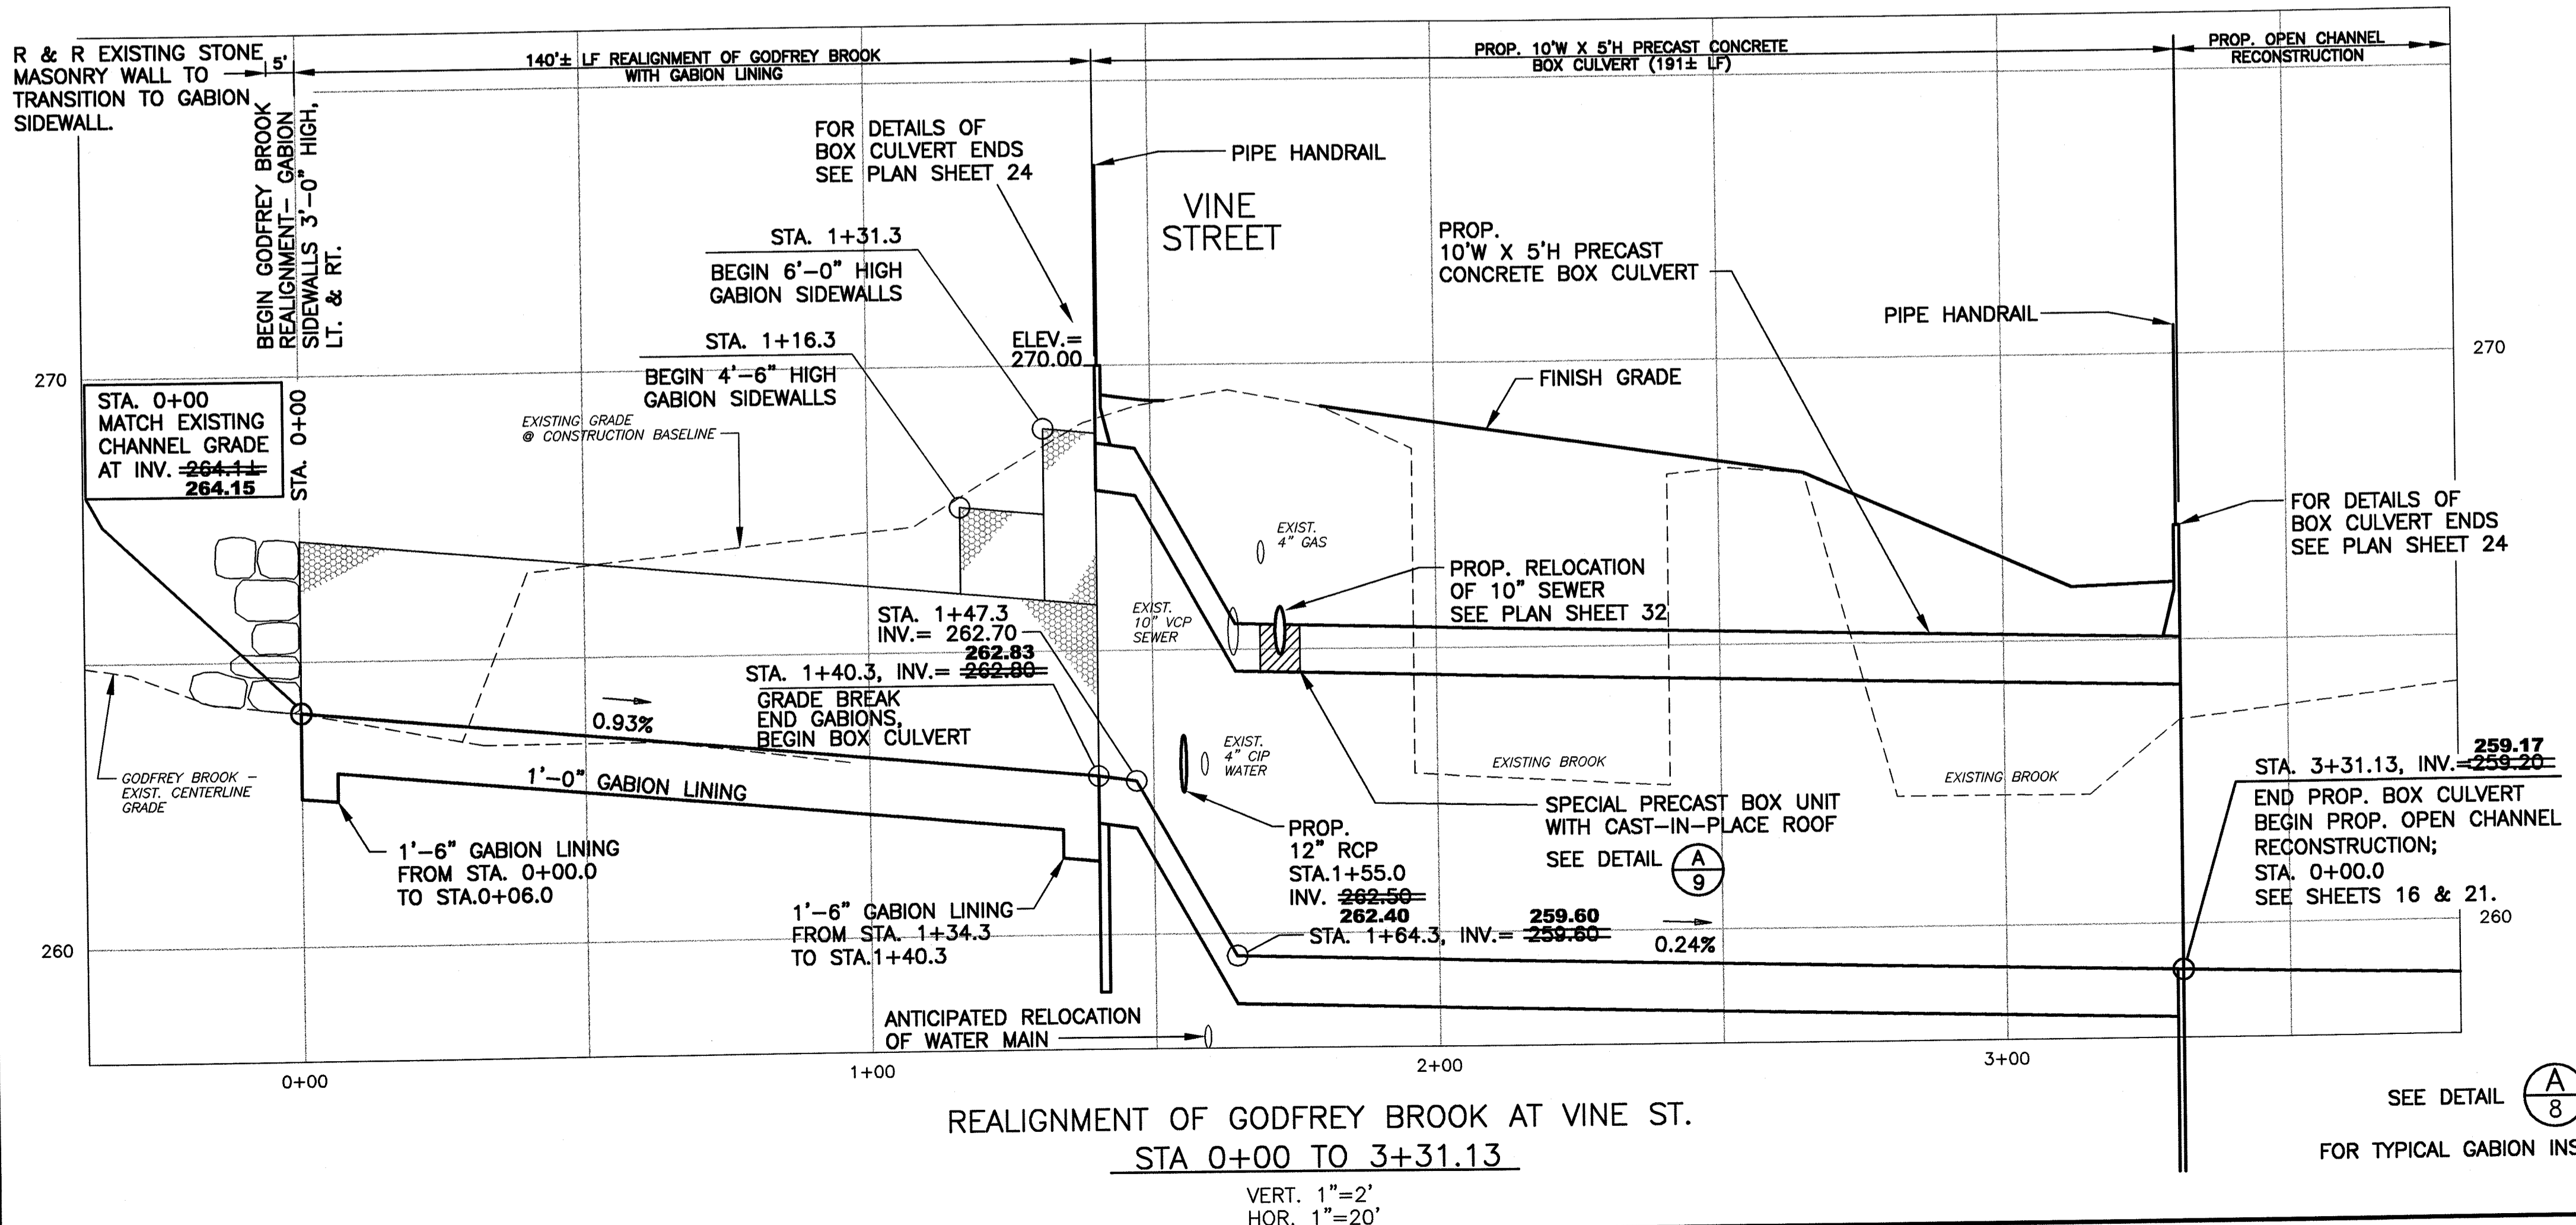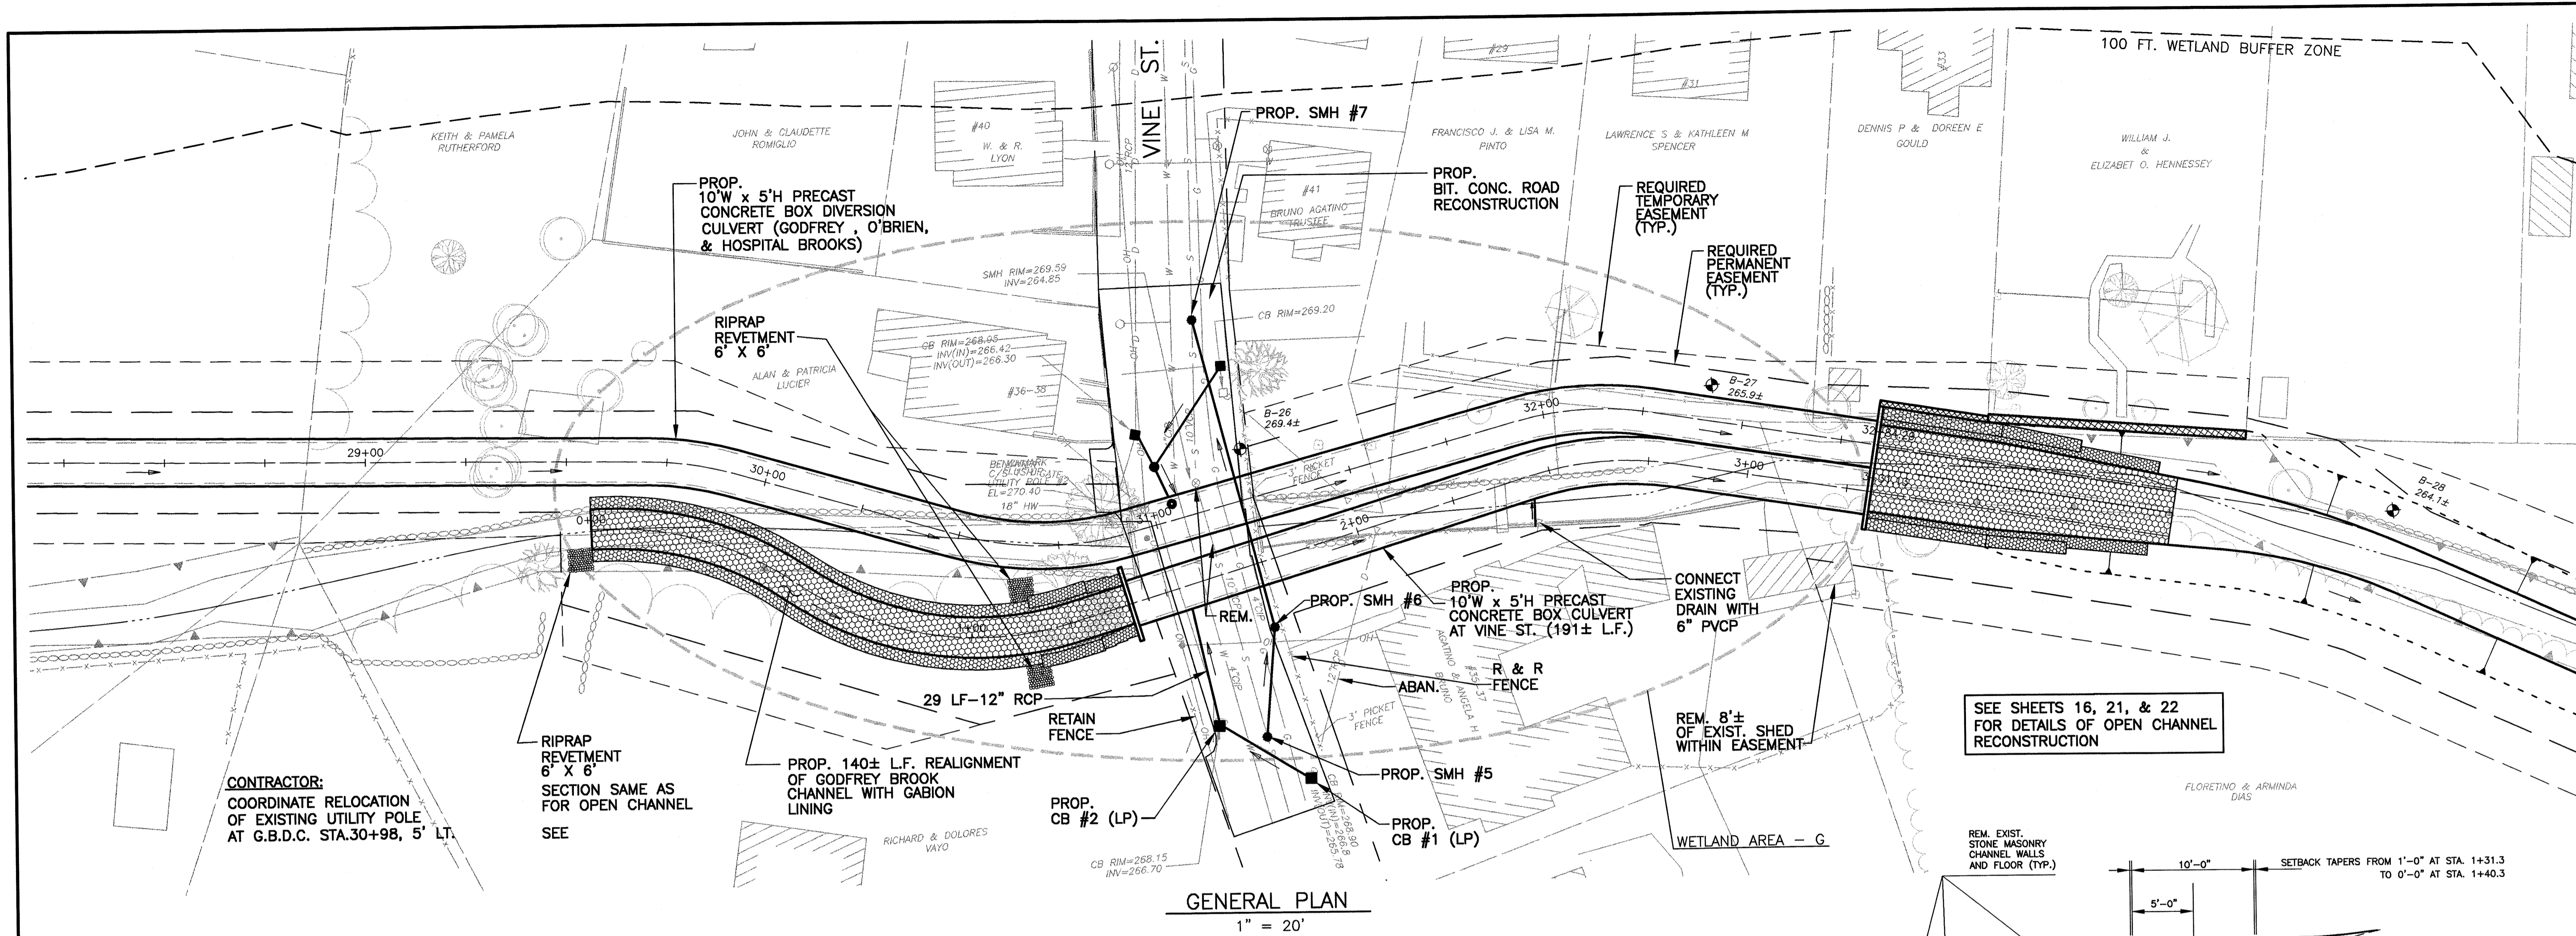

BAYSTATE ENVIRONMENTAL CONSULTANTS INC.		Surveyors East Longmeadow, MA 01028
DEC		Engineers 298 North Main Street
PROJECT NO. 94-1215		SCALE AS NOTED
DATE APRIL 1999		DRAWN BY EDM
CHECKED BY TEJ		DATE
PROJECT Plan / Profile Sta. 0+00 to 3+31.13 Realignment of Godfrey Brook at Vine St. Godfrey Brook Flood Mitigation Project Milford, Massachusetts		
NO.	DATE	REVISION
2	8/12/98	ISSUED FOR BIDDING
1		ISSUED FOR BIDDING


PRECAST CULVERT & STRUCTURE DESIGN NOTES

CONCRETE MINIMUM STRENGTH = 5000 PSI @ 28 DAYS
 STEEL REINFORCEMENT - ASTM A615, GRADE 60
 WHEEL LOADING - AASHTO HS25-40
 COVER TO STEEL - 1.5 INCHES
 EARTH COVER - 0'-0" MINIMUM, 13'-6" MAXIMUM
 UNIT WEIGHT OF EARTH - 125 POUNDS PER CUBIC FOOT
 ACTIVE PRESSURE COEFFICIENT - 0.25 MIN., 0.5 MAX.
 2'-0" LIVE LOAD SURCHARGE APPLIED TO 13'-6" DEPTH
 EXTERIOR GROUND WATER AT FINISHED GRADE
 DESIGN SHALL BE IN ACCORDANCE WITH AASHTO SPECIFICATIONS
 FOR HIGHWAY BRIDGES, ACI 318-83, AND LOAD FACTOR DESIGN (AASHTO)

LOAD FACTORS
 DEAD LOAD 1.5
 LIVE LOAD 2.17
 HYDROSTATIC PRESSURE 1.4
 EARTH PRESSURE, HORIZ. 1.7

CAPACITY REDUCTION FACTORS
 SHEAR 0.85
 MOMENT 0.90

WEEP HOLES SHALL BE SUPPLIED IN CULVERT SECTIONS AND DIVERSION
 STRUCTURES AT RATE OF ONE (1) #4 WEEP PER 8 LINEAR FEET OF
 VERTICAL FACE.

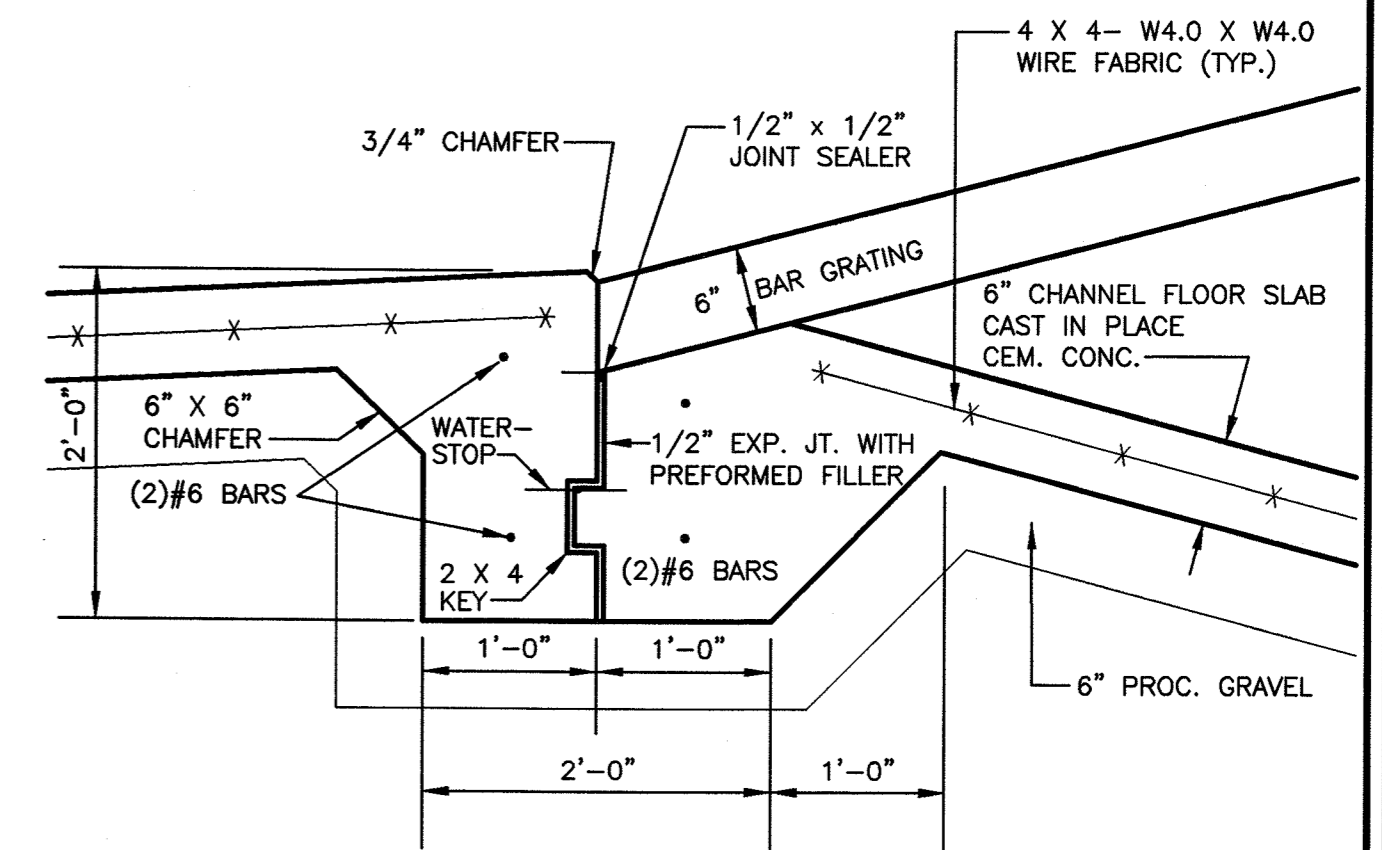

(B) SLAB JOINT DETAIL
 N.T.S.

REFER TO THE NEW PLAN SHEET NO. 25-A
 FOR
 PLAN, PROFILE, AND DETAILS OF THE
 GODFREY BROOK DIVERSION STRUCTURE

SIDEWALL LAYOUT INFORMATION:


LEFT SIDEWALL: BOTTOM OF FOOTING:
 STA. -0+11.5 TO 0+04.60 ELEV. 297.00
 STA. 0+02.6 TO 0+19.1± ELEV. 296.00 (CONSISTENT WITH APPROVED SHOP DRAWINGS)

RIGHT SIDEWALL: BOTTOM OF FOOTING:
 STA. -0+11.5 TO 0+04.60 ELEV. 297.00
 STA. 0+02.6 TO 0+20.1± ELEV. 296.00 (CONSISTENT WITH APPROVED SHOP DRAWINGS)


BAR GRATING NOTES:

- ALL STEEL SHALL CONFORM TO THE REQUIREMENTS OF AASHTO-M183.
- BAR GRATING PANELS SHALL BE FABRICATED IN FULL LENGTH PANELS. MINIMUM PANEL WIDTH = 3'-0".
- BAR GRATING PANELS SHALL BE HOT-DIP GALVANIZED AFTER FABRICATION AND TEST FITTING. GALVANIZING SHALL MEET THE REQUIREMENTS OF AASHTO-M11 "ZINC (HOT-GALVANIZED) COATINGS ON PRODUCTS FABRICATED FROM ROLLED, PRESSED, AND FORGED STEEL SHAPES, PLATES, BARS, AND STRIP."


- CAST-IN-PLACE CONCRETE NOTES:**
- CONCRETE f'_c = 4,000 psi, Class A
 - REINF. - ASTM A-61 GRADE 60, EPOXY COATED
 - ALL SURFACES VISIBLE WHEN COMPLETED SHALL HAVE RUBBED FINISH.
 - 1"x1" CHAMFER ALL CONG. CORNERS

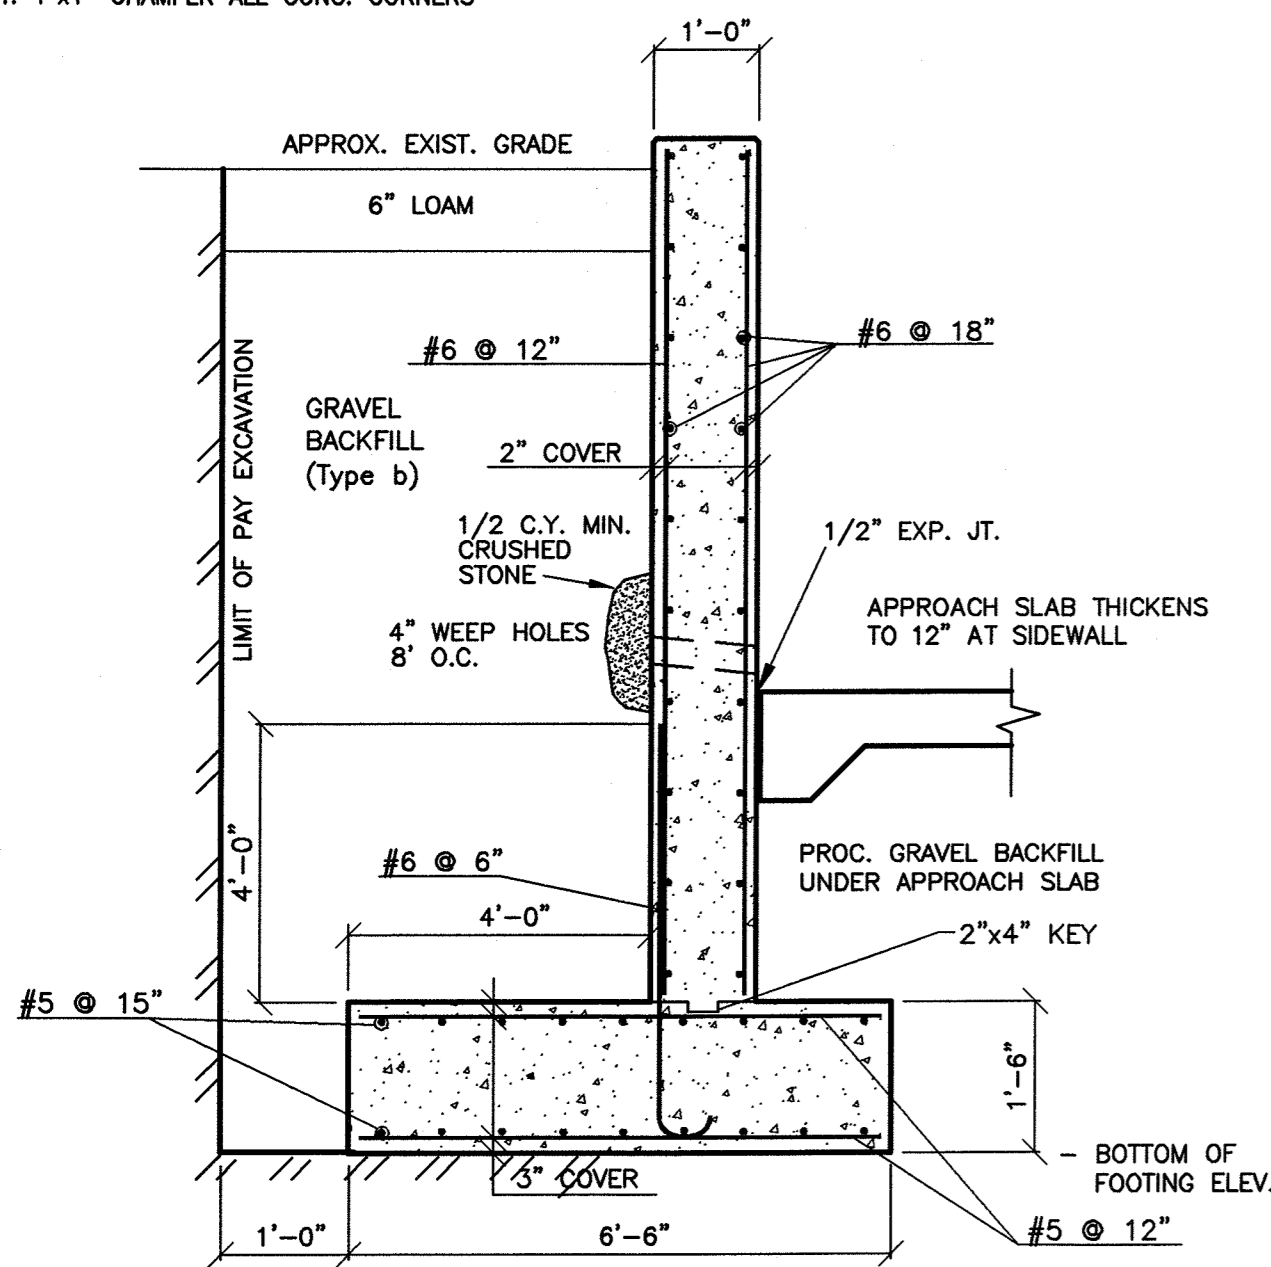


(A) CHANNEL SIDEWALL TYPICAL SECTION
 N.T.S.

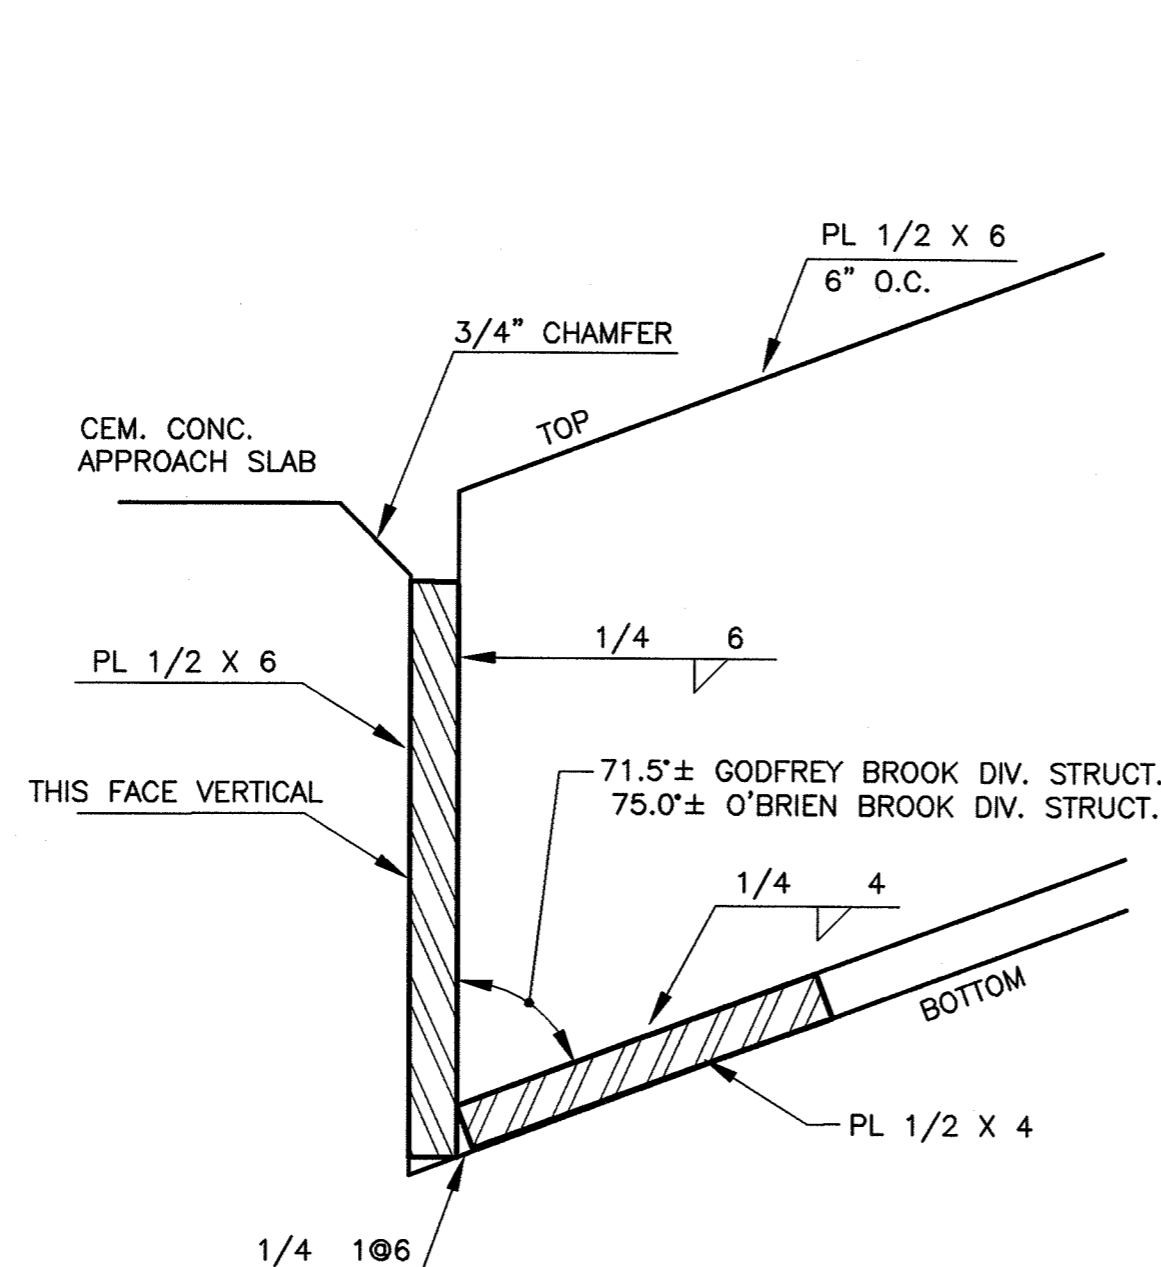

BAR GRATING NO. 1 & 2 - SECTION A-A
 1"=2"

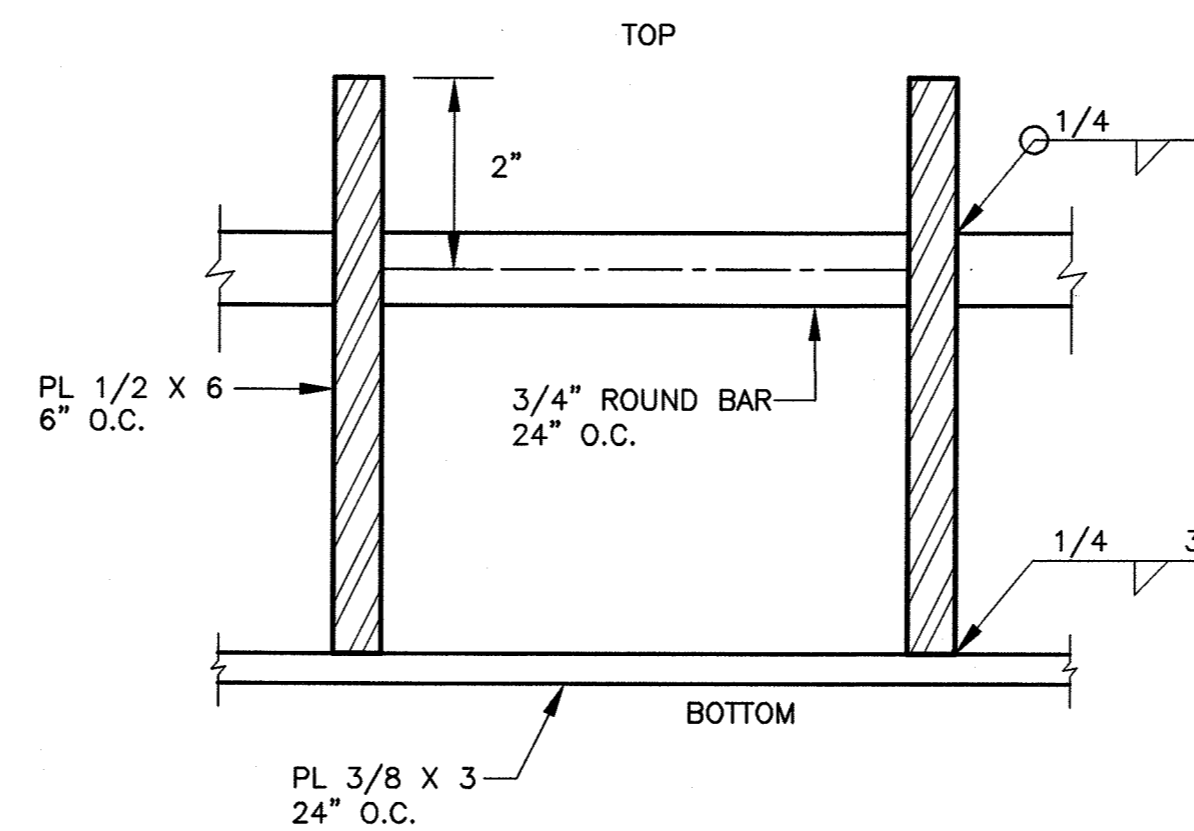

BAR GRATING NO. 1 & 2 - SECTION B-B
 1"=2"

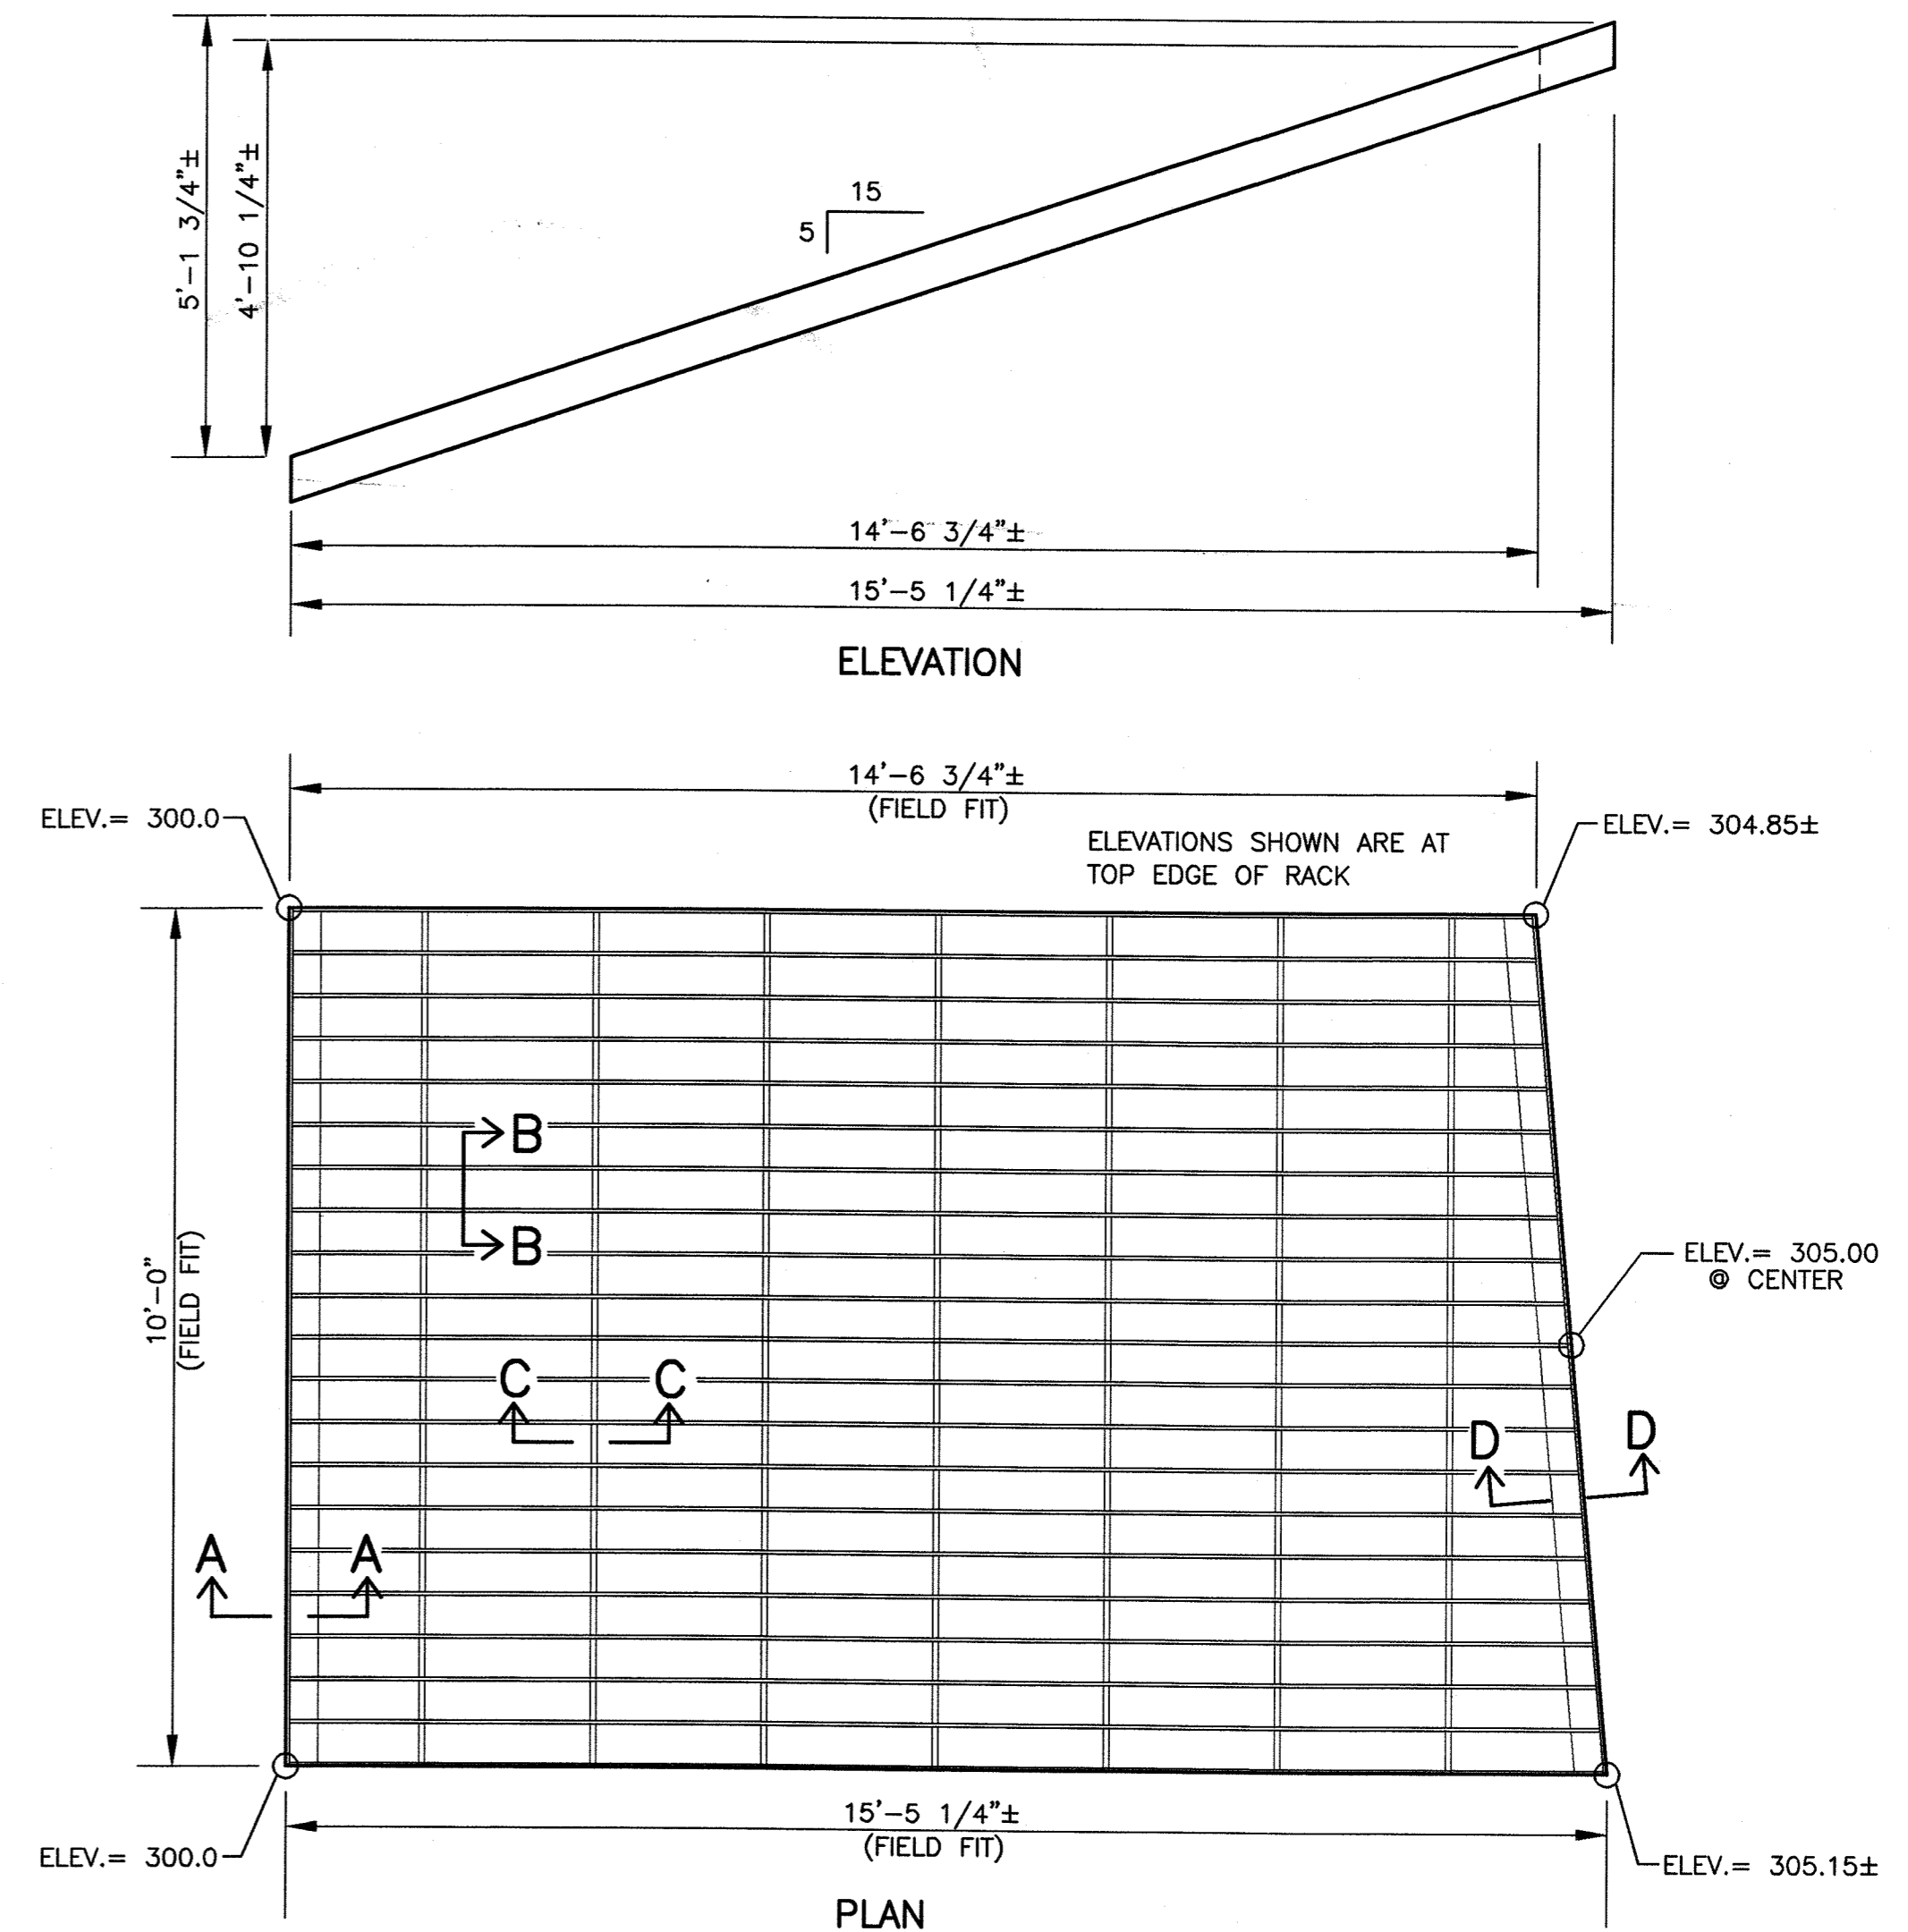

BAR GRATING NO. 1
 GODFREY BROOK DIVERSION STRUCTURE
 1/2"= 1'

DRAWING NO. **25** OF **35** SHEETS

BAYSTATE ENVIRONMENTAL CONSULTANTS INC.
 Surveyors
 East Longmeadow, MA 01028
 Scientists
 296 North Main Street
 Engineers

DEC


PROJECT NO. 94-1215
 SCALE AS NOTED
 DATE APRIL 1999
 DRAWN BY EDM
 CHECKED BY TEJ

Godfrey Brook Diversion Structure
Godfrey Brook Flood Mitigation Project
Milford, Massachusetts

NO.	DATE	REVISION	BY
3	10/01	ISSUED AS RECORD PRINT	EDM
2	11/13/00	GODFREY BROOK DIVERSION STRUCTURE, MISC. EDITS	TEJ
1	8/12/99	ISSUED FOR BIDDING	TEJ

AutoCAD File: P:\AUTOCAD\WACAD\N\941215\RECOPD DRAWINGS\Sheet 25 and 25-A.dwg Plotted at: Tue Oct 02 09:23:23 2001
 BEC, Inc.

SEE SHEET 26 FOR C-C & D-D

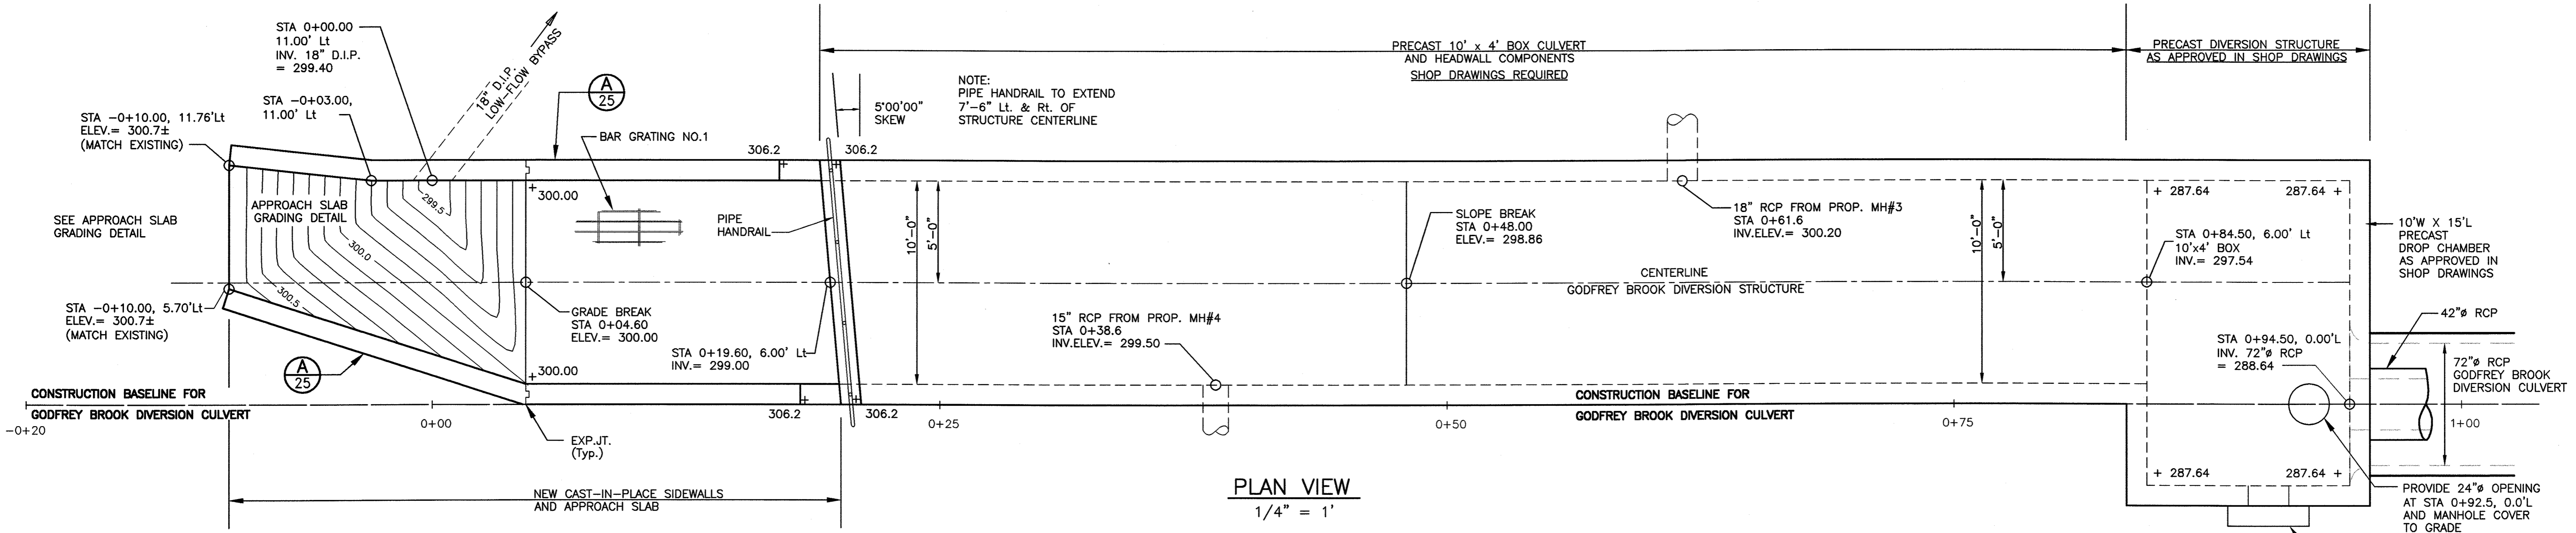

PRECAST CULVERT & STRUCTURE DESIGN NOTES

CONCRETE MINIMUM STRENGTH = 5000 PSI @ 28 DAYS
 STEEL REINFORCEMENT - ASTM A615, GRADE 60
 WHEEL LOADING - AASHTO HS25-40
 COVER TO STEEL - 1.5 INCHES
 EARTH COVER - 0'-0" MINIMUM, 13'-6" MAXIMUM
 UNIT WEIGHT OF EARTH - 125 POUNDS PER CUBIC FOOT
 ACTIVE PRESSURE COEFFICIENT - 0.25 MIN., 0.5 MAX.
 2'-0" LIVE LOAD SURCHARGE APPLIED TO 13'-6" DEPTH
 EXTERIOR GROUND WATER AT FINISHED GRADE
 DESIGN SHALL BE IN ACCORDANCE WITH AASHTO SPECIFICATIONS FOR HIGHWAY BRIDGES, ACI 318-83, AND LOAD FACTOR DESIGN (AASHTO)

LOAD FACTORS
 DEAD LOAD 1.5
 LIVE LOAD 2.17
 HYDROSTATIC PRESSURE 1.4
 EARTH PRESSURE, HORIZ. 1.7

CAPACITY REDUCTION FACTORS
 SHEAR 0.85
 MOMENT 0.90

WEEP HOLES SHALL BE SUPPLIED IN CULVERT SECTIONS AND DIVERSION STRUCTURES AT RATE OF ONE (1) 4" Ø WEEP PER 8 LINEAR FEET OF VERTICAL FACE.


CAST-IN-PLACE CONCRETE NOTES:

1. CONCRETE f'_c = 4,000 psi, Class A
2. REINF. - ASTM A-61 GRADE 60, EPOXY COATED
3. ALL SURFACES VISIBLE WHEN COMPLETED SHALL HAVE RUBBED FINISH.
4. 1"x1" CHAMFER ALL CONC. CORNERS


SIDEWALL LAYOUT INFORMATION:

LEFT SIDEWALL:	BOTTOM OF FOOTING:
STA. -0+11.5 TO 0+04.60	ELEV. 297.00
STA. 0+02.6 TO 0+19.1±	ELEV. 296.00


RIGHT SIDEWALL:	BOTTOM OF FOOTING:
STA. -0+11.5 TO 0+04.60	ELEV. 297.00
STA. 0+02.6 TO 0+20.1±	ELEV. 296.00

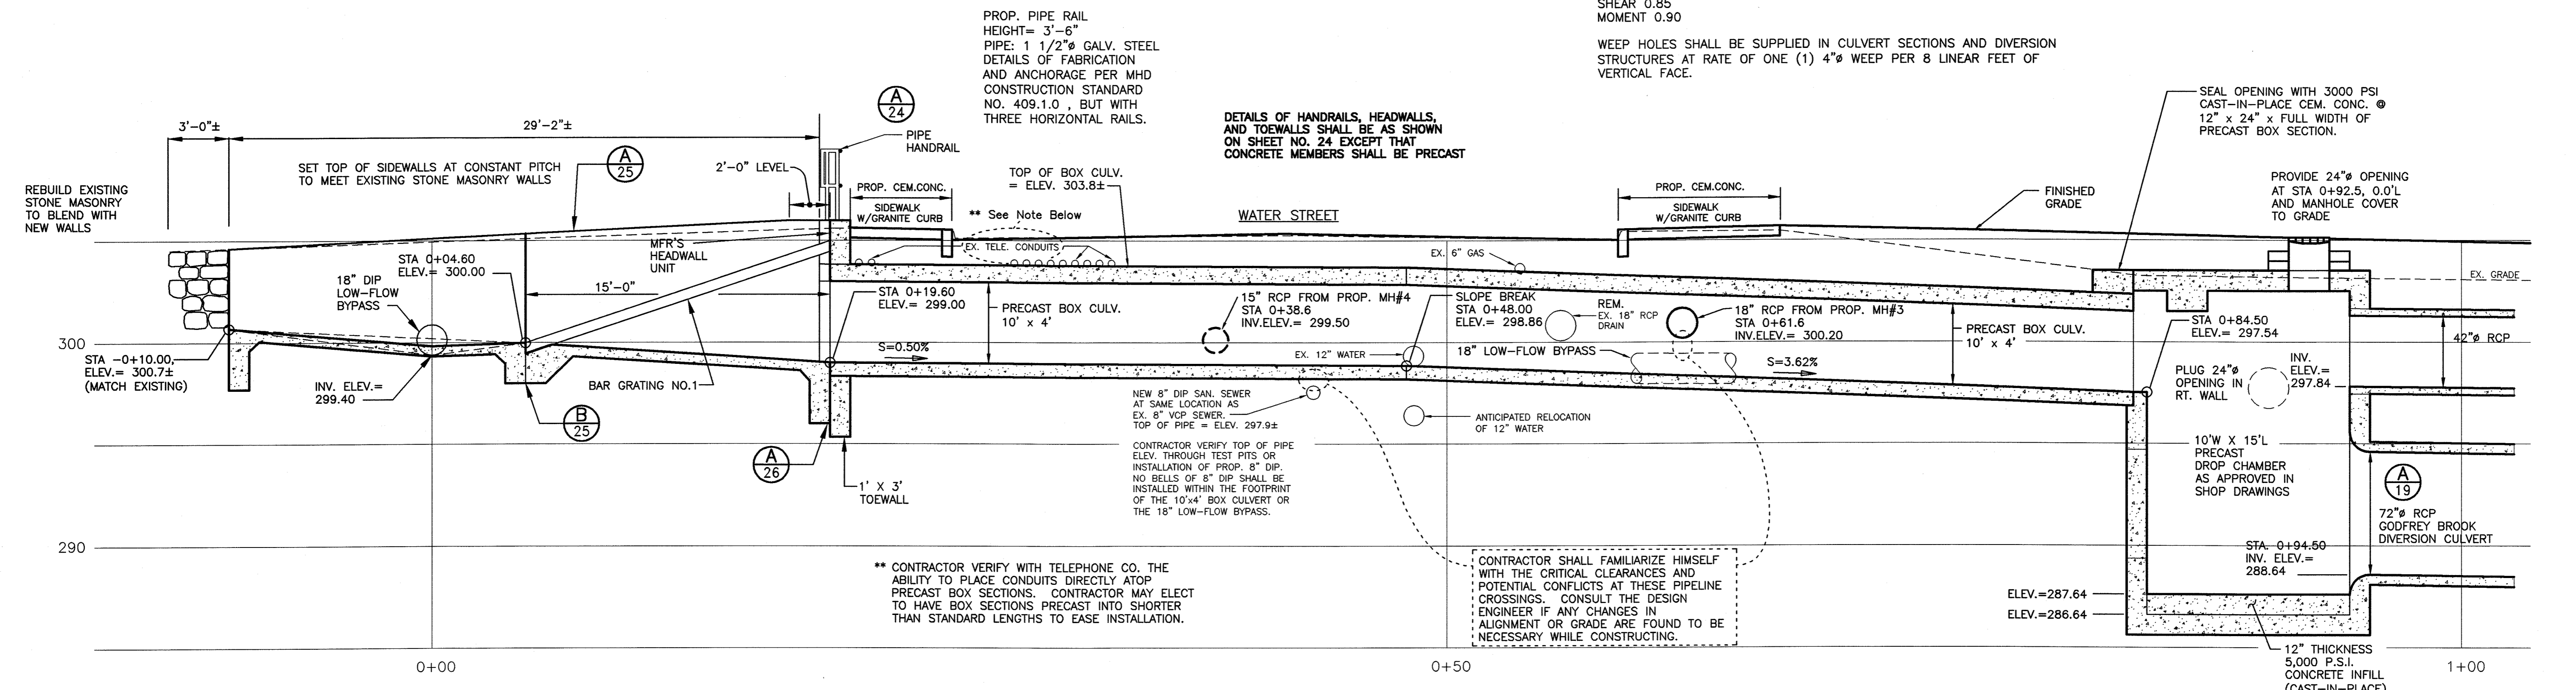


AutoCAD File: P:\AUTOCAD\CDM\IN\941215\RECORD DRAWINGS\Sheet 25 and 25-A.dwg Plotted at: Tue Oct 02 09:24:12 2001 BEC, Inc.

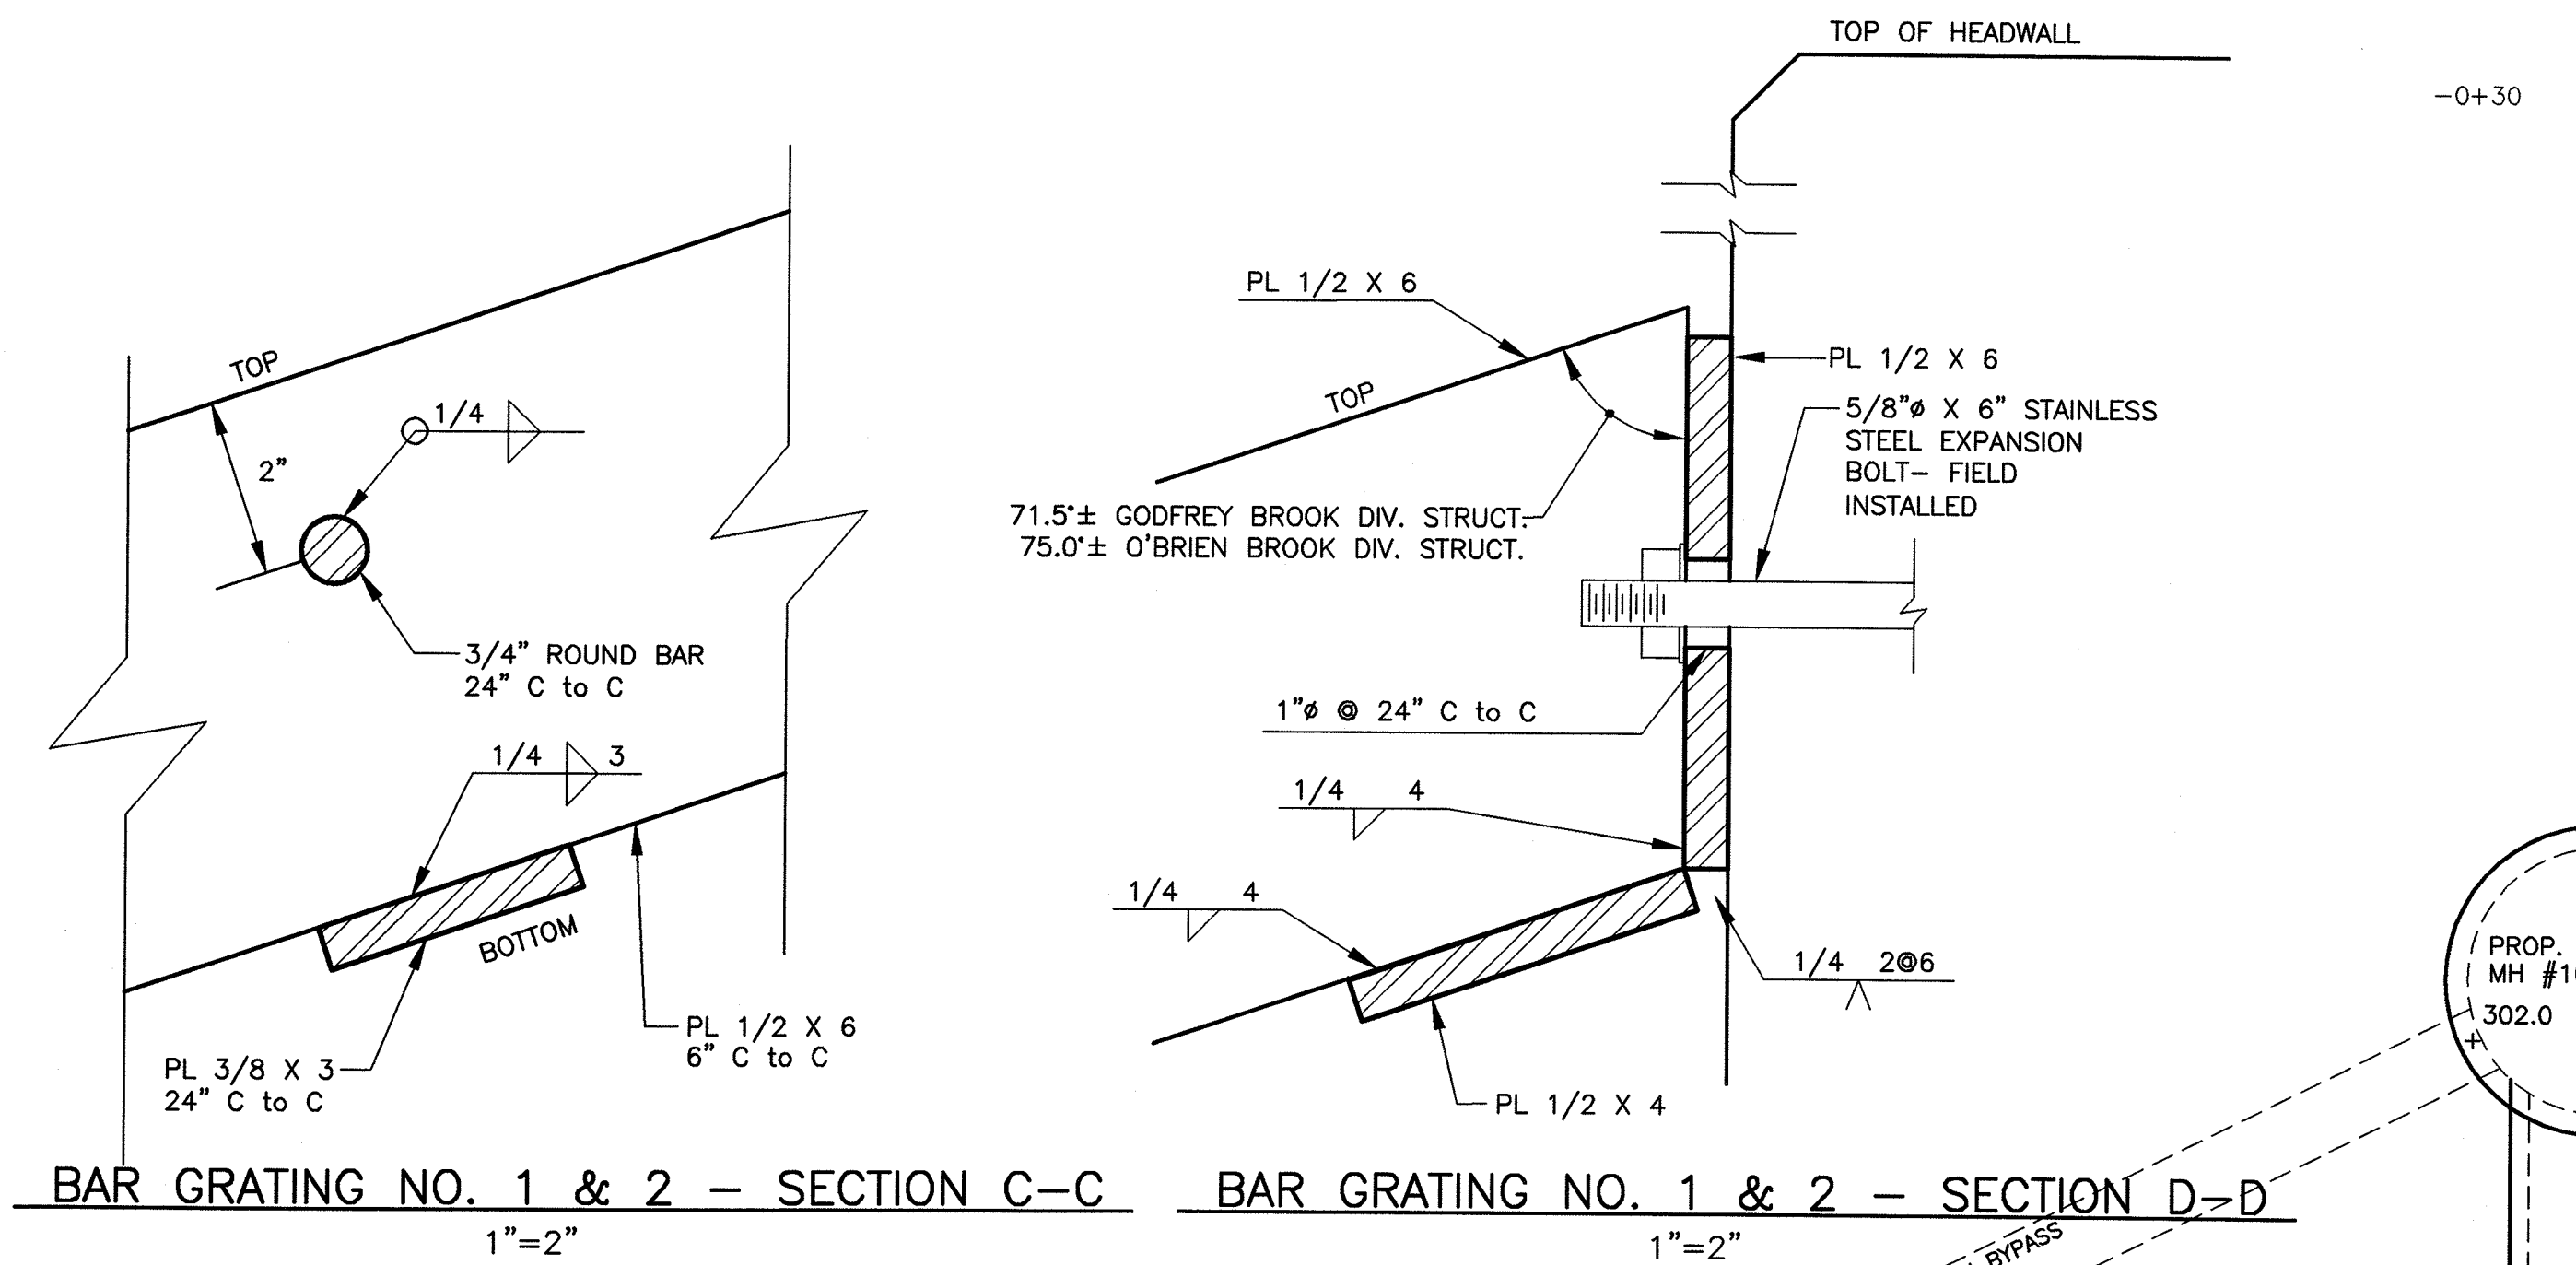


BAR GRATING NO. 1 & 2 - SECTION C-C
1"=2"
SEE SHEET 25 FOR A-A & B-B

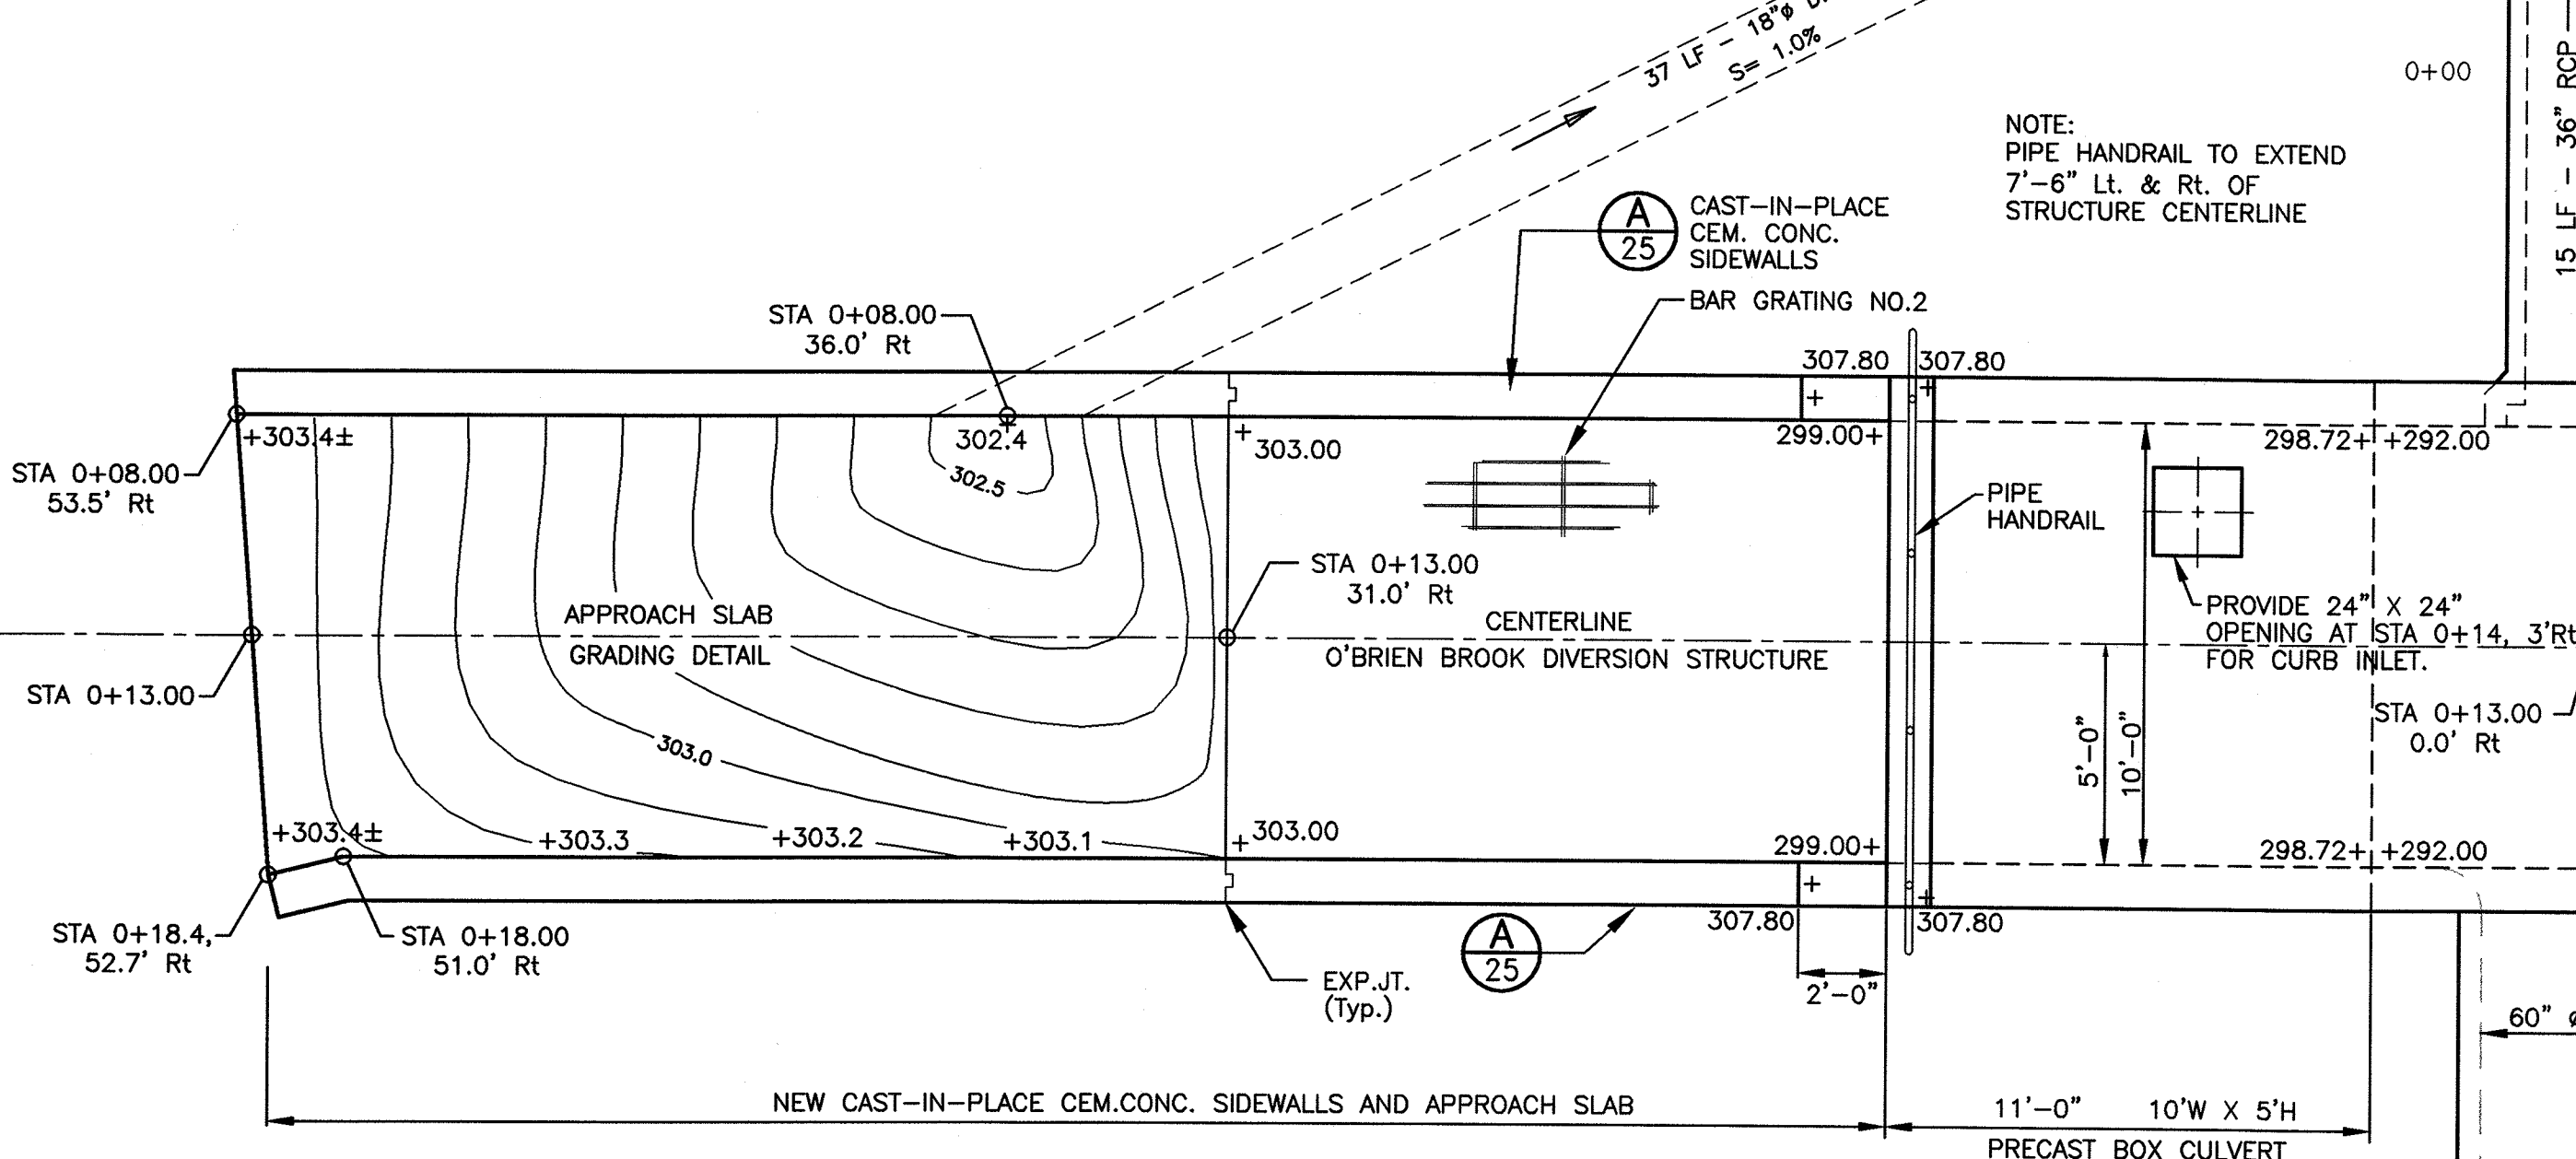

PLAN VIEW
1/4" = 1'

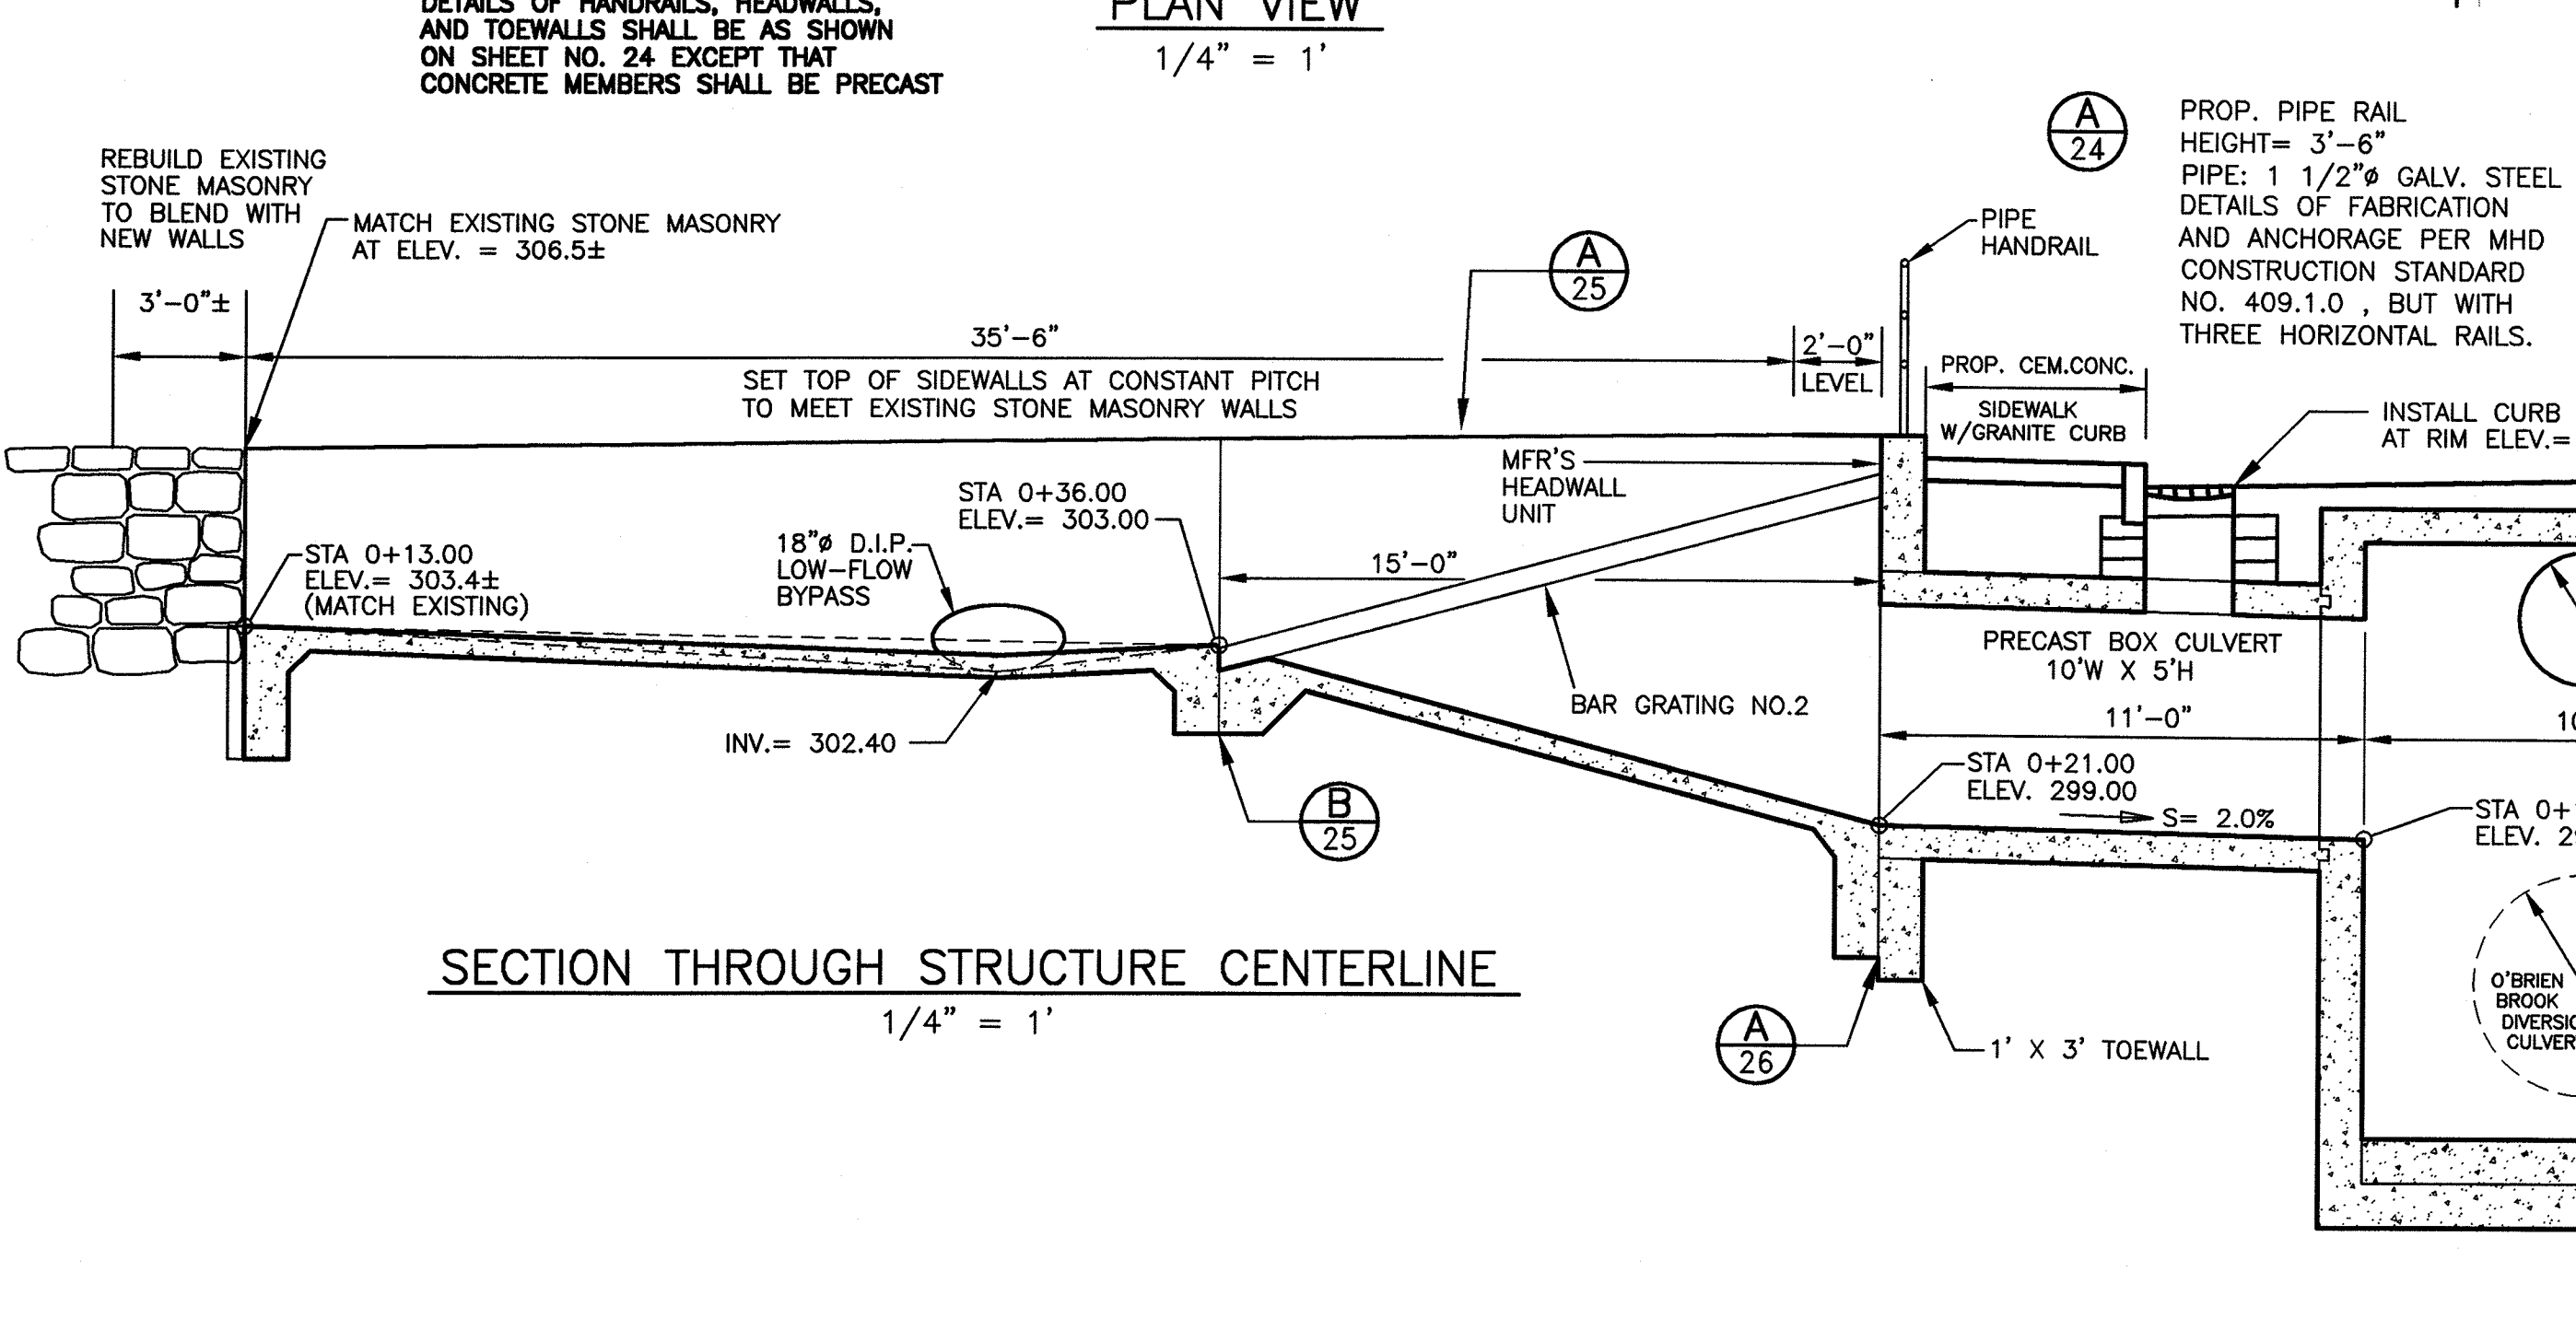

SECTION THROUGH STRUCTURE CENTERLINE
1/4" = 1'

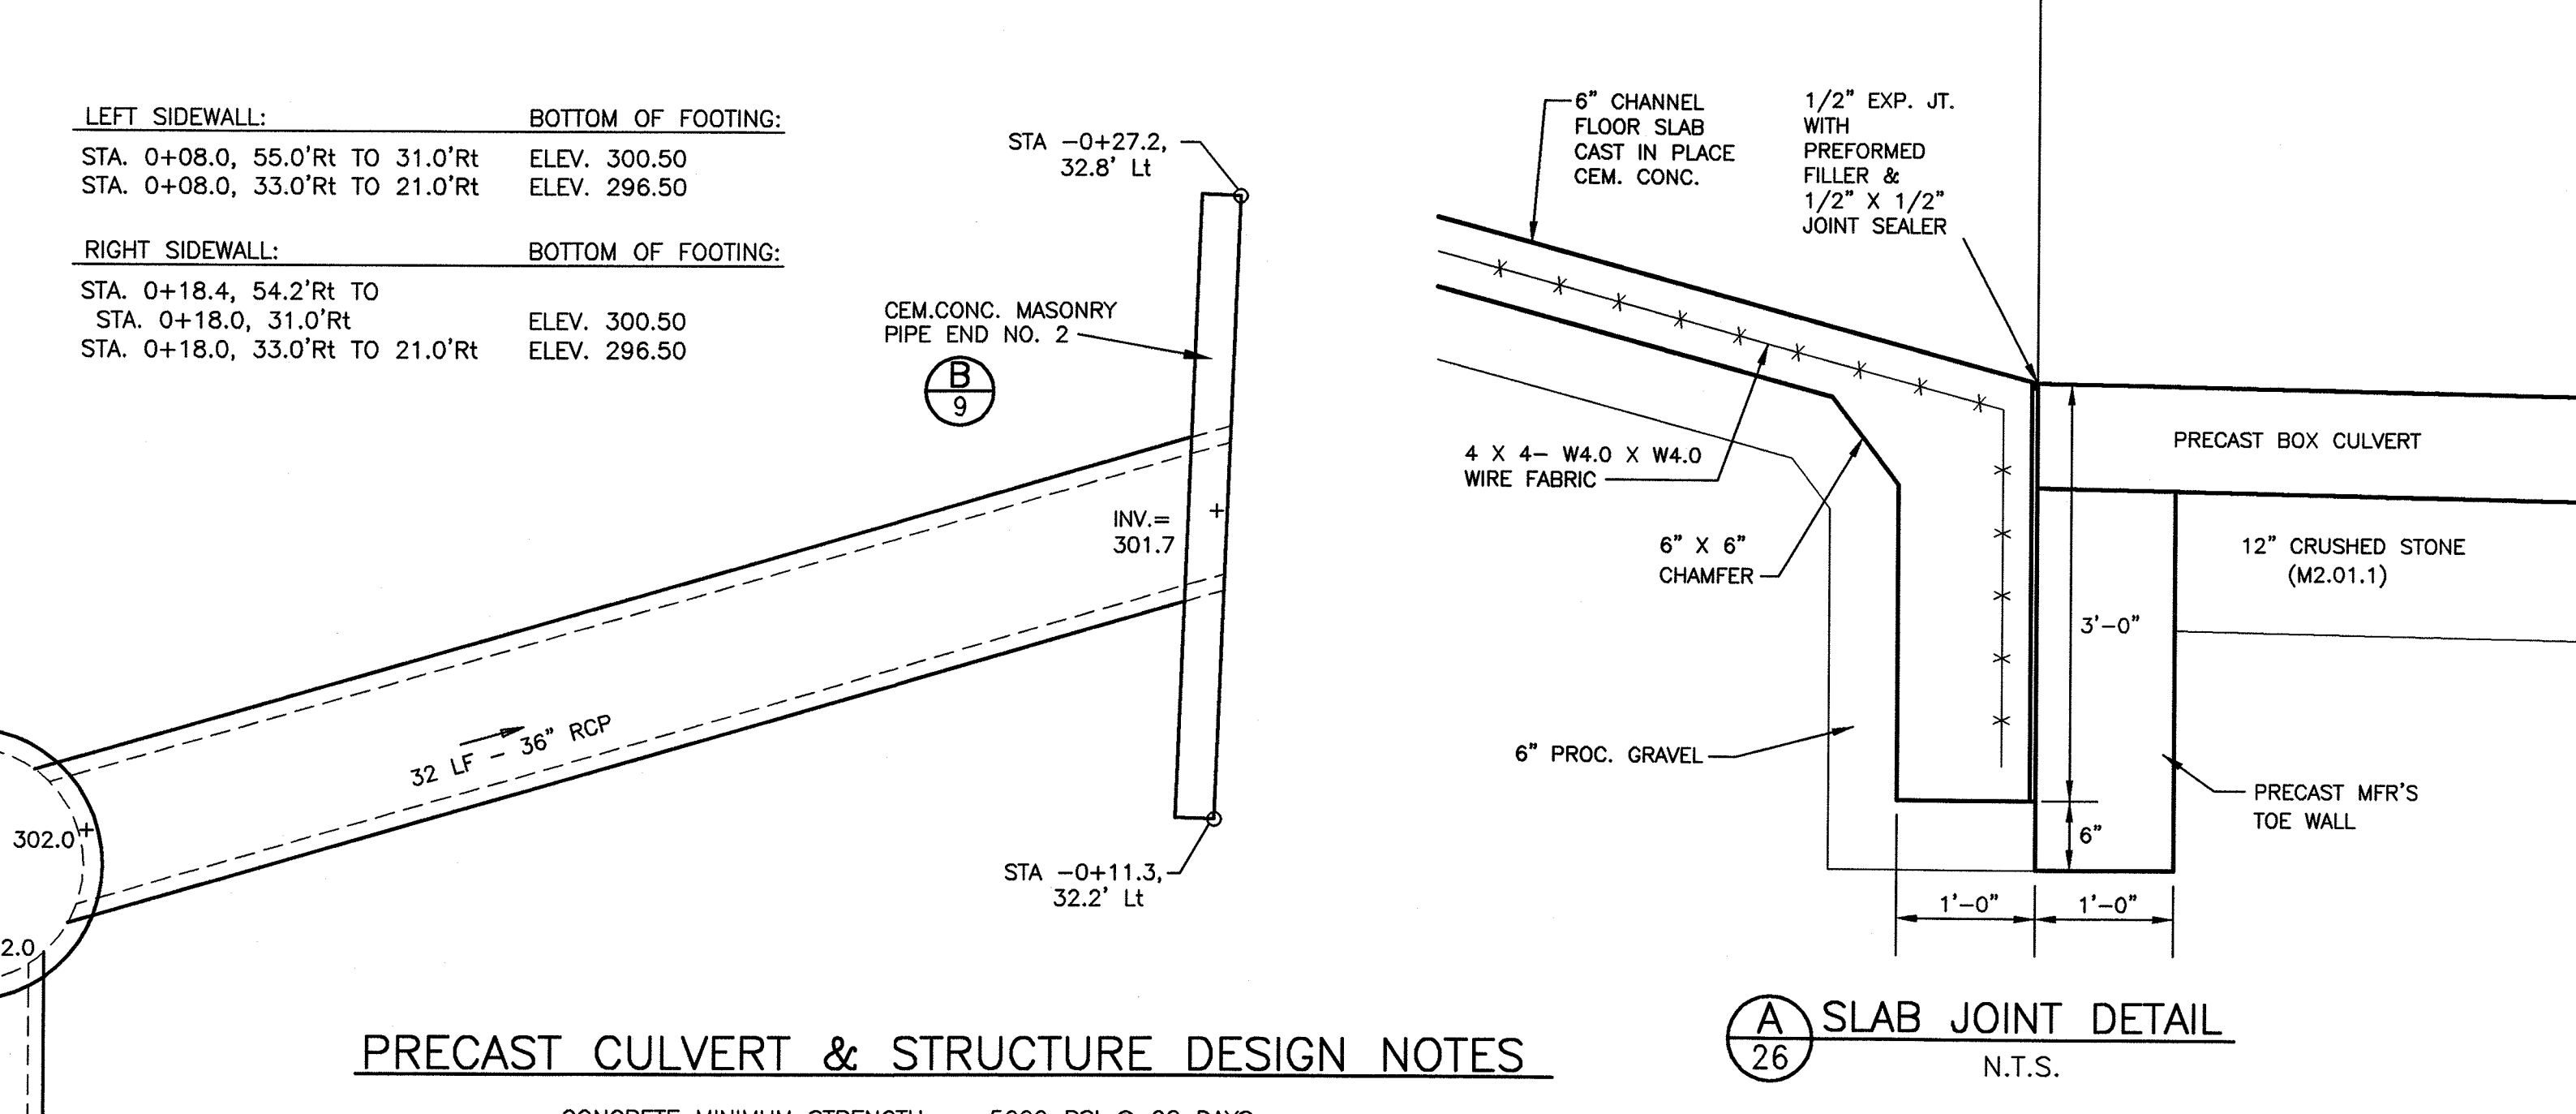


PRECAST CULVERT & STRUCTURE DESIGN NOTES

CONCRETE MINIMUM STRENGTH = 5000 PSI @ 28 DAYS
 STEEL REINFORCEMENT - ASTM A615, GRADE 60
 WHEEL LOADING - AASHTO HS25-40
 COVER TO STEEL - 1.5 INCHES
 EARTH COVER - 0'-0" MINIMUM, 13'-6" MAXIMUM
 UNIT WEIGHT OF EARTH - 125 POUNDS PER CUBIC FOOT
 ACTIVE PRESSURE COEFFICIENT - 0.25 MIN., 0.5 MAX.
 2'-0" LIVE LOAD SURCHARGE APPLIED TO 13'-6" DEPTH
 EXTERIOR GROUND WATER AT FINISHED GRADE
 DESIGN SHALL BE IN ACCORDANCE WITH AASHTO SPECIFICATIONS
 FOR HIGHWAY BRIDGES, ACI 318-83, AND LOAD FACTOR DESIGN (AASHTO)


LOAD FACTORS: DEAD LOAD 1.5 LIVE LOAD 2.17
 HYDROSTATIC PRESSURE 1.4 EARTH PRESSURE, HORIZ. 1.7

CAPACITY REDUCTION FACTORS: SHEAR 0.85 MOMENT 0.90

WEEP HOLES SHALL BE SUPPLIED IN CULVERT SECTIONS AND
 DIVERSION STRUCTURES AT RATE OF ONE (1) 4"φ WEEP PER
 8 LINEAR FEET OF VERTICAL FACE.

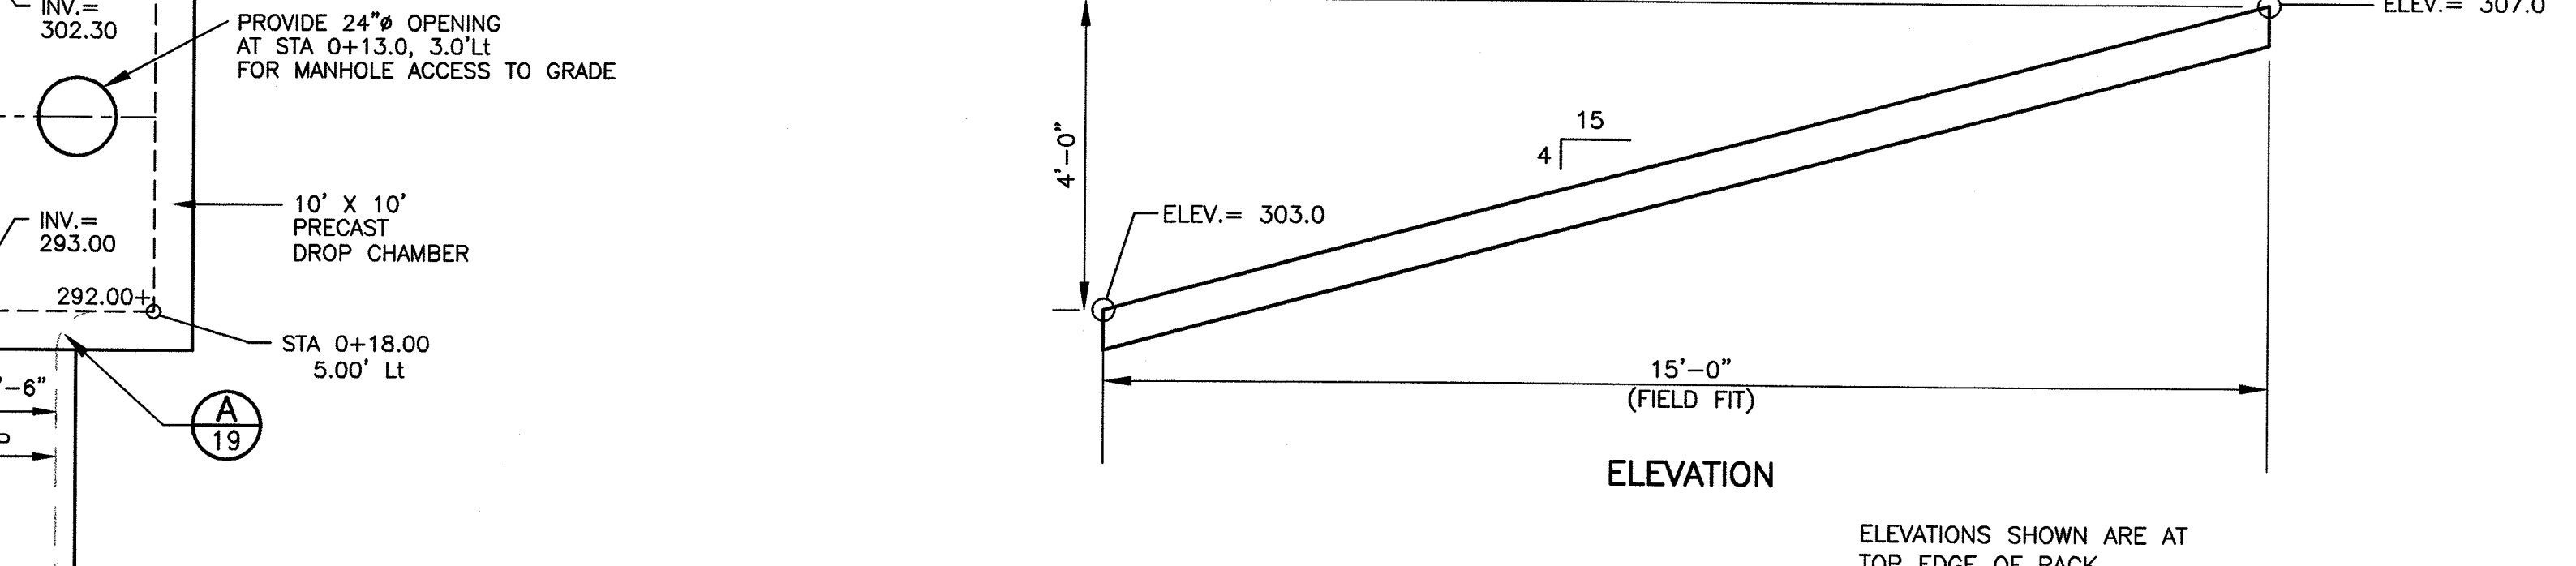

ELEVATION

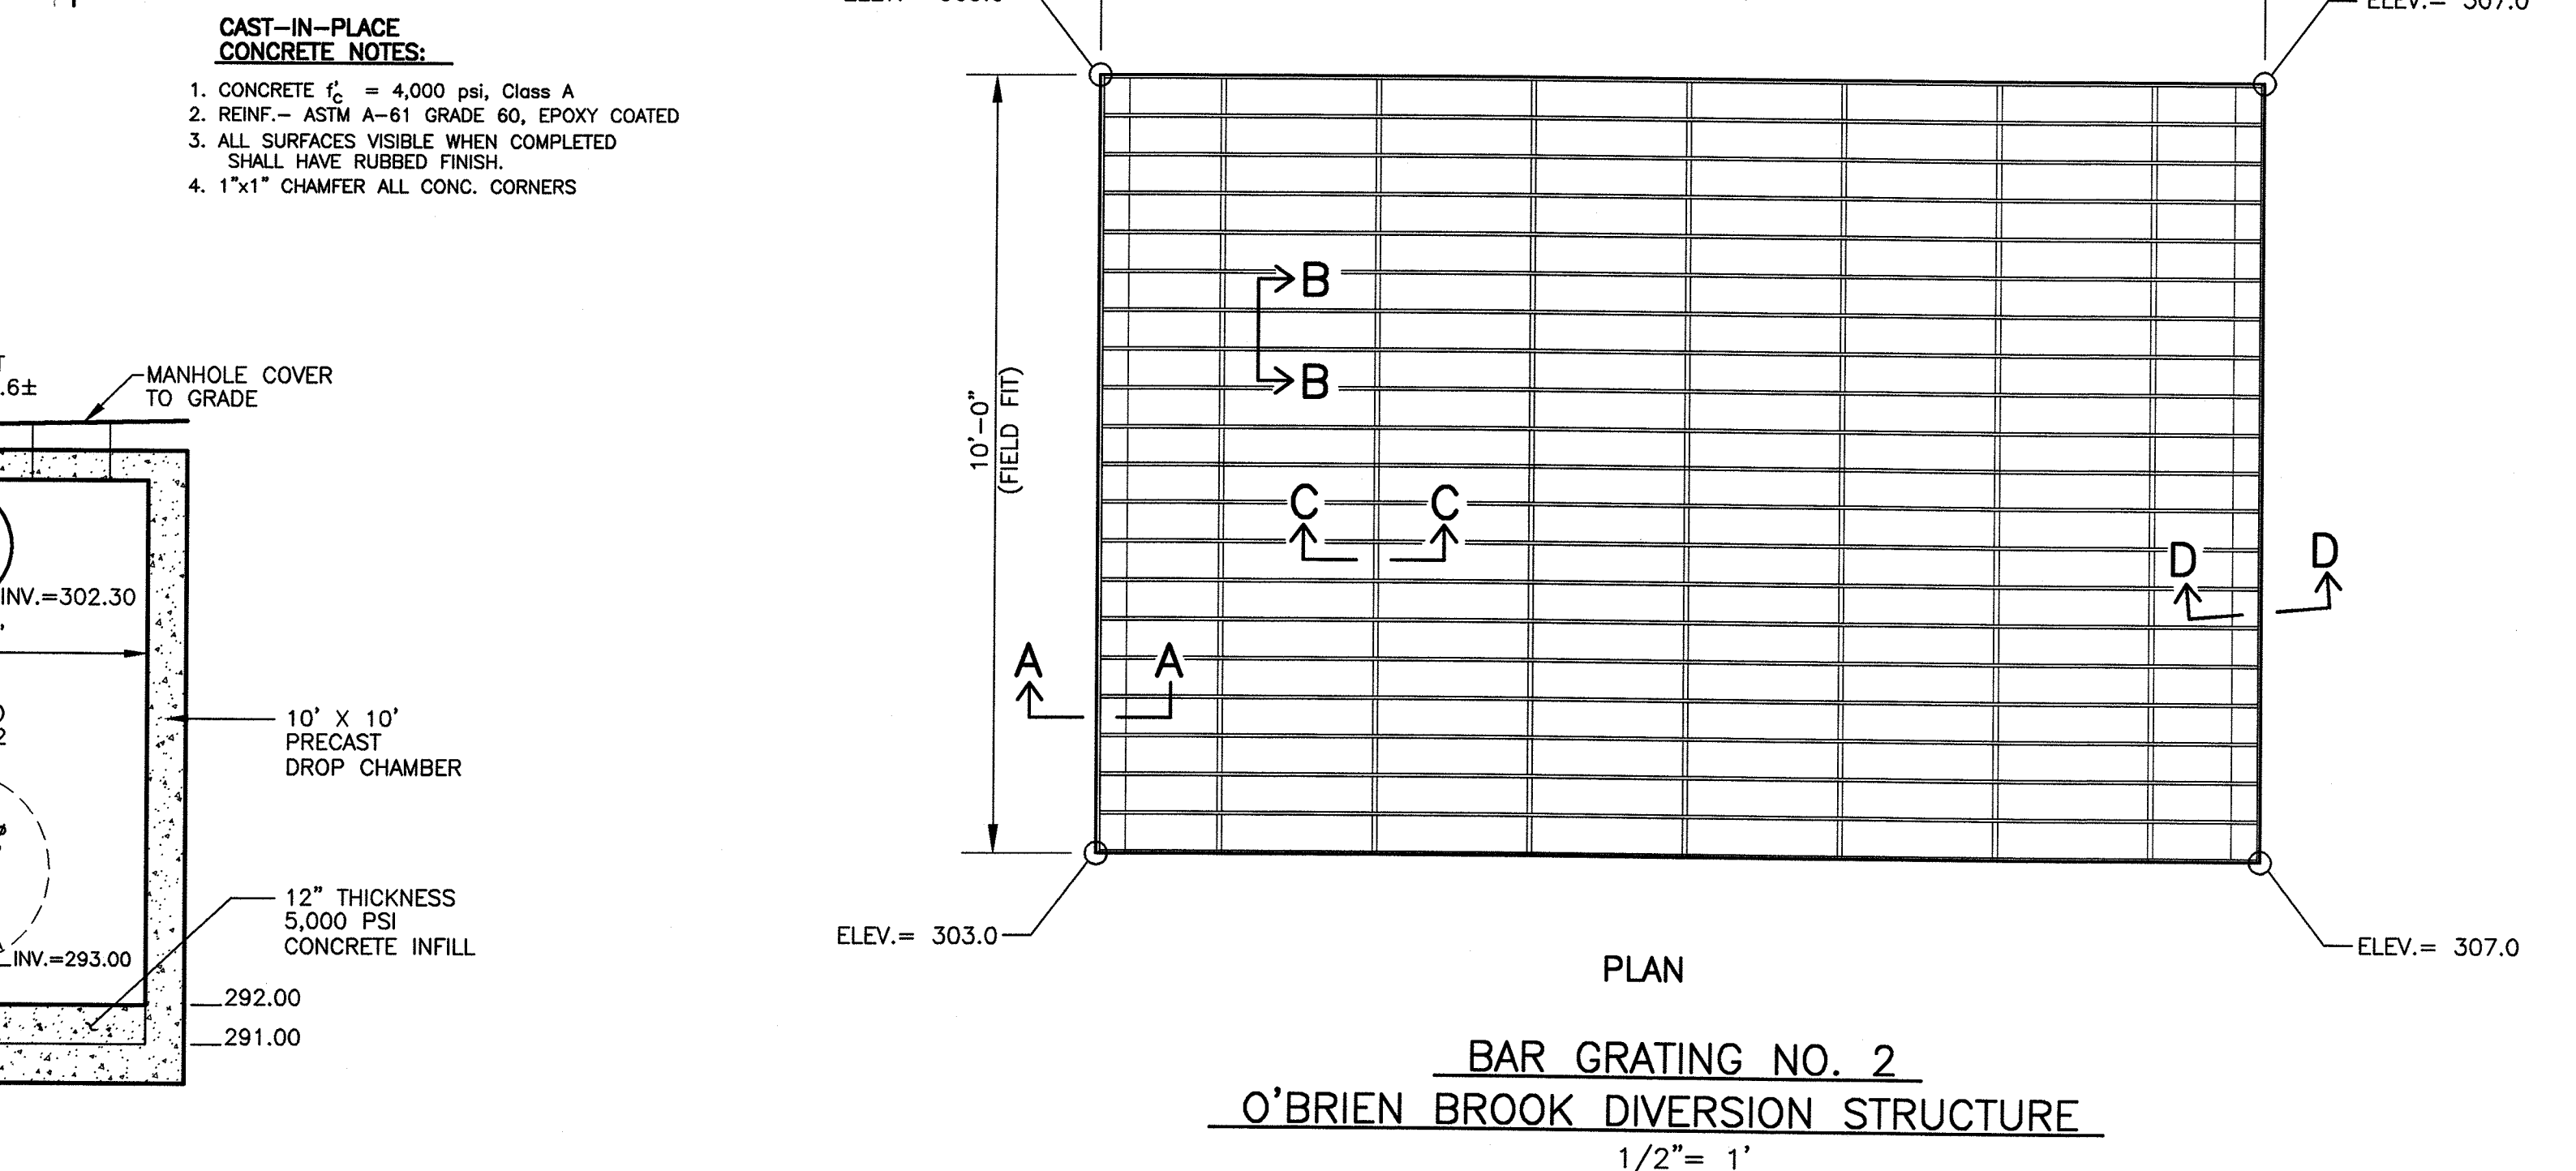

PLAN
BAR GRATING NO. 2
O'BRIEN BROOK DIVERSION STRUCTURE
1/2" = 1'

26 of 35 SHEETS

BAYSTATE ENVIRONMENTAL CONSULTANTS INC.
 Surveyors
 East Longmeadow, MA 01028
 Scientists
 286 North Main Street
 Milford, Massachusetts

DEC


PROJECT NO. 94-1215
 SCALE AS NOTED
 DATE APRIL 1999
 DRAWN BY EDM
 CHECKED BY TEJ

O'Brien Brook Diversion Structure
Godfrey Brook Flood Mitigation Project
Milford, Massachusetts

NO.	DATE	REVISION
1	8/12/99	ISSUED FOR BIDDING
2	10/1/01	ISSUED AS RECORD PRINT

AutoCAD File: P:\AUTOCAD\MCADWIN\944215\RECORD DRAWINGS\Sheets 24 26.dwg Plotted at: Tue Oct 02 09:36:41 2001
 BEC, Inc.


AutoCAD File: P:\AUTOCAD\ACAD\MN\941215\RECORD DRAWINGS\Sheet 27 28.dwg Plotted at: Tue Oct 02 08:26:21 2001
BEC, Inc.

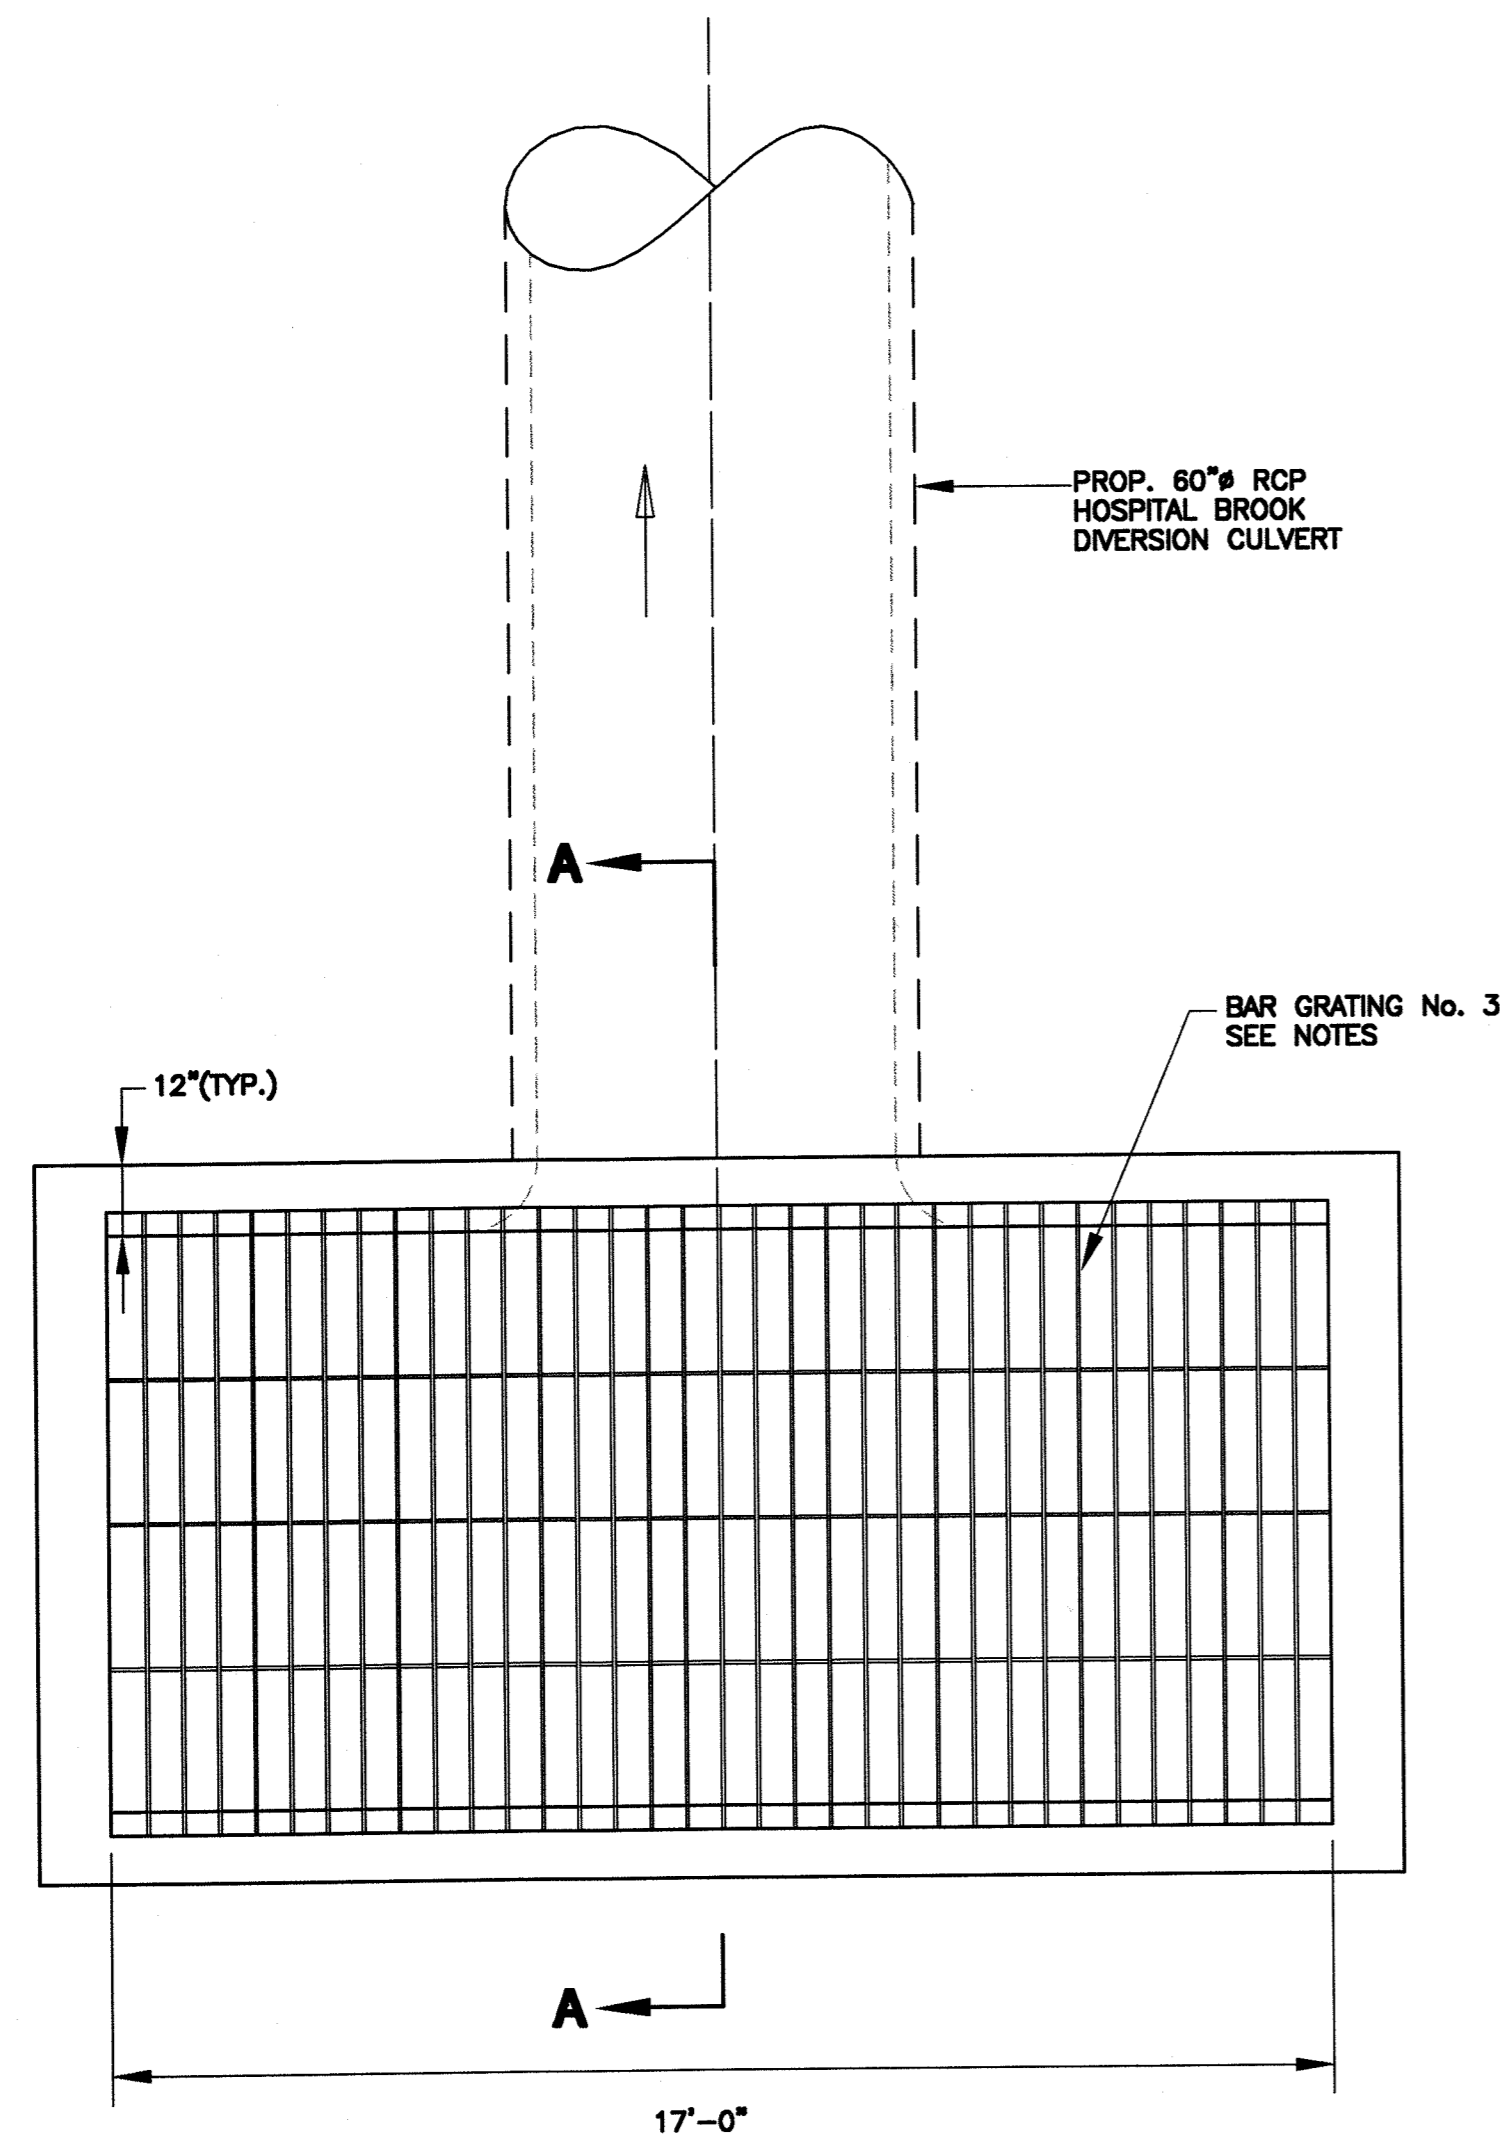


PLAN VIEW
3/8" = 1'-0"

BAR GRATING NOTES:


1. ALL STEEL SHALL CONFORM TO THE REQUIREMENTS OF AASHTO-M183.
2. BAR GRATING PANELS SHALL BE FABRICATED IN FULL LENGTH PANELS. MINIMUM PANEL WIDTH = 3'-0".
3. BAR GRATING PANELS SHALL BE HOT-DIP GALVANIZED AFTER FABRICATION AND TEST FITTING. GALVANIZING SHALL MEET THE REQUIREMENTS OF AASHTO-M11 "ZINC (HOT-GALVANIZED) COATINGS ON PRODUCTS FABRICATED FROM ROLLED, PRESSED, AND FORGED STEEL SHAPES, PLATES, BARS, AND STRIP."

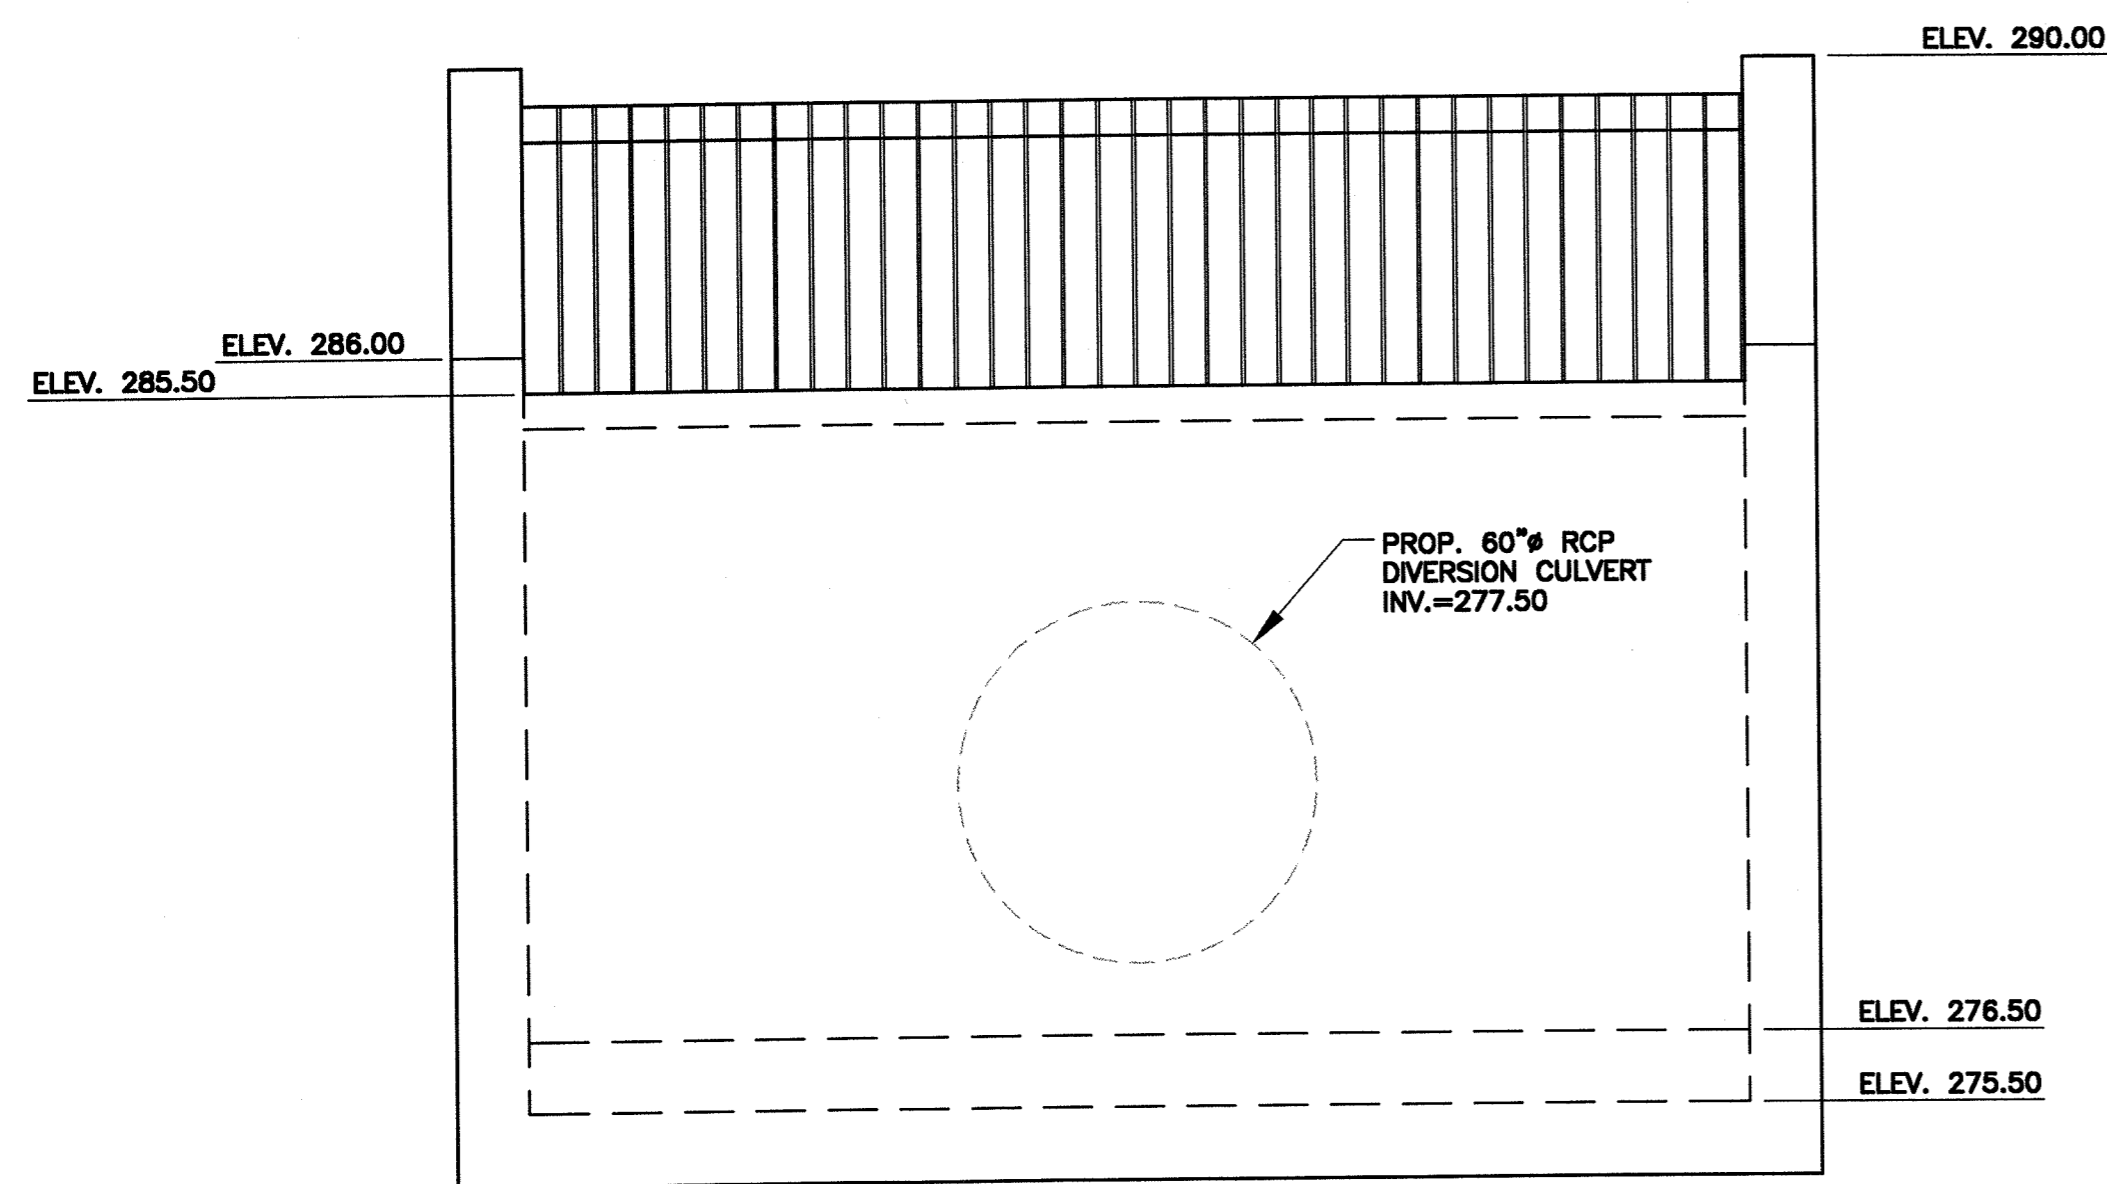

FRONT ELEVATION
3/8" = 1'-0"

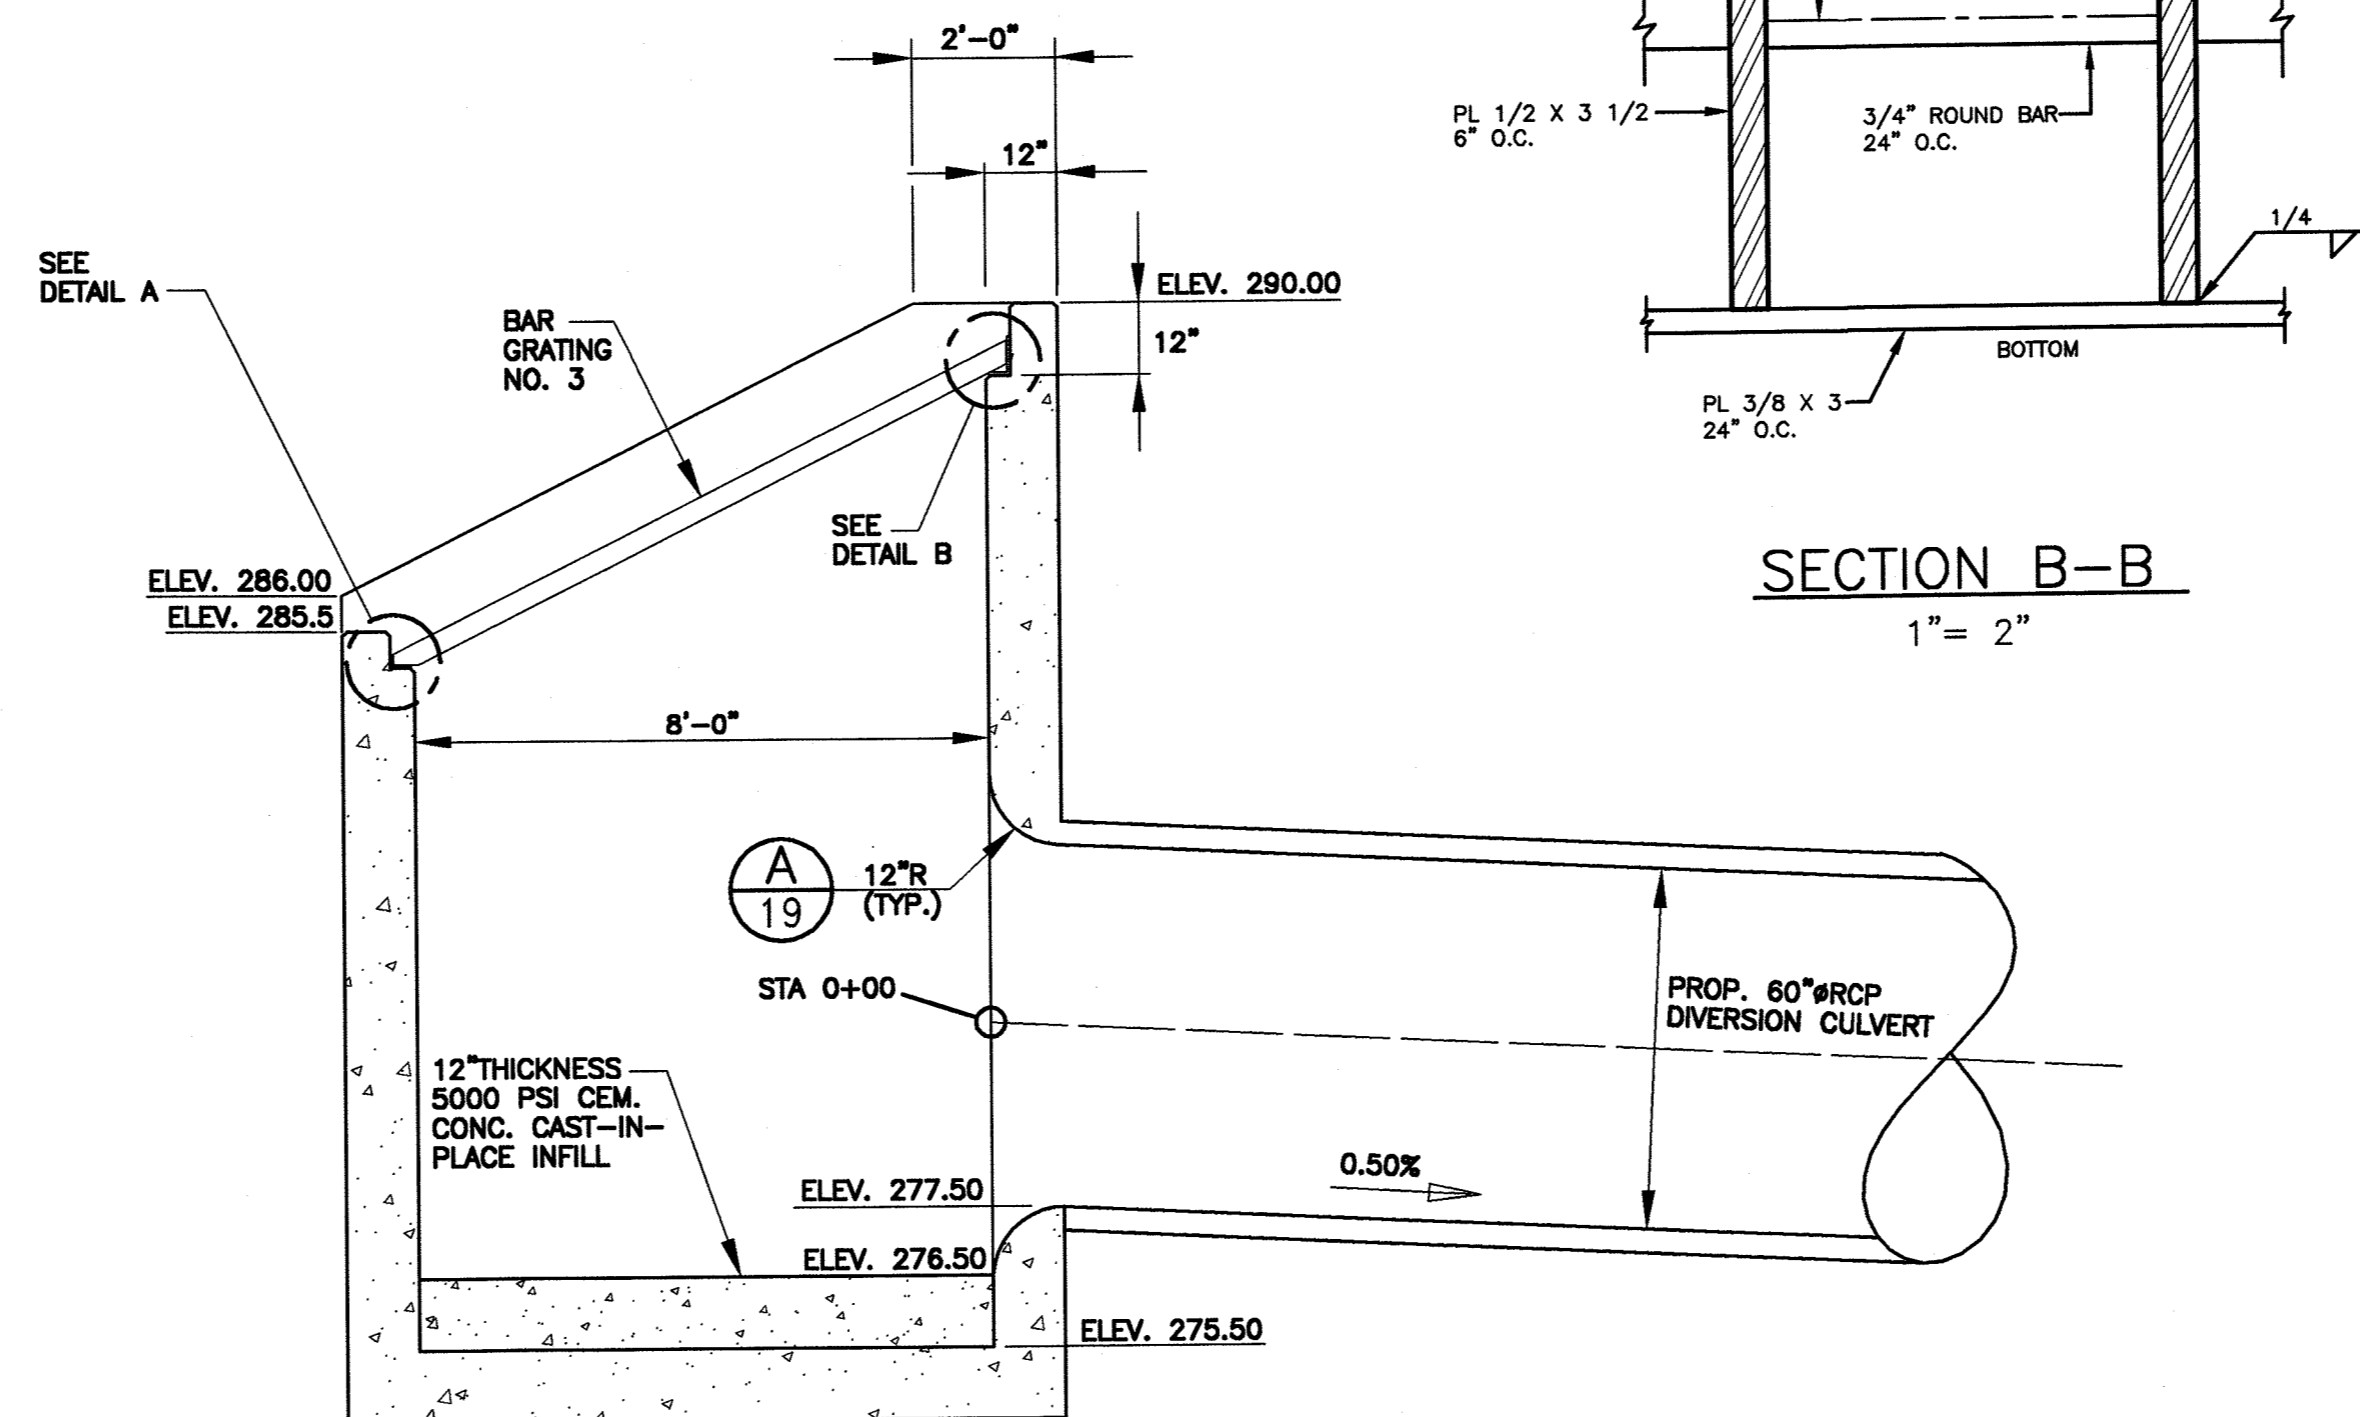

SECTION A-A
3/8" = 1'-0"

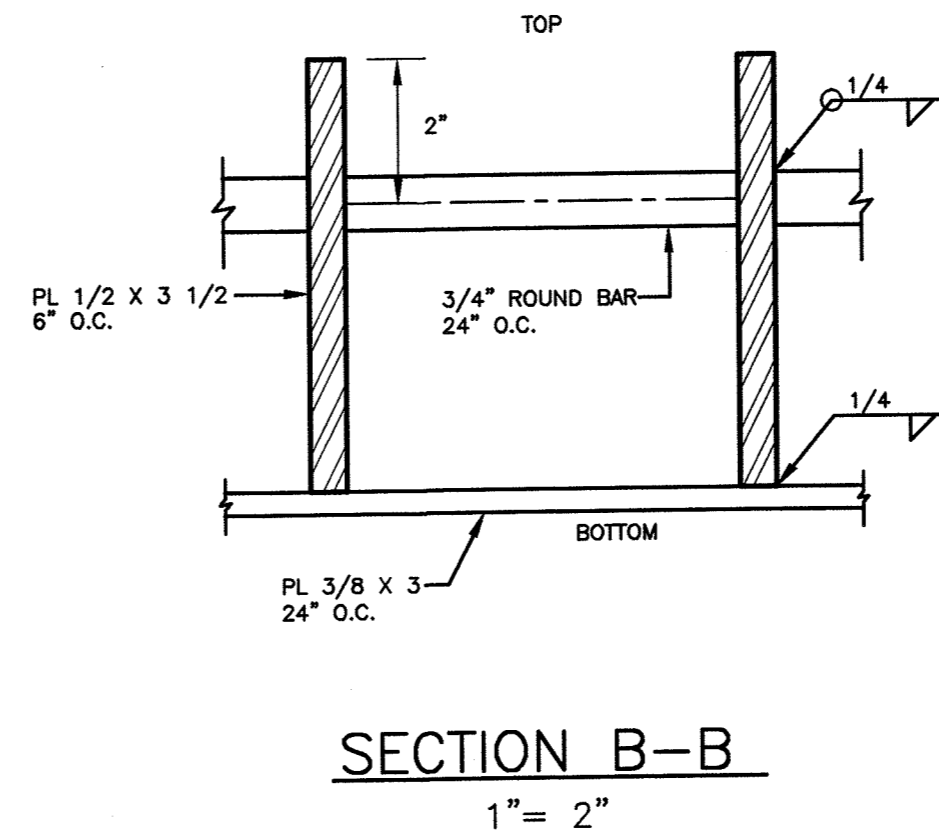

SECTION B-B
1" = 2"


PRECAST STRUCTURE DESIGN NOTES

CONCRETE MINIMUM STRENGTH = 5000 PSI @ 28 DAYS
 STEEL REINFORCEMENT - ASTM A615, GRADE 60
 WHEEL LOADING - AASHTO HS25-40
 COVER TO STEEL - 1.5 INCHES
 EARTH COVER - 0'-0" MINIMUM, 13'-6" MAXIMUM
 UNIT WEIGHT OF EARTH - 125 POUNDS PER CUBIC FOOT
 ACTIVE PRESSURE COEFFICIENT - 0.25 MIN., 0.5 MAX.
 2'-0" LIVE LOAD SURCHARGE APPLIED TO 13'-6" DEPTH
 EXTERIOR GROUND WATER AT FINISHED GRADE
 DESIGN SHALL BE IN ACCORDANCE WITH AASHTO SPECIFICATIONS FOR HIGHWAY BRIDGES, ACI 318-83, AND LOAD FACTOR DESIGN (AASHTO)


LOAD FACTORS
 DEAD LOAD 1.5
 LIVE LOAD 2.17
 HYDROSTATIC PRESSURE 1.4
 EARTH PRESSURE, HORIZ. 1.7

CAPACITY REDUCTION FACTORS
 SHEAR 0.85
 MOMENT 0.90


WEEP HOLES SHALL BE SUPPLIED IN CULVERT SECTIONS AND DIVERSION STRUCTURES AT RATE OF ONE (1) 4" Ø WEEP PER 8 LINEAR FEET OF VERTICAL FACE.

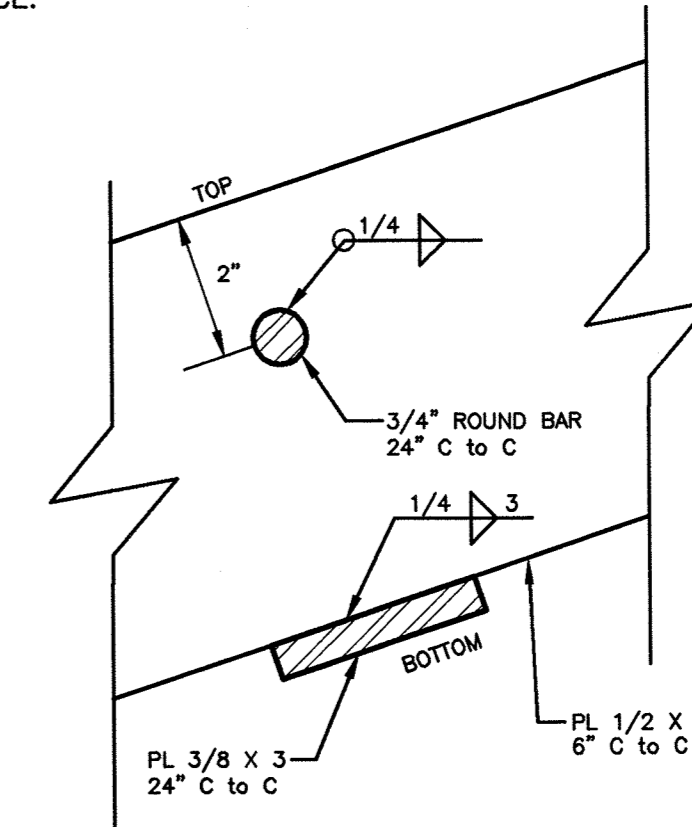

SECTION C-C
1" = 2"

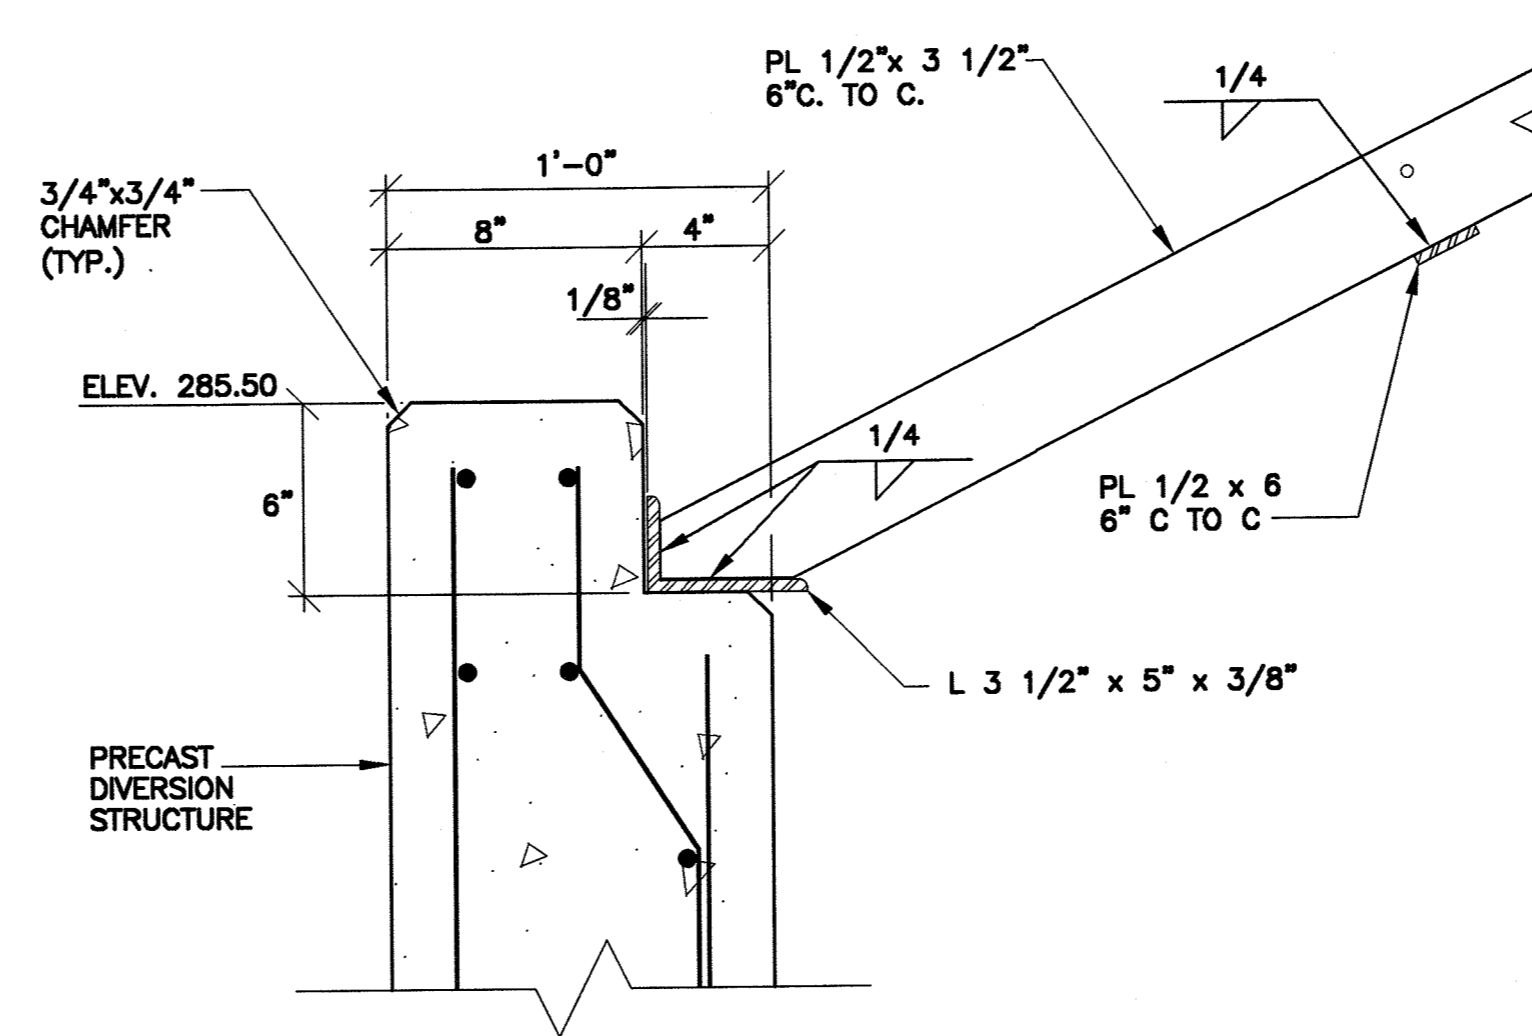

**BAR GRATING NO. 3
DETAIL A**
3/8" = 1'-0"

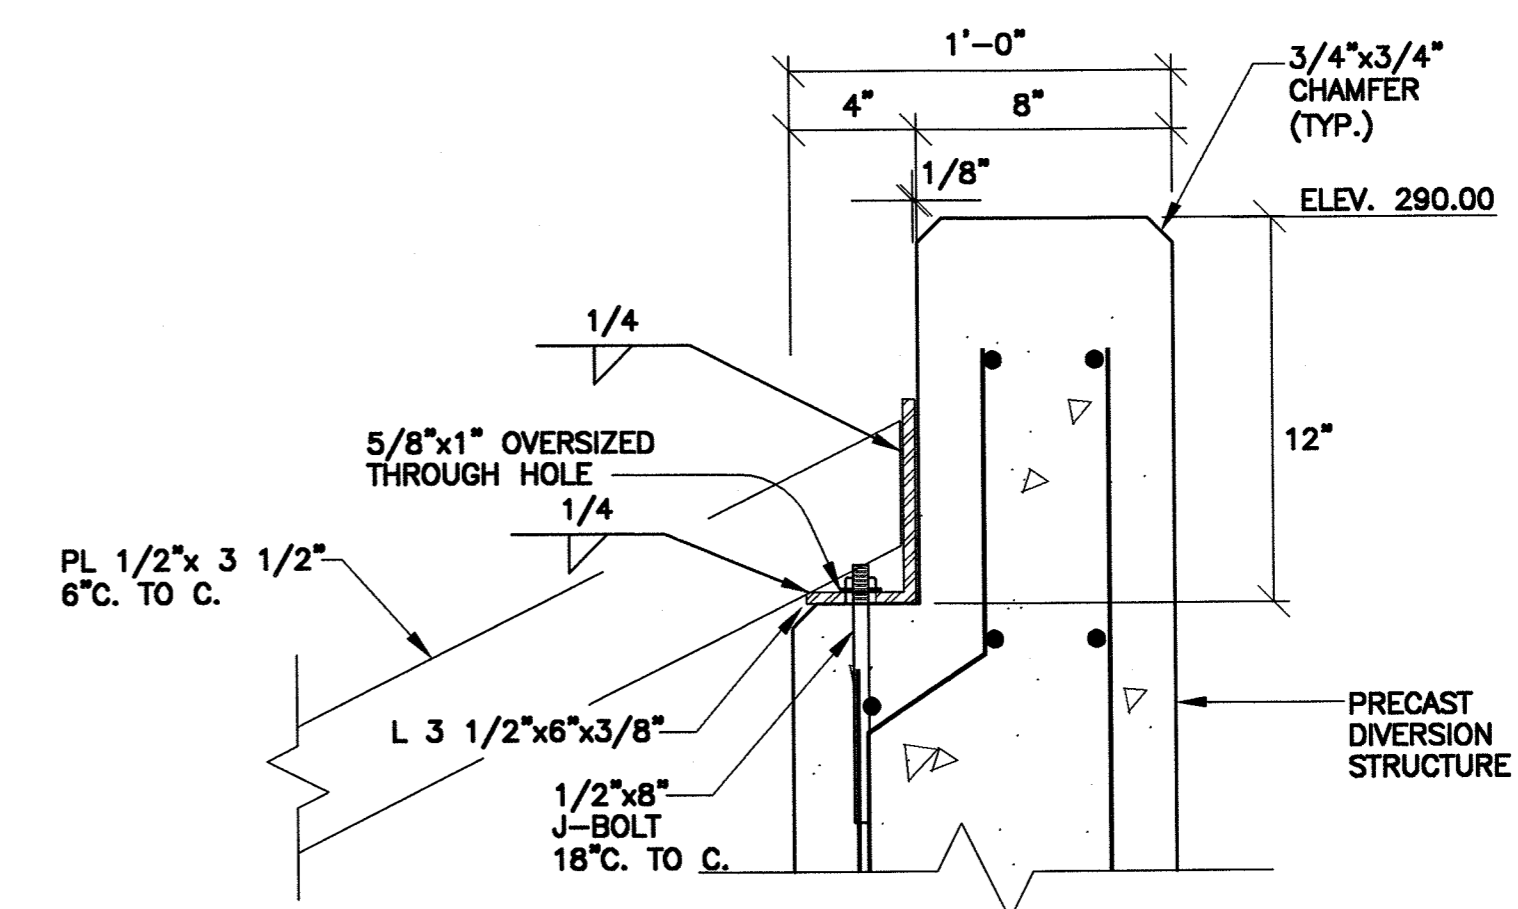


**BAR GRATING NO. 3
DETAIL B**
3/8" = 1'-0"

Entire Sheet to be Included Under Bid Alternative No. 1

PROJECT NO. 94-1215		SCALE AS NOTED		DATE APRIL 1999	
DRAWN BY EDM		CHECKED BY TEJ		DATE	
PROJECT TITLE		PROJECT		NO.	
Hospital Brook Diversion Structure		Godfrey Brook Flood Mitigation Project		1	
Miford, Massachusetts		Miford, Massachusetts		2	
ISSUED AS RECORD PRINT		ISSUED FOR BIDDING		REVISION	
10/1/01		9/12/99		DATE	
EDM		TEJ		BY	
2		1		NO.	


BAYSTATE ENVIRONMENTAL CONSULTANTS INC.
 Engineers
 286 North Main Street
 East Longmeadow, MA 01028

Scientists
 Surveyors

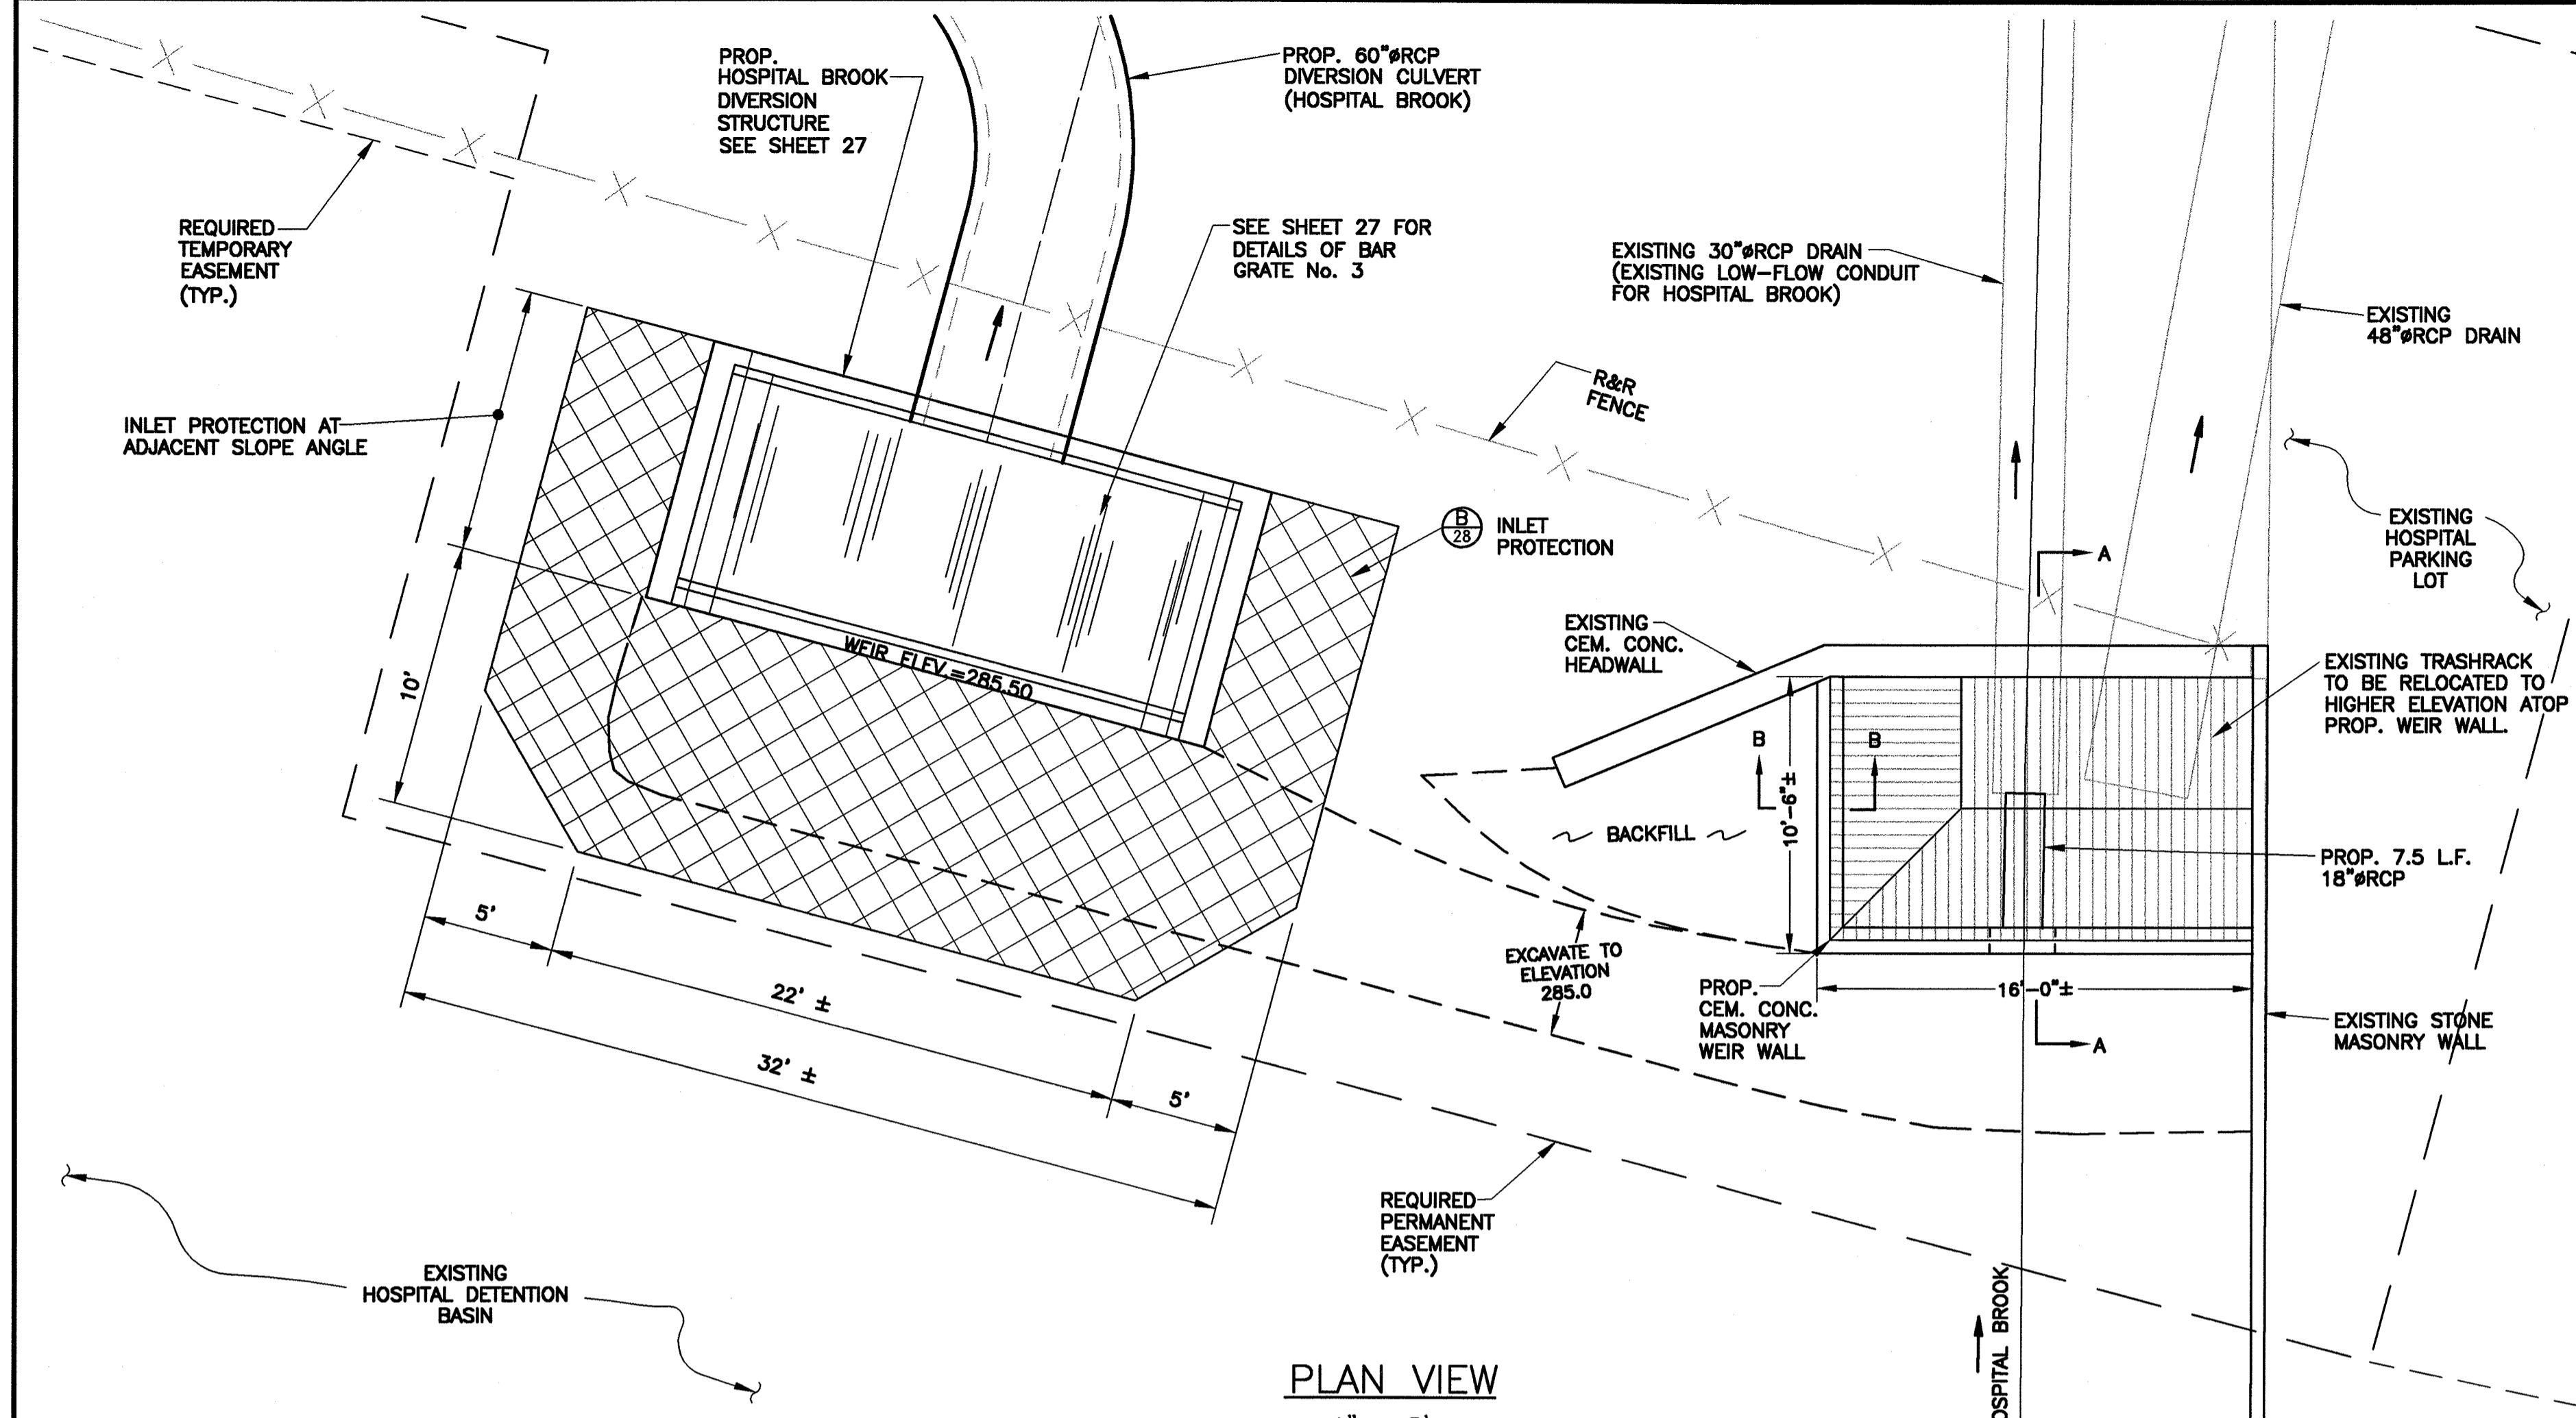


PLAN VIEW
1" = 5'

REFER TO SHEET 19 FOR PLAN/PROFILE OF HOSPITAL BROOK DIVERSION CULVERT IN THIS AREA.

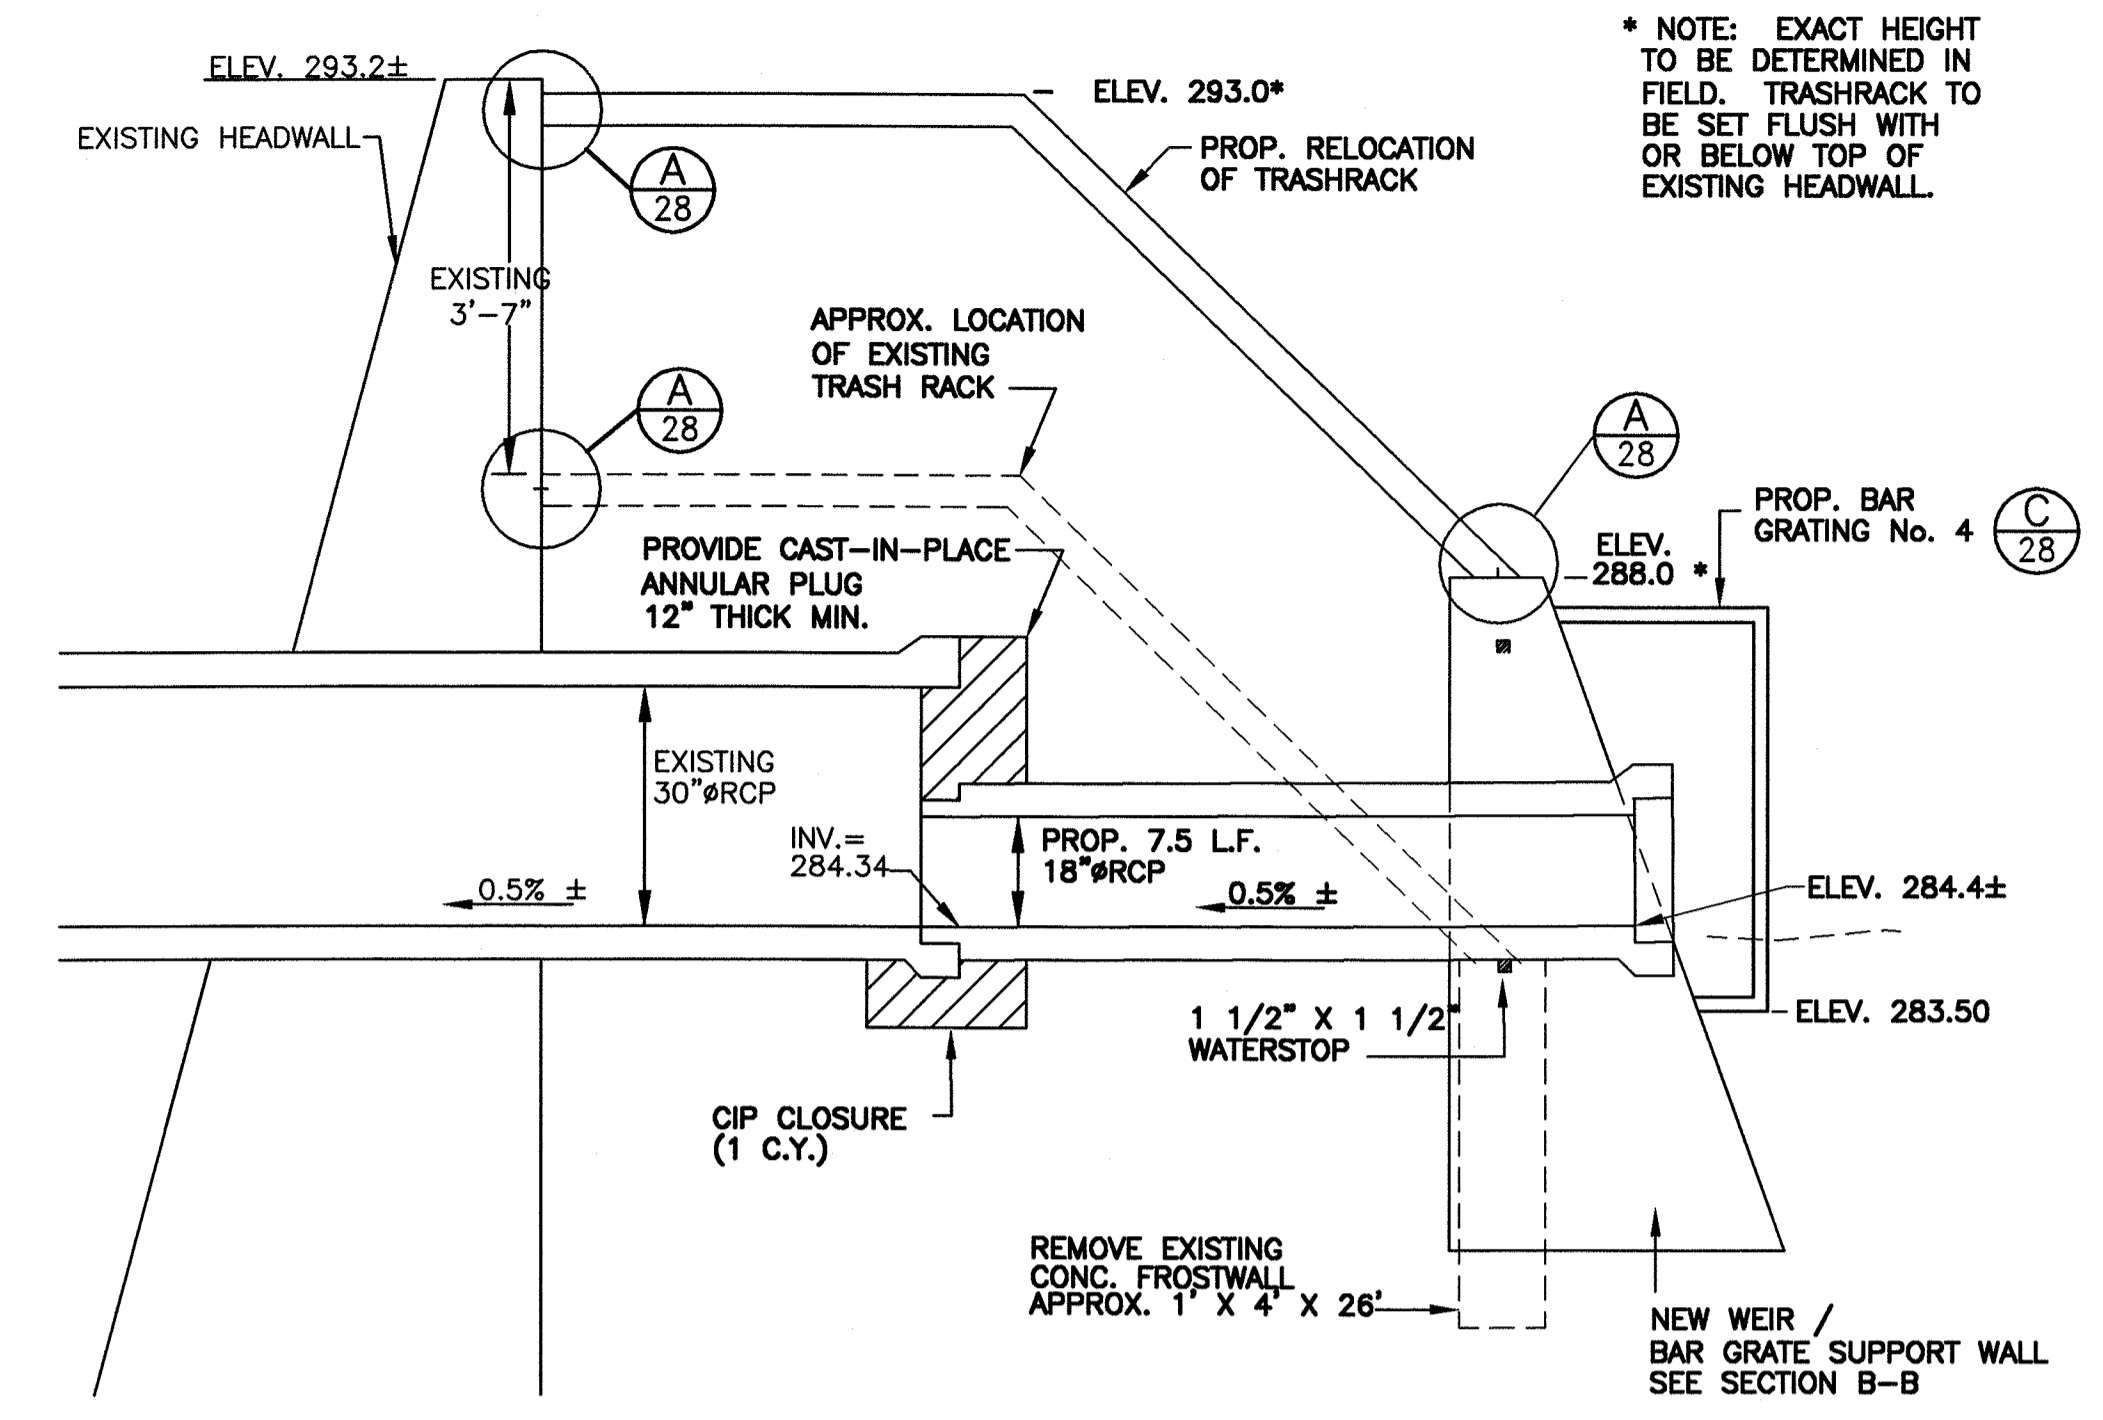


SECTION A-A
1/2" = 1'


- CONCRETE NOTES:**
1. CONCRETE f'c = 4,000 psi, Class A
 2. REINF. - ASTM A-61 GRADE 60, EPOXY COATED
 3. ALL SURFACES VISIBLE WHEN COMPLETED SHALL HAVE RUBBED FINISH.
 4. 1"x1" CHAMFER ALL CONC. CORNERS

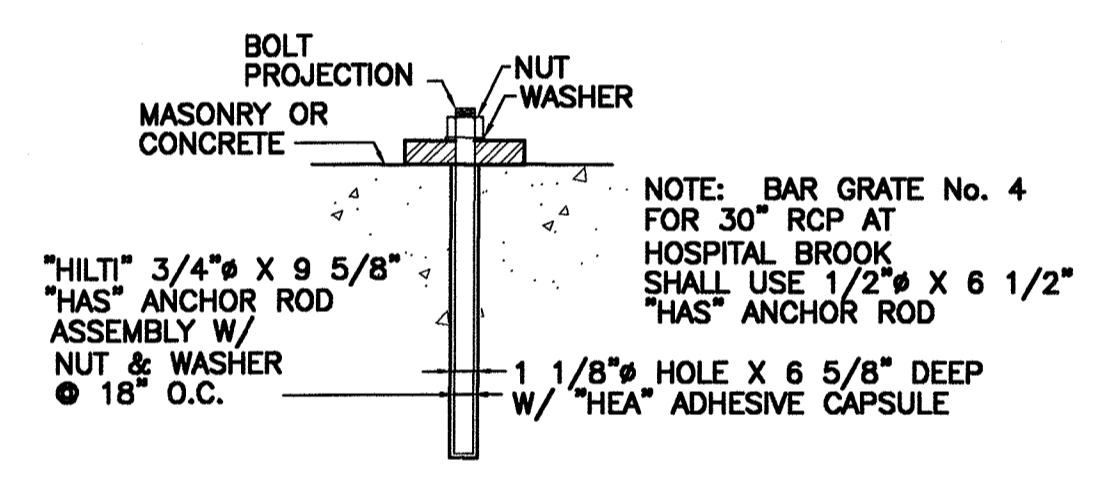


TYPICAL BAR GRATE FASTENER DETAIL
1/4" = 1'

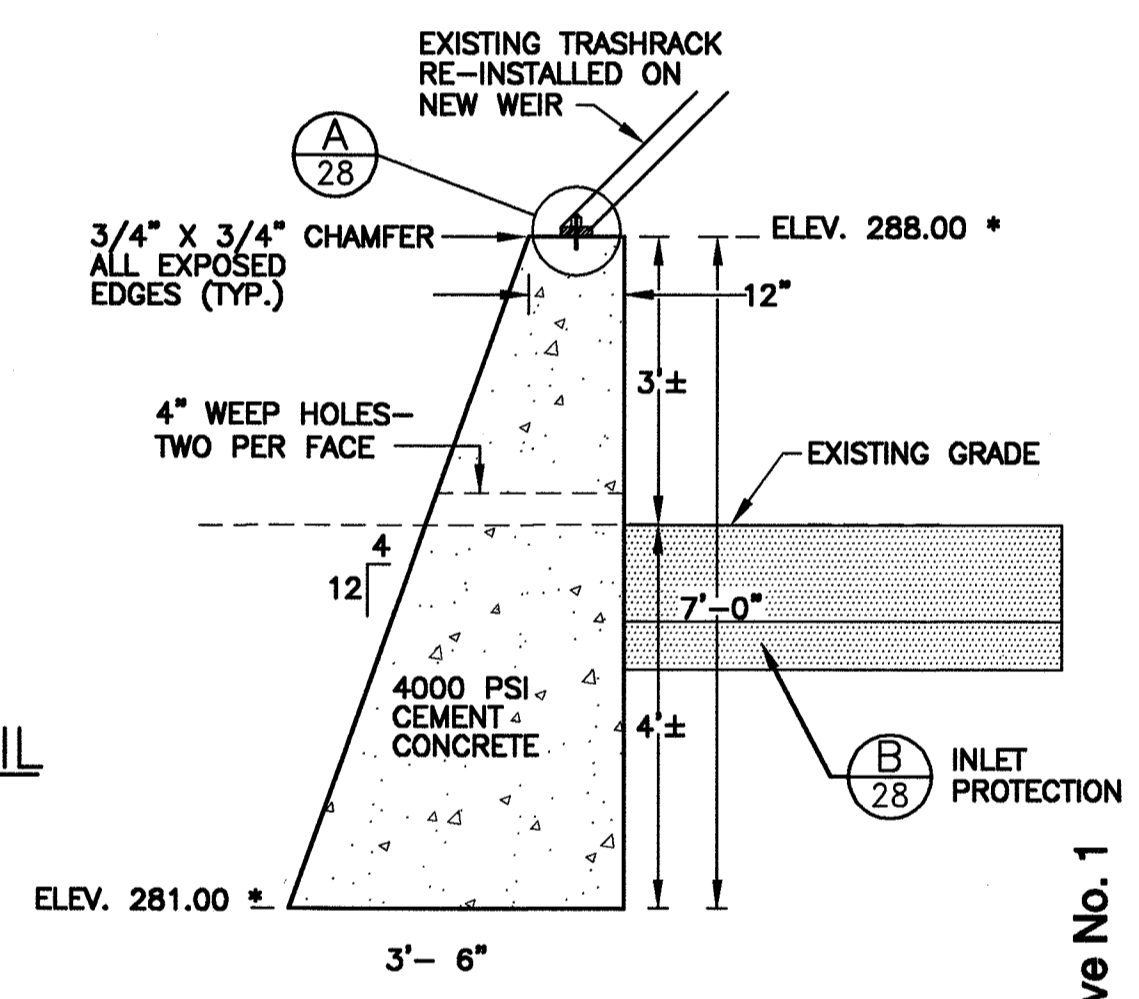



SECTION B-B
1/2" = 1'

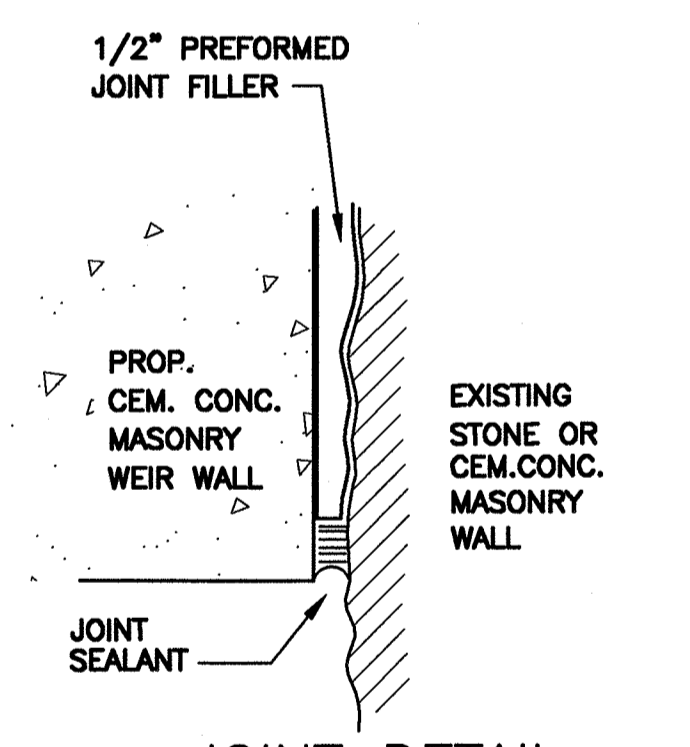


JOINT DETAIL
PROP. MASONRY WEIR WALL AGAINST EXIST. MASONRY

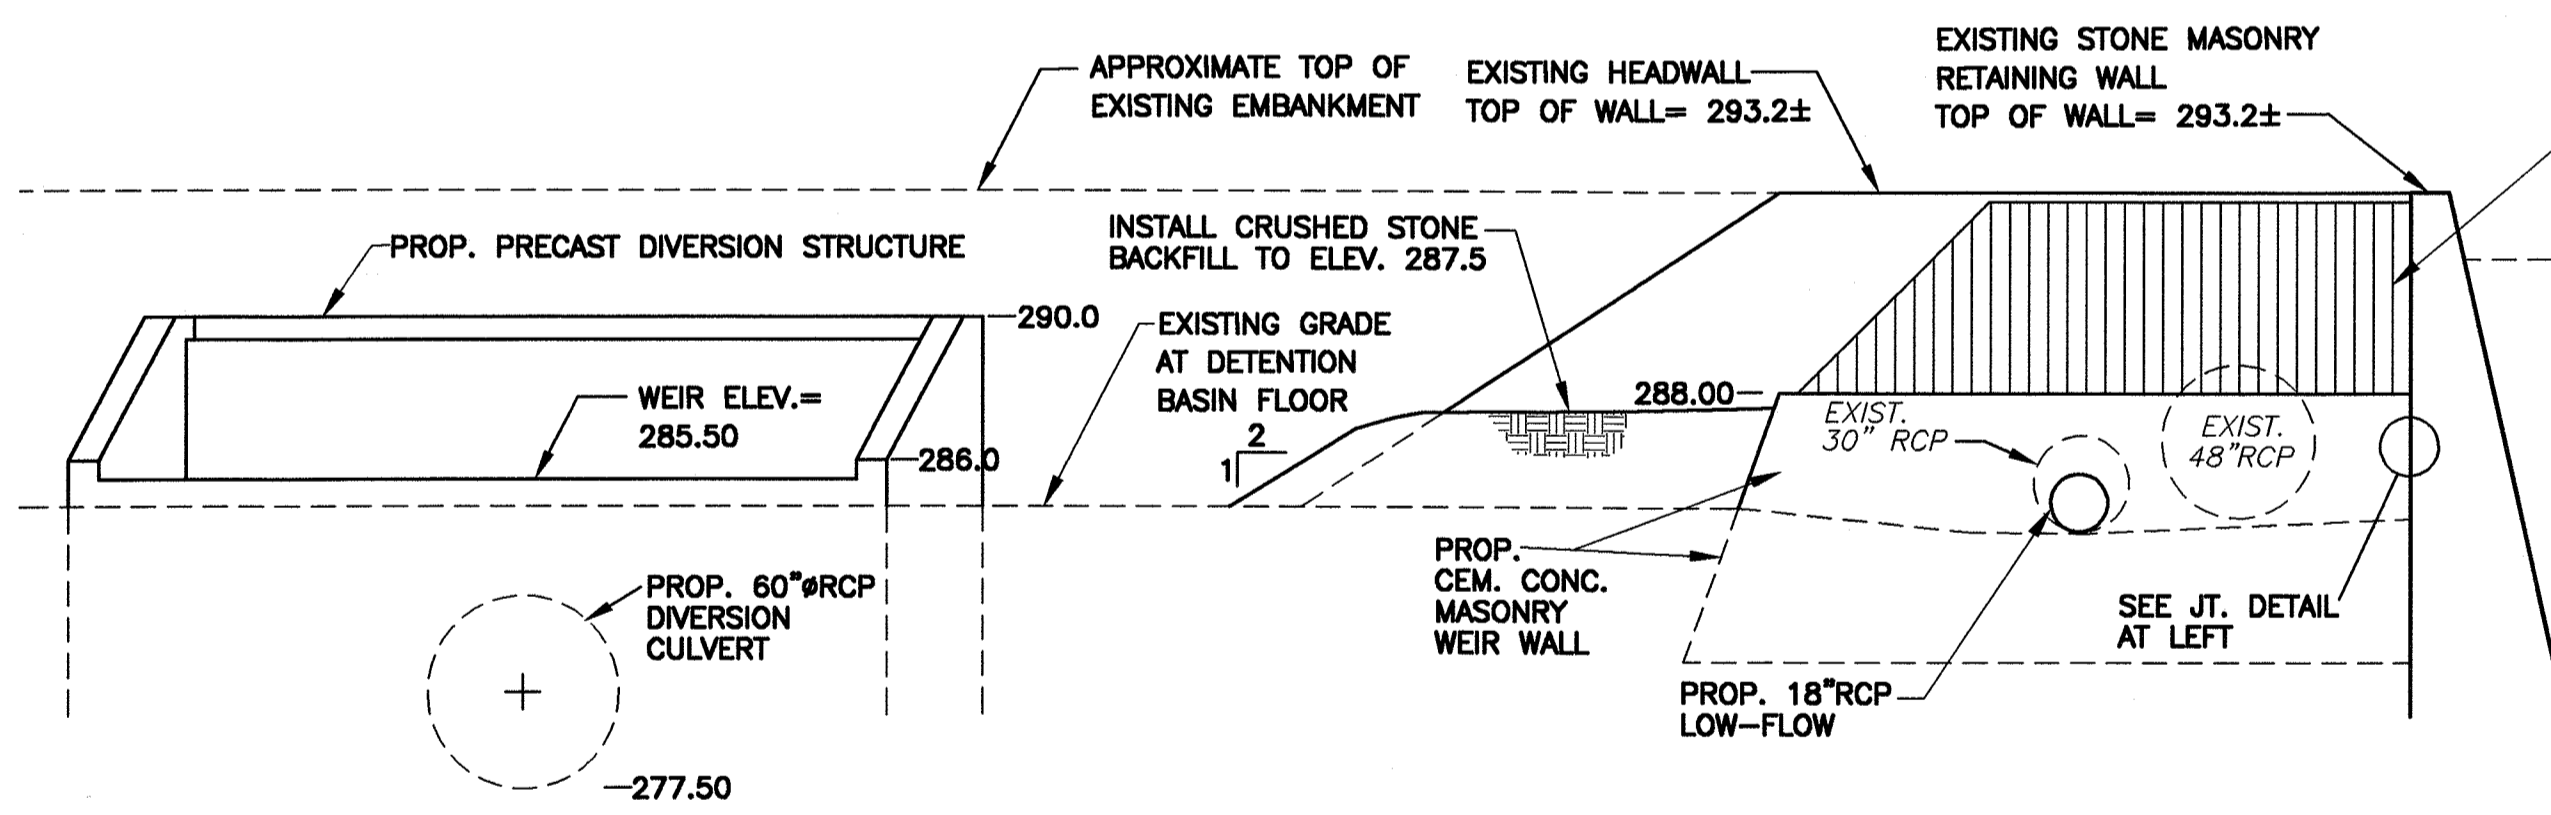


ELEVATION
1" = 5'

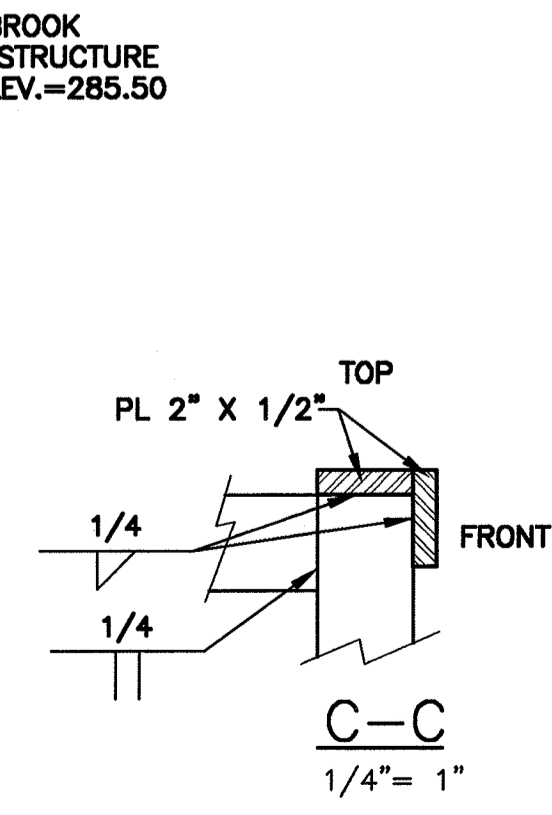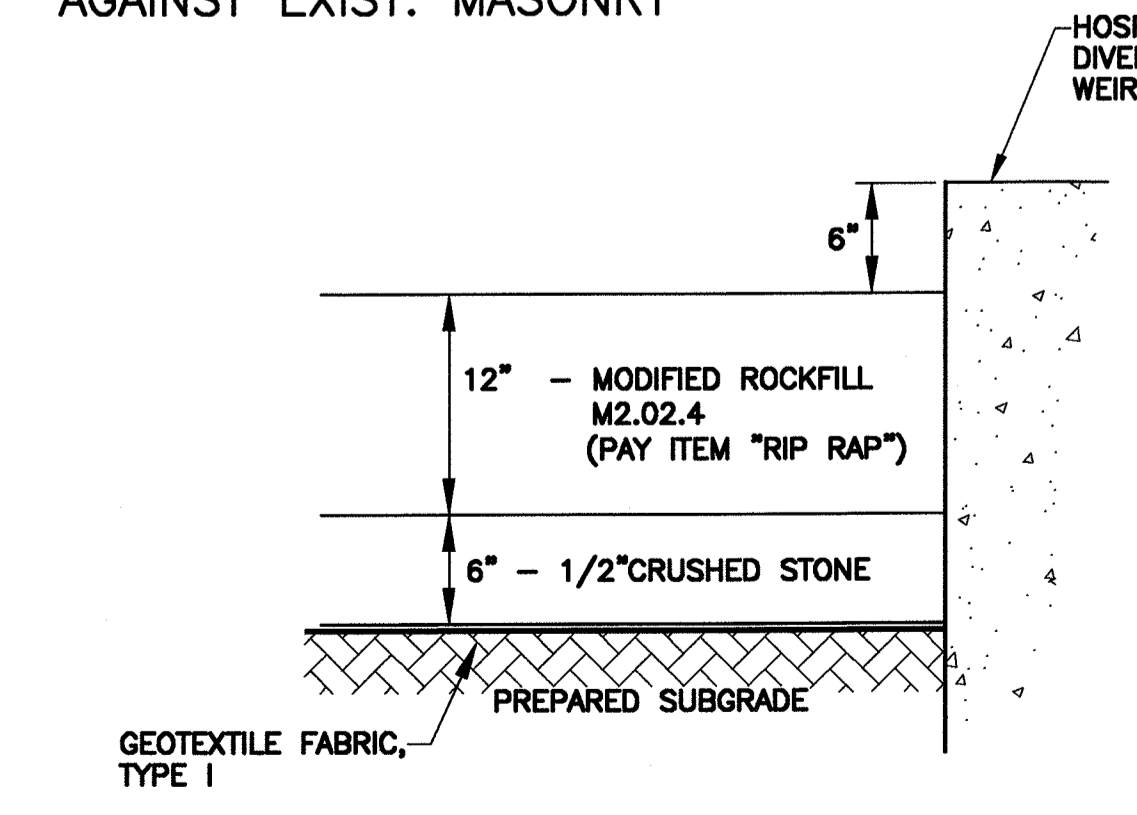


C-C
1/4" = 1'

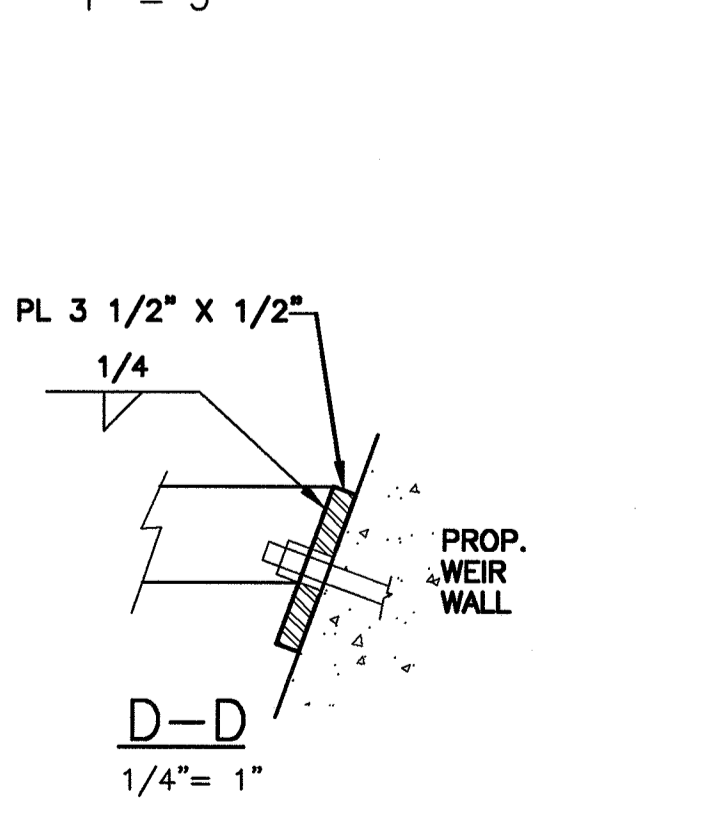


D-D
1/4" = 1'

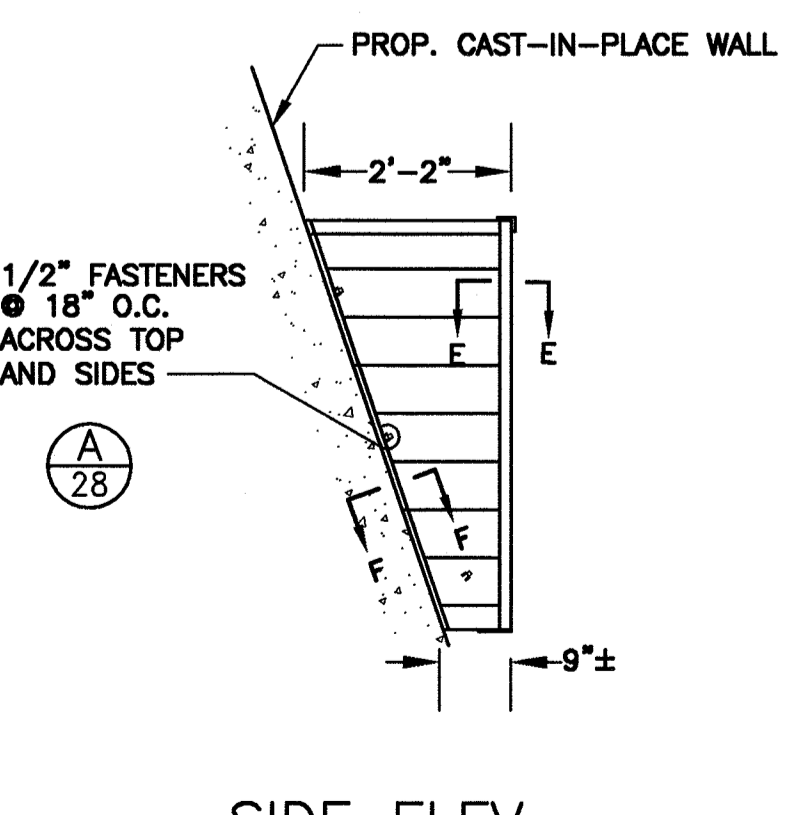


SIDE ELEV
1/2" = 1'

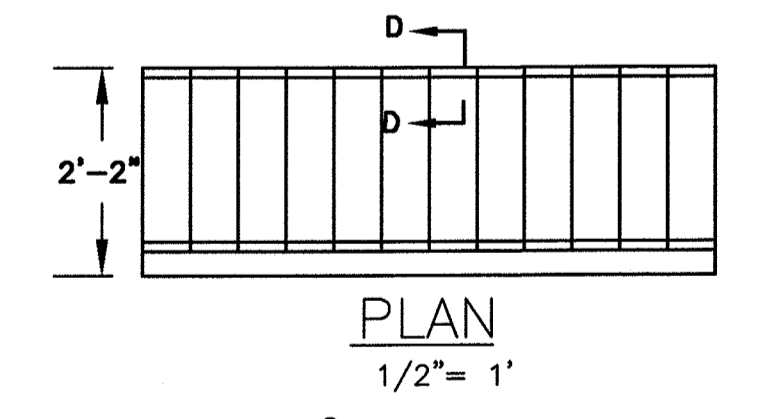


PLAN
1/2" = 1'

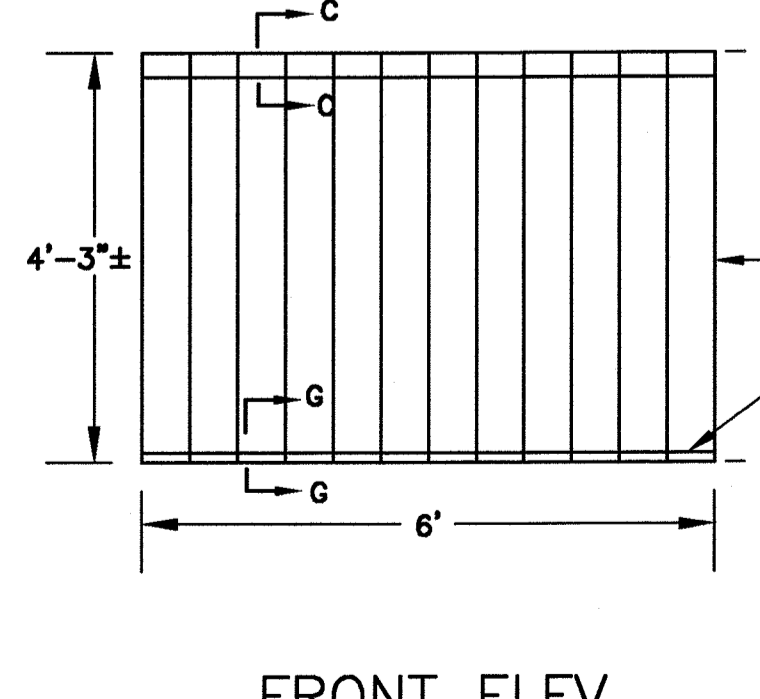


FRONT ELEV
1/2" = 1'

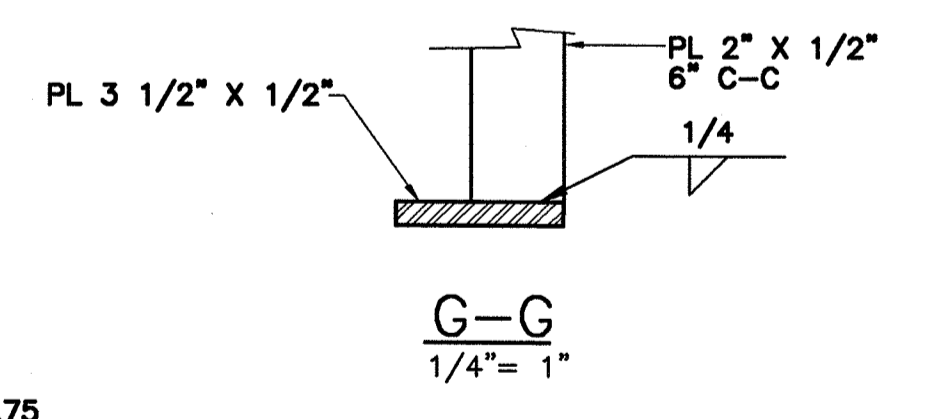

G-G
1/4" = 1'

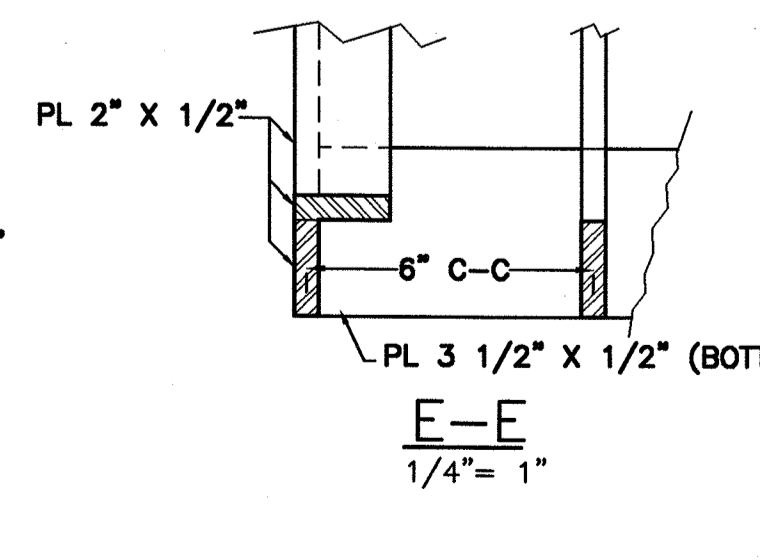

E-E
1/4" = 1'

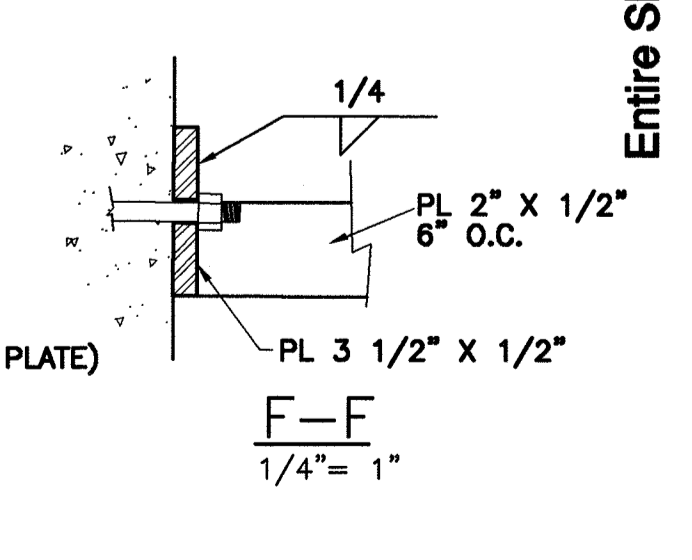

F-F
1/4" = 1'

B INLET PROTECTION - TYPICAL SECTION
NTS

C BAR GRATING No. 4
NTS

28 of 35 SHEETS

BAYSTATE ENVIRONMENTAL CONSULTANTS INC.
Scientists
296 North Main Street
Milford, Massachusetts 01028
Engineers
Surveyors

PROJECT NO. 94-1215	DATE AS NOTED	DATE APRIL 1999	DESIGNED BY SWJR	PROJECT HOSPITAL
Hospital Brook Diversion and Modifications to Existing Structures				
Godfrey Brook Flood Mitigation Project				
Milford, Massachusetts				
ISSUED AS RECORD PRINT	EDM	TEJ	BY	
10/1/01	8/12/99			
2	1			
NO.	DATE	REVISION		

Entire Sheet to be Included Under Bid Alternative No. 1

AUTOCAD FILE: P:\AUTOCAD\VCAD\IN\941215\RECORD DRAWINGS\Sheet 27.dwg Plotted at: Tue Oct 02 09:27:19 2001 REC, INC.


PRECAST CULVERT & STRUCTURE DESIGN NOTES

CONCRETE MINIMUM STRENGTH = 5000 PSI @ 28 DAYS
 STEEL REINFORCEMENT - ASTM A615, GRADE 60
 WHEEL LOADING - AASHTO HS25-40
 COVER TO STEEL - 1.5 INCHES
 EARTH COVER - 0'-0" MINIMUM, 13'-6" MAXIMUM
 UNIT WEIGHT OF EARTH - 125 POUNDS PER CUBIC FOOT
 ACTIVE PRESSURE COEFFICIENT - 0.25 MIN., 0.5 MAX.
 2'-0" LIVE LOAD SURCHARGE APPLIED TO 13'-6" DEPTH
 EXTERIOR GROUND WATER AT FINISHED GRADE
 DESIGN SHALL BE IN ACCORDANCE WITH AASHTO SPECIFICATIONS
 FOR HIGHWAY BRIDGES, ACI 318-83, AND LOAD FACTOR DESIGN (AASHTO)


LOAD FACTORS
 DEAD LOAD 1.5
 LIVE LOAD 2.17
 HYDROSTATIC PRESSURE 1.4
 EARTH PRESSURE, HORIZ. 1.7

CAPACITY REDUCTION FACTORS
 SHEAR 0.85
 MOMENT 0.90

WEEP HOLES SHALL BE SUPPLIED IN CULVERT SECTIONS AND DIVERSION STRUCTURES AT RATE OF ONE (1) 4" Ø WEEP PER 8' LINEAR FEET OF VERTICAL FACE.

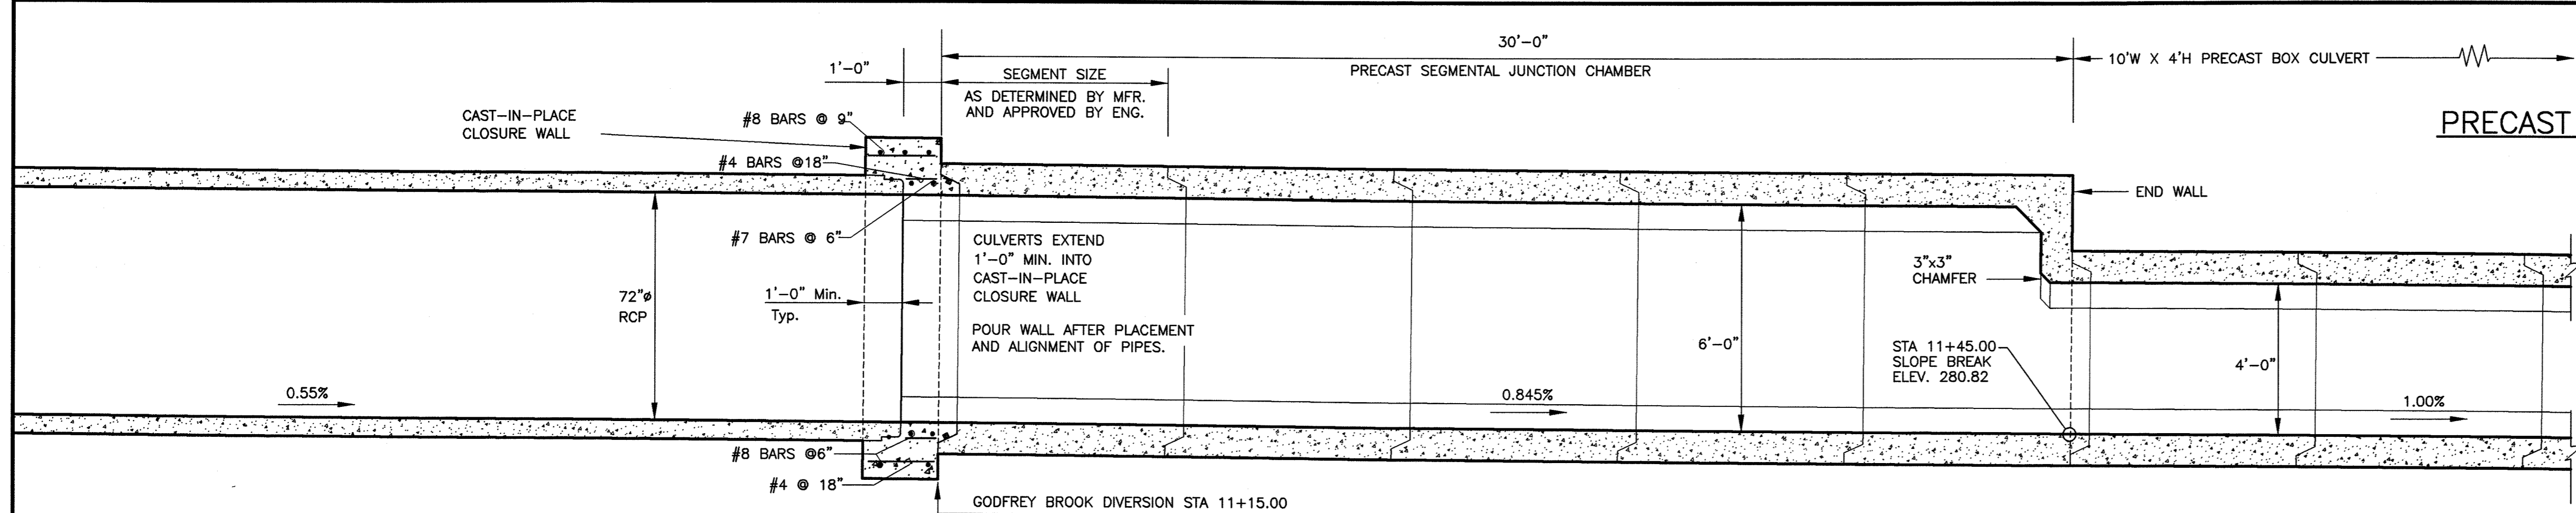


SECTION A-A
 SCALE: 3/8" = 1'

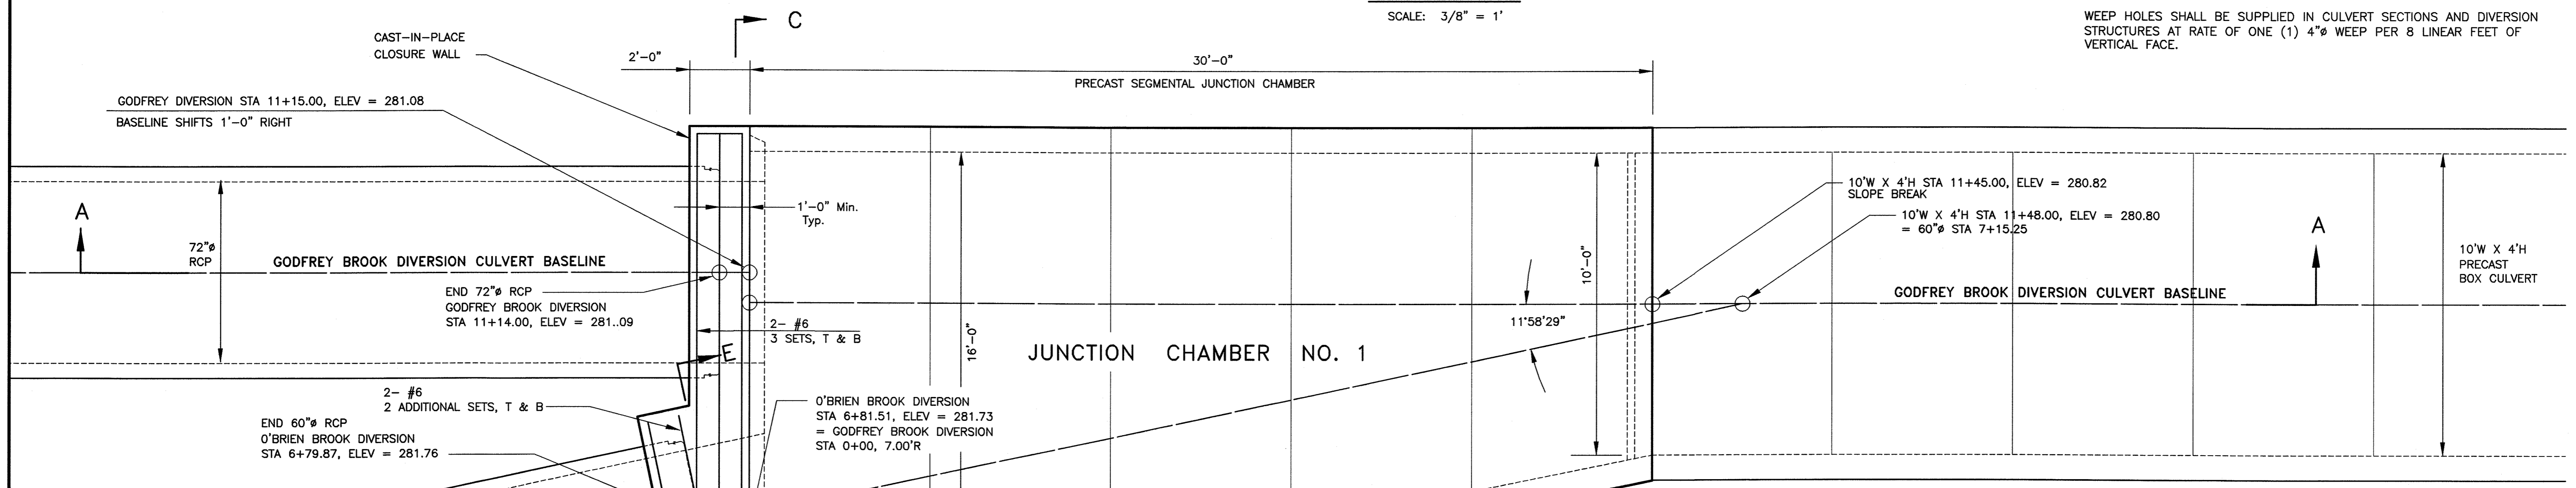


PLAN VIEW
 SCALE: 3/8" = 1'-0"


- CONCRETE NOTES:**
1. CONCRETE f'_c = 4,000 psi, Class A
 2. REINF. - ASTM A-61 GRADE 60, EPOXY COATED
 3. ALL SURFACES VISIBLE WHEN COMPLETED SHALL HAVE RUBBED FINISH.
 4. 1"x1" CHAMFER ALL CONC. CORNERS

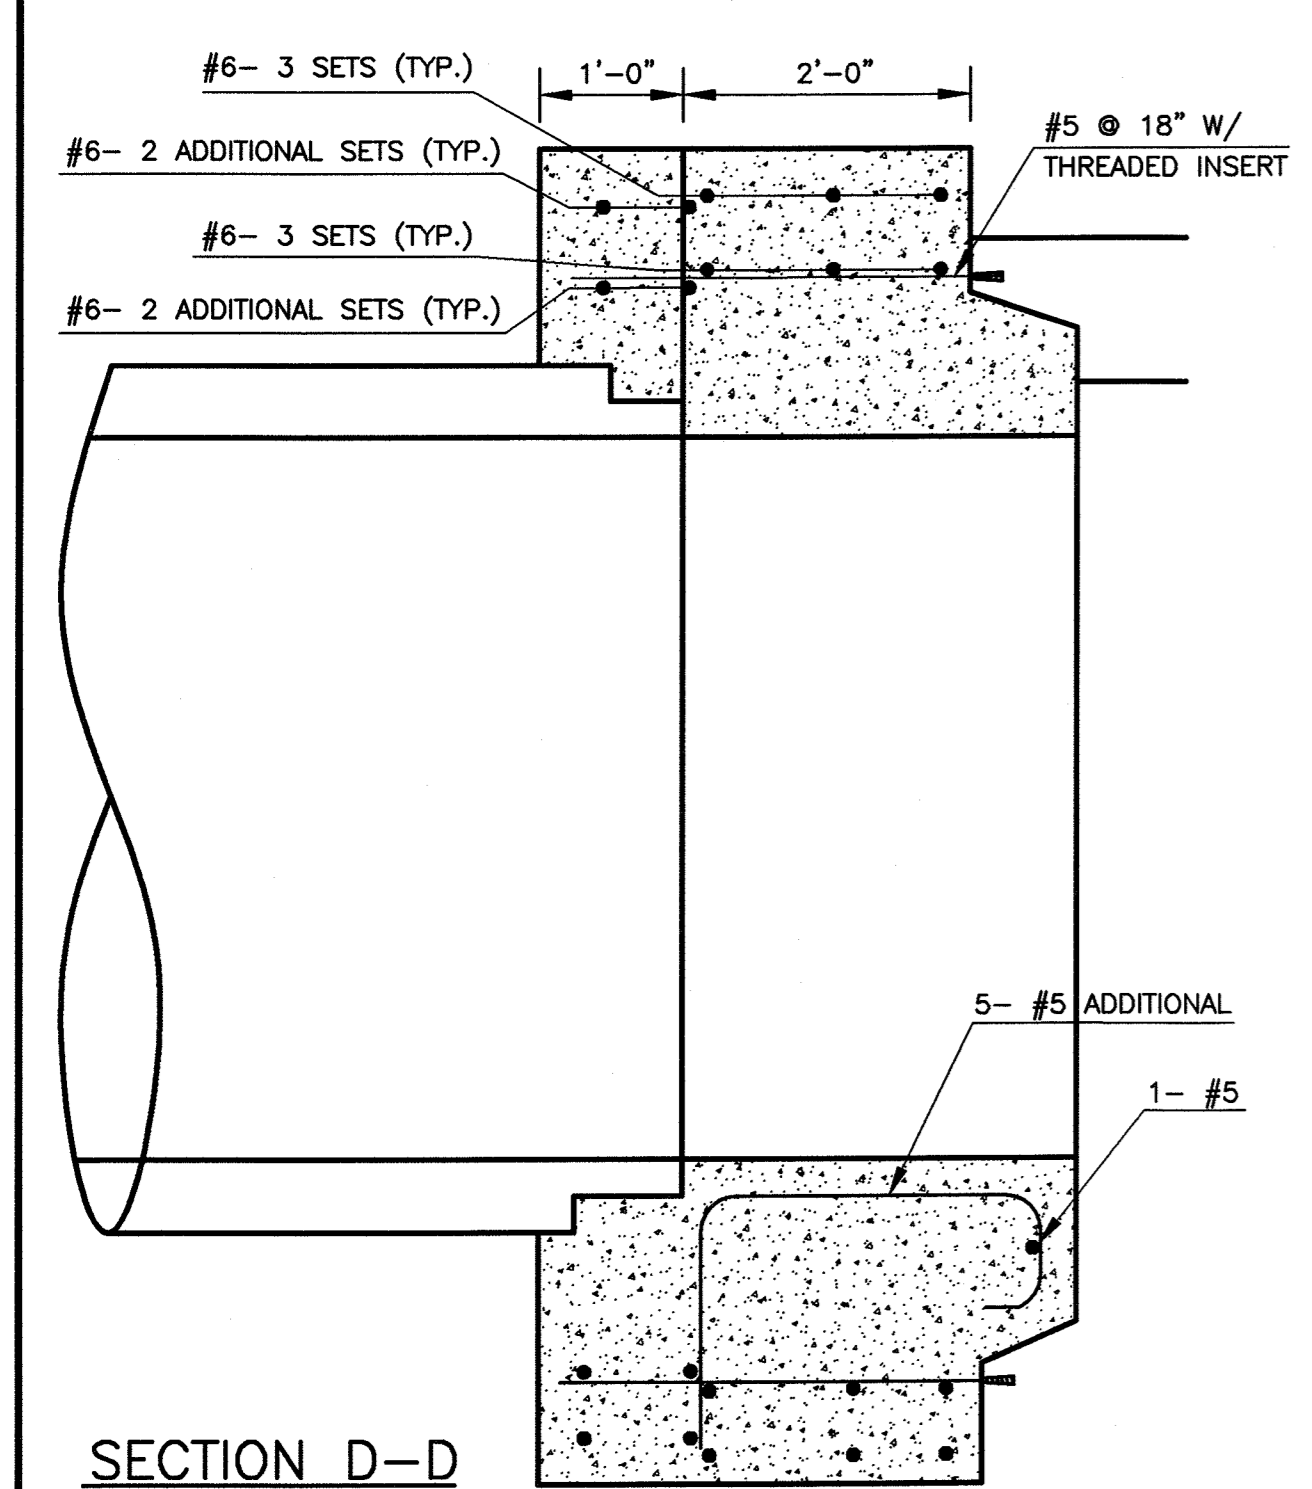

SECTION D-D
 SCALE: 3/4" = 1'-0"

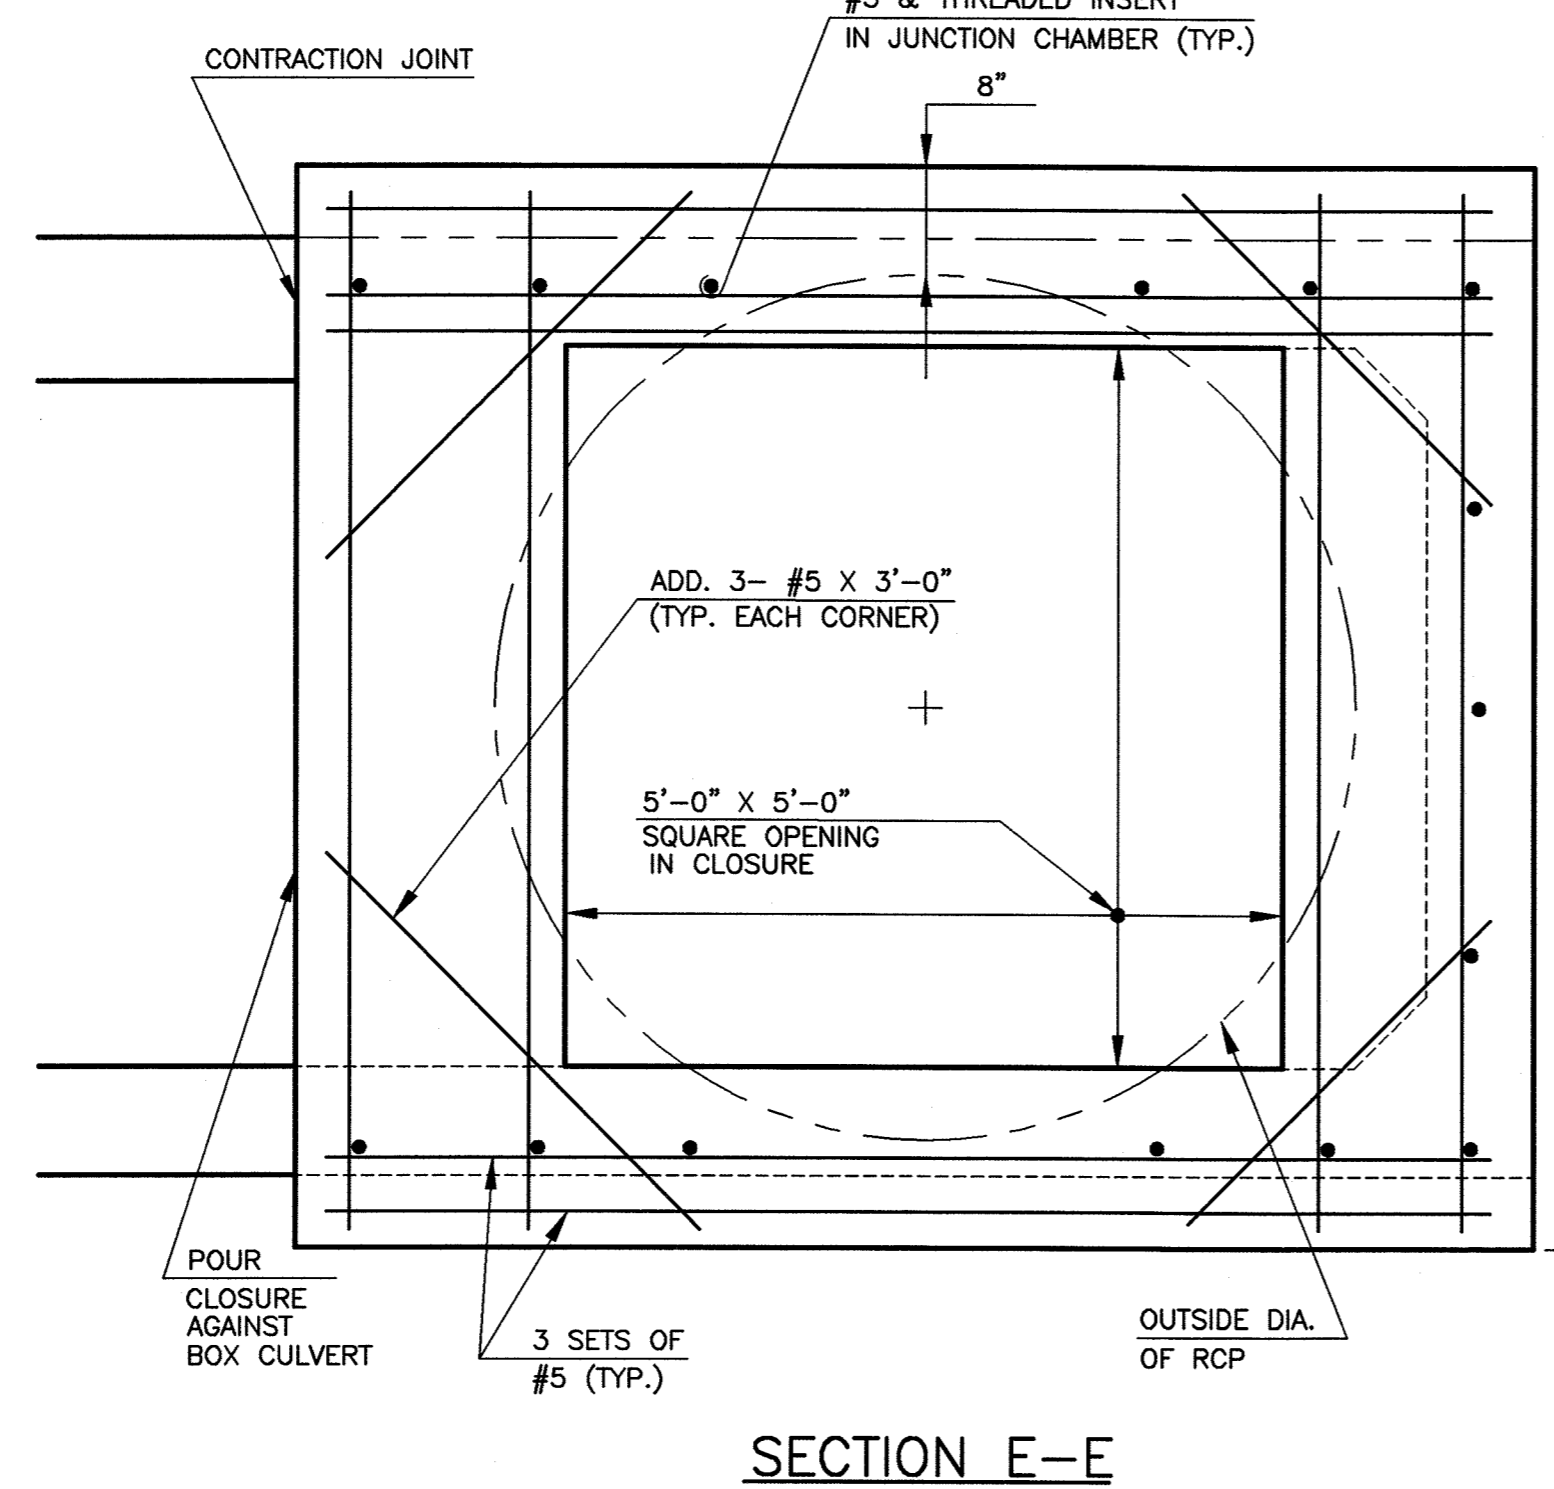

SECTION E-E
 SCALE: 3/4" = 1'-0"

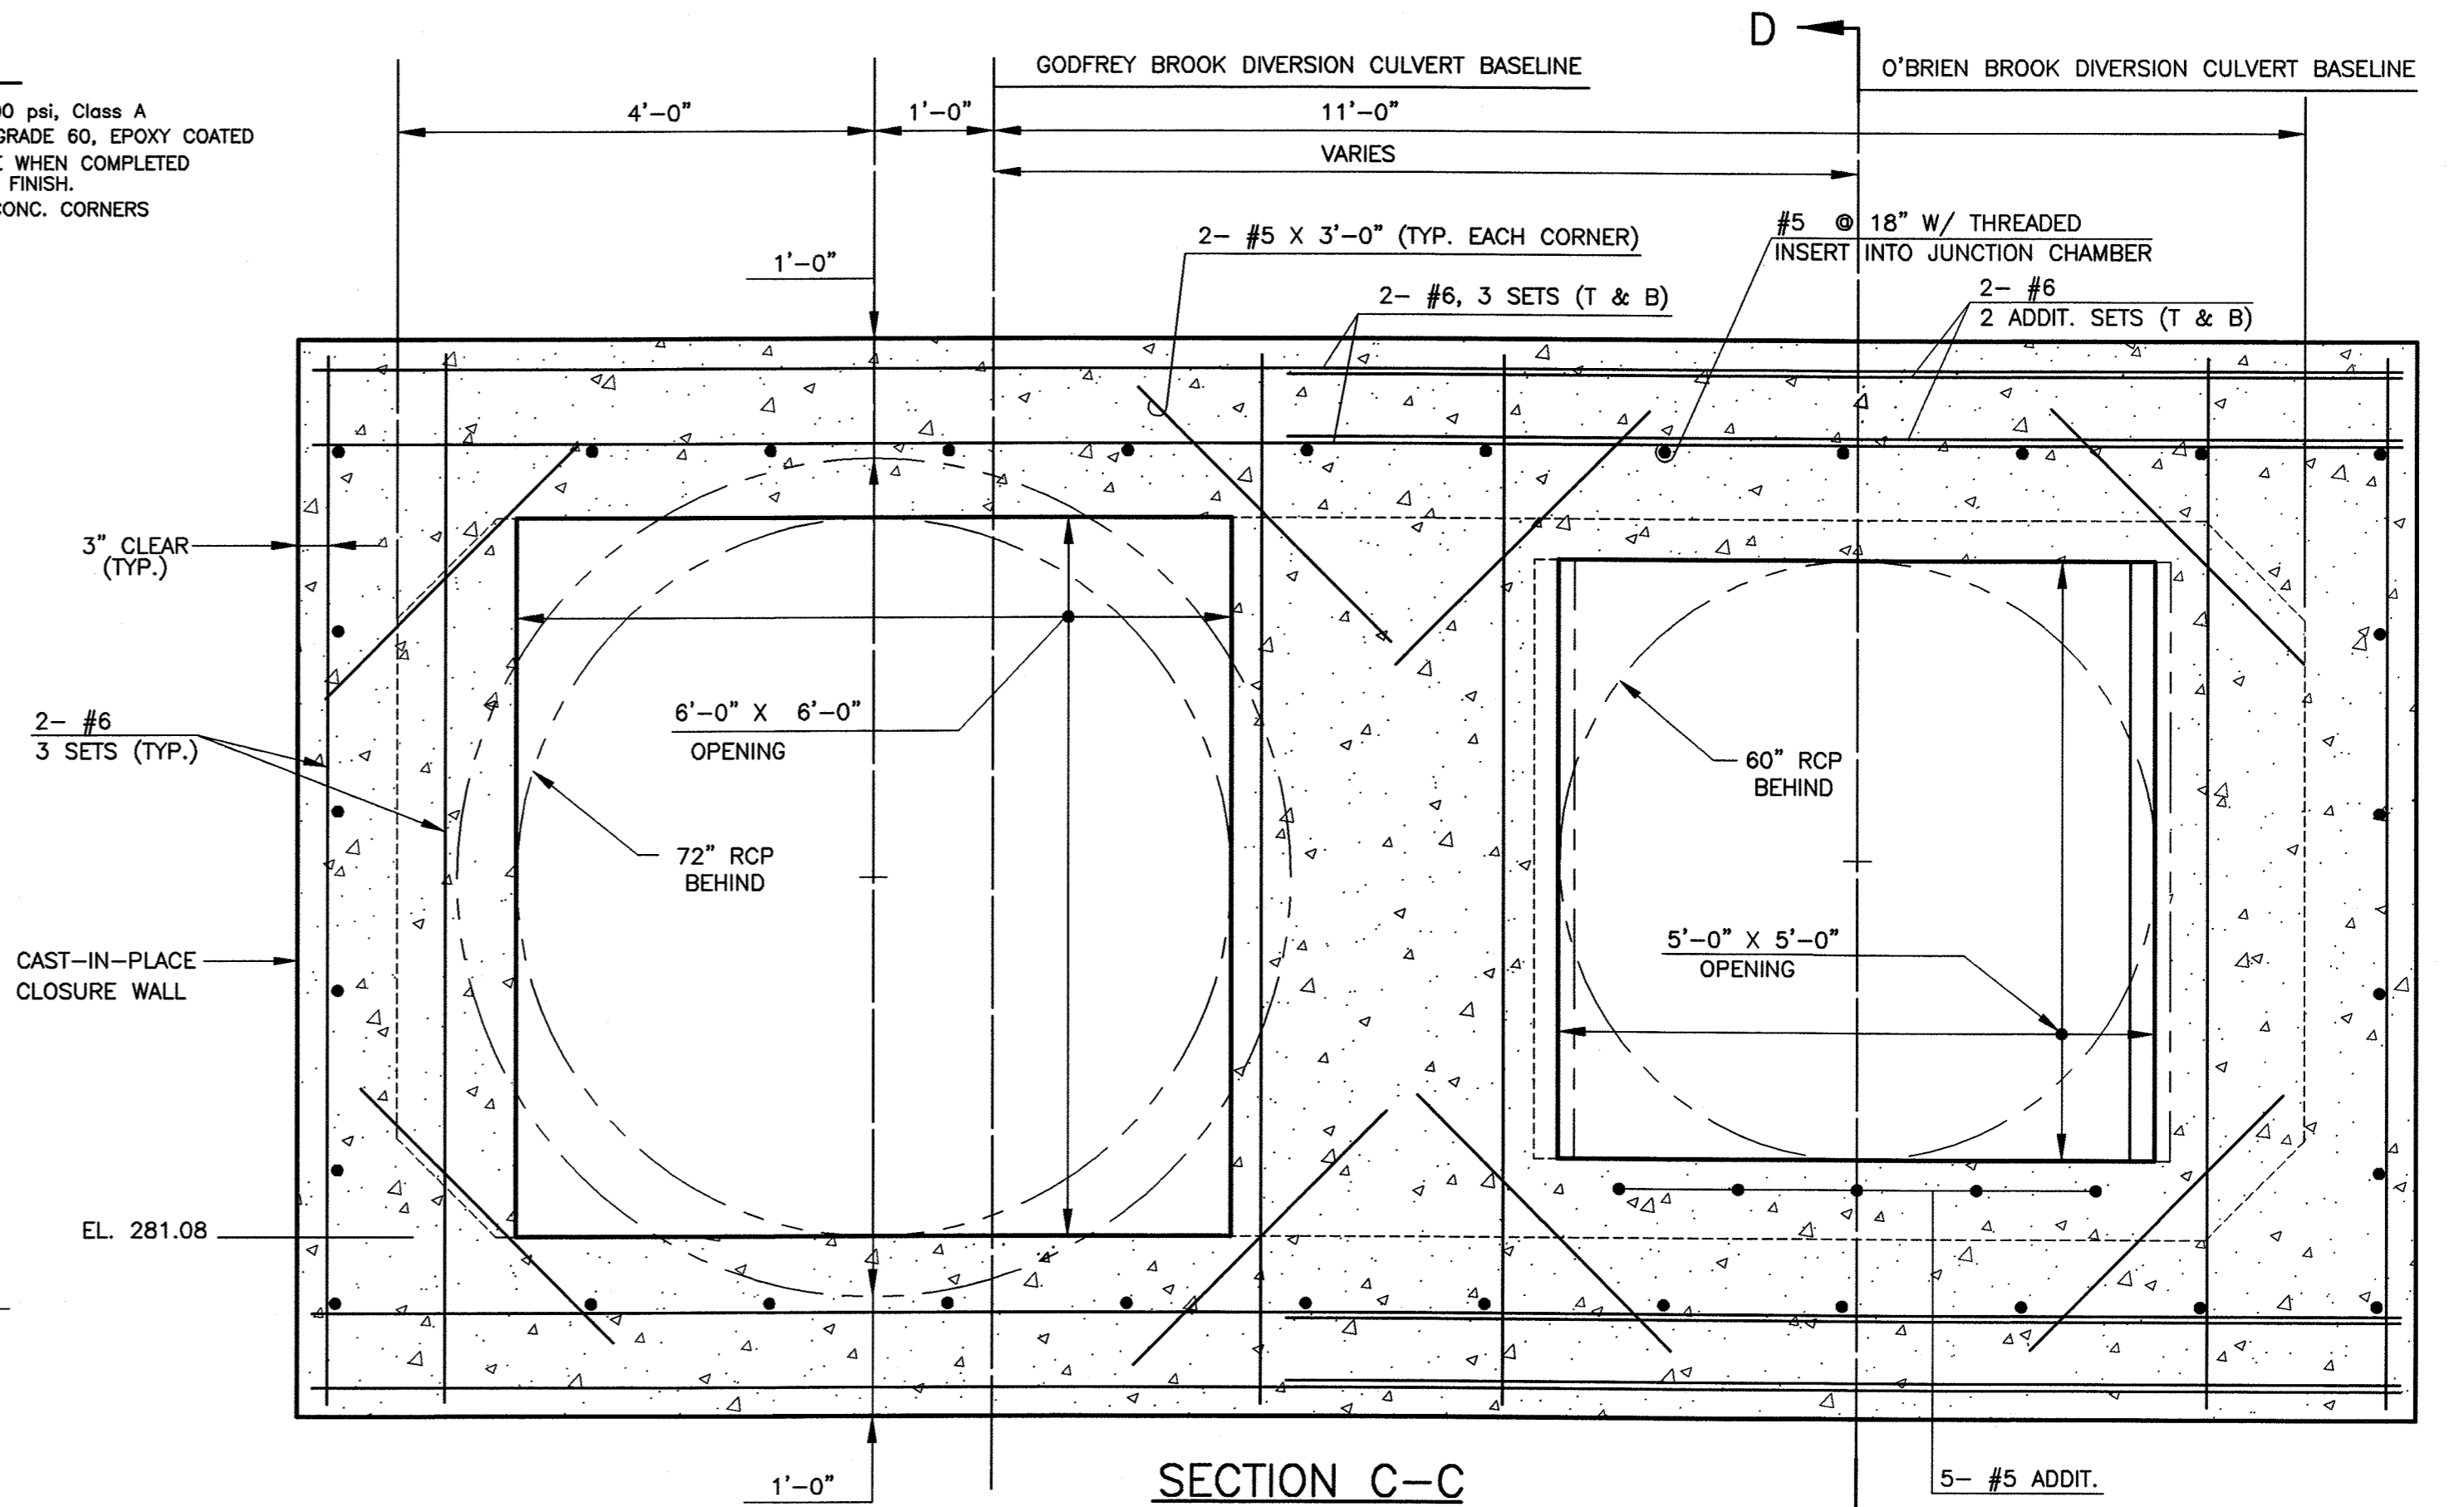

SECTION C-C
 SCALE: 3/4" = 1'-0"

BAYSTATE ENVIRONMENTAL CONSULTANTS INC.
 296 North Main Street
 East Longmeadow, MA 01028
 Engineers
 Scientists
 Surveyors


PROJECT NO. 94-1215
 SCALE AS NOTED
 DATE APRIL 1999
 DRAWN BY EDM
 CHECKED BY TEJ

**Junction Chamber No. 1
 Plan and Sections**

**Godfrey Brook Flood Mitigation Project
 Milford, Massachusetts**

NO.	DATE	REVISION	BY
2	10/1/01	ISSUED AS RECORD PRINT	EDM
1	5/12/99	ISSUED FOR BIDDING	TEJ

AUTOCAD FILE: P:\AUTOCAD\MCAD\IN\941215\RECORD DRAWINGS\Sheet 29.dwg Plotted at: Tue Oct 02 09:30:15 2001
 BEC, Inc.

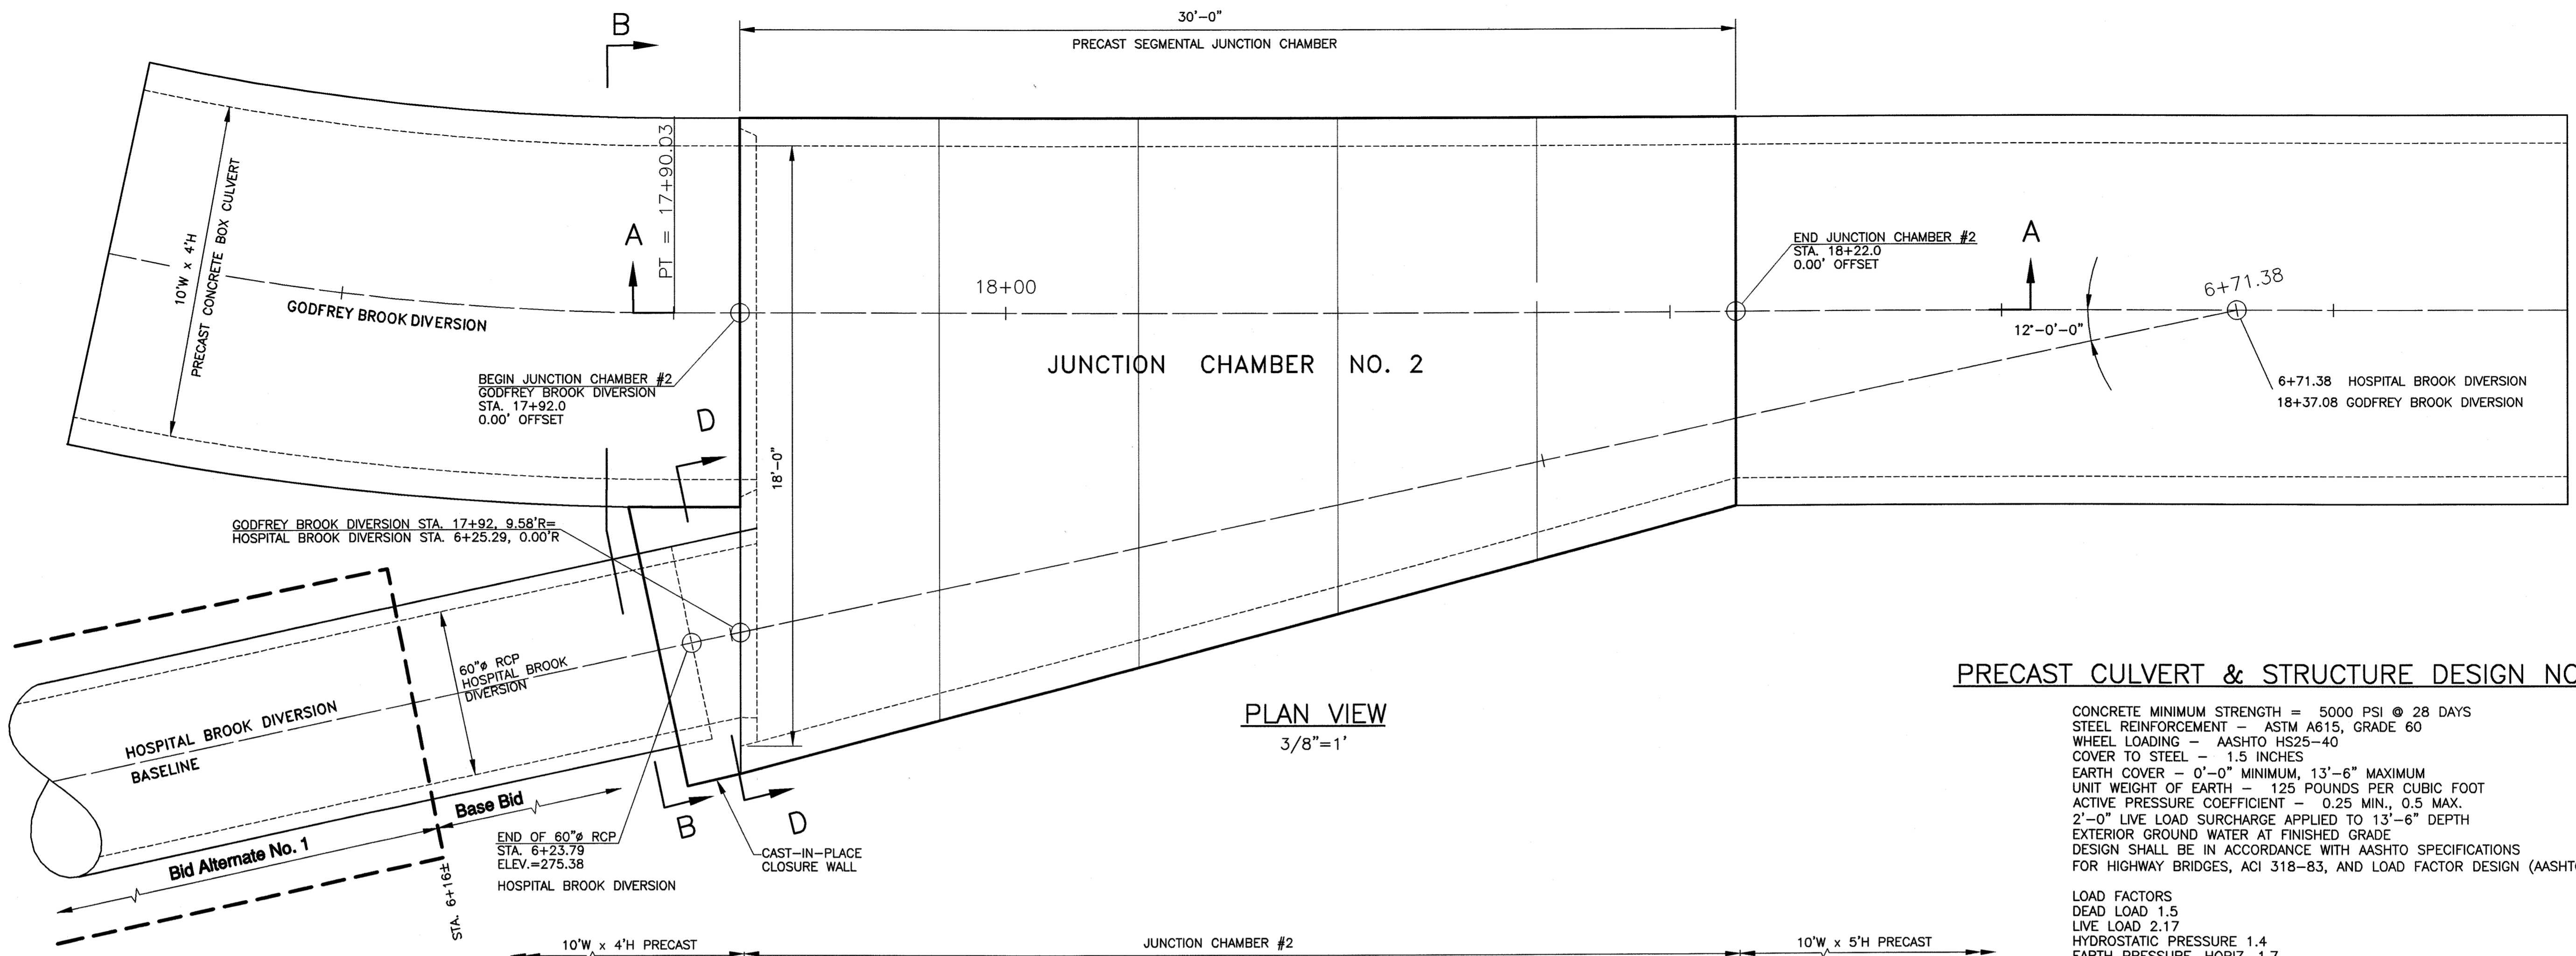

PRECAST CULVERT & STRUCTURE DESIGN NOTES

CONCRETE MINIMUM STRENGTH = 5000 PSI @ 28 DAYS
 STEEL REINFORCEMENT - ASTM A615, GRADE 60
 WHEEL LOADING - AASHTO HS25-40
 COVER TO STEEL - 1.5 INCHES
 EARTH COVER - 0'-0" MINIMUM, 13'-6" MAXIMUM
 UNIT WEIGHT OF EARTH - 125 POUNDS PER CUBIC FOOT
 ACTIVE PRESSURE COEFFICIENT - 0.25 MIN., 0.5 MAX.
 2'-0" LIVE LOAD SURCHARGE APPLIED TO 13'-6" DEPTH
 EXTERIOR GROUND WATER AT FINISHED GRADE
 DESIGN SHALL BE IN ACCORDANCE WITH AASHTO SPECIFICATIONS
 FOR HIGHWAY BRIDGES, ACI 318-83, AND LOAD FACTOR DESIGN (AASHTO)

LOAD FACTORS
 DEAD LOAD 1.5
 LIVE LOAD 2.17
 HYDROSTATIC PRESSURE 1.4
 EARTH PRESSURE, HORIZ. 1.7


CAPACITY REDUCTION FACTORS
 SHEAR 0.85
 MOMENT 0.90

WEEP HOLES SHALL BE SUPPLIED IN CULVERT SECTIONS AND DIVERSION STRUCTURES AT RATE OF ONE (1) 4" WEEP PER 8 LINEAR FEET OF VERTICAL FACE.


NOTE: IF BID ALTERNATE No.1 IS NOT SELECTED, BASE BID SHALL INCLUDE 8" X 8" X 1.5" CAST-IN-PLACE TEMPORARY PLUG (3000 psi CEM. CONC.) AT HOSPITAL BROOK DIVERSION, STA. 6+16±.

CAST-IN-PLACE CONC. NOTES:


1. Fc' = 4,000 psi - CLASS A CONC.
2. REINF. - ASTM A-615 GRADE 60.
3. REINF. - 2" COVER MIN.
4. REINF. - MIN. SPLICE = 18"
5. 1" X 1" CHAMFER ALL CORNERS.

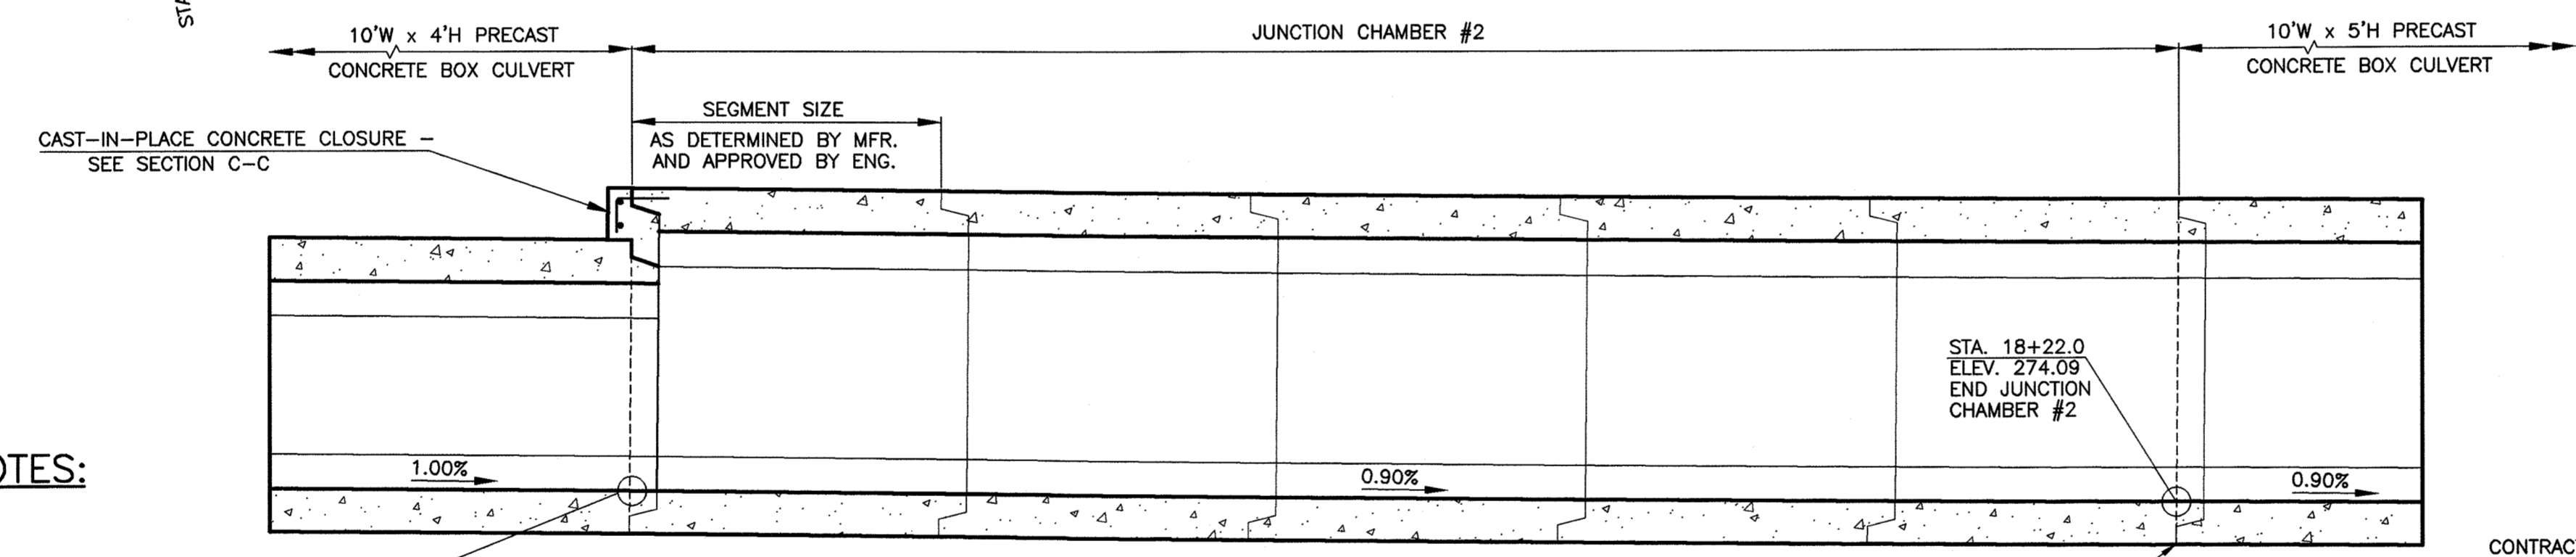


SECTION A-A
3/8"=1'

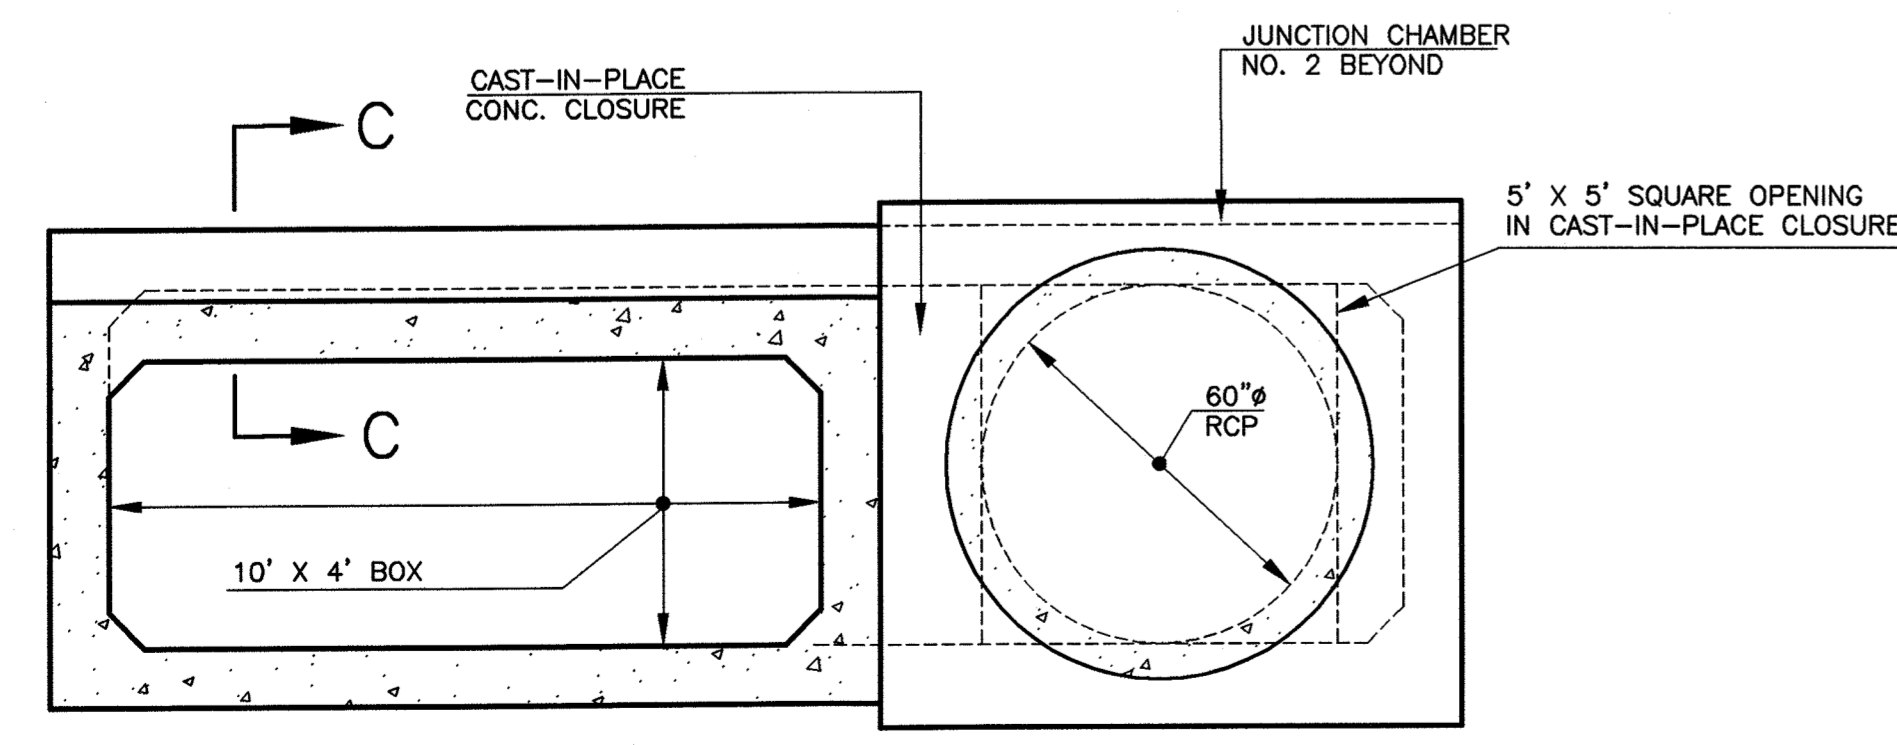

SECTION B-B
3/8"=1'

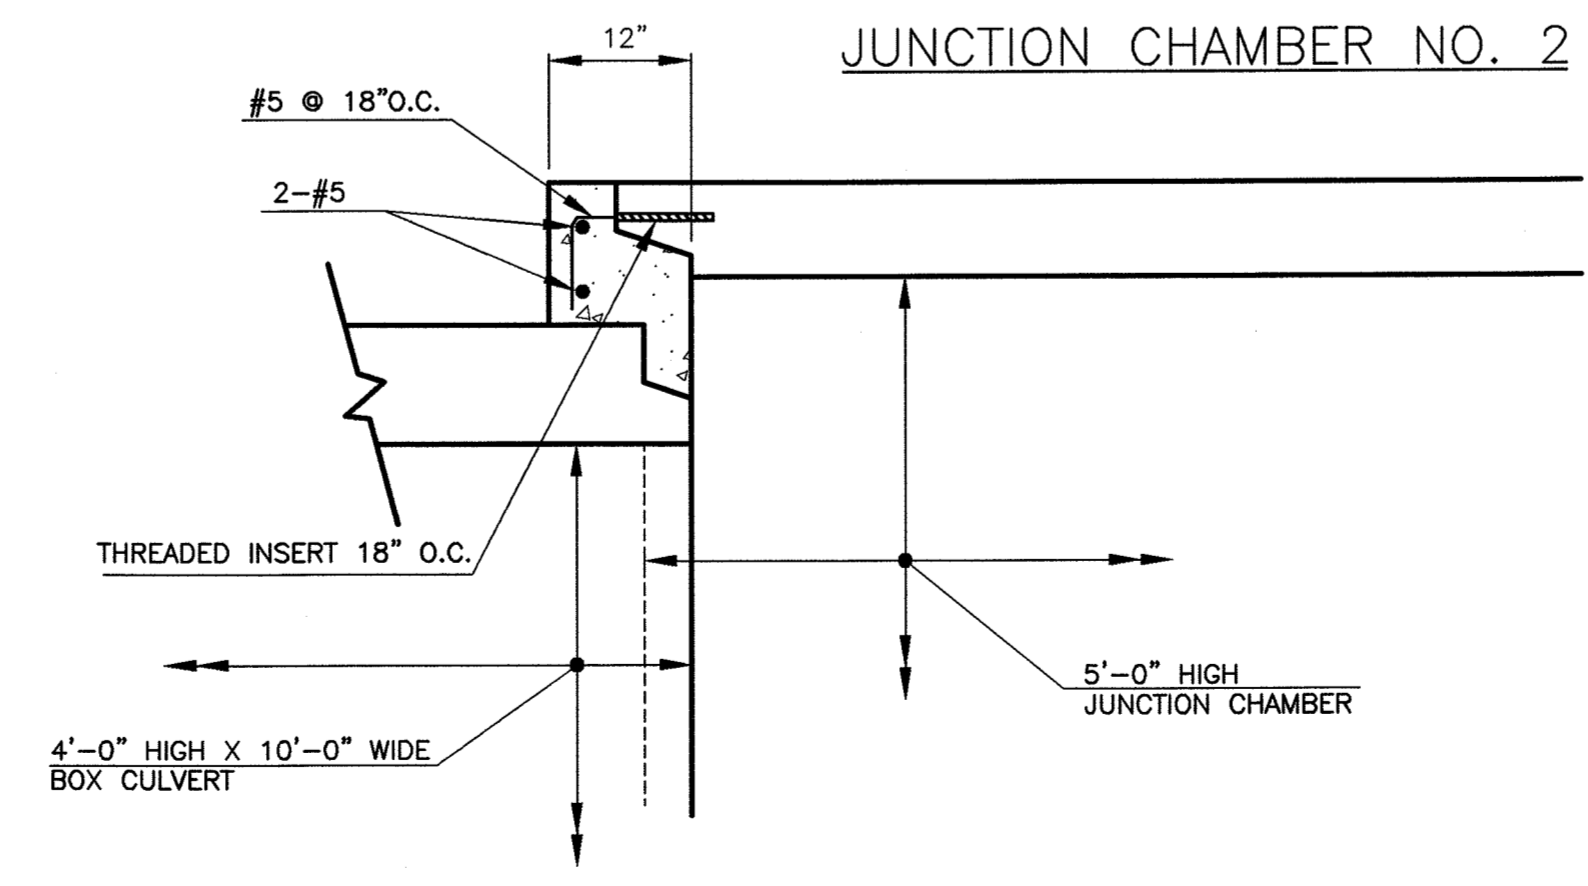

SECTION C-C
3/4"=1'

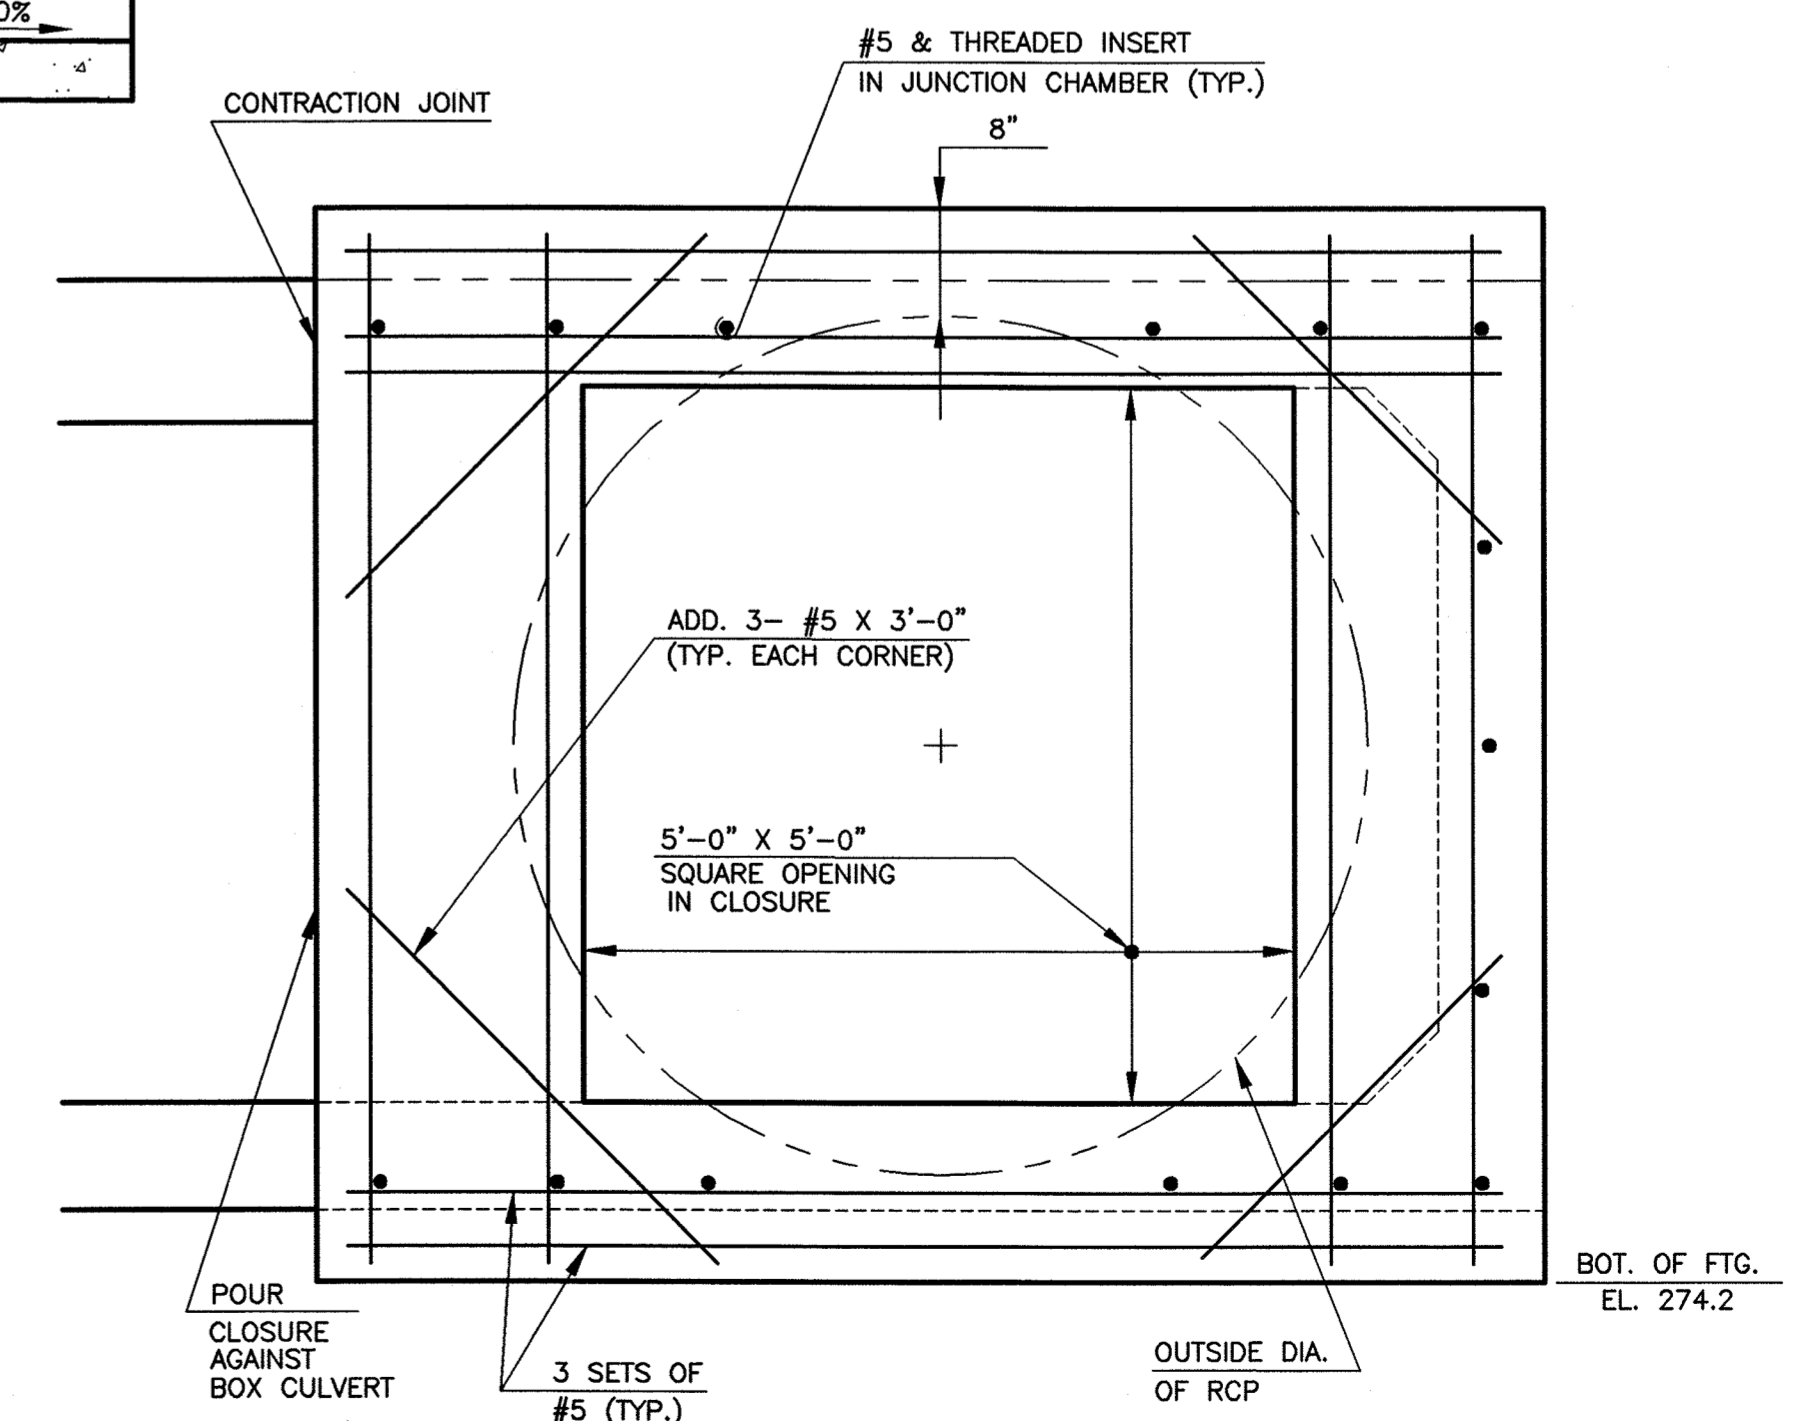

SECTION D-D
3/4"=1'

30 of 35 SHEETS



BAYSTATE ENVIRONMENTAL CONSULTANTS INC.
 Scientists
 Engineers
 286 North Main Street
 East Longmeadow, MA 01028

DEC

PROJECT NO. 94-1215
 SCALE AS NOTED
 DATE APRIL 1999
 DRAWN BY EDM
 CHECKED BY TEJ

Junction Chamber No. 2
 Plan and Sections
 Godfrey Brook Flood Mitigation Project
 Milford, Massachusetts

NO.	DATE	REVISION	BY
2	10/101	ISSUED AS RECORD PRINT	EDM
1	8/12/99	ISSUED FOR BIDDING	TEJ

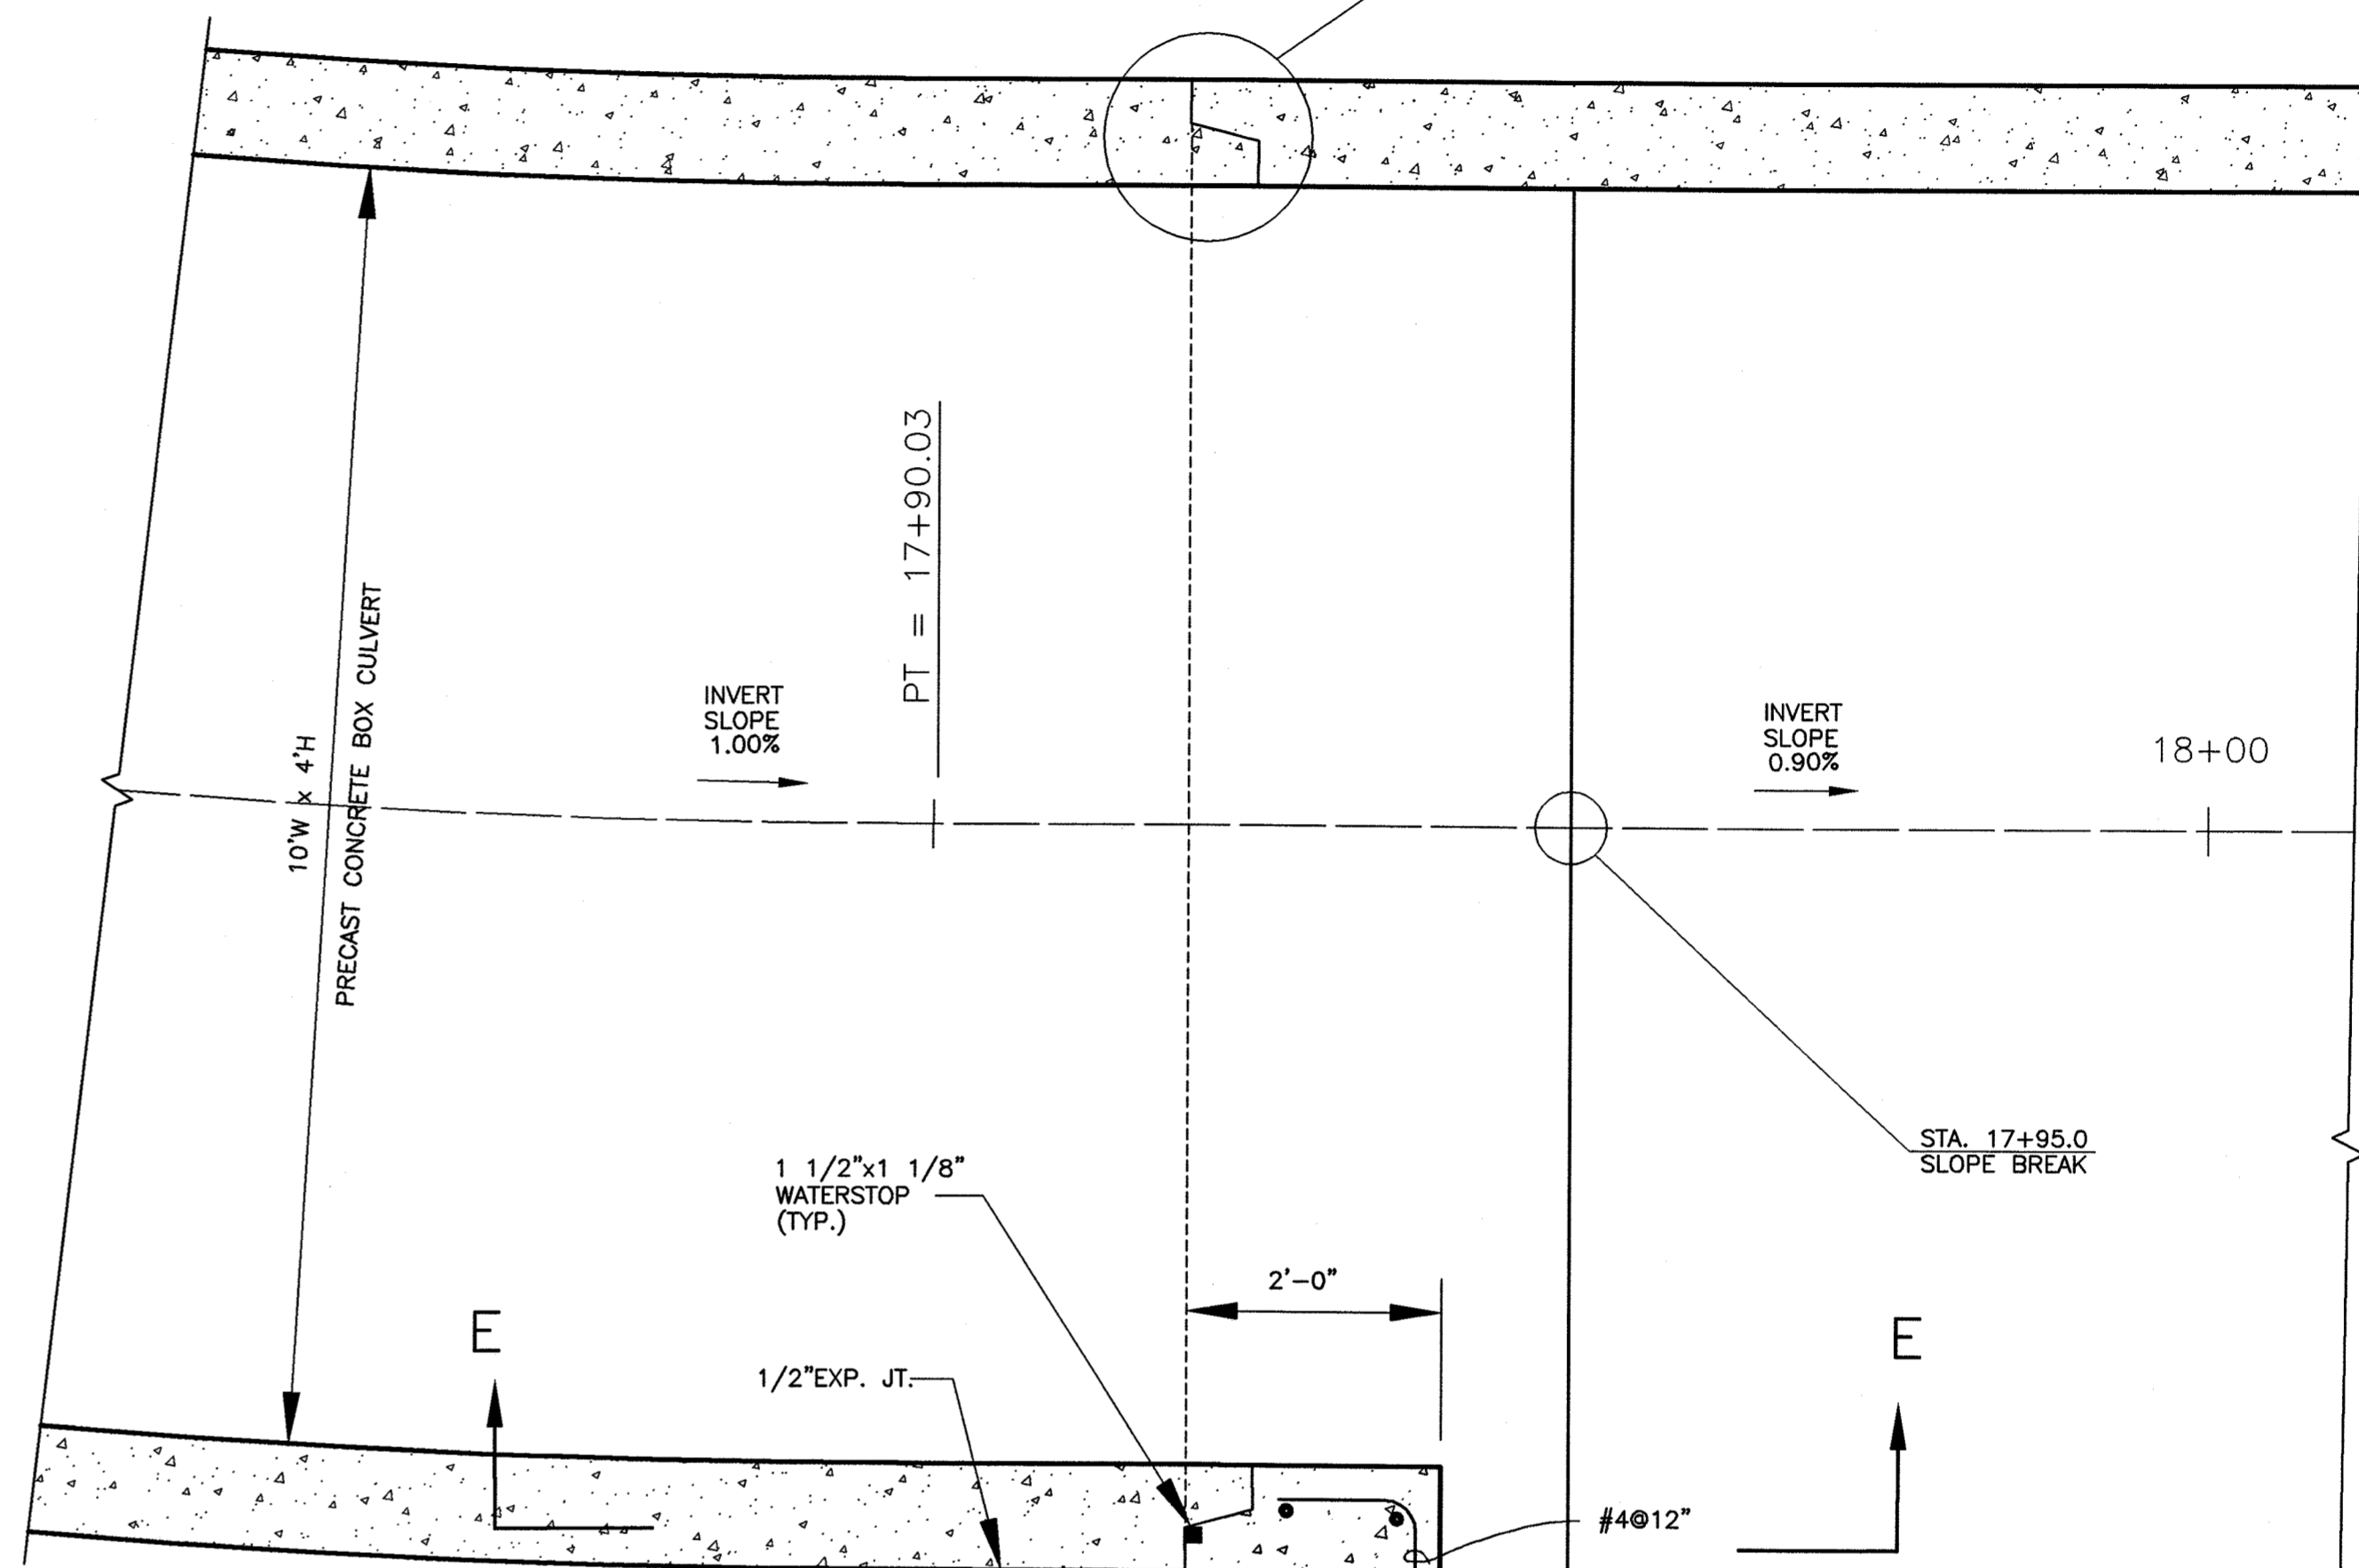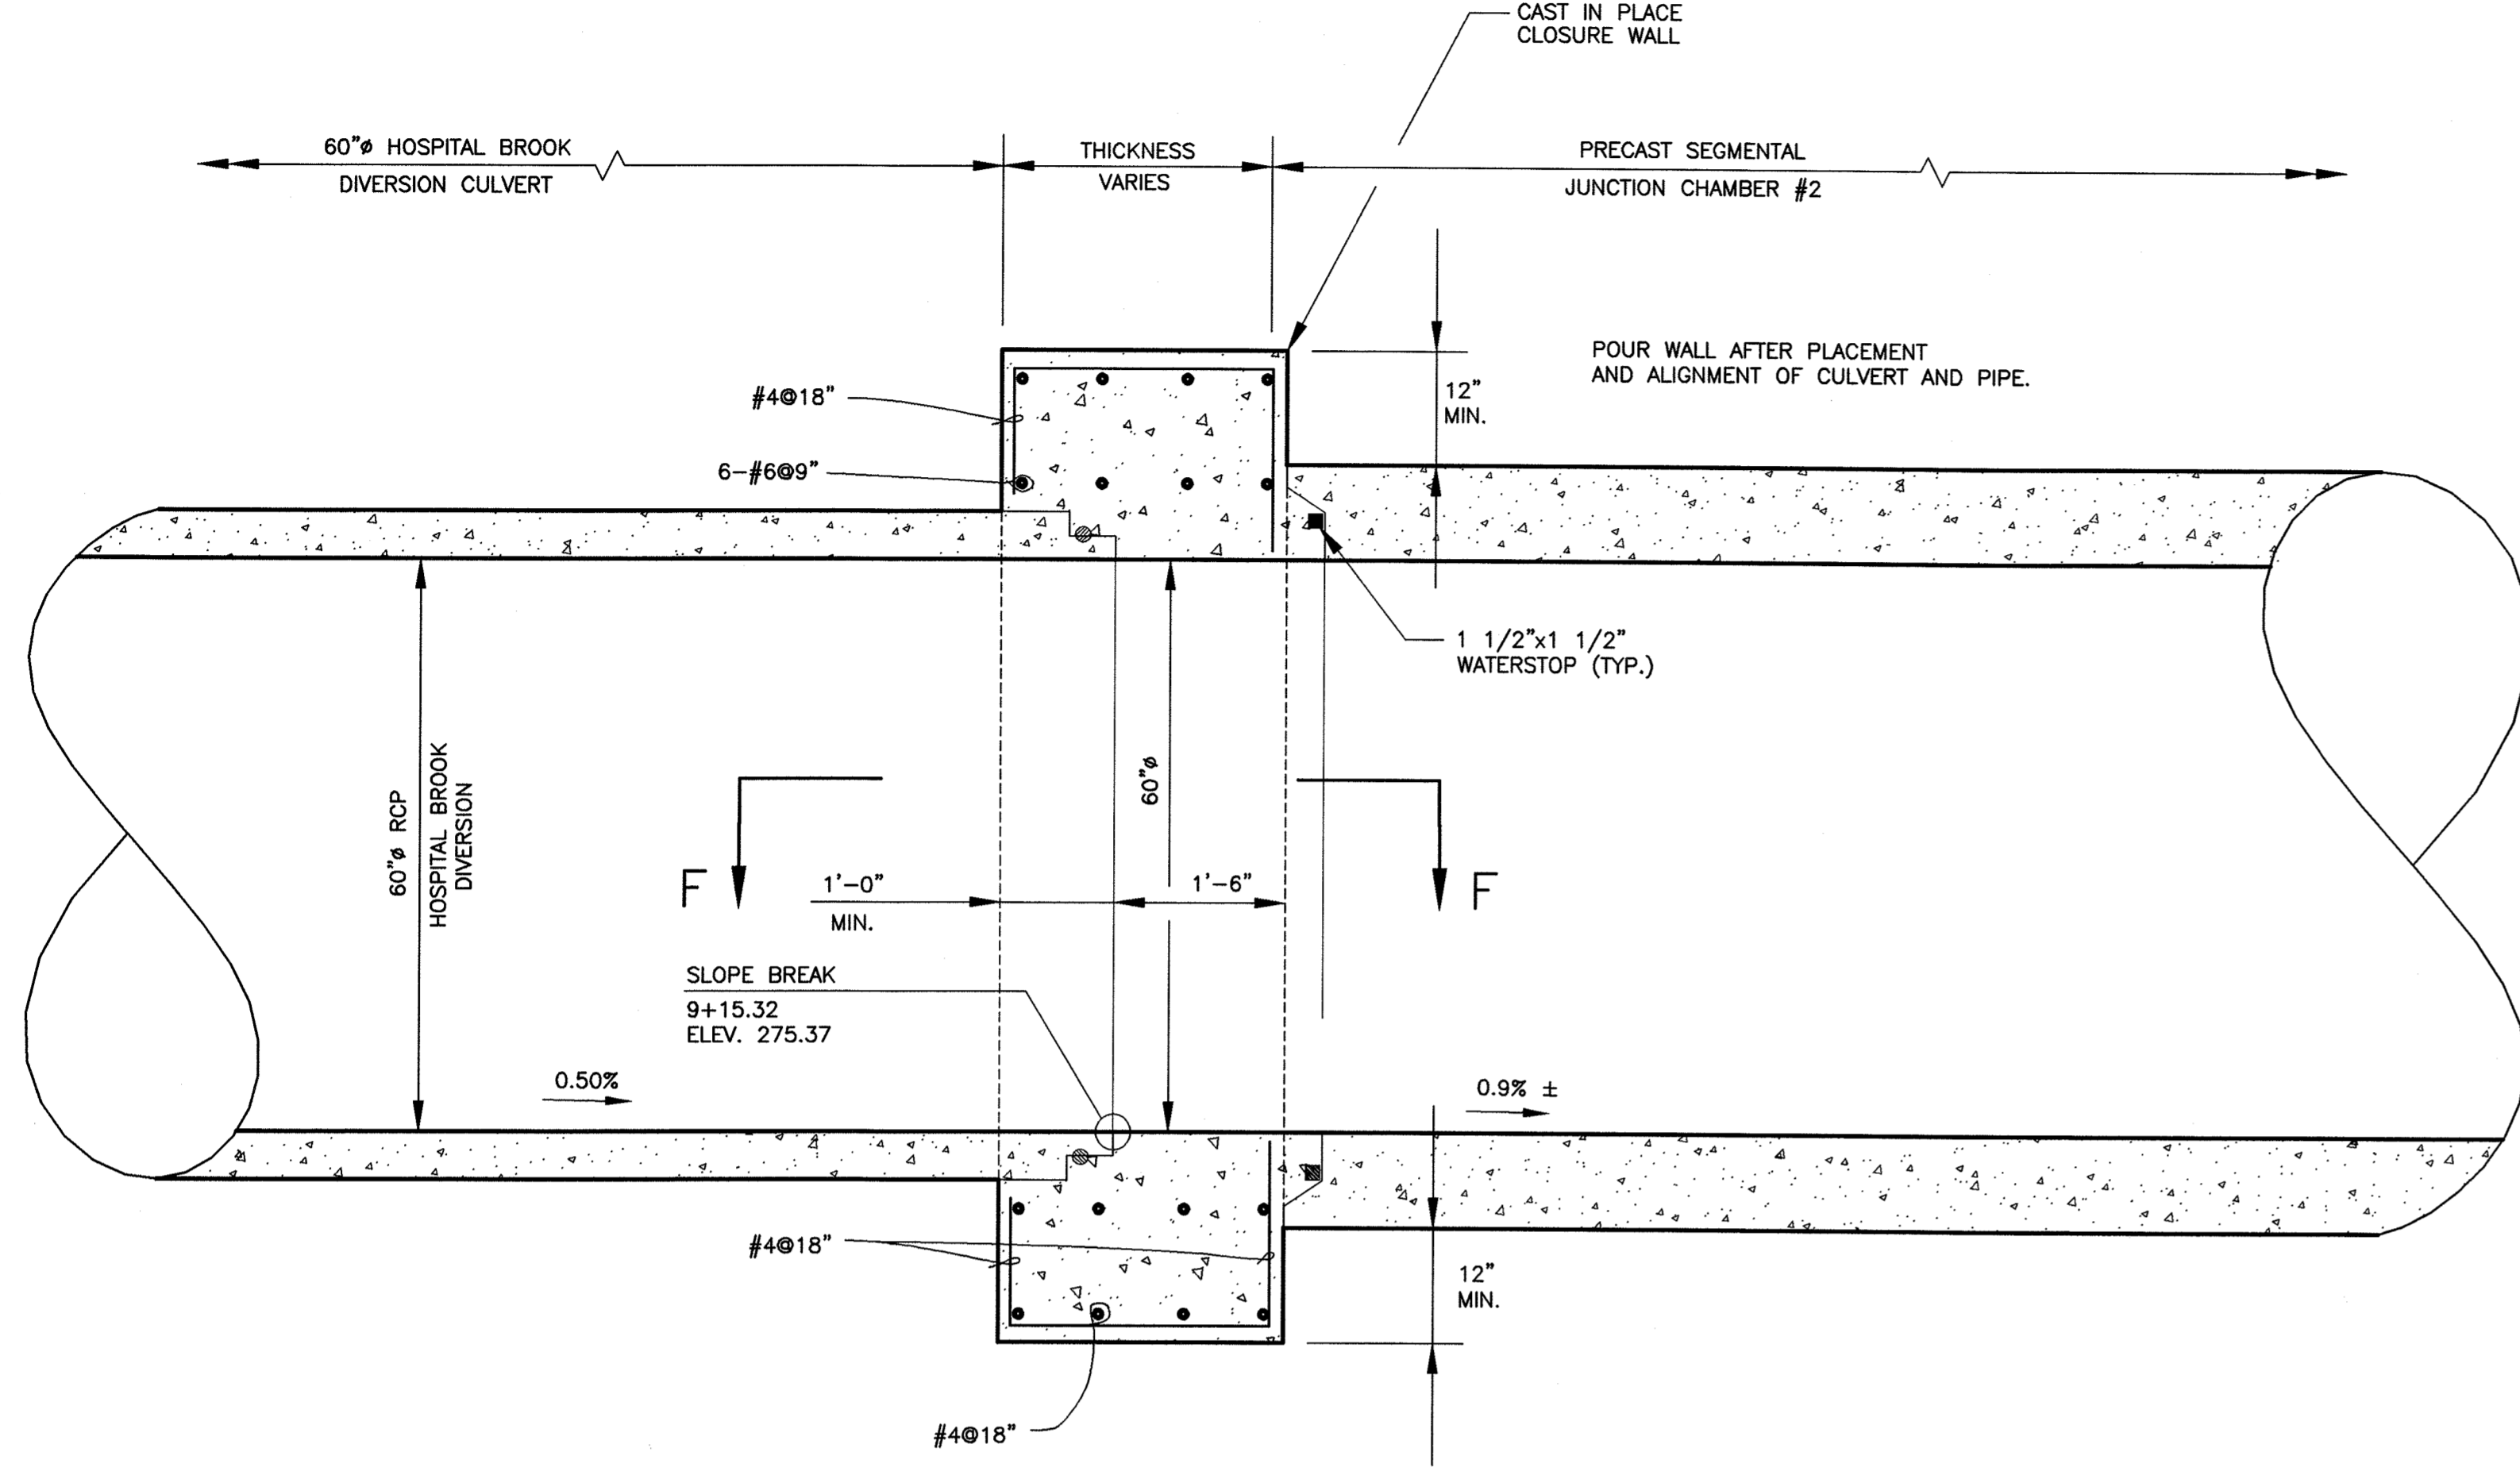

CAST-IN-PLACE CONC. NOTES:

1. $F_c = 4,000$ psi - CLASS A CONC.
2. REINF. - ASTM A-615 GRADE 60.
3. REINF. - 2" COVER MIN.
4. REINF. - MIN. SPLICE = 18"
5. 1" X 1" CHAMFER ALL CORNERS.

SECTION B-B
3/4"=1'

NOTE: IF BID ALTERNATE No. 1 IS NOT SELECTED, BASE BID SHALL INCLUDE 8' X 8' X 1.5' CAST-IN-PLACE TEMPORARY PLUG (3000 psi CEM. CONC.) AT HOSPITAL BROOK DIVERSION, STA. 6+16±.


PRECAST CULVERT & STRUCTURE DESIGN NOTES

CONCRETE MINIMUM STRENGTH = 5000 PSI @ 28 DAYS
 STEEL REINFORCEMENT - ASTM A615, GRADE 60
 WHEEL LOADING - AASHTO HS25-40
 COVER TO STEEL - 1.5 INCHES
 EARTH COVER - 0'-0" MINIMUM, 13'-6" MAXIMUM
 UNIT WEIGHT OF EARTH - 125 POUNDS PER CUBIC FOOT
 ACTIVE PRESSURE COEFFICIENT - 0.25 MIN., 0.5 MAX.
 2'-0" LIVE LOAD SURCHARGE APPLIED TO 13'-6" DEPTH
 EXTERIOR GROUND WATER AT FINISHED GRADE
 DESIGN SHALL BE IN ACCORDANCE WITH AASHTO SPECIFICATIONS FOR HIGHWAY BRIDGES, ACI 318-83, AND LOAD FACTOR DESIGN (AASHTO)

LOAD FACTORS
 DEAD LOAD 1.5
 LIVE LOAD 2.17
 HYDROSTATIC PRESSURE 1.4
 EARTH PRESSURE, HORIZ. 1.7


CAPACITY REDUCTION FACTORS
 SHEAR 0.85
 MOMENT 0.90

WEEP HOLES SHALL BE SUPPLIED IN CULVERT SECTIONS AND DIVERSION STRUCTURES AT RATE OF ONE (1) 4" WEEP PER 8 LINEAR FEET OF VERTICAL FACE.

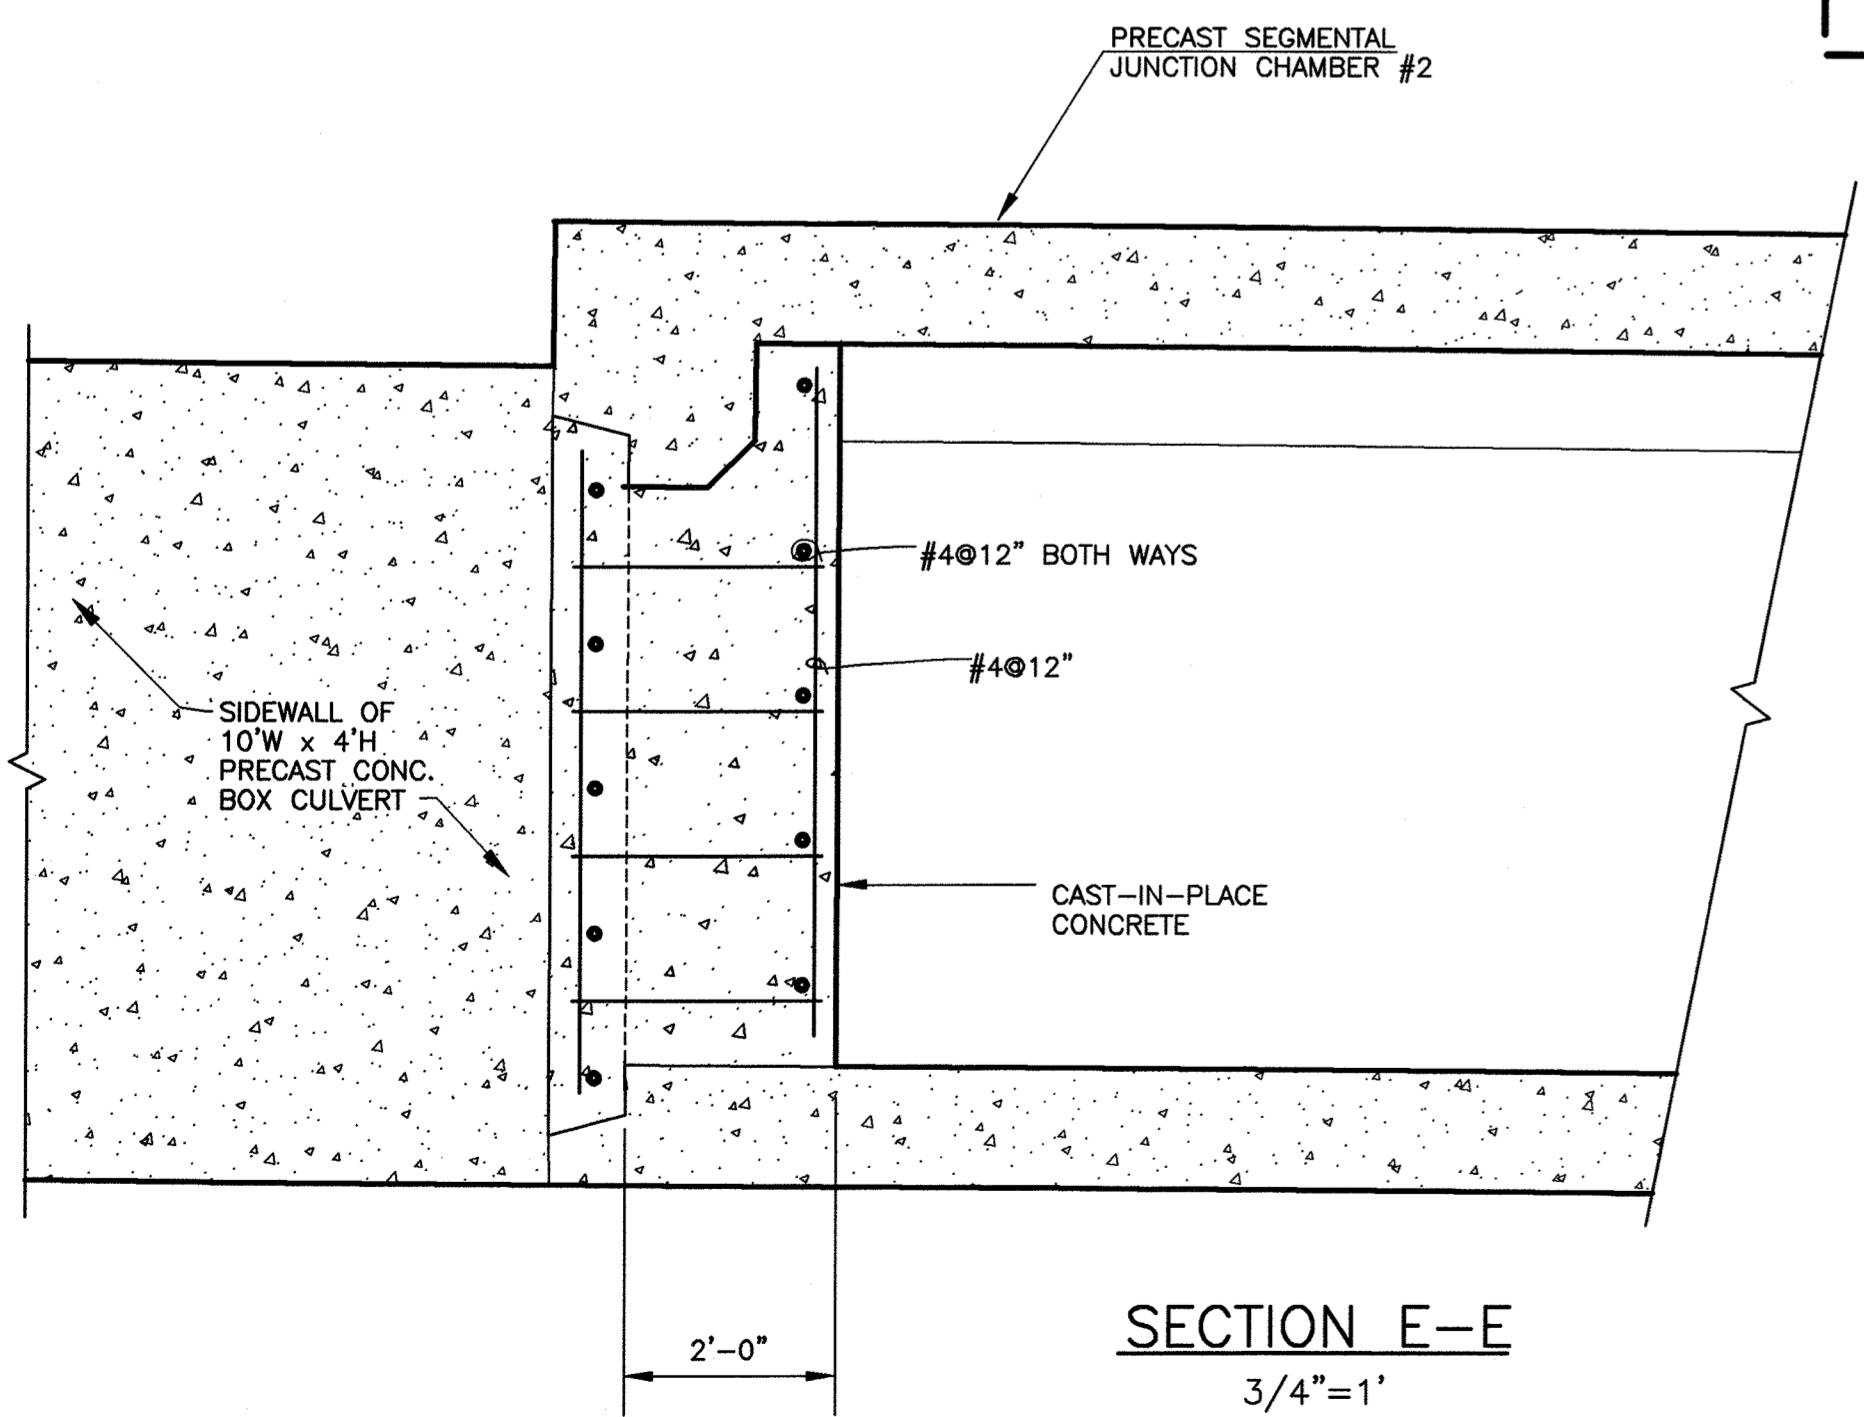

SECTION E-E
3/4"=1'


Bid Alternate No. 1
 Base Bid

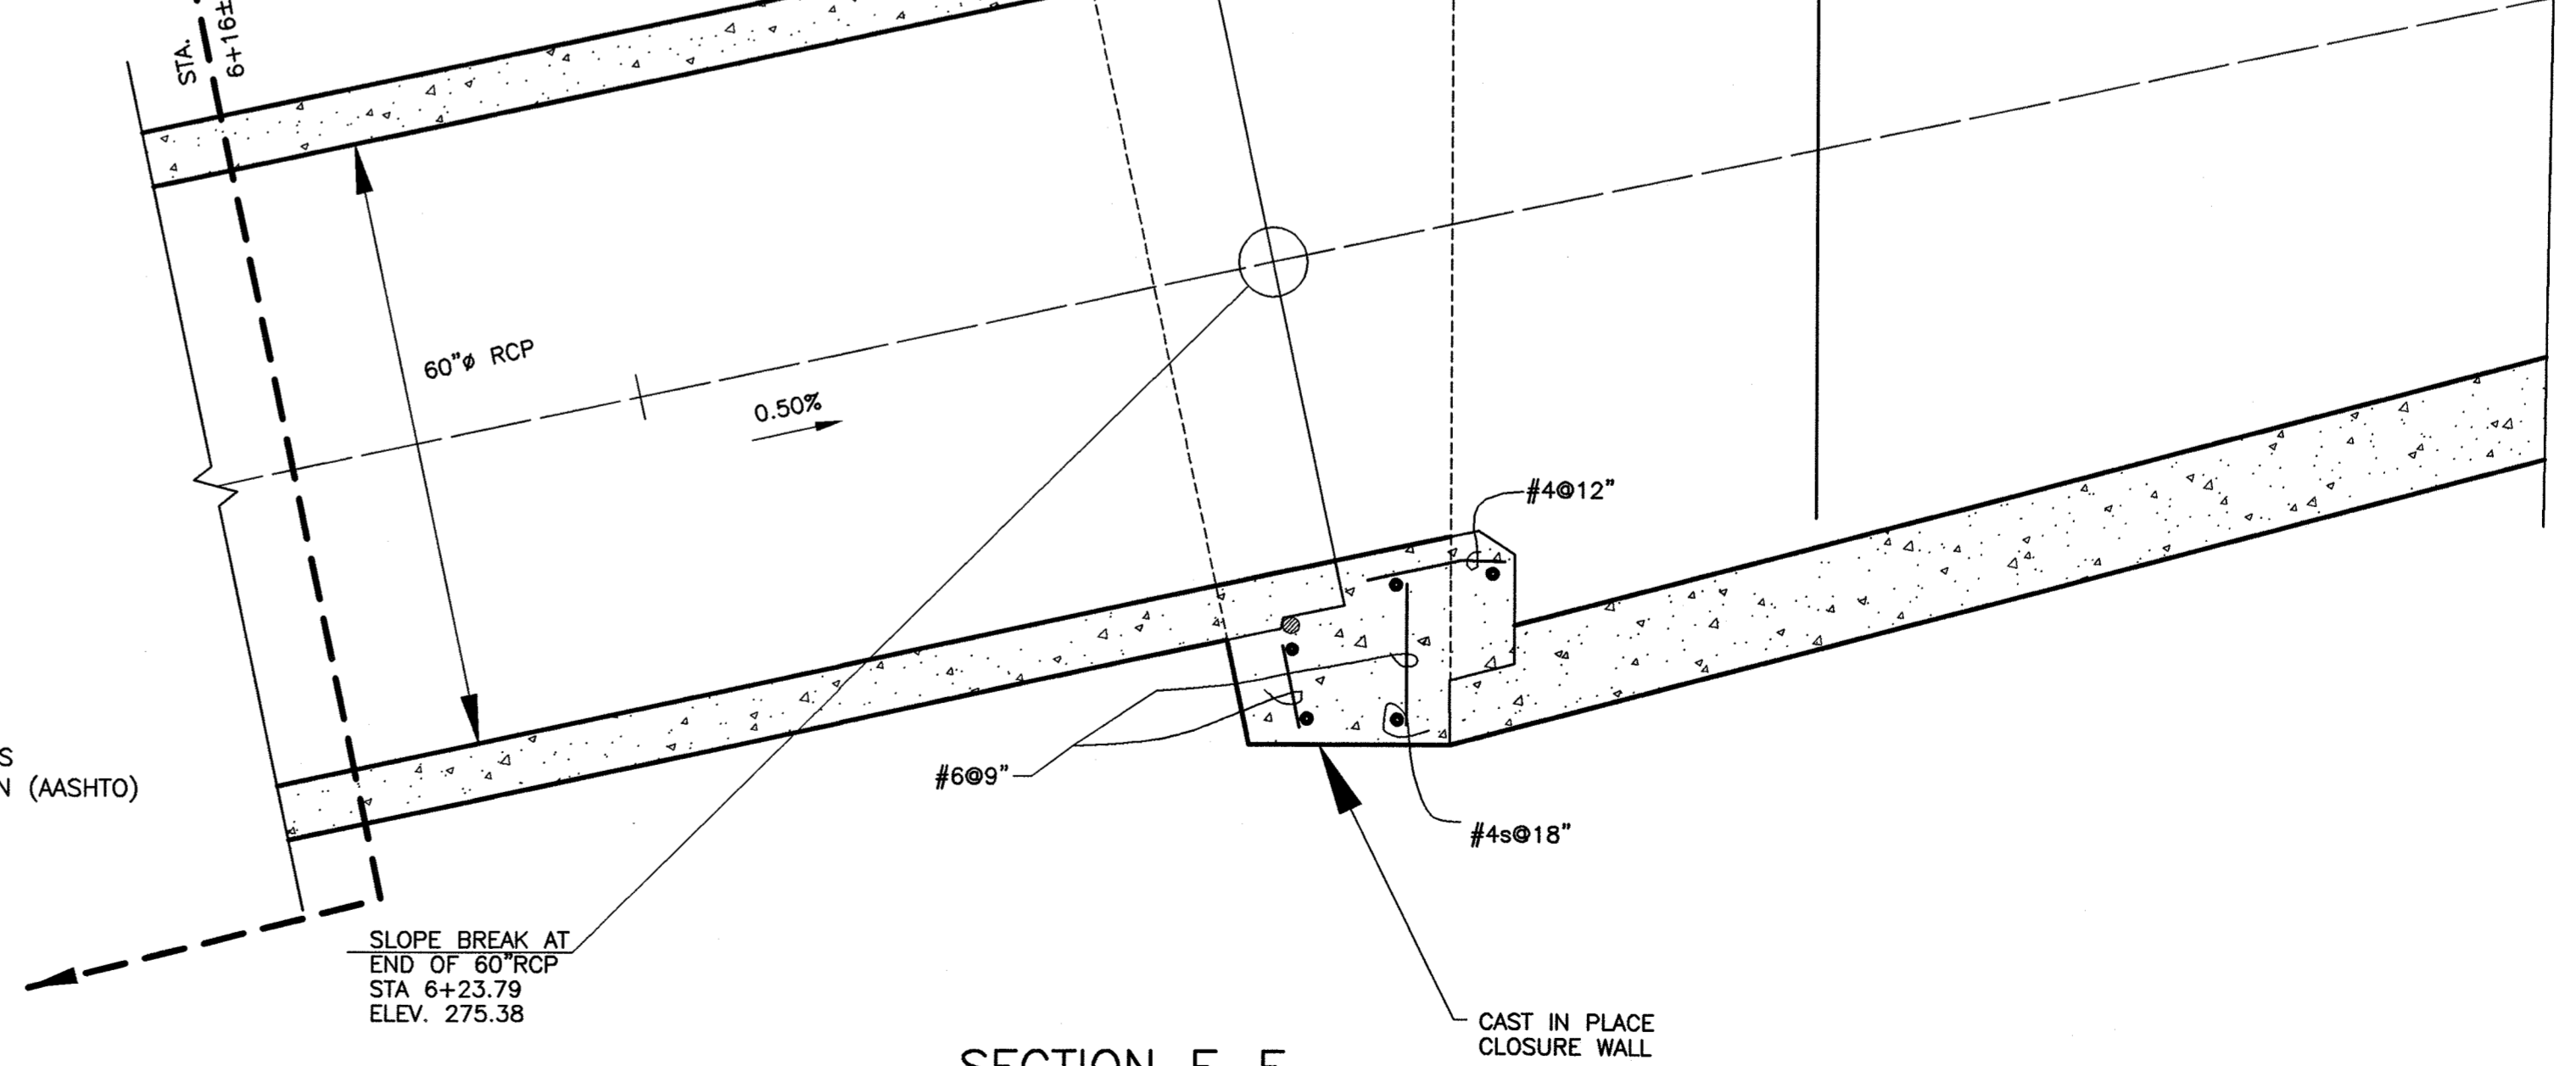


SECTION F-F
3/4"=1'

AutoCAD File: P:\AUTOCAD\ACAD\IN\941215\RECORD DRAWINGS\Sheet 30 31.dwg Plotted at: Tue Oct 02 09:32:55 2001
BEC, Inc.


DRAWING NO.		31 of 35 SHEETS	
BAYSTATE ENVIRONMENTAL CONSULTANTS INC. Engineers 296 North Main Street East Longmeadow, MA 01028 Scientists Surveyors			
PROJECT NO.	SCALE	DATE	DRAWN BY
94-1215	AS NOTED	APRIL 1999	EDM
SHEET TITLE		CHECKED BY	DATE
Junction Chamber No. 2 Sections		TEJ	8/12/99
Godfrey Brook Flood Mitigation Project Milford, Massachusetts			
ISSUED AS RECORD PRINT	EDM	BY	
ISSUED FOR BIDDING	TEJ	BY	
NO.	DATE	REVISION	

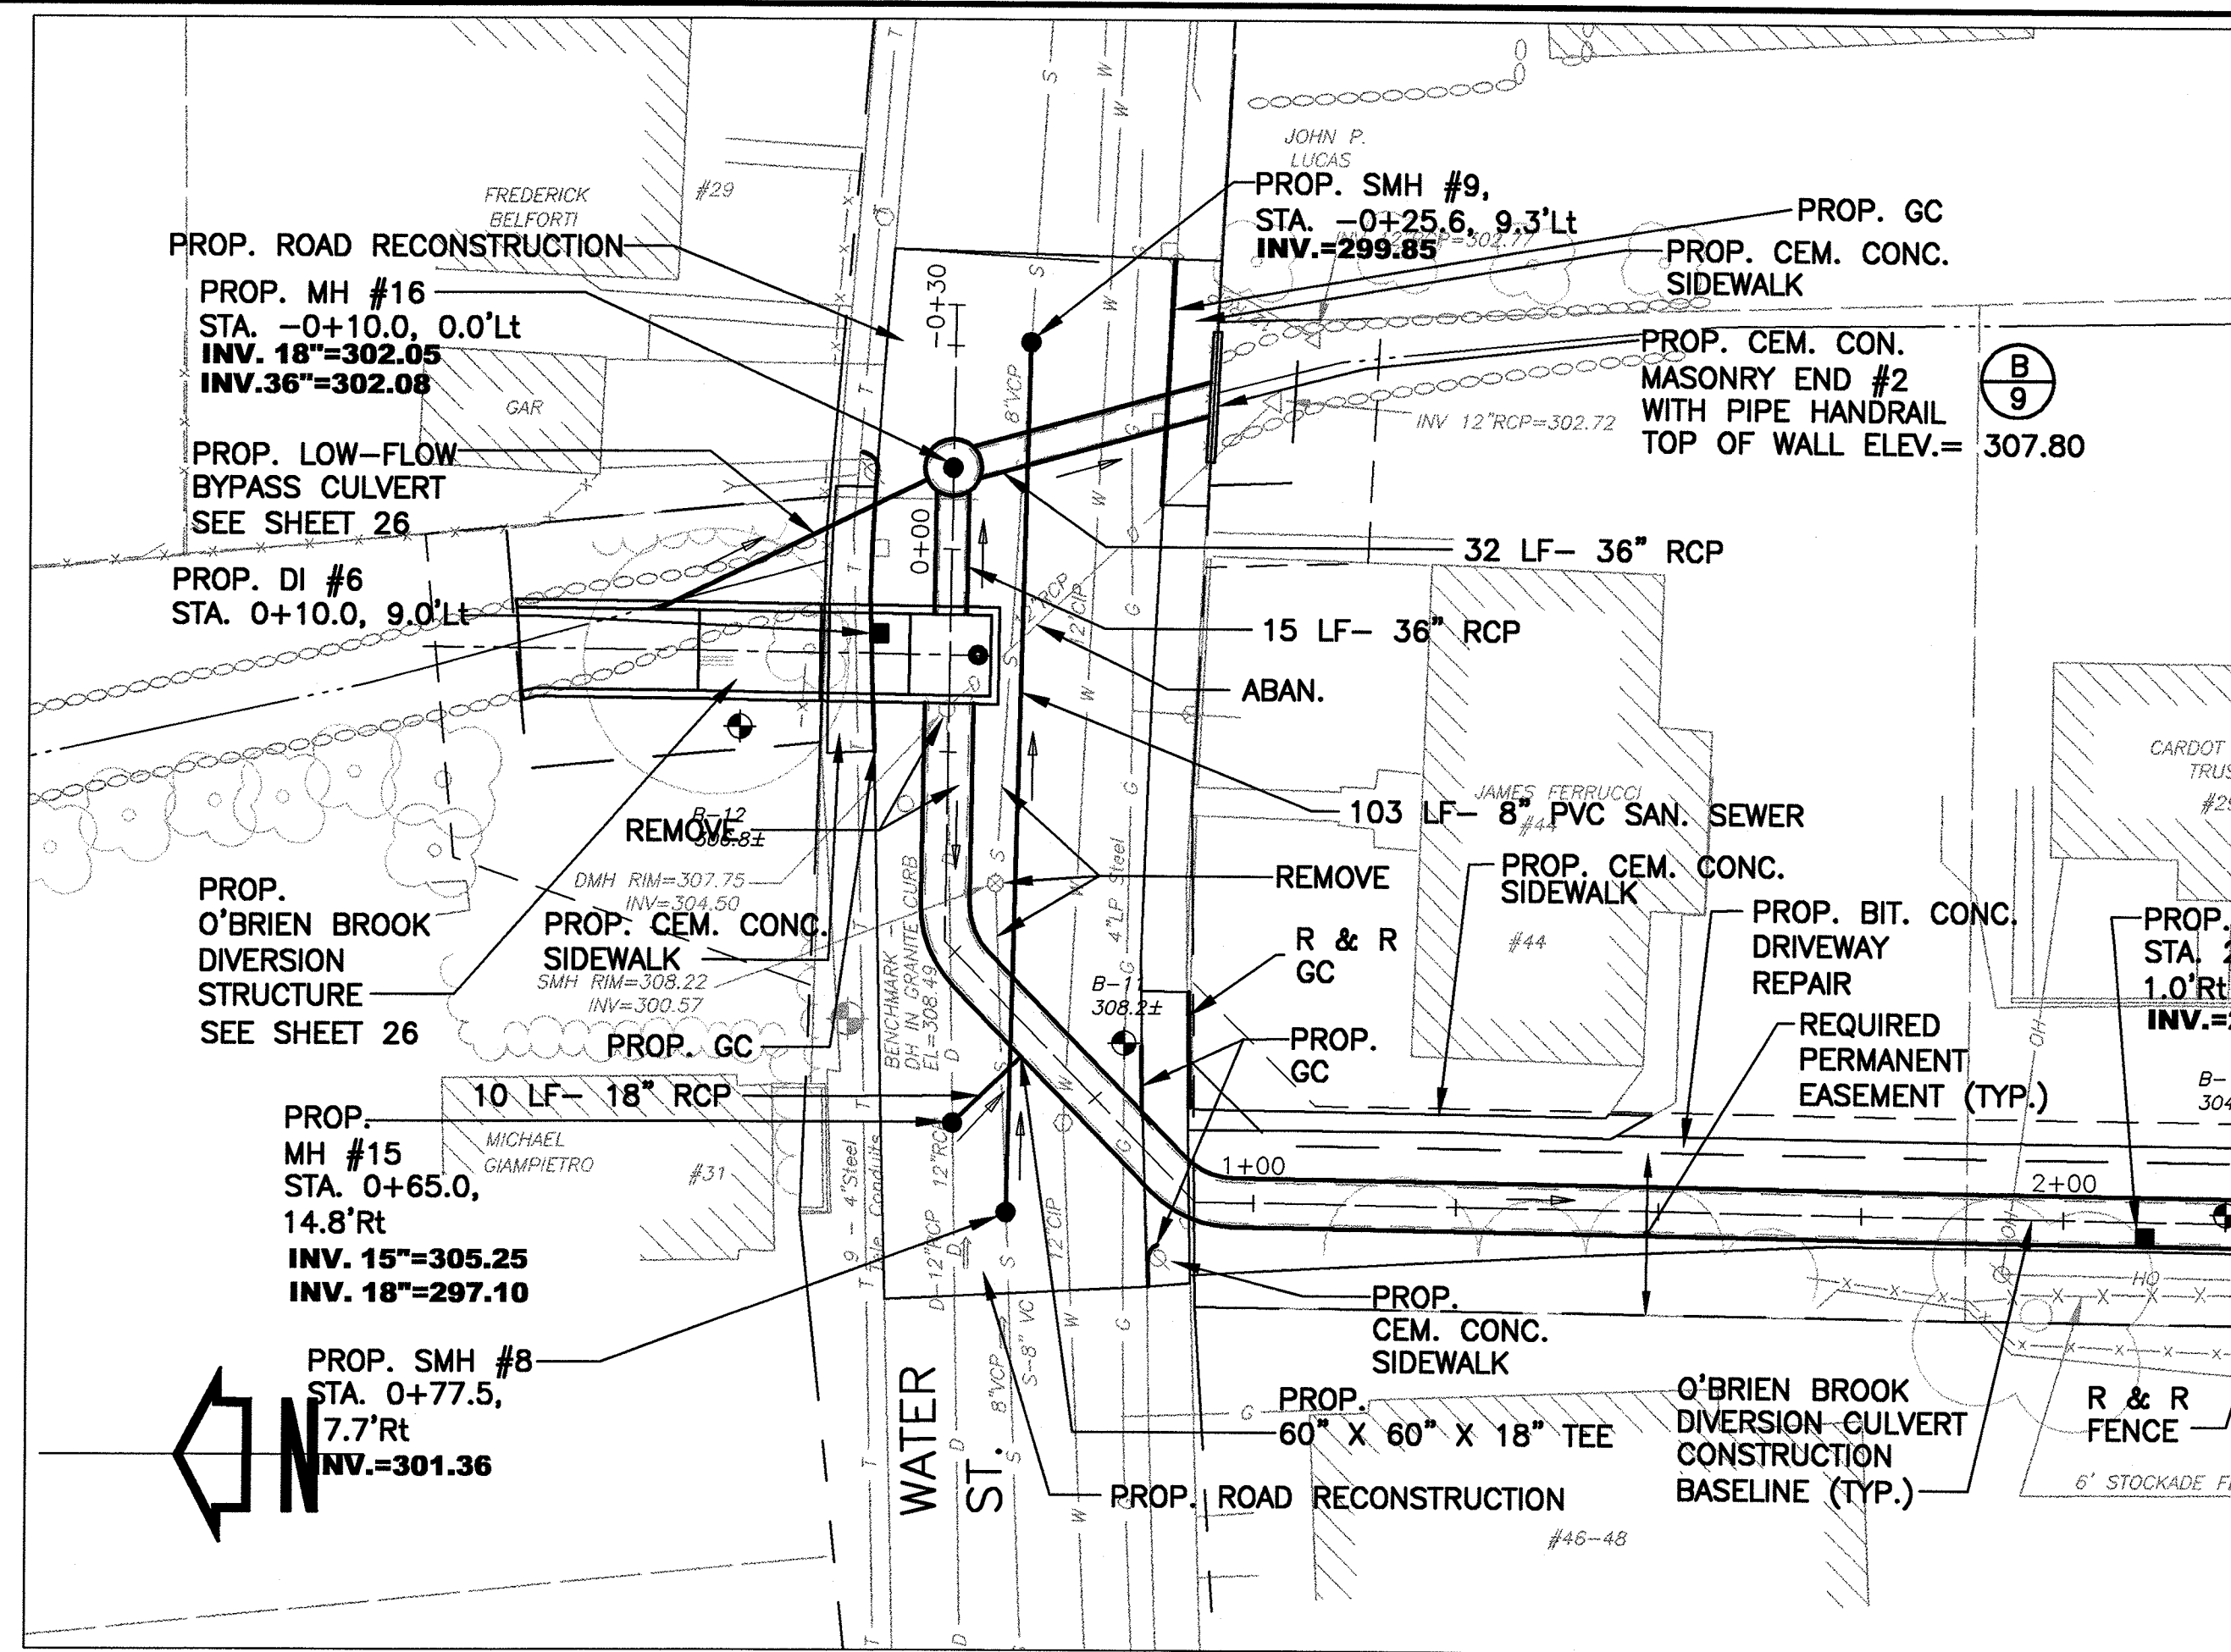


SEE SHEET 17 FOR PLAN/PROFILE OF O'BRIEN BROOK DIVERSION CULVERT IN THIS AREA
PARTIAL PLAN OF O'BRIEN BROOK DIVERSION AREA
 1" = 20'

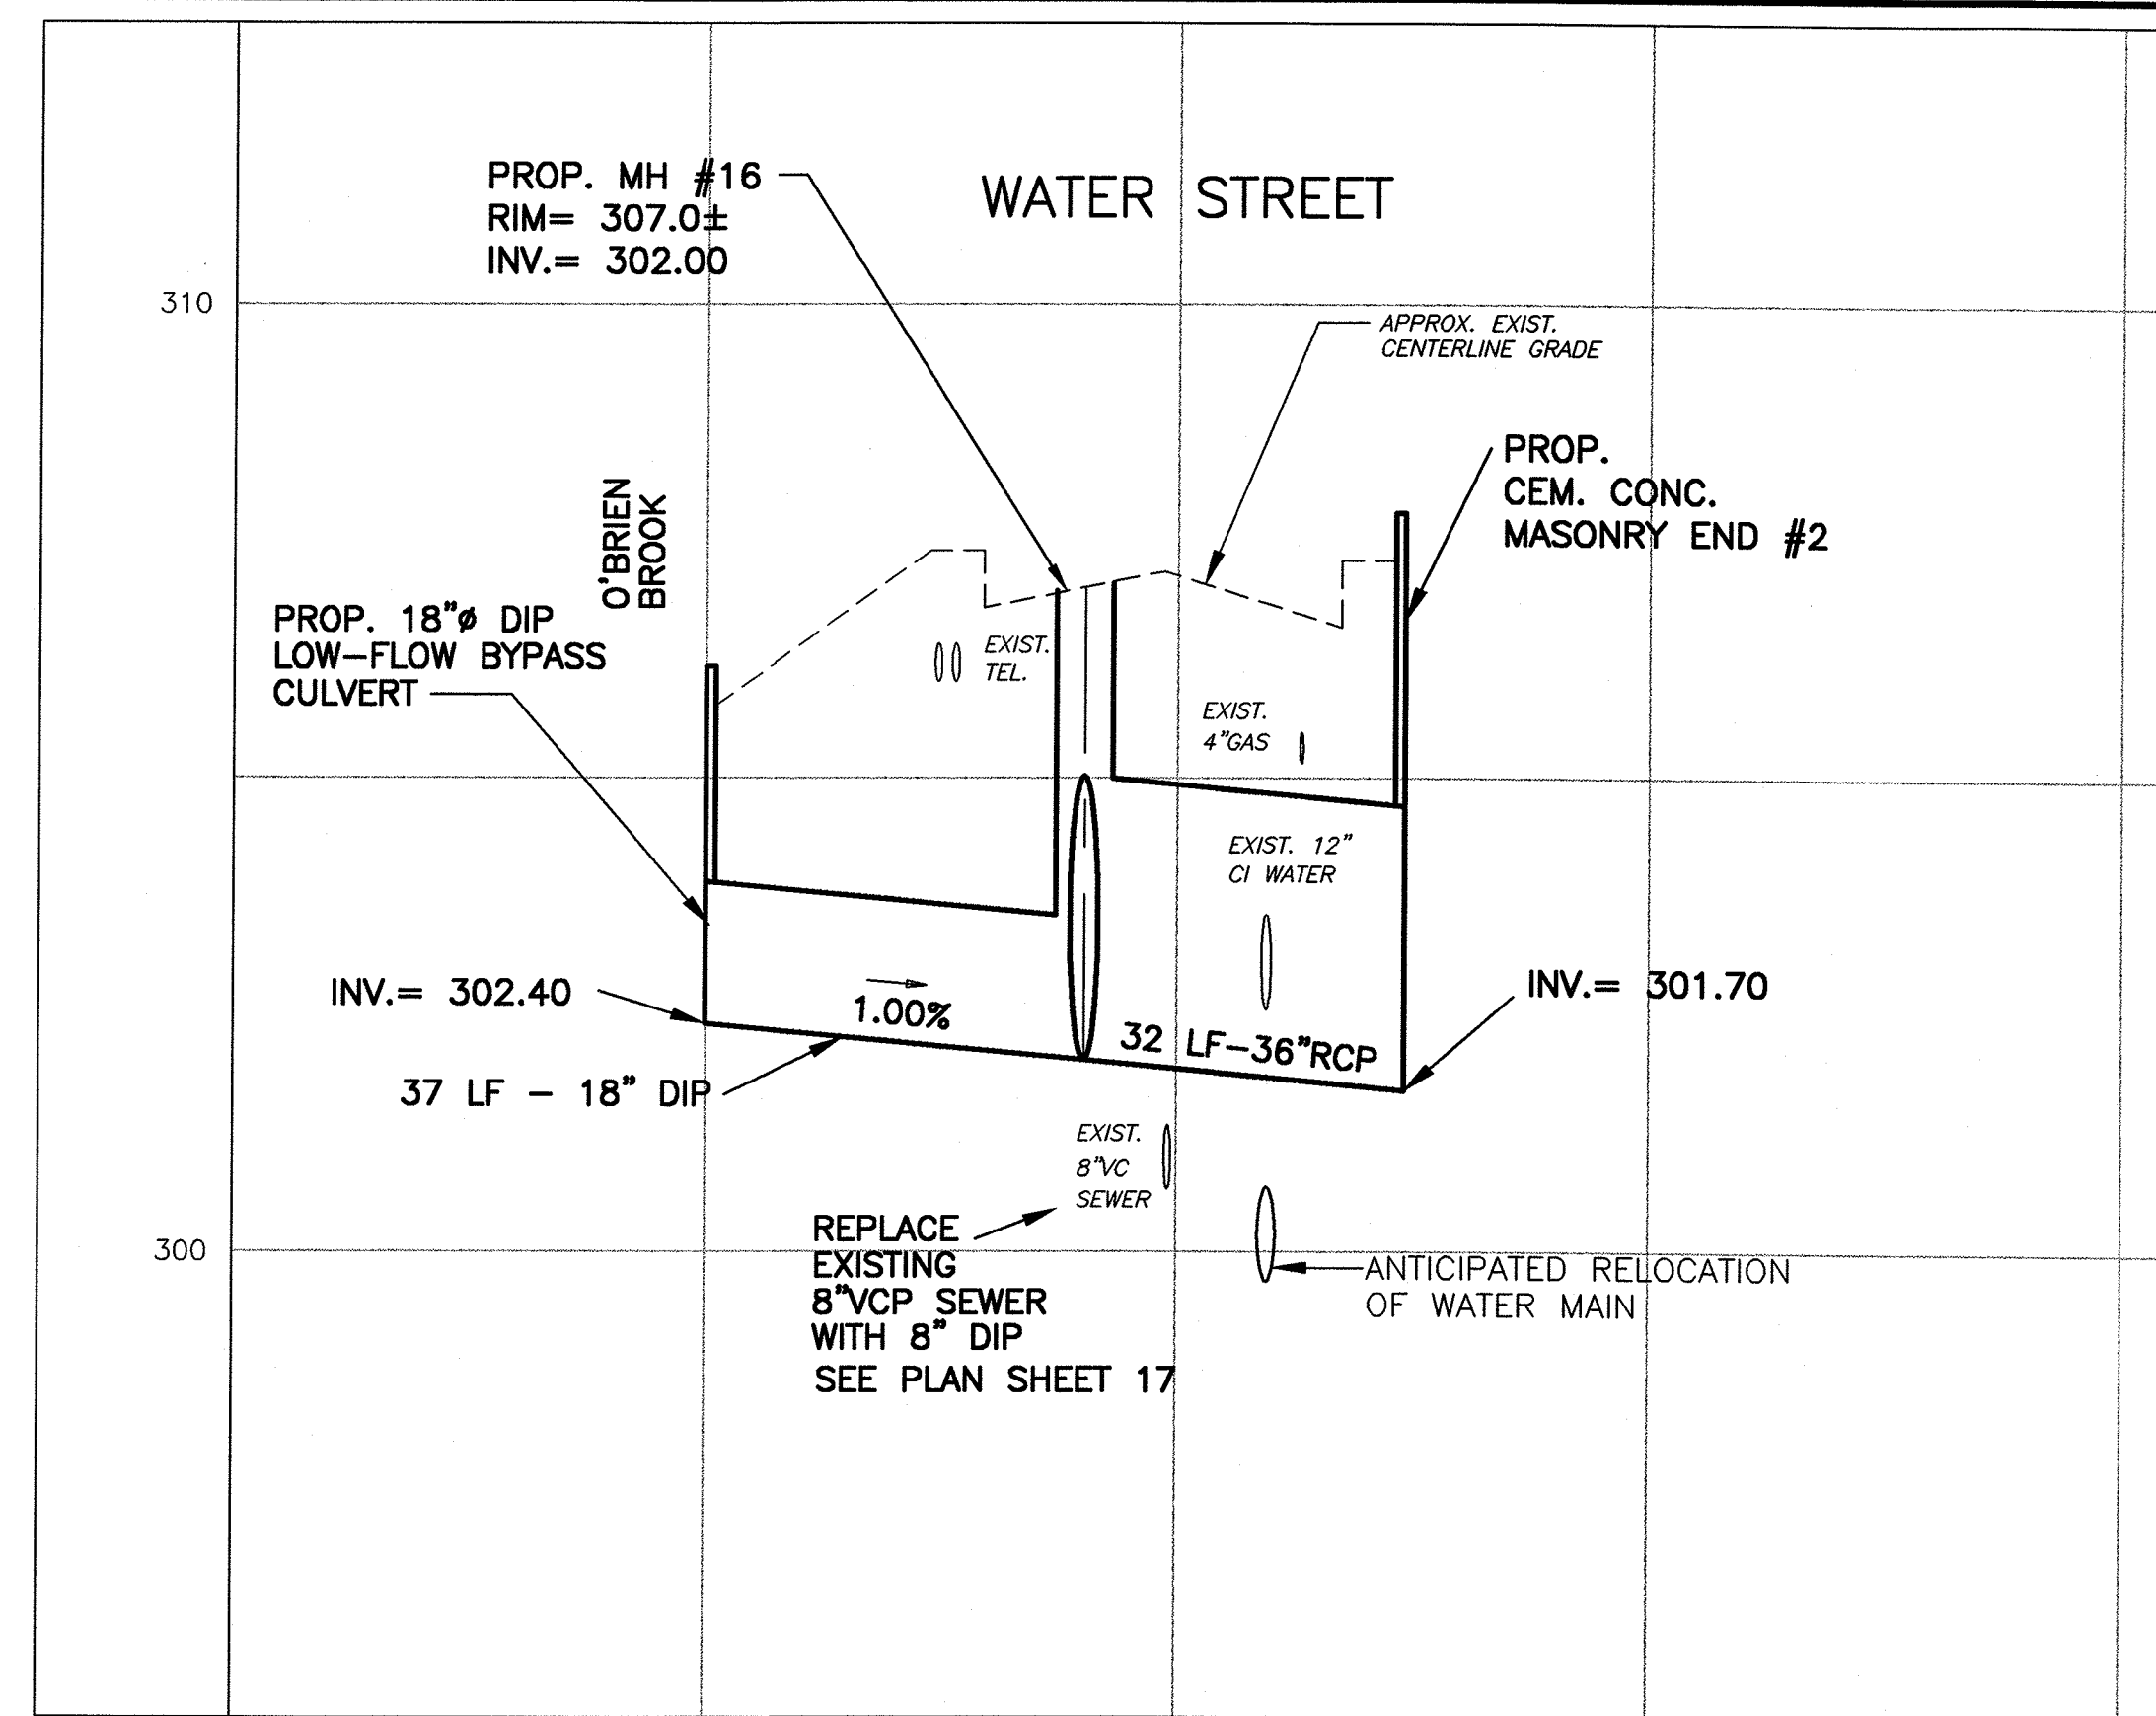

— DRAIN PROFILE —
PROP. O'BRIEN BROOK LOW-FLOW BYPASS CULVERT, MH #16, & FIELDSTONE MASONRY END
 VERT. 1"=2'
 HOR. 1"=20'

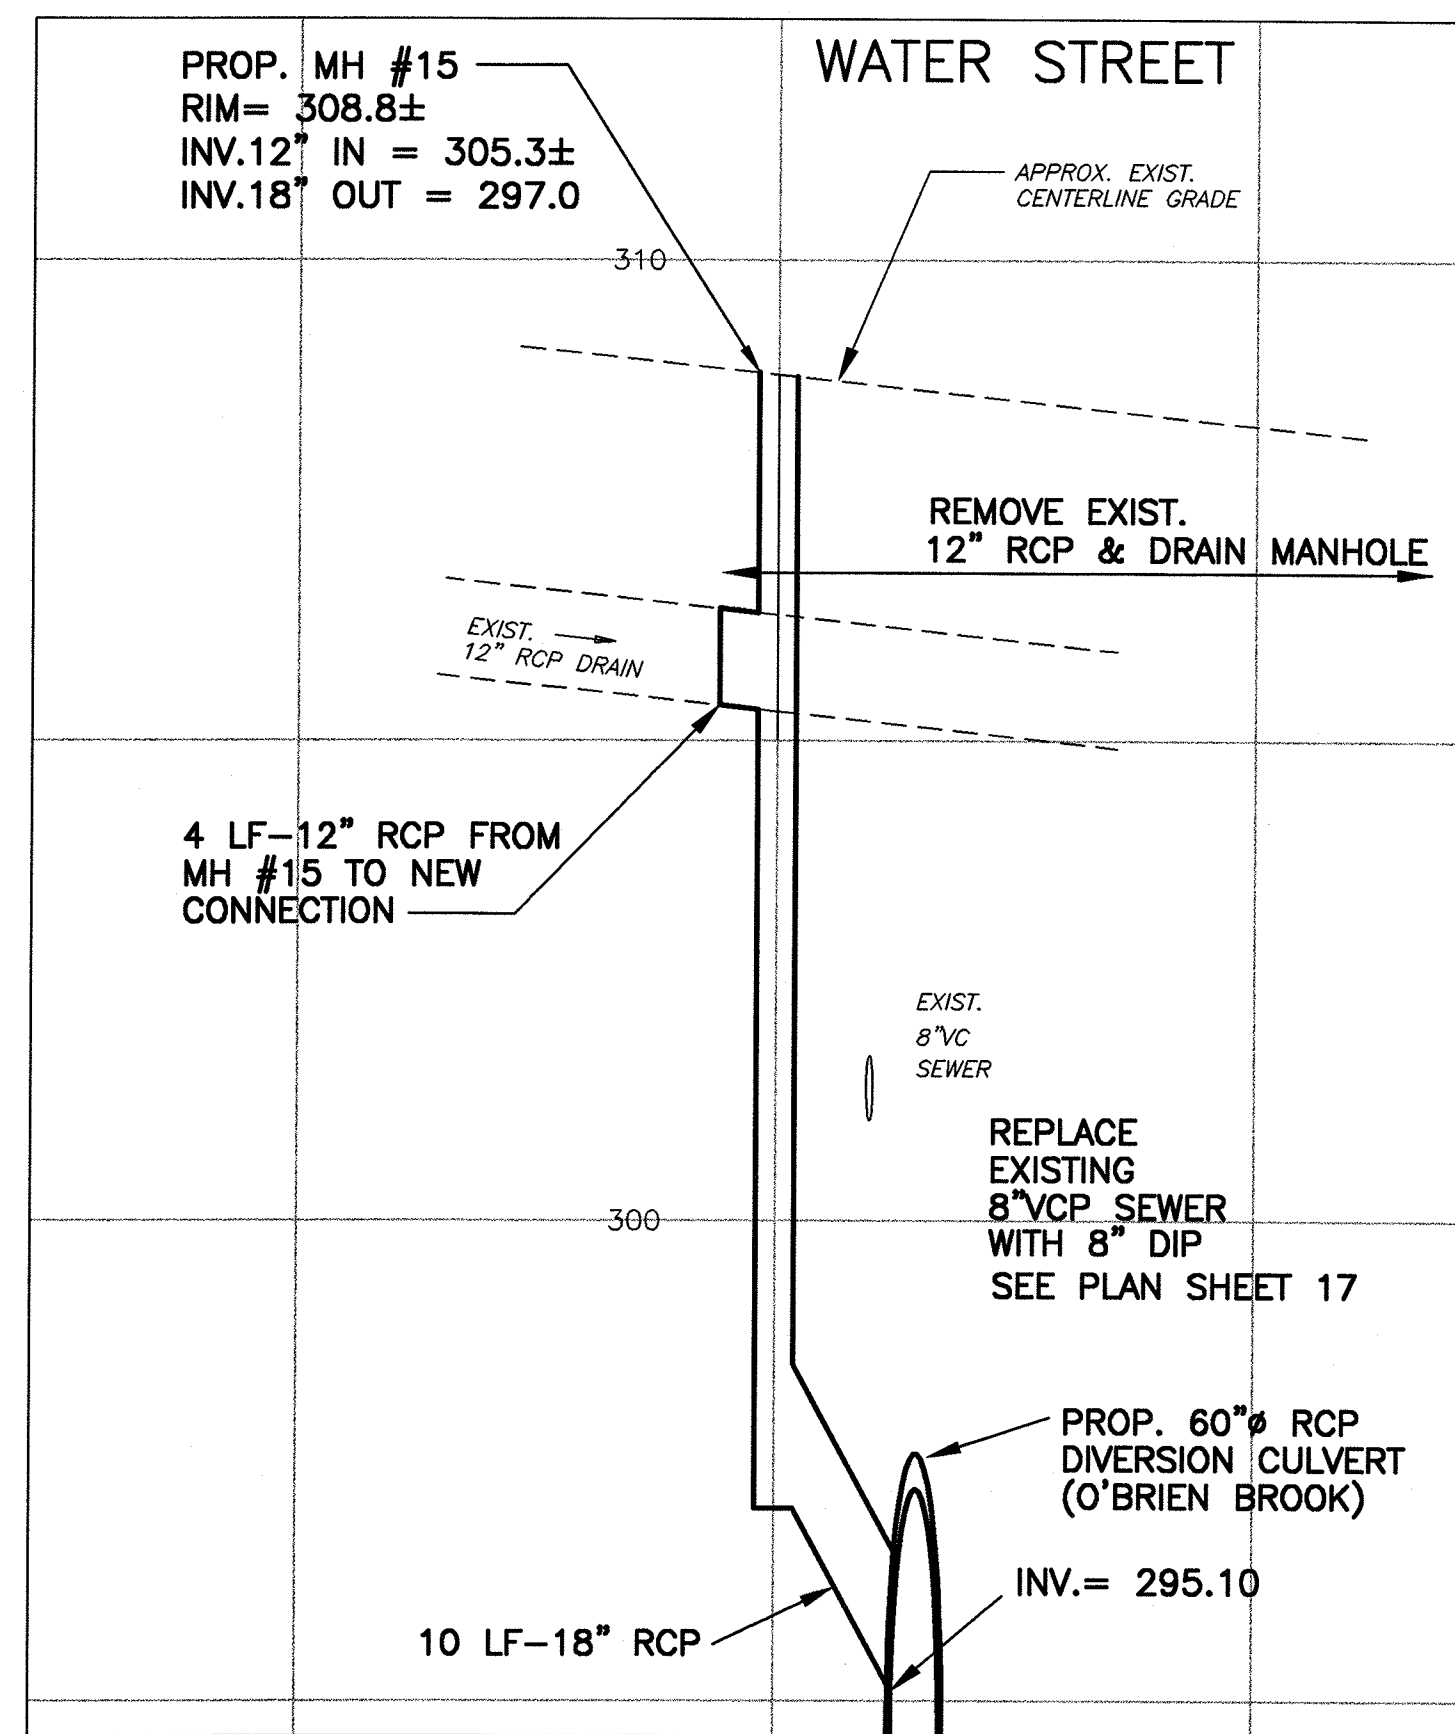







— DRAIN PROFILE —
PROP. MH #15 TO DIVERSION CULVERT
 VERT. 1"=2'
 HOR. 1"=20'

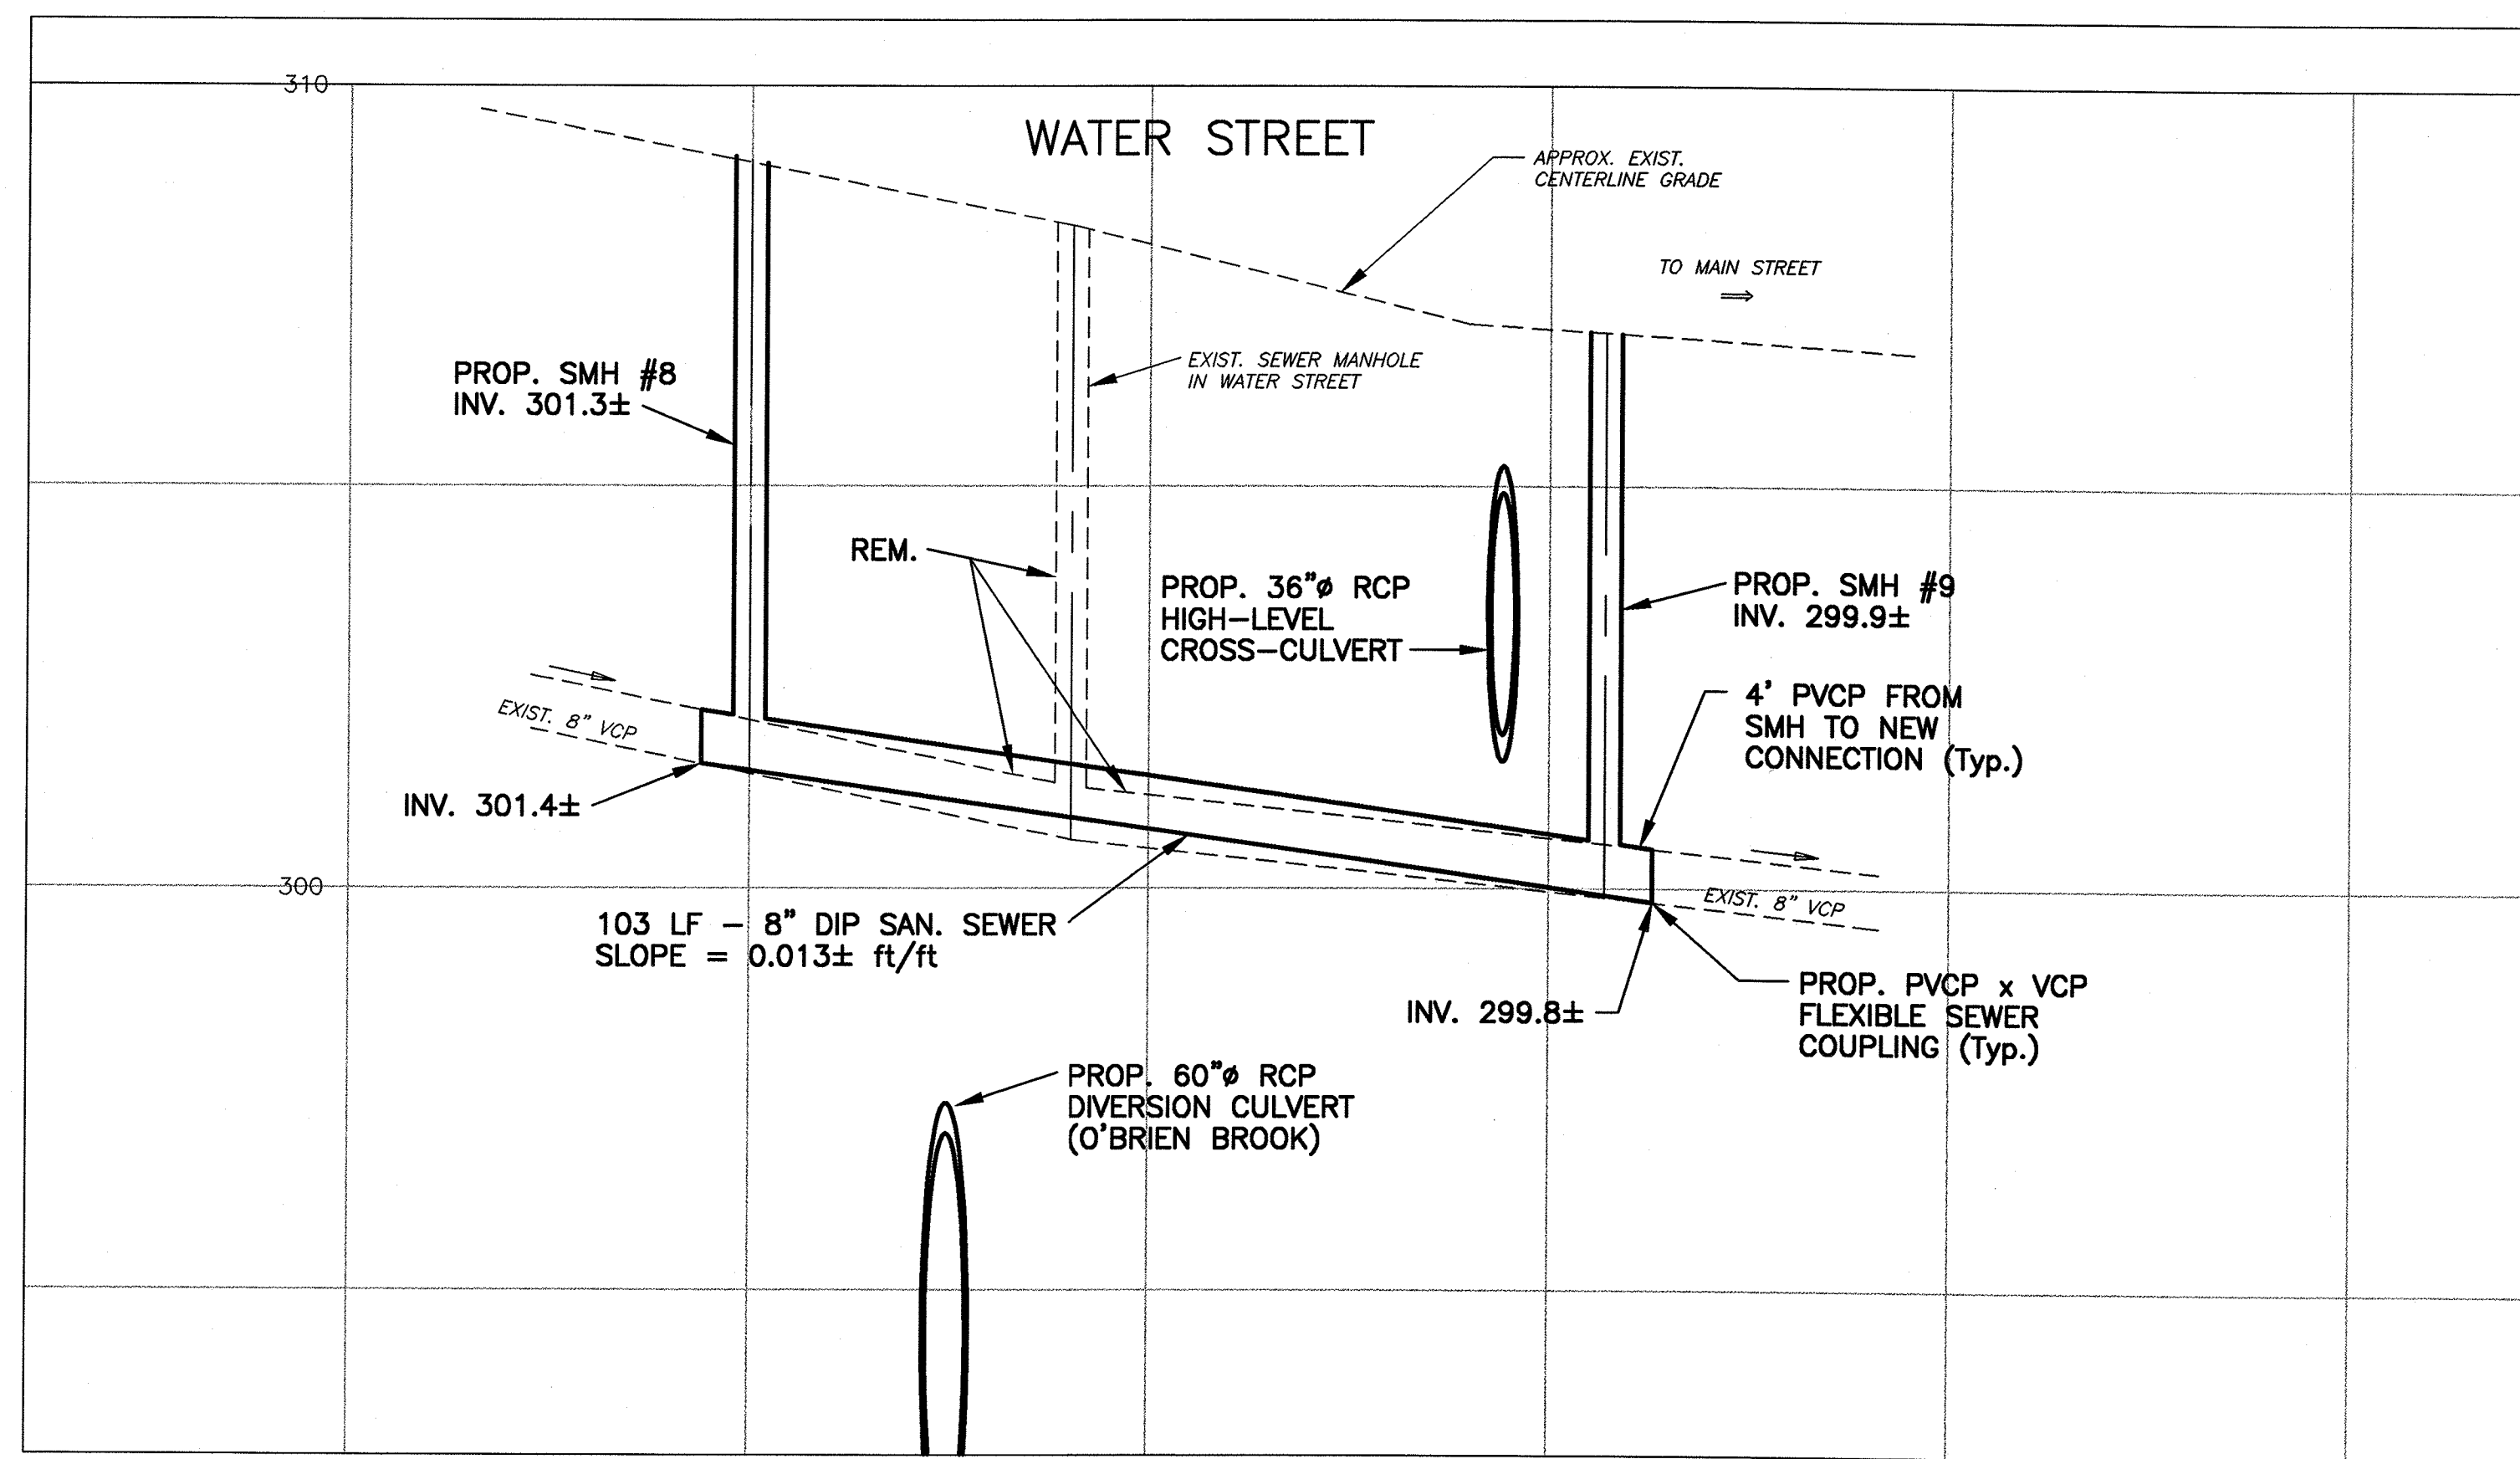

— SAN. SEWER PROFILE —
PROP. SMH #8 TO SMH #9, WATER STREET
 VERT. 1"=2'
 HOR. 1"=20'


AutoCAD File: P:\AUTOCAD\ADMIN\944215\RECORD DRAWINGS\Sheet 16 17 18 22 34.dwg Plotted at: Tue Oct 02 08:35:01 2001

		BAYSTATE ENVIRONMENTAL CONSULTANTS INC. Engineers 298 North Main Street East Longmeadow, MA 01028 Scientists Surveyors	
		PROJECT NO. 94-1215 SCALE AS NOTED DATE APRIL 1999 DRAWN BY EDM CHECKED BY TEJ	
SHEET TITLE Utility Profiles No. 3 Proposed Drains and Sanitary Sewers		PROJECT Godfrey Brook Flood Mitigation Project Milford, Massachusetts	
ISSUED AS RECORD PRINT 10/1/01	ISSUED FOR BIDDING 8/12/99	EDM TEJ	BY
NO.	DATE	REVISION	

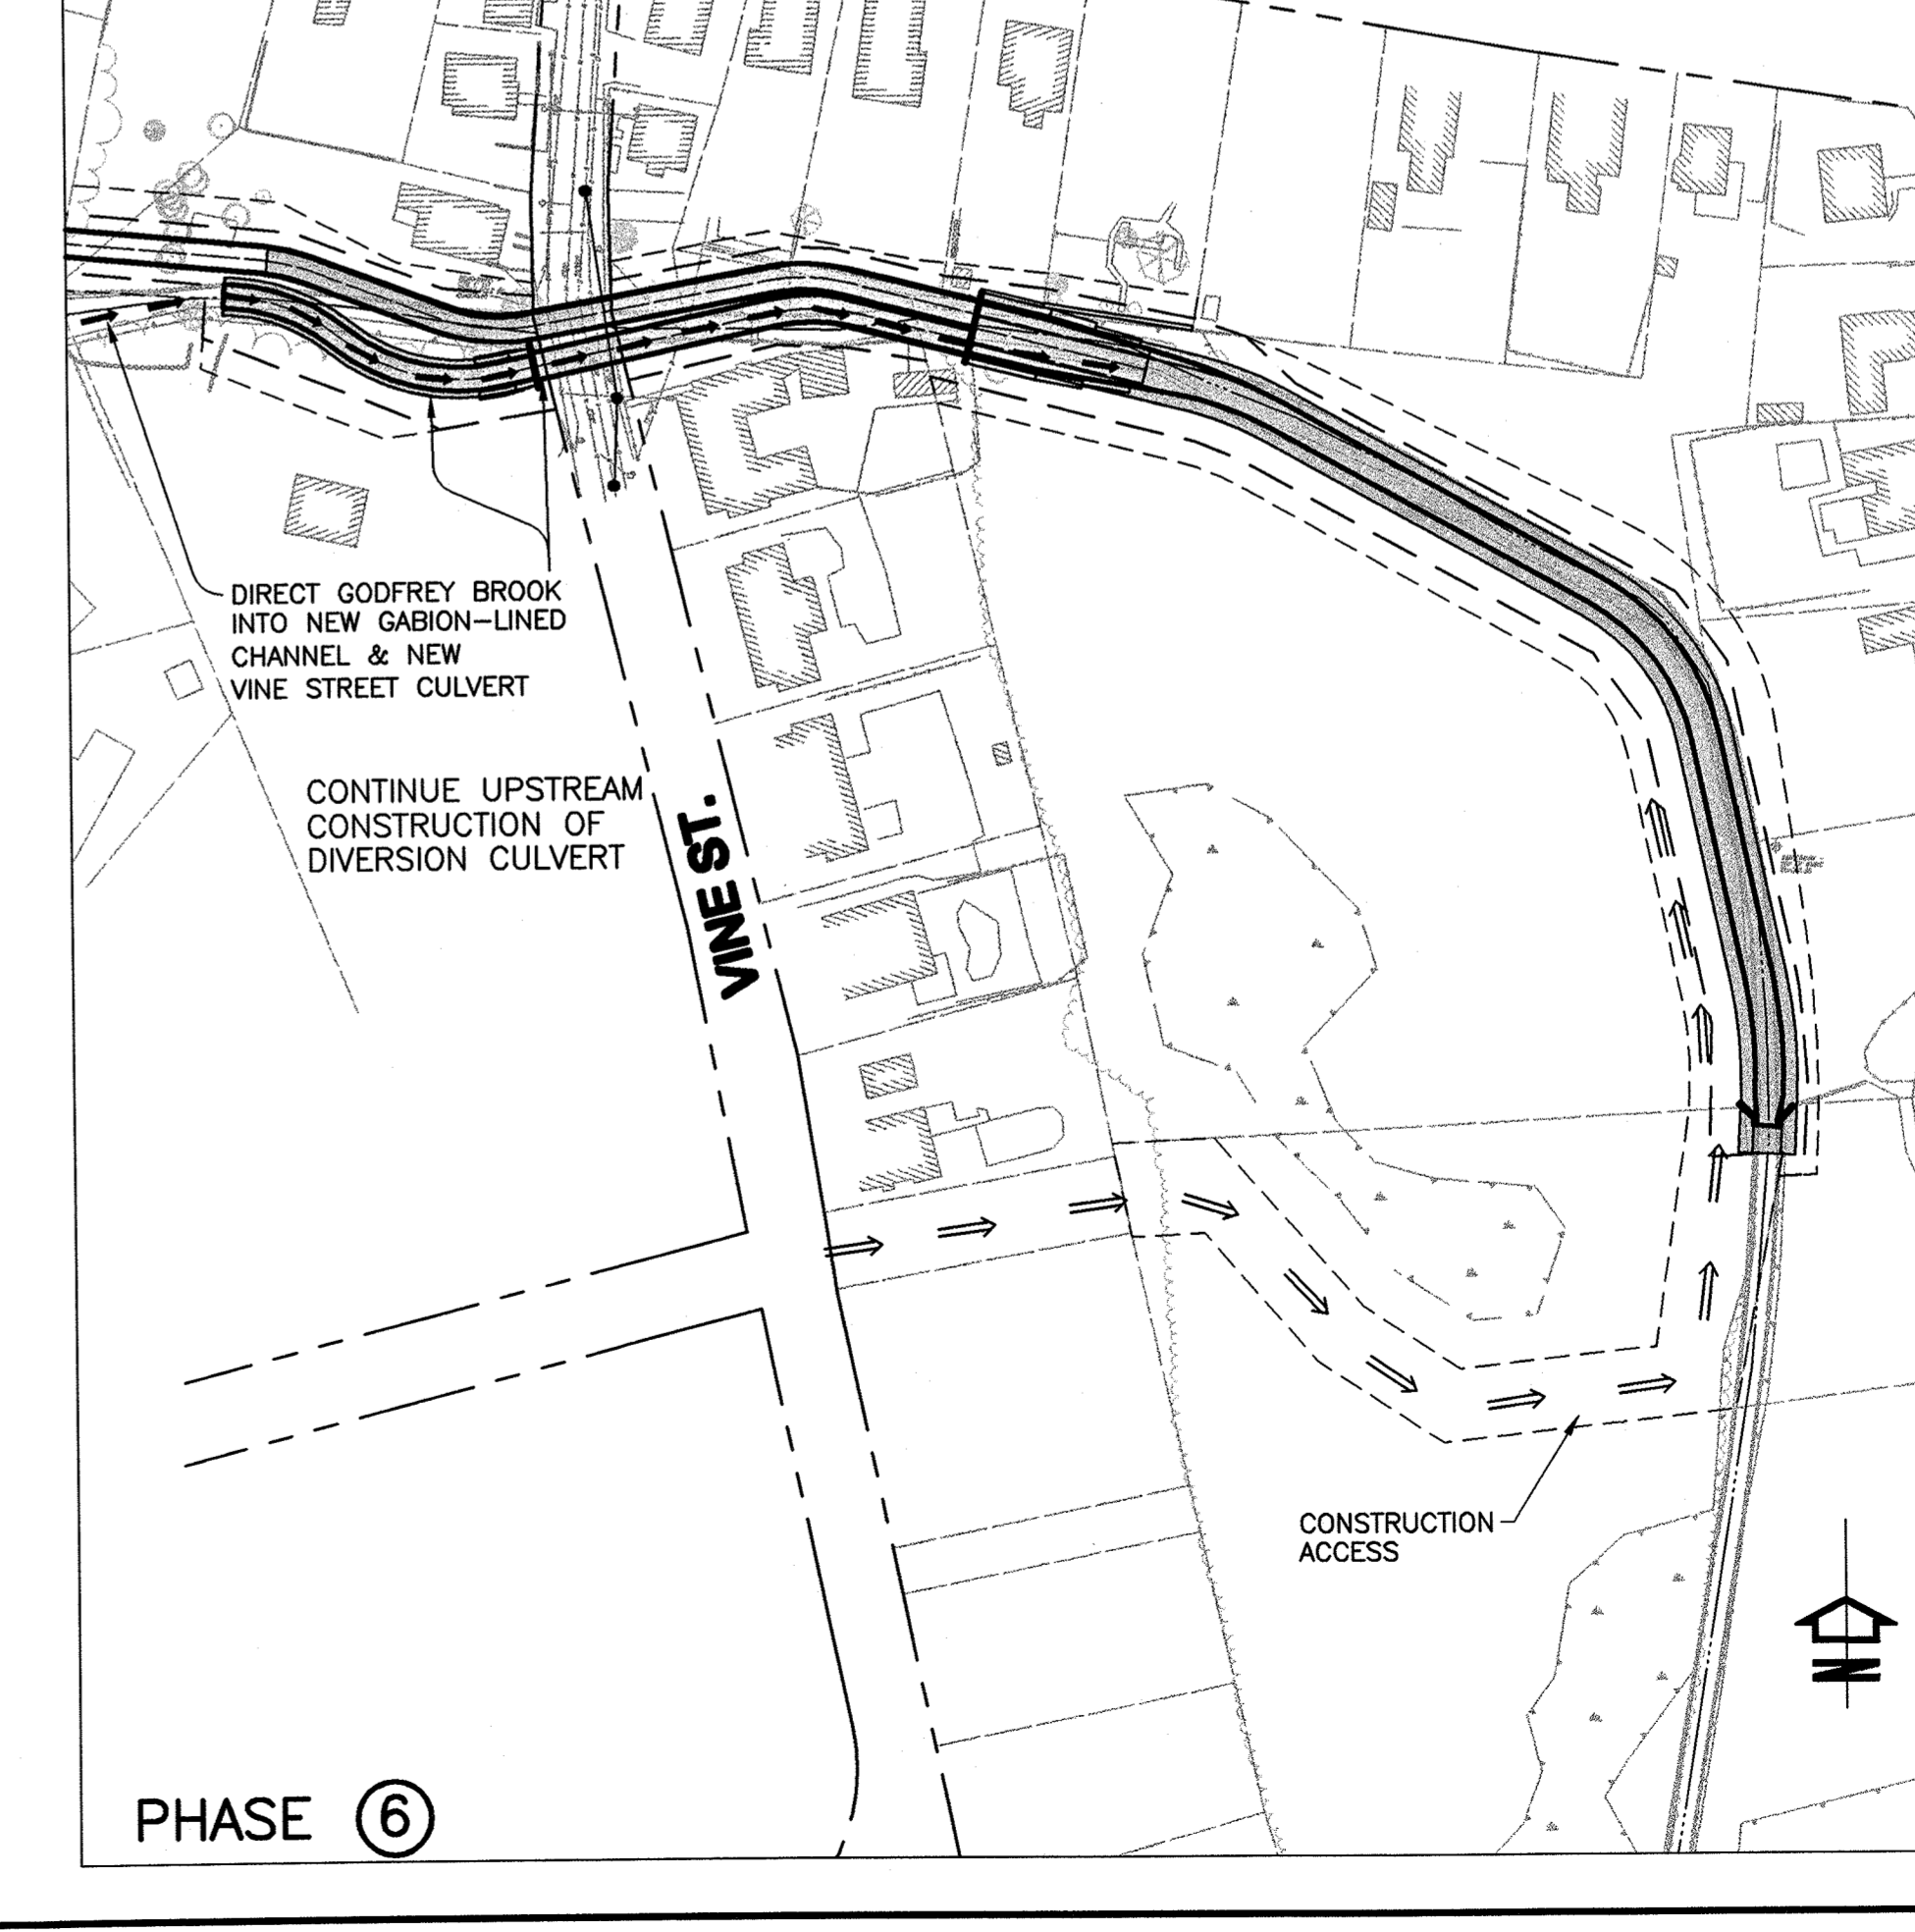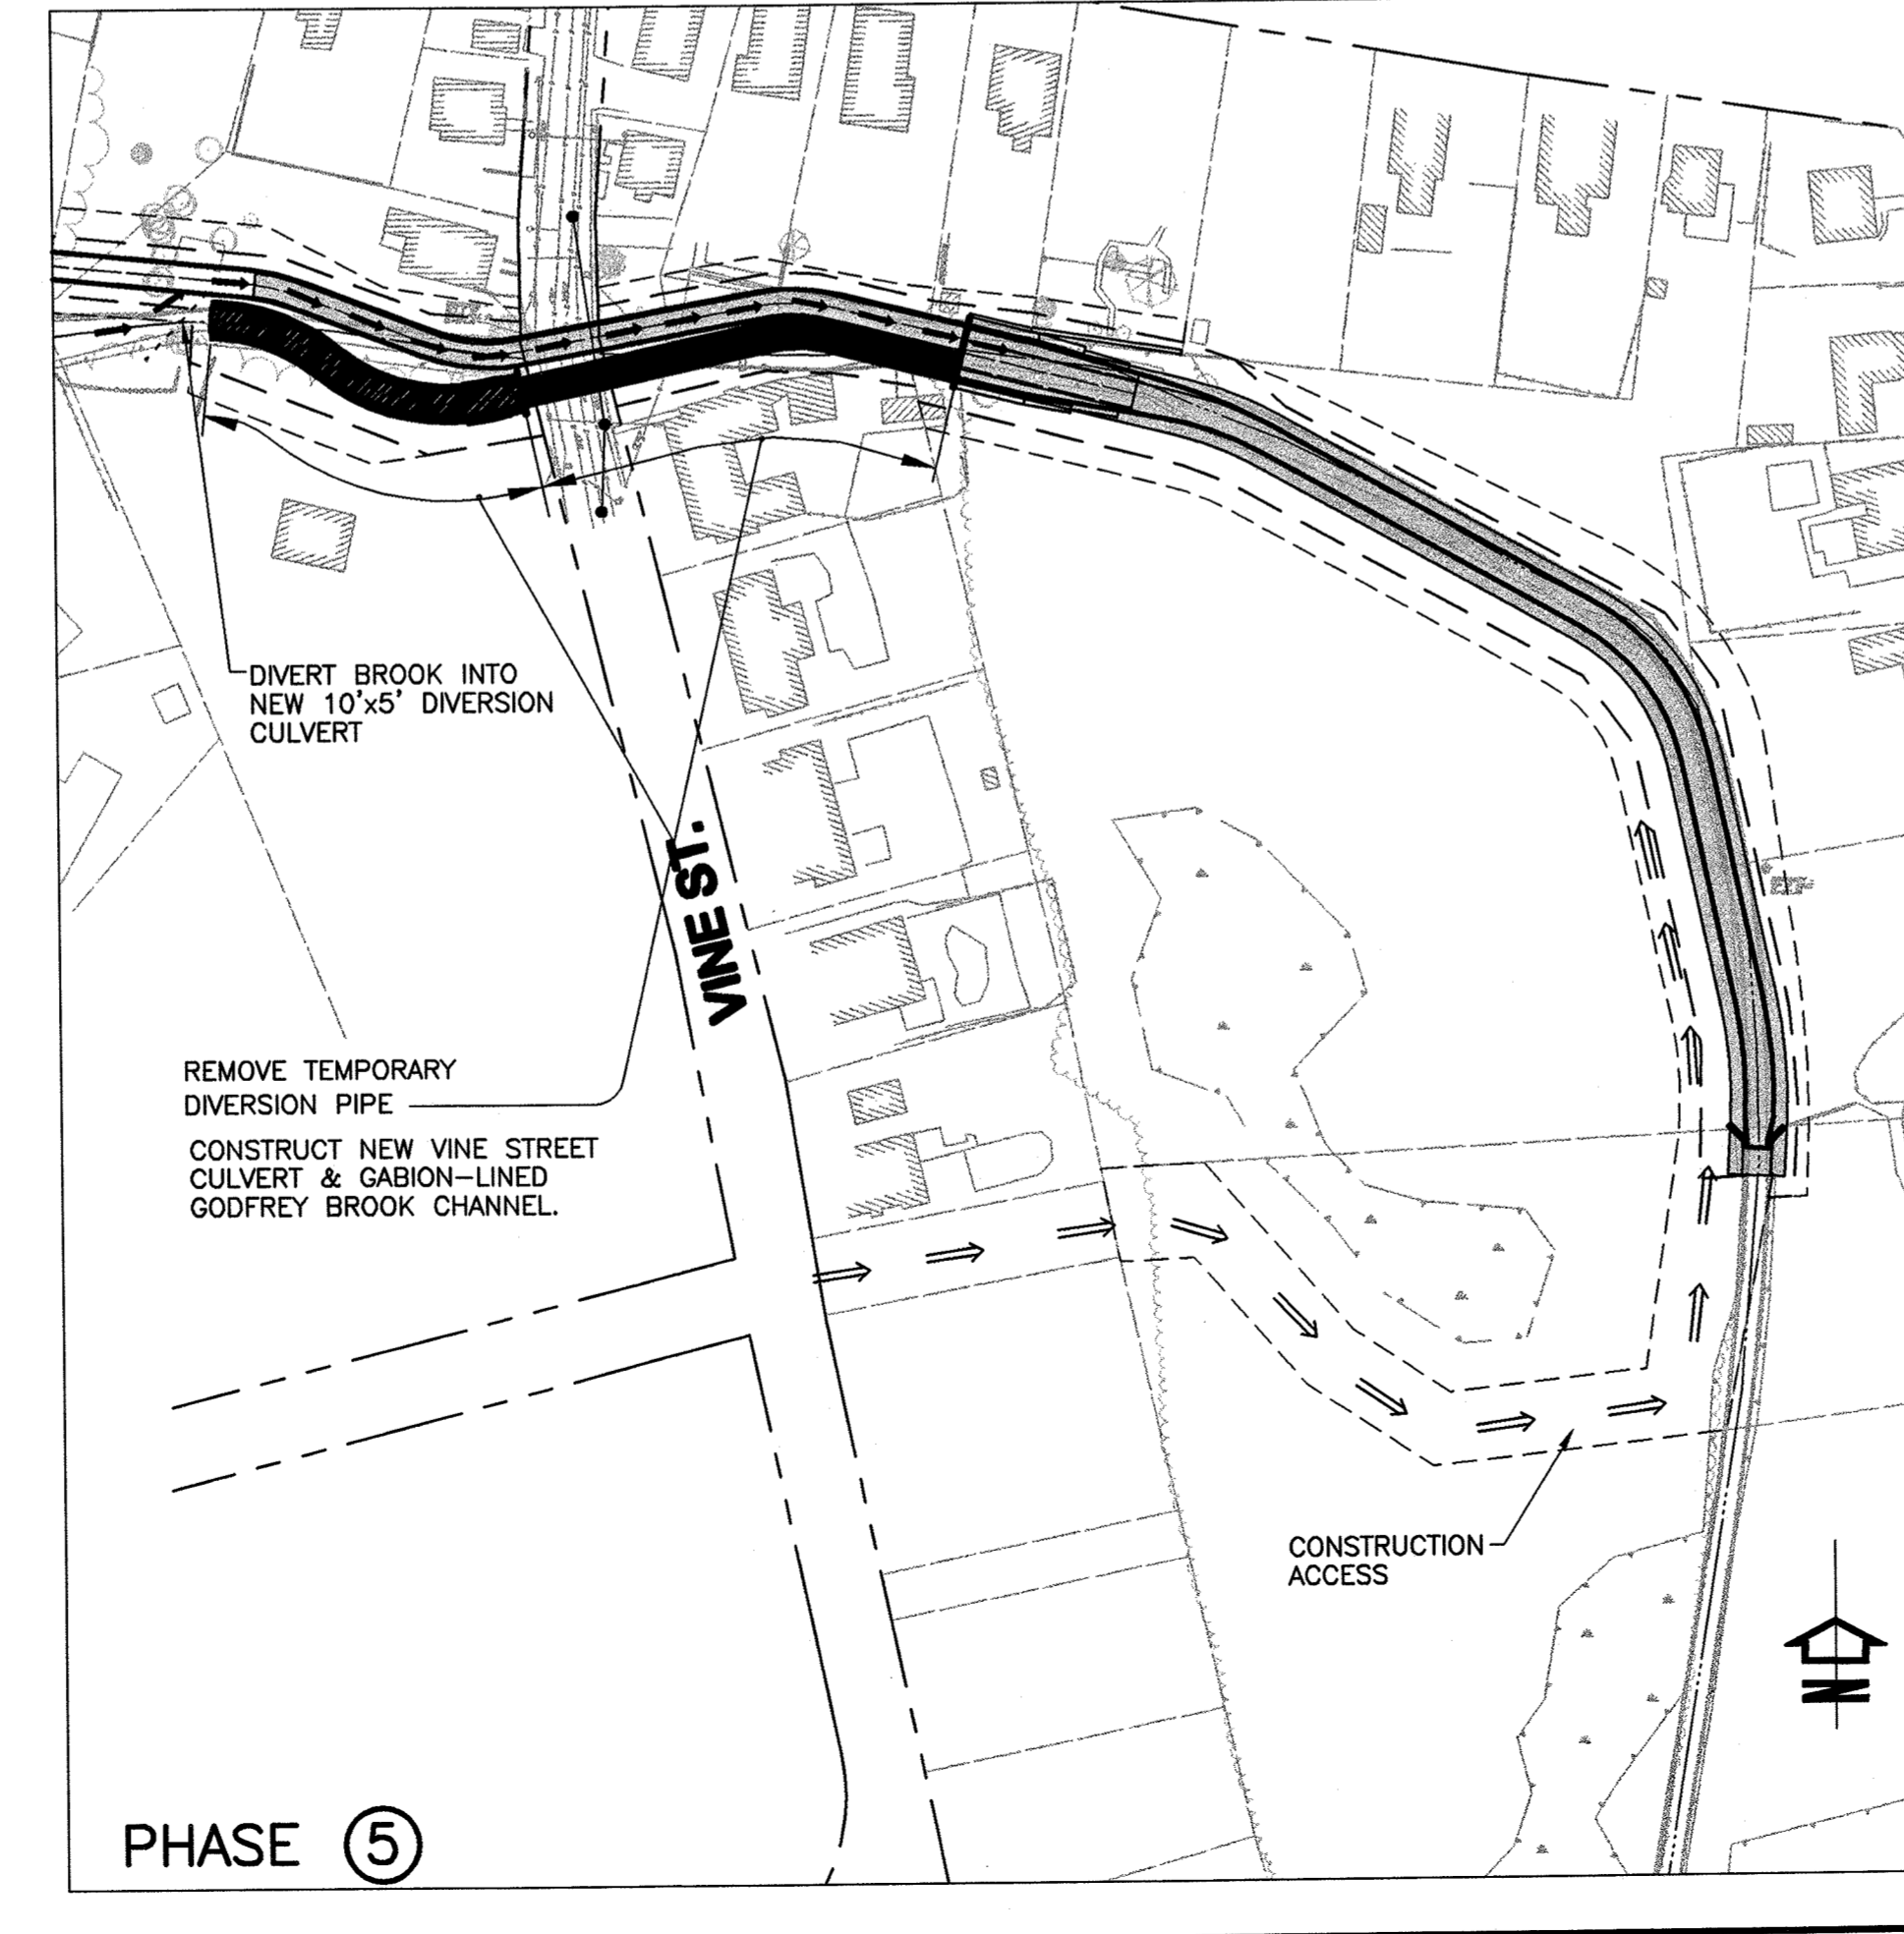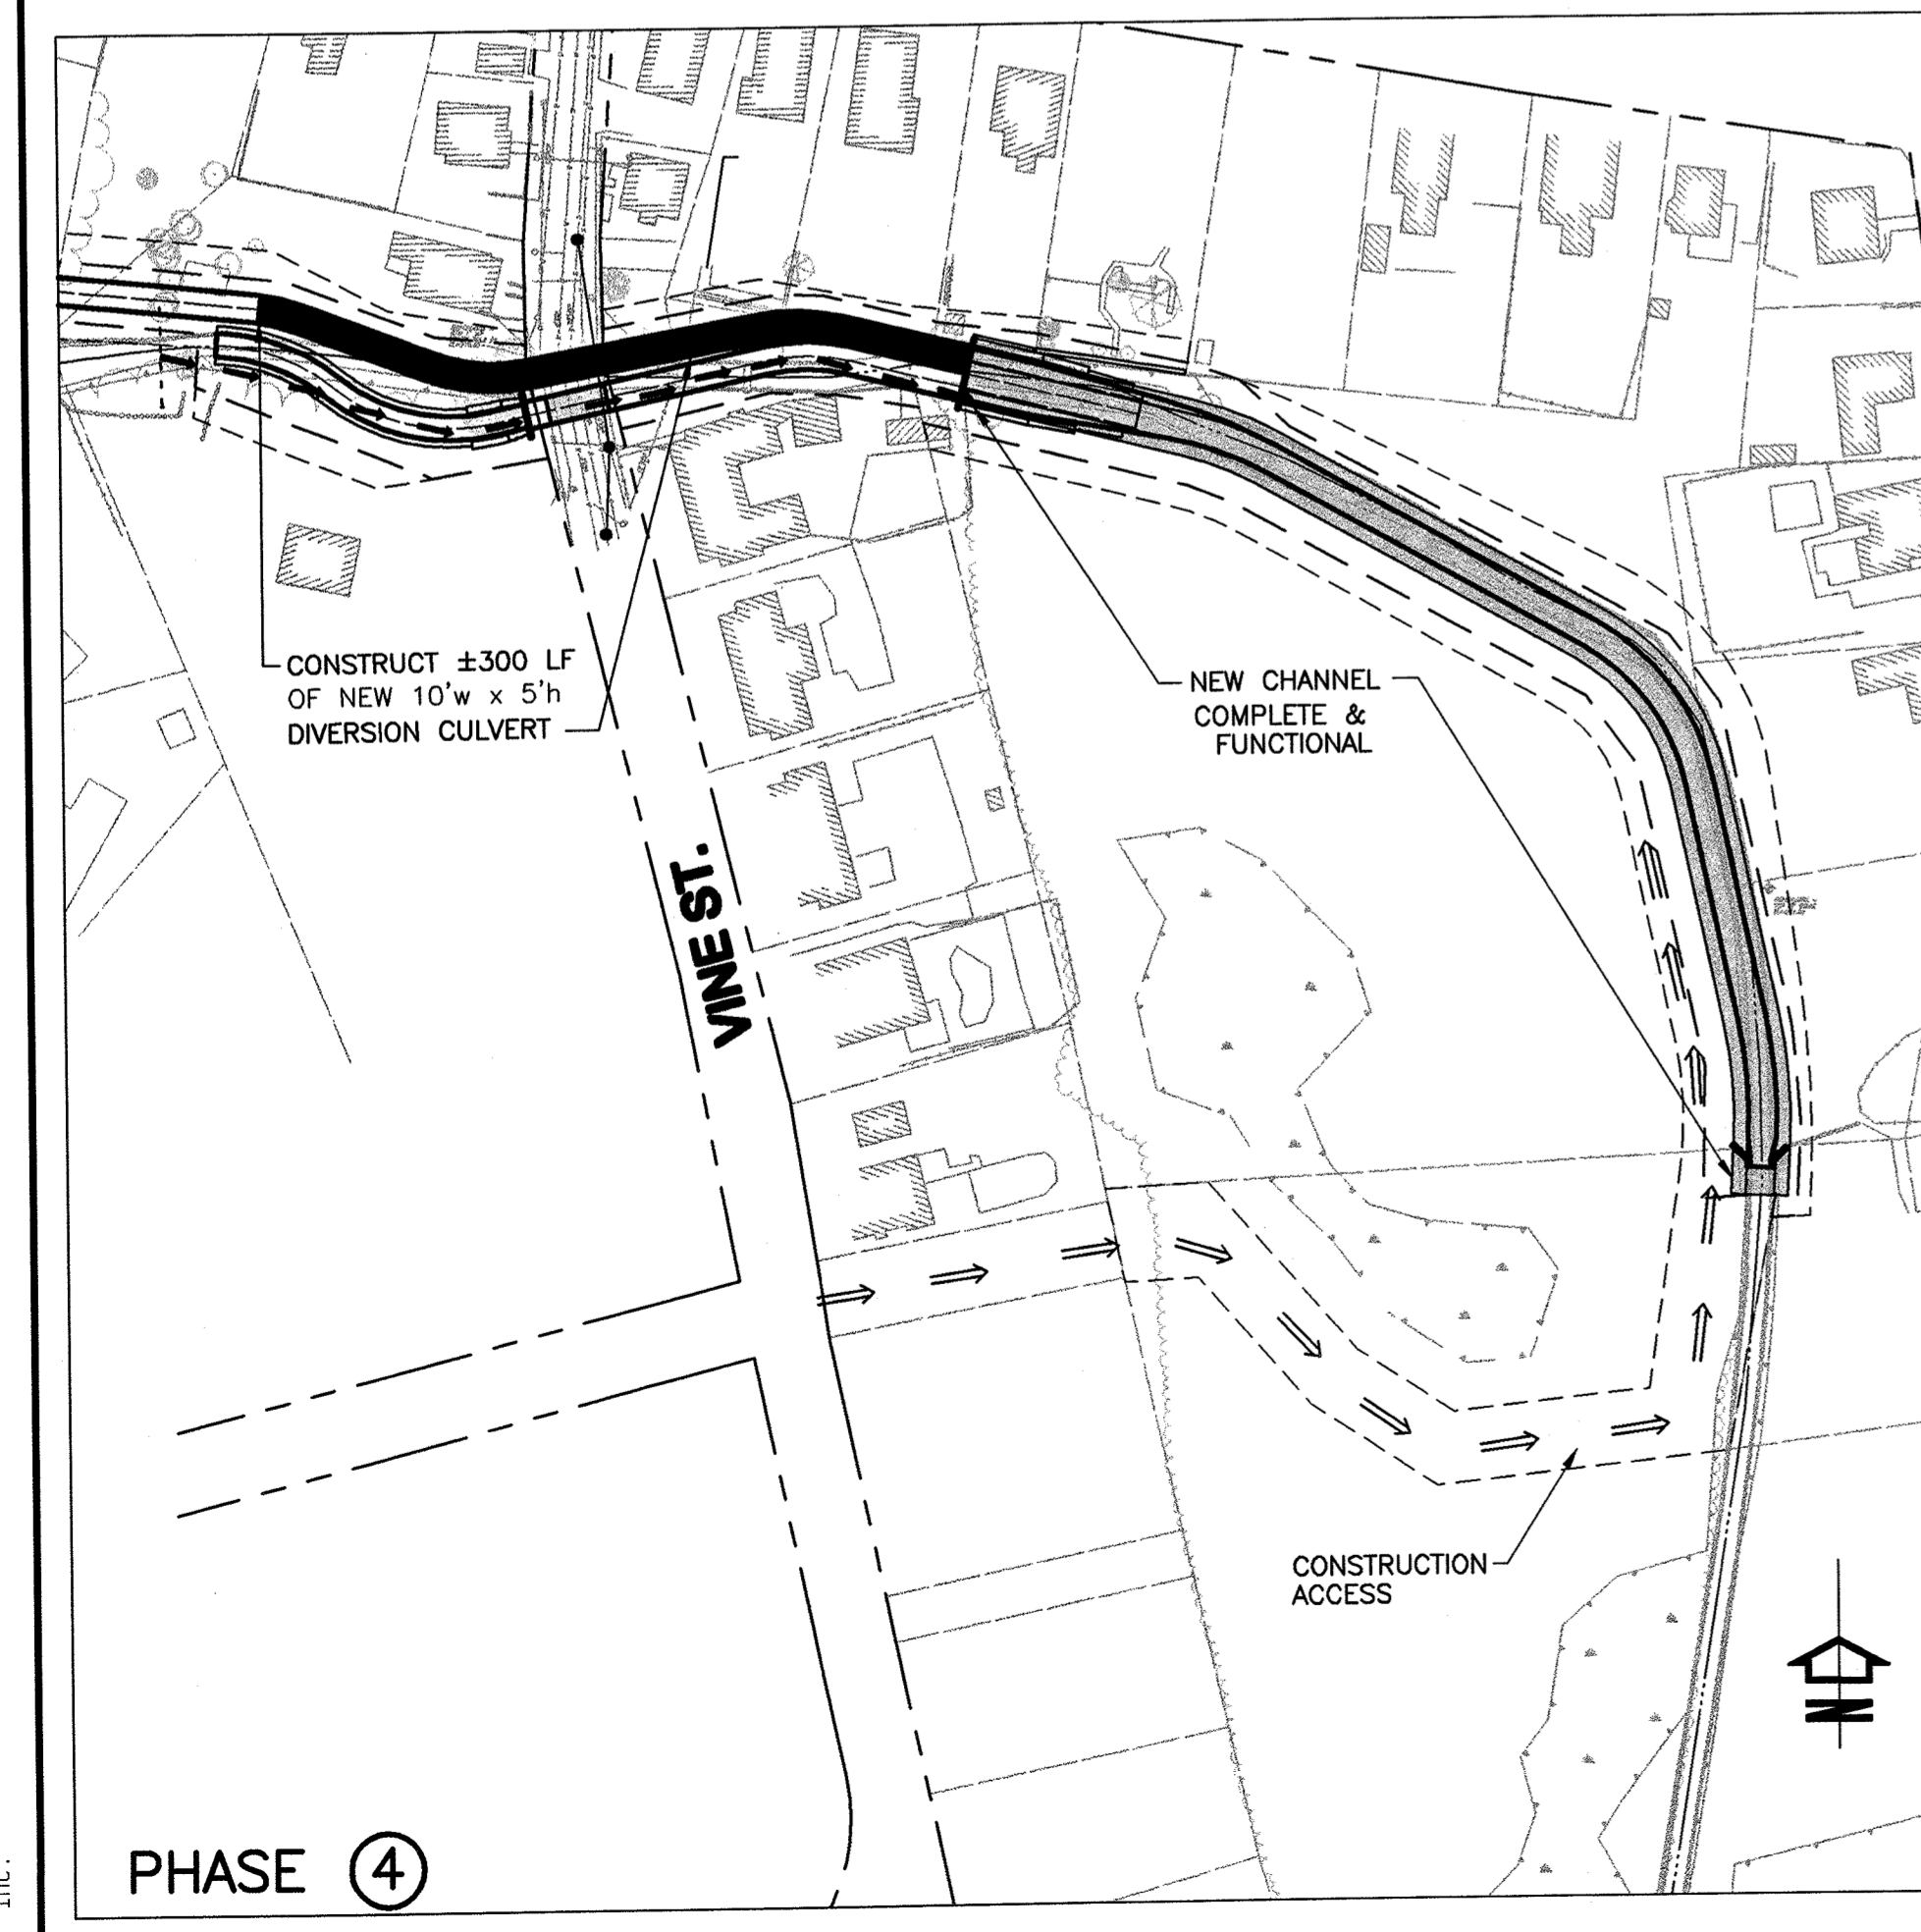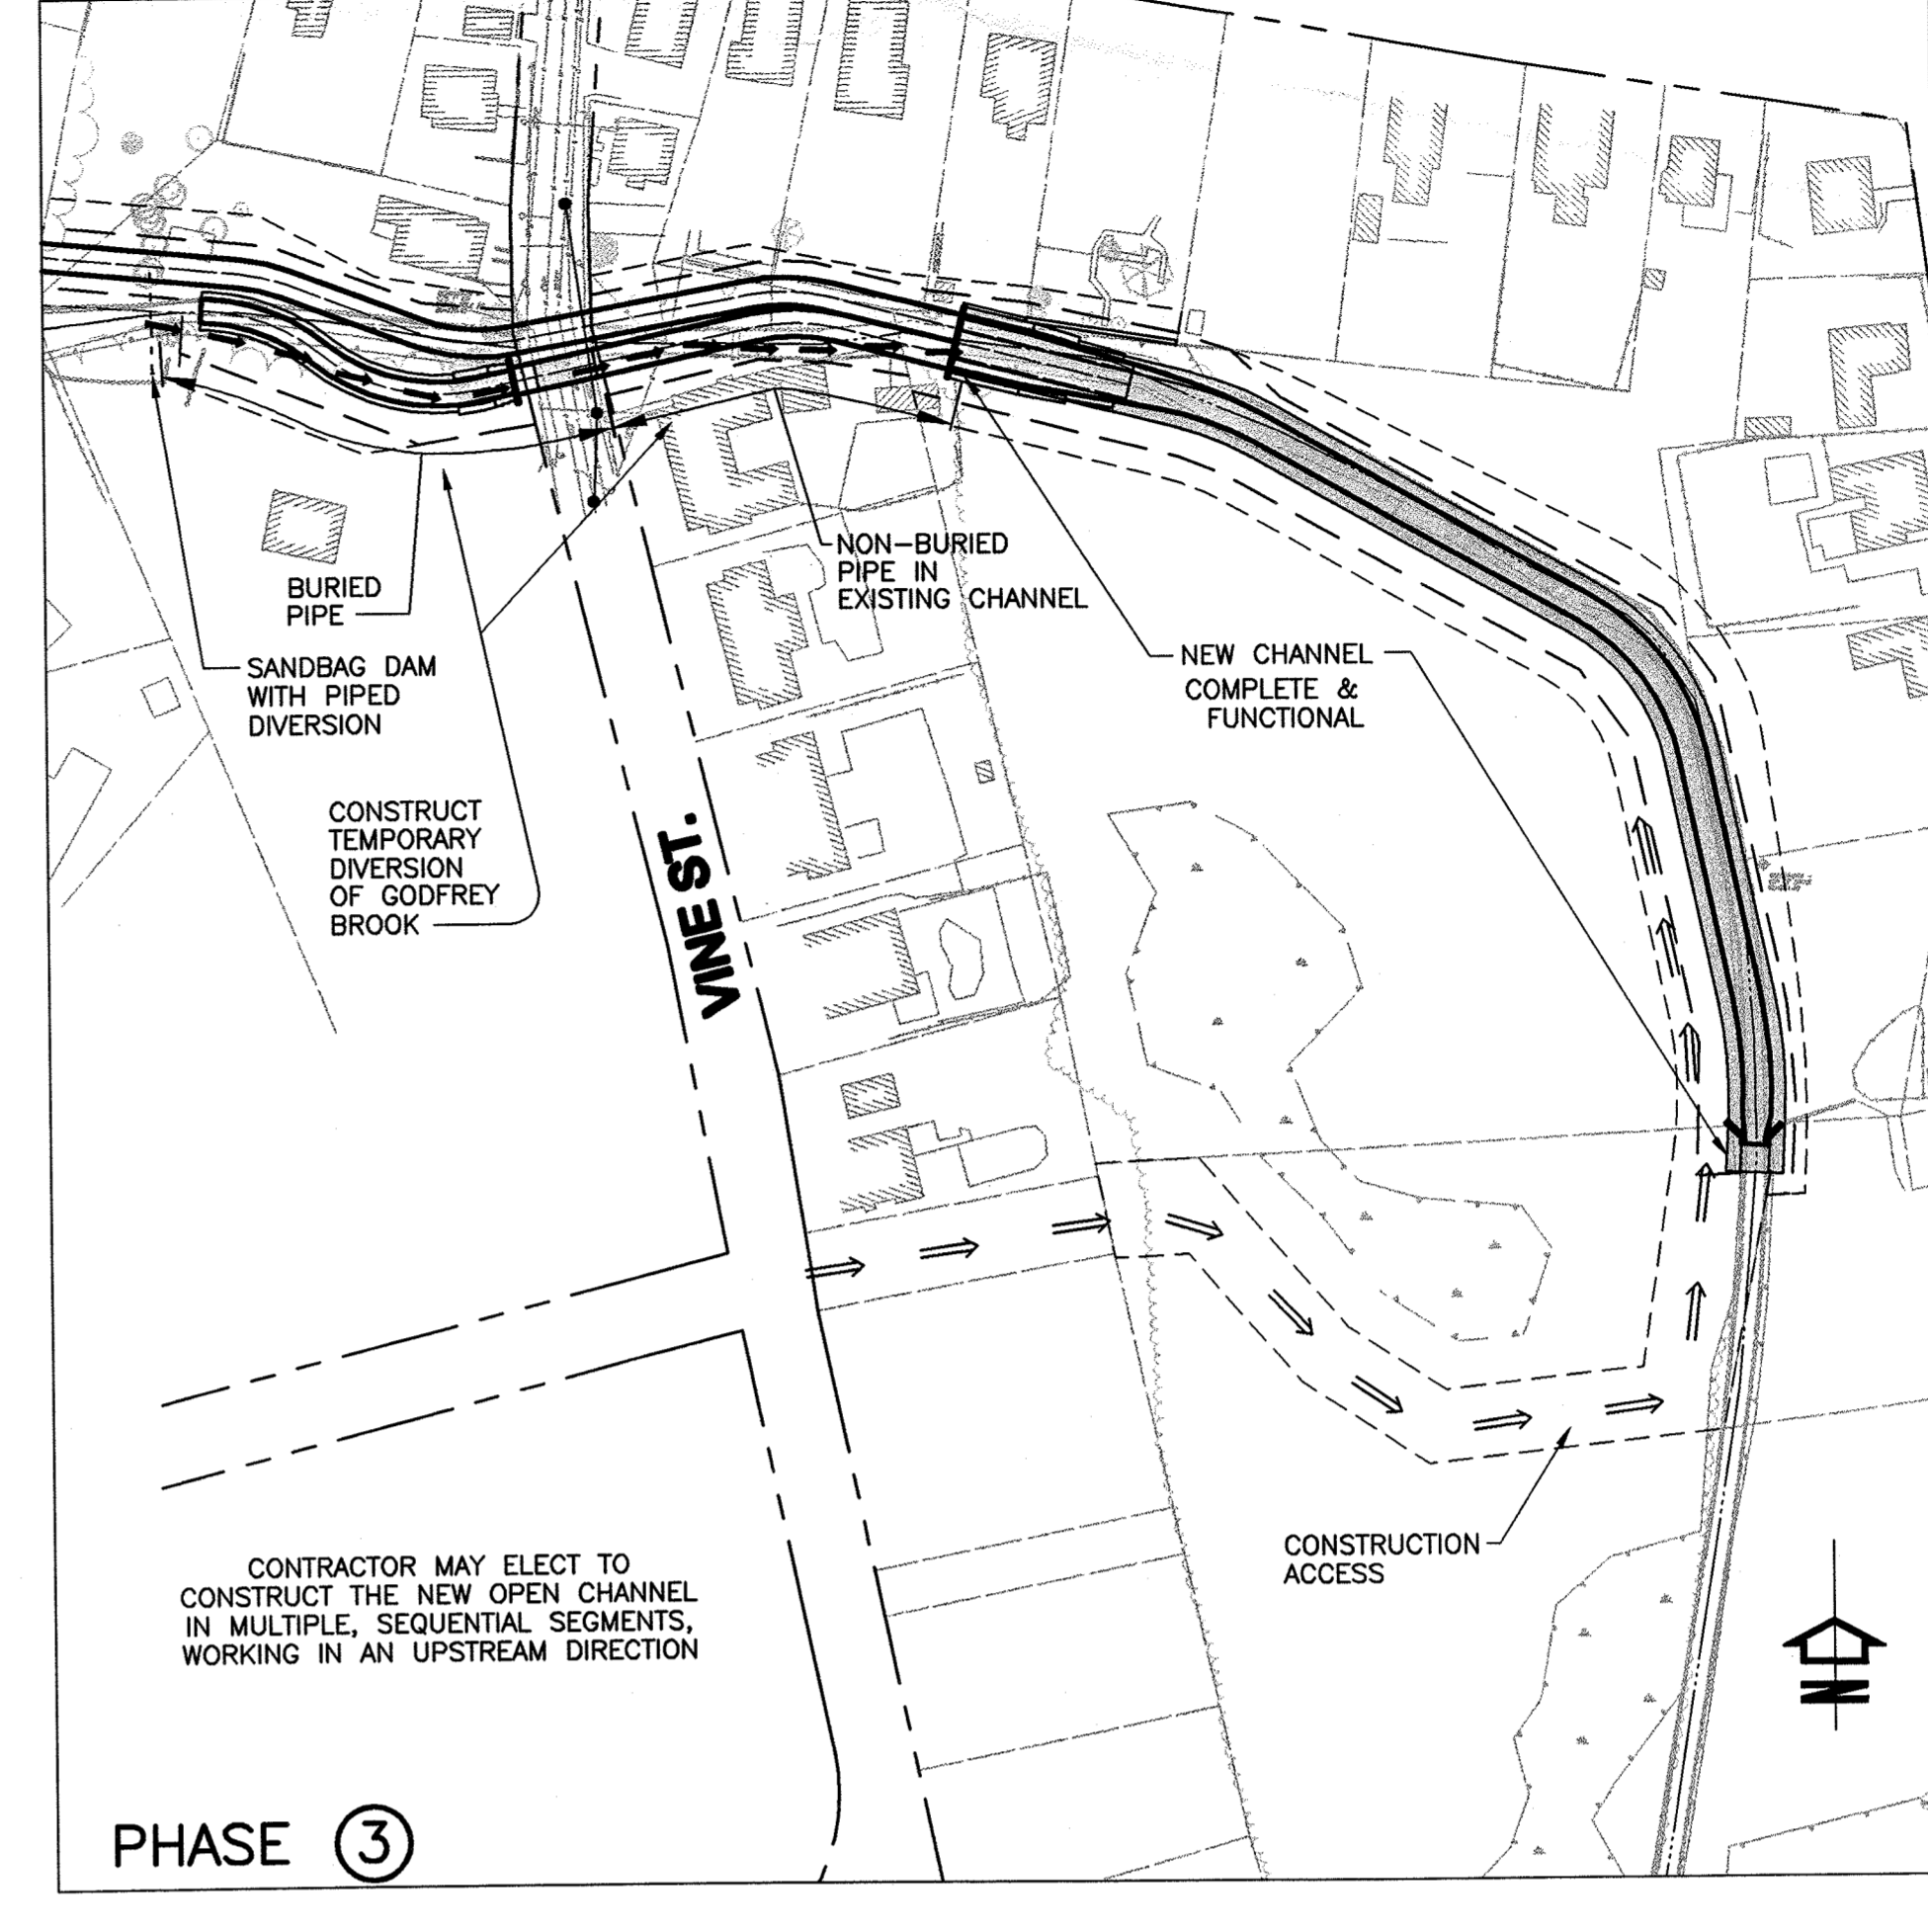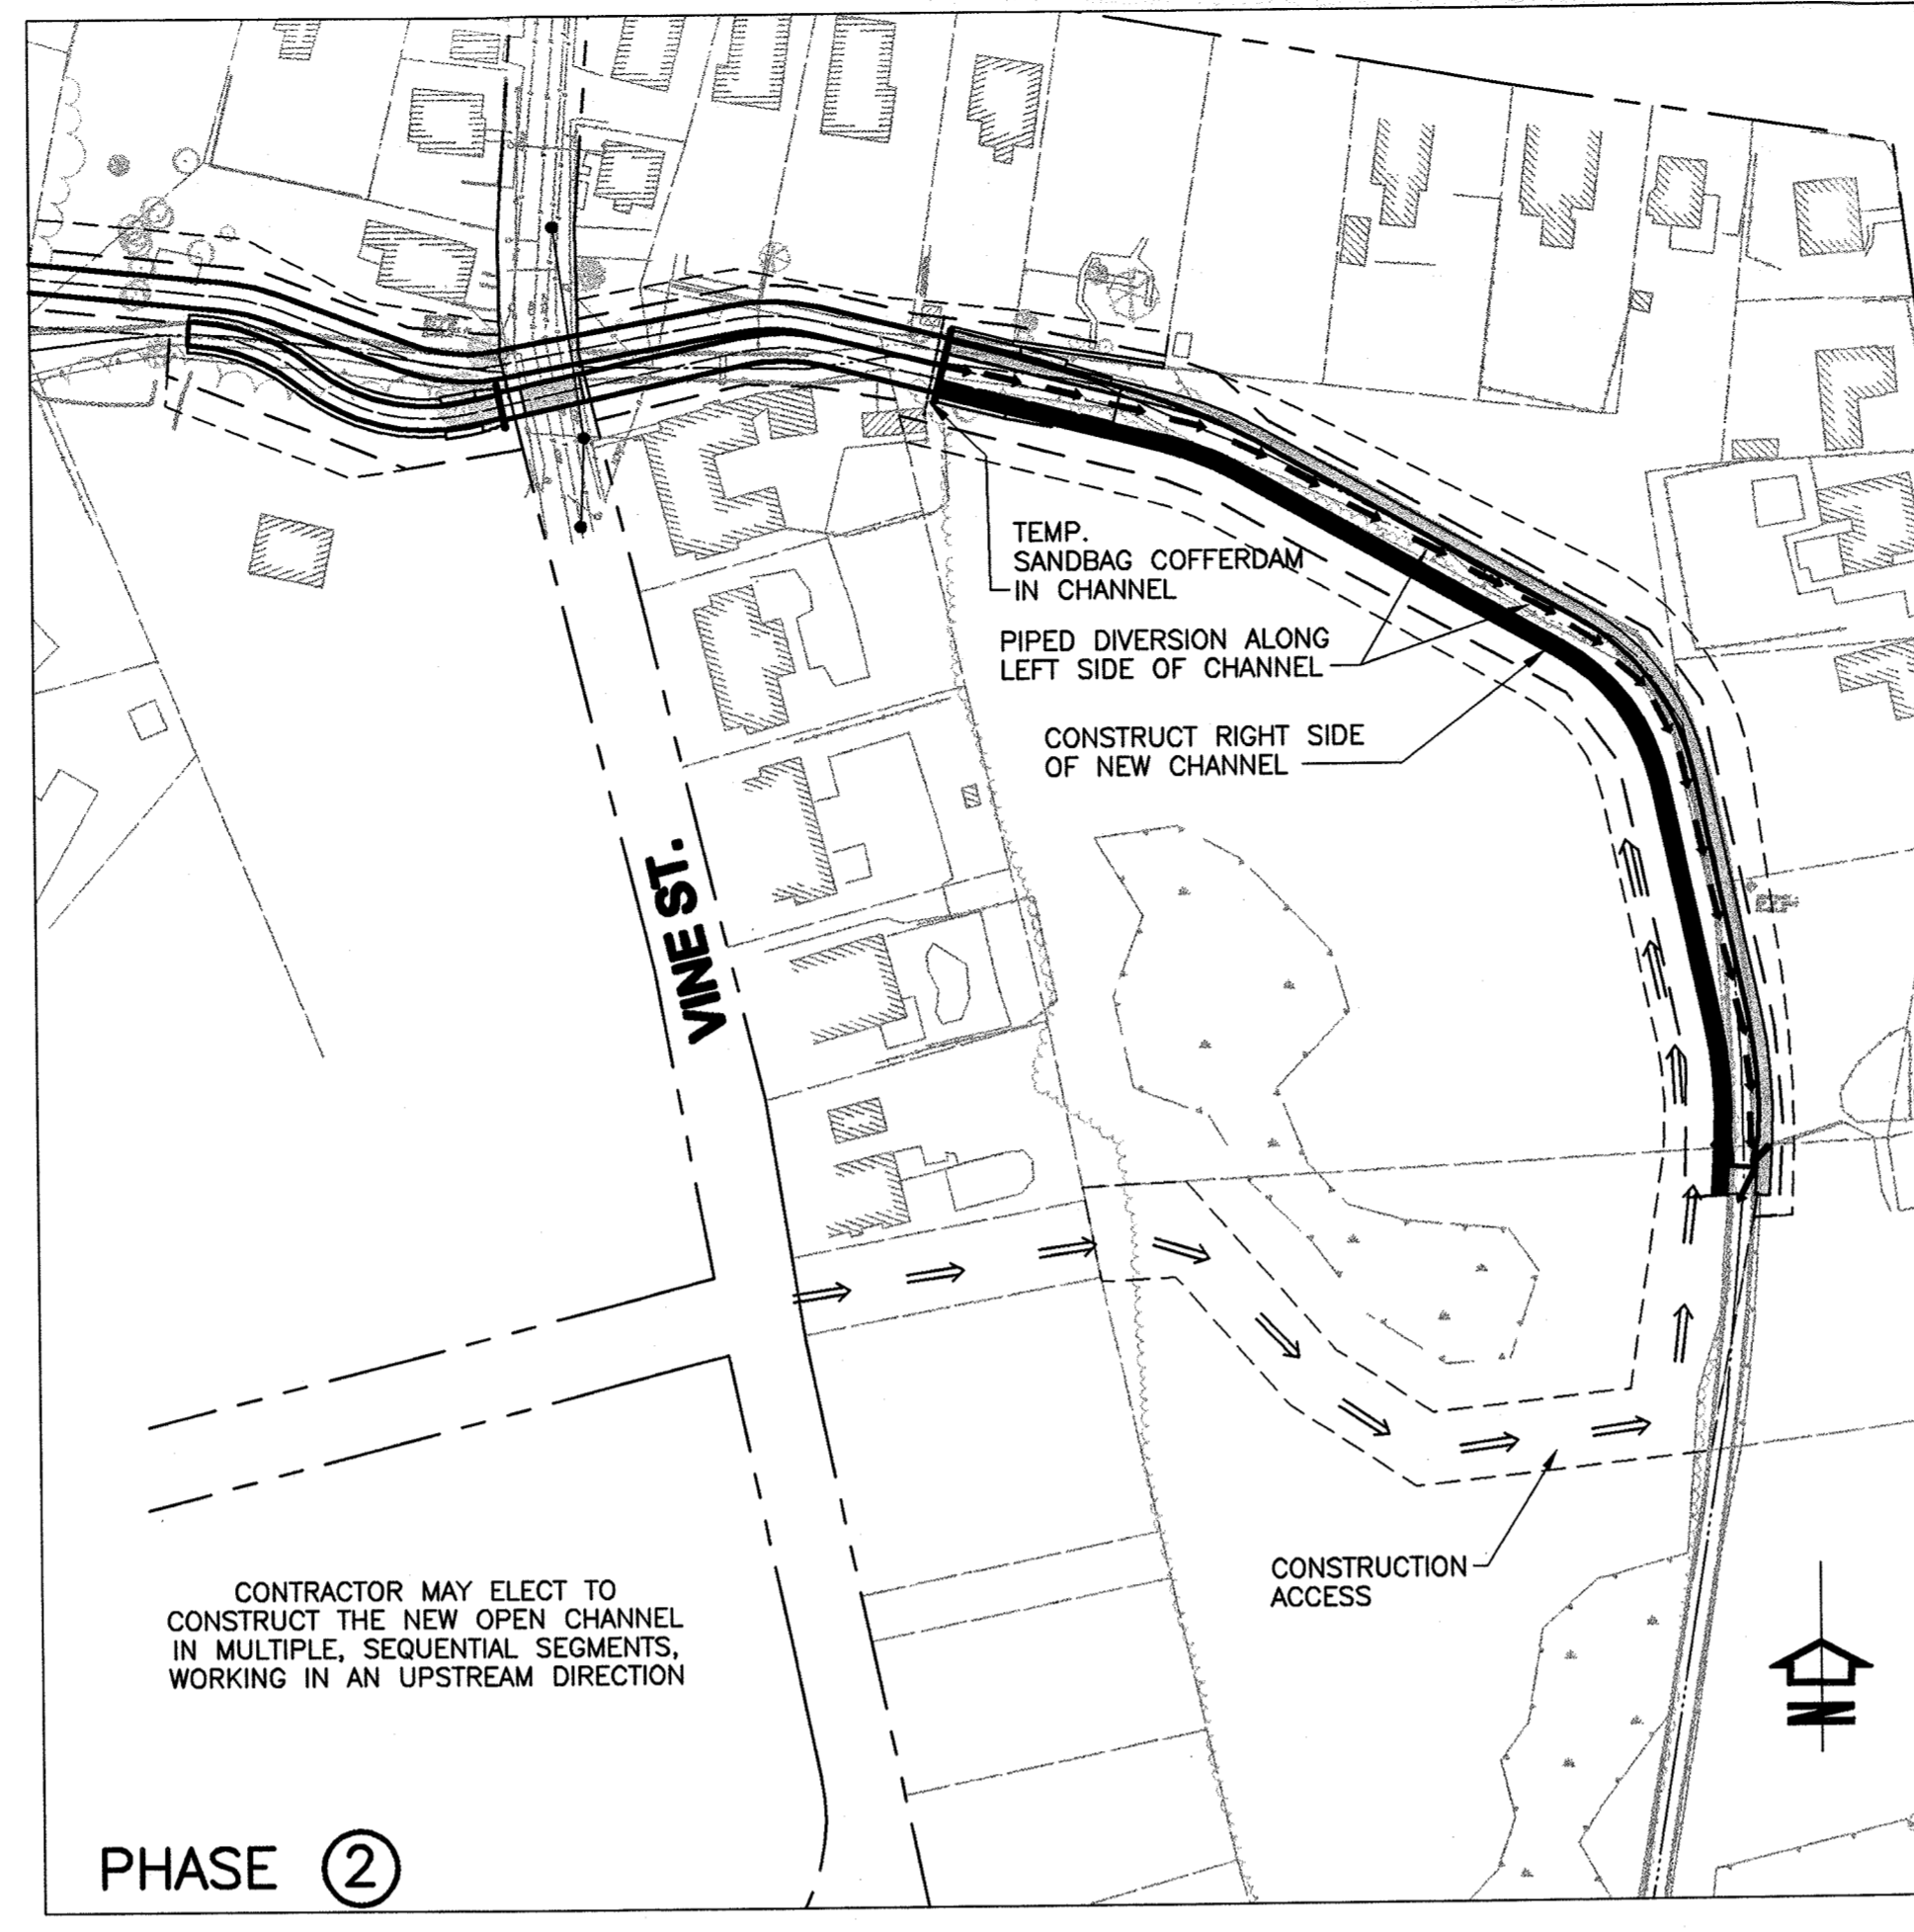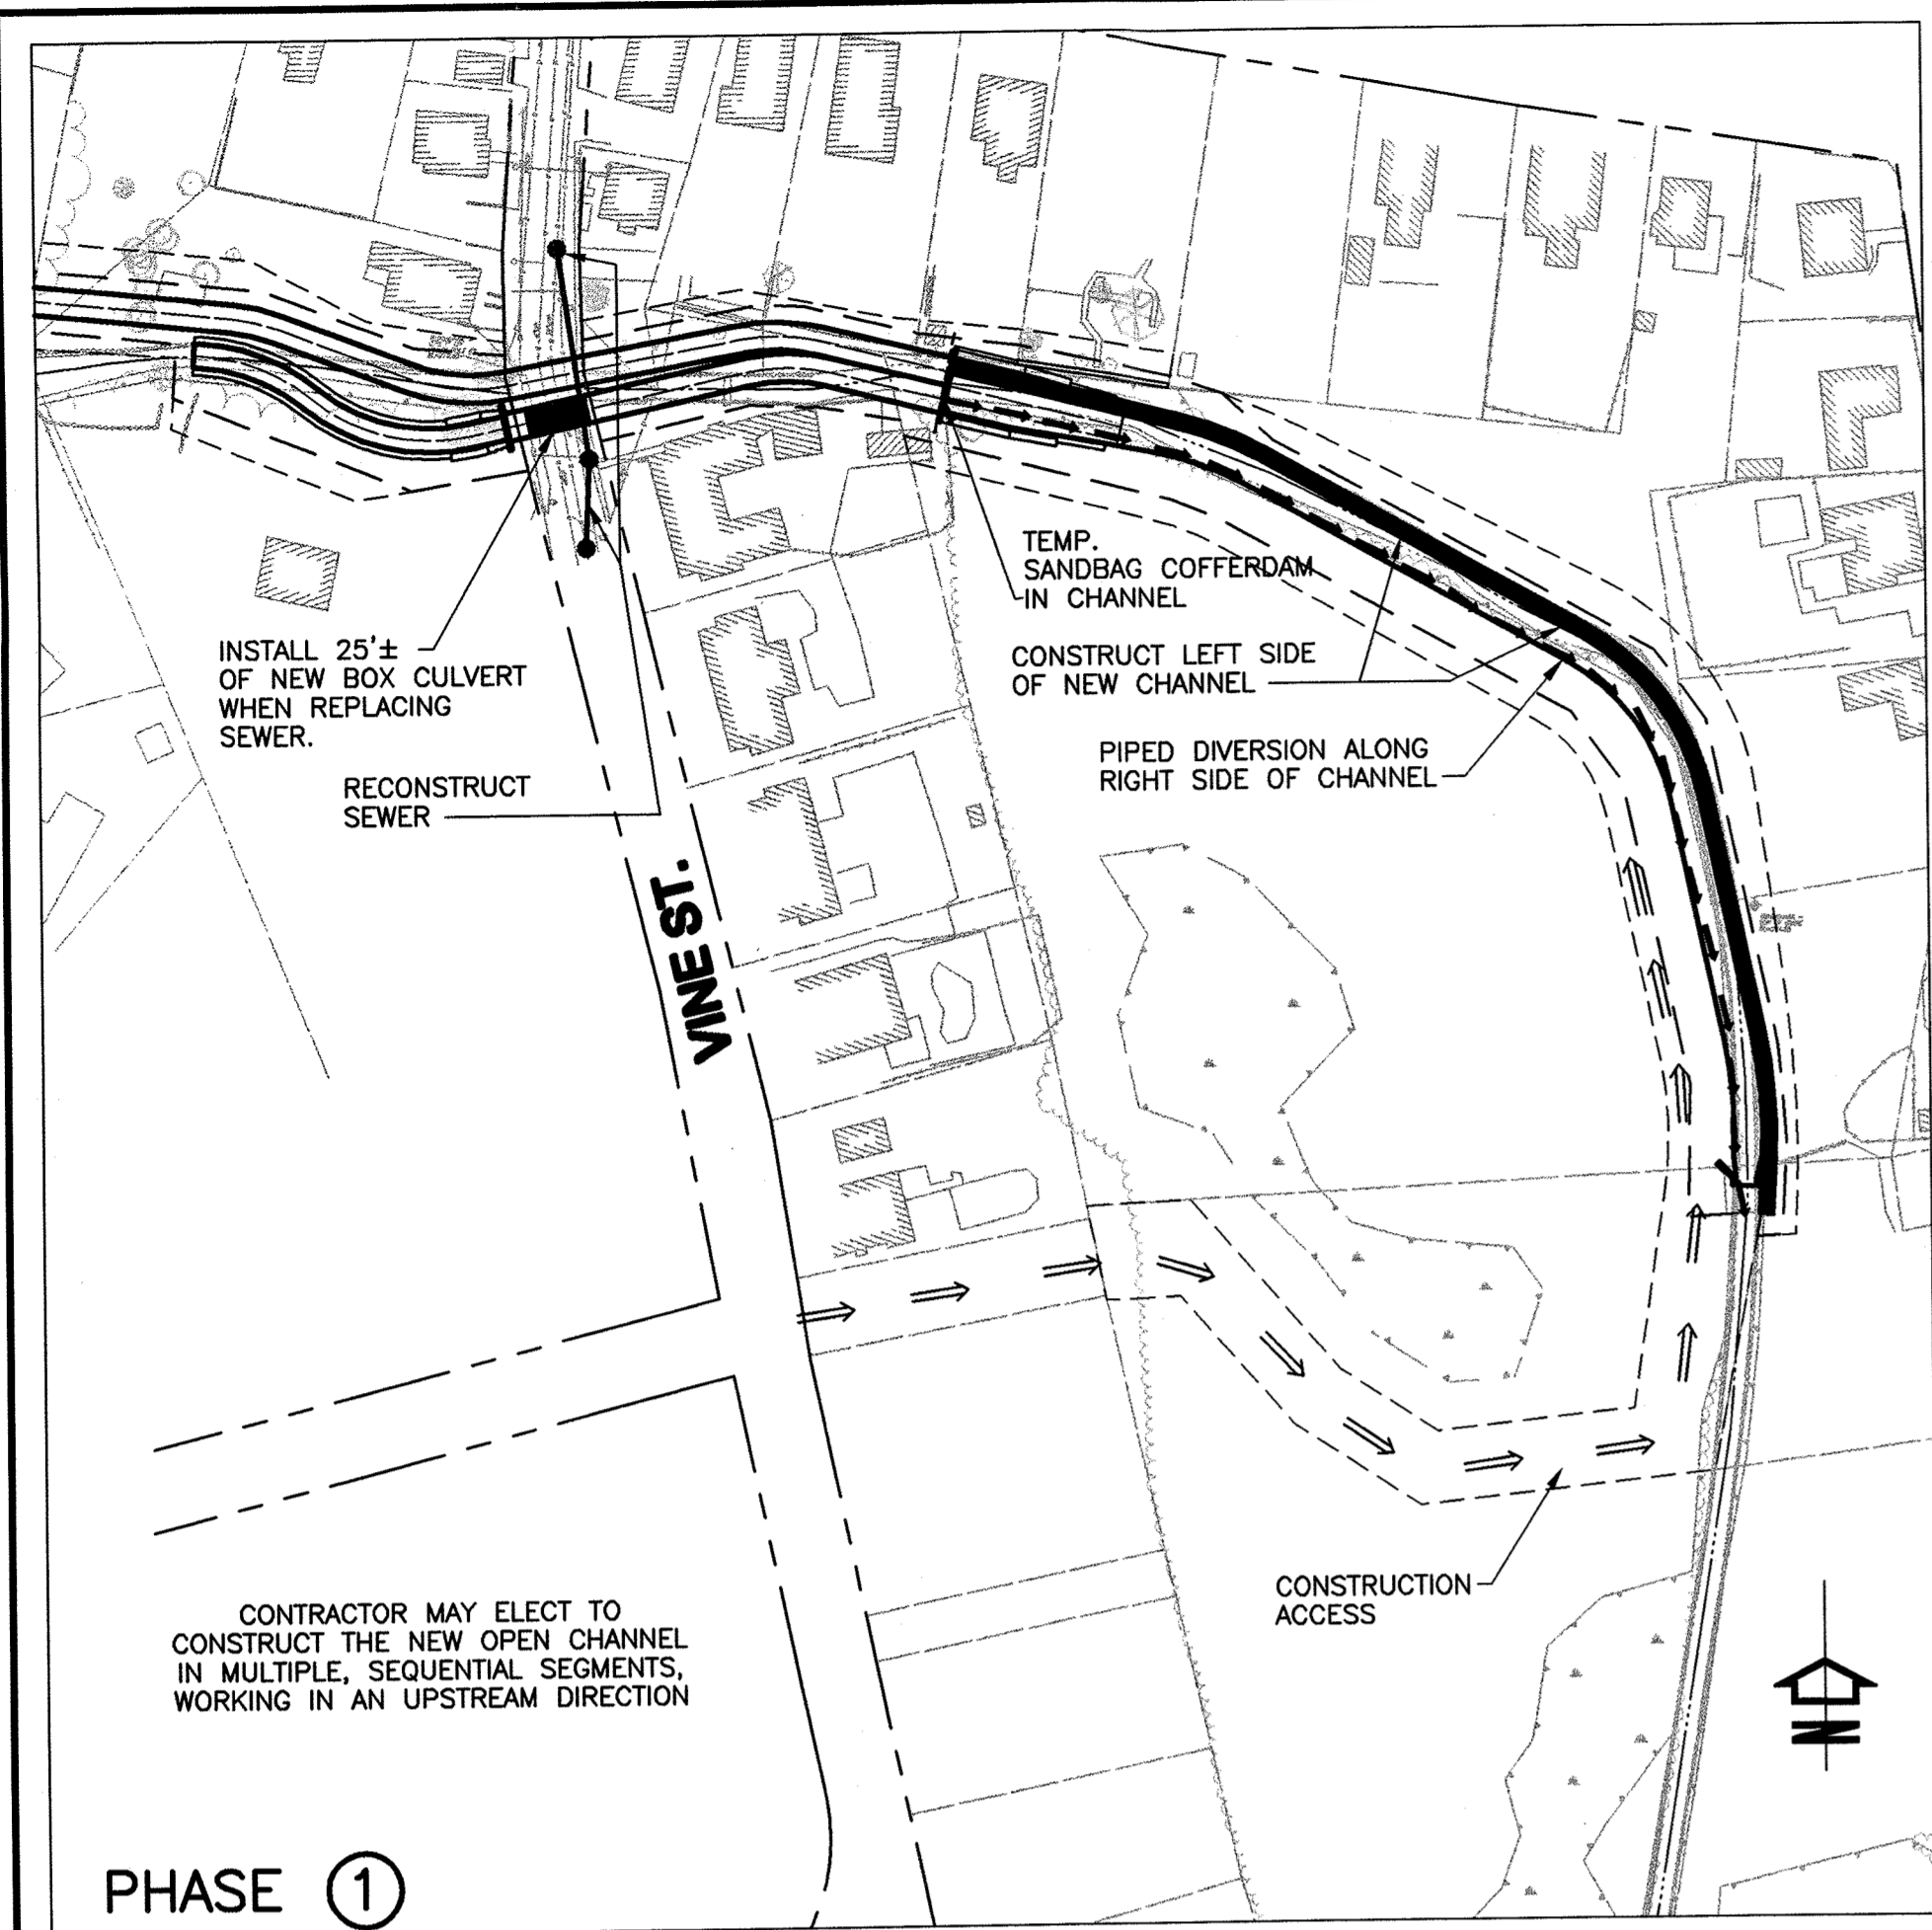

■ CONSTRUCTION IN CURRENT PHASE
 ■ CONSTRUCTED IN PREVIOUS PHASES

REFER TO SHEET NO.2 FOR GENERAL SEQUENCING NOTES

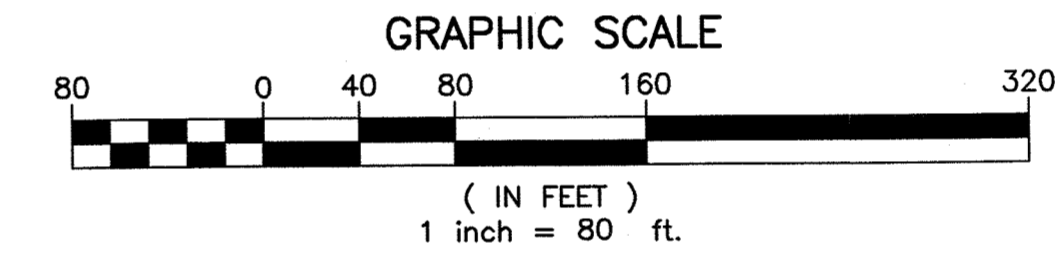

DRAWING NO. **35** OF **35** SHEETS

BAYSTATE ENVIRONMENTAL CONSULTANTS INC.

Engineers Surveyors
 Scientists East Longmeadow, MA 01028
 286 North Main Street

BEC

PROJECT NO. 94-1215	SCALE AS NOTED	DATE APRIL 1999	DRAWN BY EDM	CHECKED BY TEJ
Construction Sequencing Plan Vine Street Area Godfrey Brook Flood Mitigation Project Milford, Massachusetts				
NO.	DATE	REVISION	BY	EDM
2	10/1/01	ISSUED AS RECORD PRINT		
1	8/12/99	ISSUED FOR BIDDING	TEJ	

AutoCAD File: P:\AUTOCAD\ADMIN\941215\RECORD DRAWINGS\Sheet 35.dwg Plotted at: Tue Oct 02 09:35:08 2001
 BEC, Inc.